
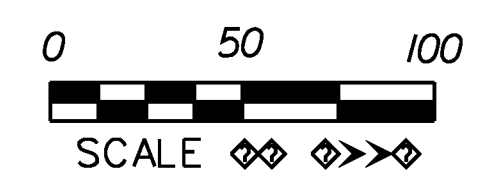


EPSC-CN5

EPSC-CN7

KEYPLAN

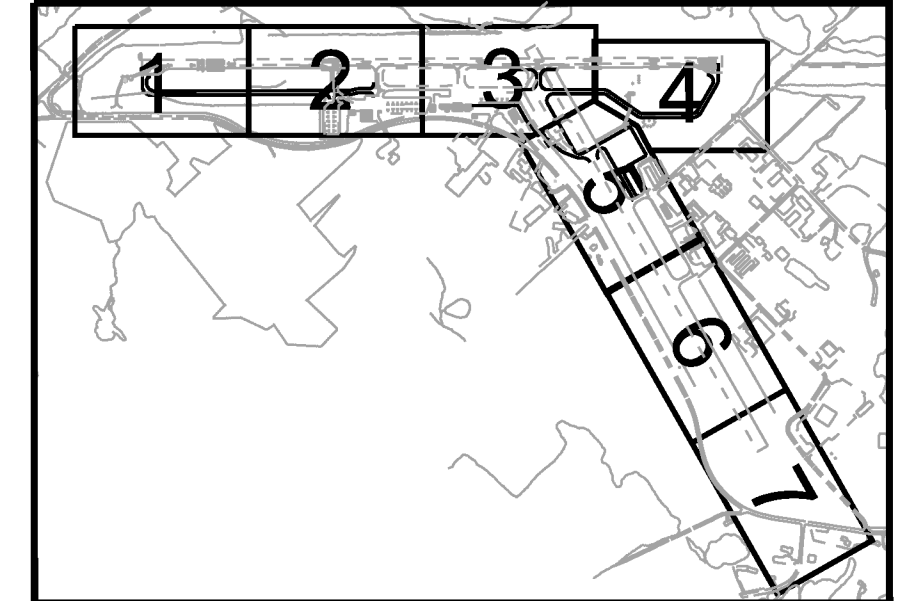

NOTE:
PROPOSED ALIGNMENTS
SHOWN FOR GUIDANCE ONLY.
SEE GEOMETRY SHEETS 1-7.

Hoyle, Tanner & Associates, Inc.
 150 Dow Street
 Manchester, NH 03101-1227
 Tel 603-669-5555
 Fax 603-669-4168
 Web Page: www.hoyletanner.com
Hoyle, Tanner & Associates © 2008

EPSC CONSTRUCTION SITE PLAN

PROJECT NAME: E. F. KNAPP STATE AIRPORT	
A.I.P. 3-50-0001-011-2009	
PROJECT NUMBER: BERLIN AIR 04-3216	
FILE NAME: z05h378shf.EPSCcnstr.dgn	PLOT DATE: 11/22/2011
PROJECT LEADER: S. FORTNEY	DRAWN BY: D. STANDISH
DESIGNED BY: S. BOUCHARD	CHECKED BY: J. DOWNAR
EPSC CONSTRUCTION SITE PLAN	SHEET 46 OF 173