



\$(EPSC\_FN1)

\$(EPSC\_FN3)

**KEYPLAN**

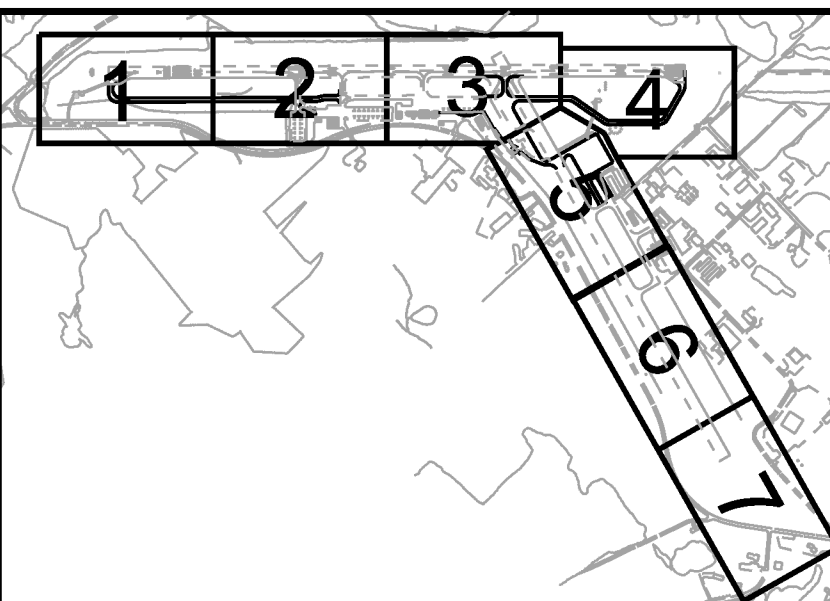

NOTE:  
 PROPOSED ALIGNMENTS  
 SHOWN FOR GUIDANCE ONLY.  
 SEE GEOMETRY SHEETS 1-7.

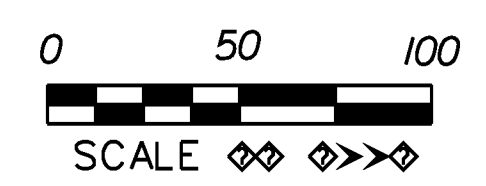

**Hoyle, Tanner & Associates, Inc.**  
 150 Dow Street  
 Manchester, NH 03101-1227  
 Tel 603-669-5555  
 Fax 603-669-4168  
 Web Page: [www.hoyletanner.com](http://www.hoyletanner.com)  
Hoyle, Tanner & Associates © 2008

**EPSC FINAL CONDITIONS SITE PLAN**

PROJECT NAME: E. F. KNAPP STATE AIRPORT	
A.I.P. 3-50-0001-011-2009	
PROJECT NUMBER: BERLIN AIR 04-3216	
FILE NAME: z05h378shf.EPSCfni.dgn	PLOT DATE: 11/22/2011
PROJECT LEADER: S. FORTNEY	DRAWN BY: D. STANDISH
DESIGNED BY: S. BOUCHARD	CHECKED BY: J. DOWNAR
EPSC FINAL CONDITIONS SITE PLAN	SHEET 49 OF 173