

AIRPORT PROPERTY LINE

PROPOSED WIND CONE

WINDSOCK RELOCATED TO 115+00, 220.00 LT.

REDESIGNATED TAXIWAY H

TOPSOIL AND SEED

RUNWAY 5-23

EPSC-FN5

EPSC-FN7

128+00 127+00 126+00 125+00 124+00 123+00 122+00 121+00 120+00 119+00 118+00 117+00 116+00 115+00 114+00

TOPSOIL AND SEED



APPROXIMATE LIMITS OF GRADING (TYP.)

AIRPORT PROPERTY LINE

AIRPORT ROAD

RELOCATED WINDSOCK

KEYPLAN

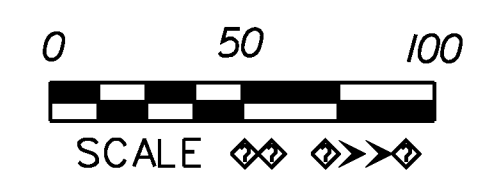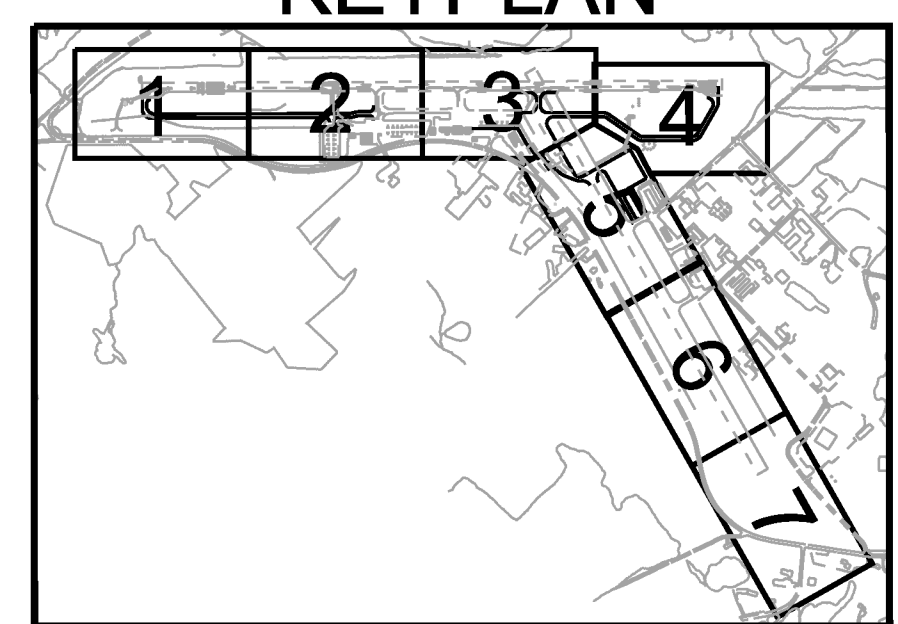

Hoyle, Tanner & Associates, Inc.

150 Dow Street
Manchester, NH 03101-1227
Tel 603-669-5555
Fax 603-669-4168
Web Page: www.hoyletanner.com
Hoyle, Tanner & Associates © 2008

EPSC FINAL CONDITIONS SITE PLAN

PROJECT NAME: E. F. KNAPP STATE AIRPORT
A.I.P. 3-50-0001-011-2009
PROJECT NUMBER: BERLIN AIR 04-3216
FILE NAME: z05h378shf.EPSCfn1.dgn
PROJECT LEADER: S. FORTNEY
DESIGNED BY: S. BOUCHARD
EPSC FINAL CONDITIONS SITE PLAN
PLOT DATE: 11/22/2011
DRAWN BY: D. STANDISH
CHECKED BY: J. DOWNAR
SHEET 53 OF 173

NOTE:
PROPOSED ALIGNMENTS
SHOWN FOR GUIDANCE ONLY.
SEE GEOMETRY SHEETS 1-7.