

SEE WINTER CONSTRUCTION  
NOTE #1  
ON EPSC NOTES  
AND LEGEND SHEET


LIMITS OF WINTER  
CONSTRUCTION (TYP.)

LIMITS OF WINTER  
CONSTRUCTION (TYP.)

SEE WINTER CONSTRUCTION  
NOTE #1 ON EPSC NOTES  
AND LEGEND SHEET

SEE WINTER CONSTRUCTION  
NOTE #1 ON EPSC NOTES  
AND LEGEND SHEET

- NOTES:
1. SEE EPSC WINTER CONSTRUCTION NOTES ON EPSC NOTES AND LEGEND SHEET.
  2. PROPOSED ALIGNMENTS SHOWN FOR GUIDANCE ONLY. SEE GEOMETRY SHEETS 1-7.

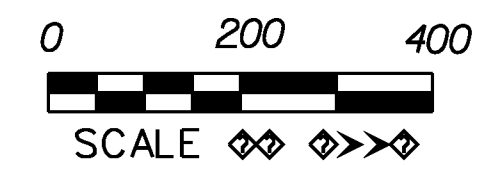

**Hoyle, Tanner & Associates, Inc.**  
 150 Dow Street  
 Manchester, NH 03101-1227  
 Tel 603-669-5555  
 Fax 603-669-4168  
 Web Page: [www.hoyletanner.com](http://www.hoyletanner.com)  
Hoyle, Tanner & Associates © 2008

<b>EPSC WINTER SITE PLAN</b>	
PROJECT NAME: E.F. KNAPP STATE AIRPORT	
A.I.P. 3-50-0001-011-2009	
PROJECT NUMBER: BERLIN AIR 04-3216	
FILE NAME: z05h378sht.EPSCwinter.dgn	LOT DATE: 11/22/2011
PROJECT LEADER: S. FORTNEY	DRAWN BY: D. STANDISH
DESIGNED BY: S. BOUCHARD	CHECKED BY: J. DOWNAR
EPSC WINTER SITE PLAN	SHEET 55 OF 173