



SEE DEMOLITION SHT 2

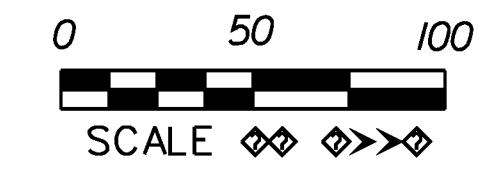

NOTE:  
 PROPOSED GEOMETRY SHOWN FOR GUIDANCE ONLY. SEE GEOMETRY SHEETS 1-7.  
 REMOVE ALL CABLE IN TURF AS SHOWN ON PLANS. CABLE REMOVAL IS INCIDENTAL TO TO COST OF THE ITEM THAT GENERATES THE CABLE. ALL CABLE REMOVED SHALL BE DISPOSED OF LEGALLY OFF AIRPORT PROPERTY.

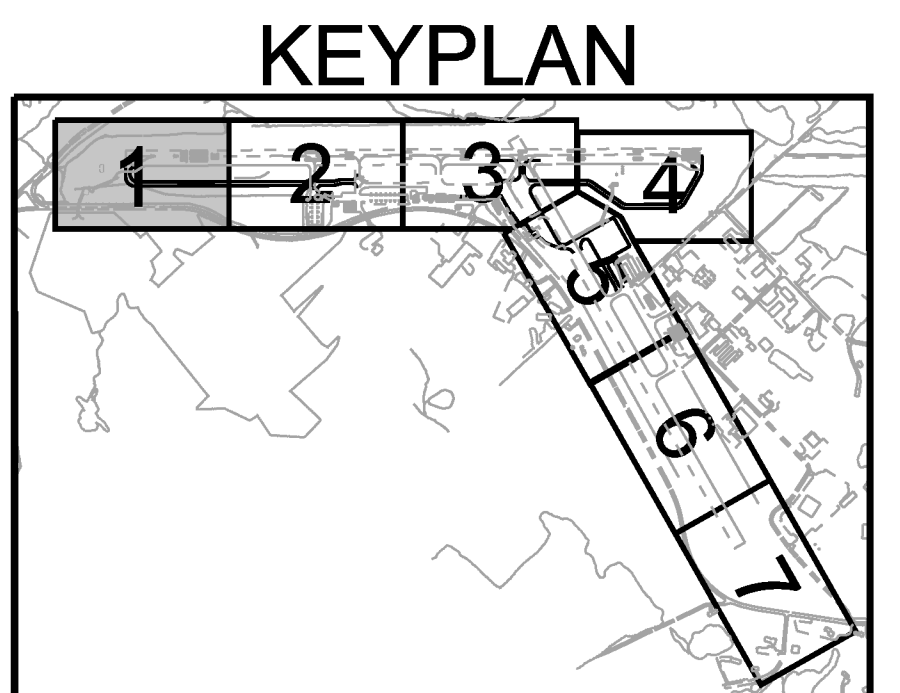

**Hoyle, Tanner & Associates, Inc.**  
 150 Dow Street  
 Manchester, NH 03101-1227  
 Tel 603-669-5555  
 Fax 603-669-4168  
 Web Page: [www.hoyletanner.com](http://www.hoyletanner.com)  
Hoyle, Tanner & Associates © 2008

|   |                       |
|---|-----------------------|
| PROJECT NAME: E. F. KNAPP STATE AIRPORT |                       |
| A.I.P. 3-50-001-011-2009                |                       |
| PROJECT NUMBER: BERLIN AIR 04-3216      |                       |
| FILE NAME: 302803_sht_demo.dgn          | PLOT DATE: 11/22/2011 |
| PROJECT LEADER: S. FORTNEY              | DRAWN BY: D. STANDISH |
| DESIGNED BY: S. BOUCHARD                | CHECKED BY: J. DOWNAR |
| DEMOLITION SHT 1                        | SHEET 59 OF 173       |