

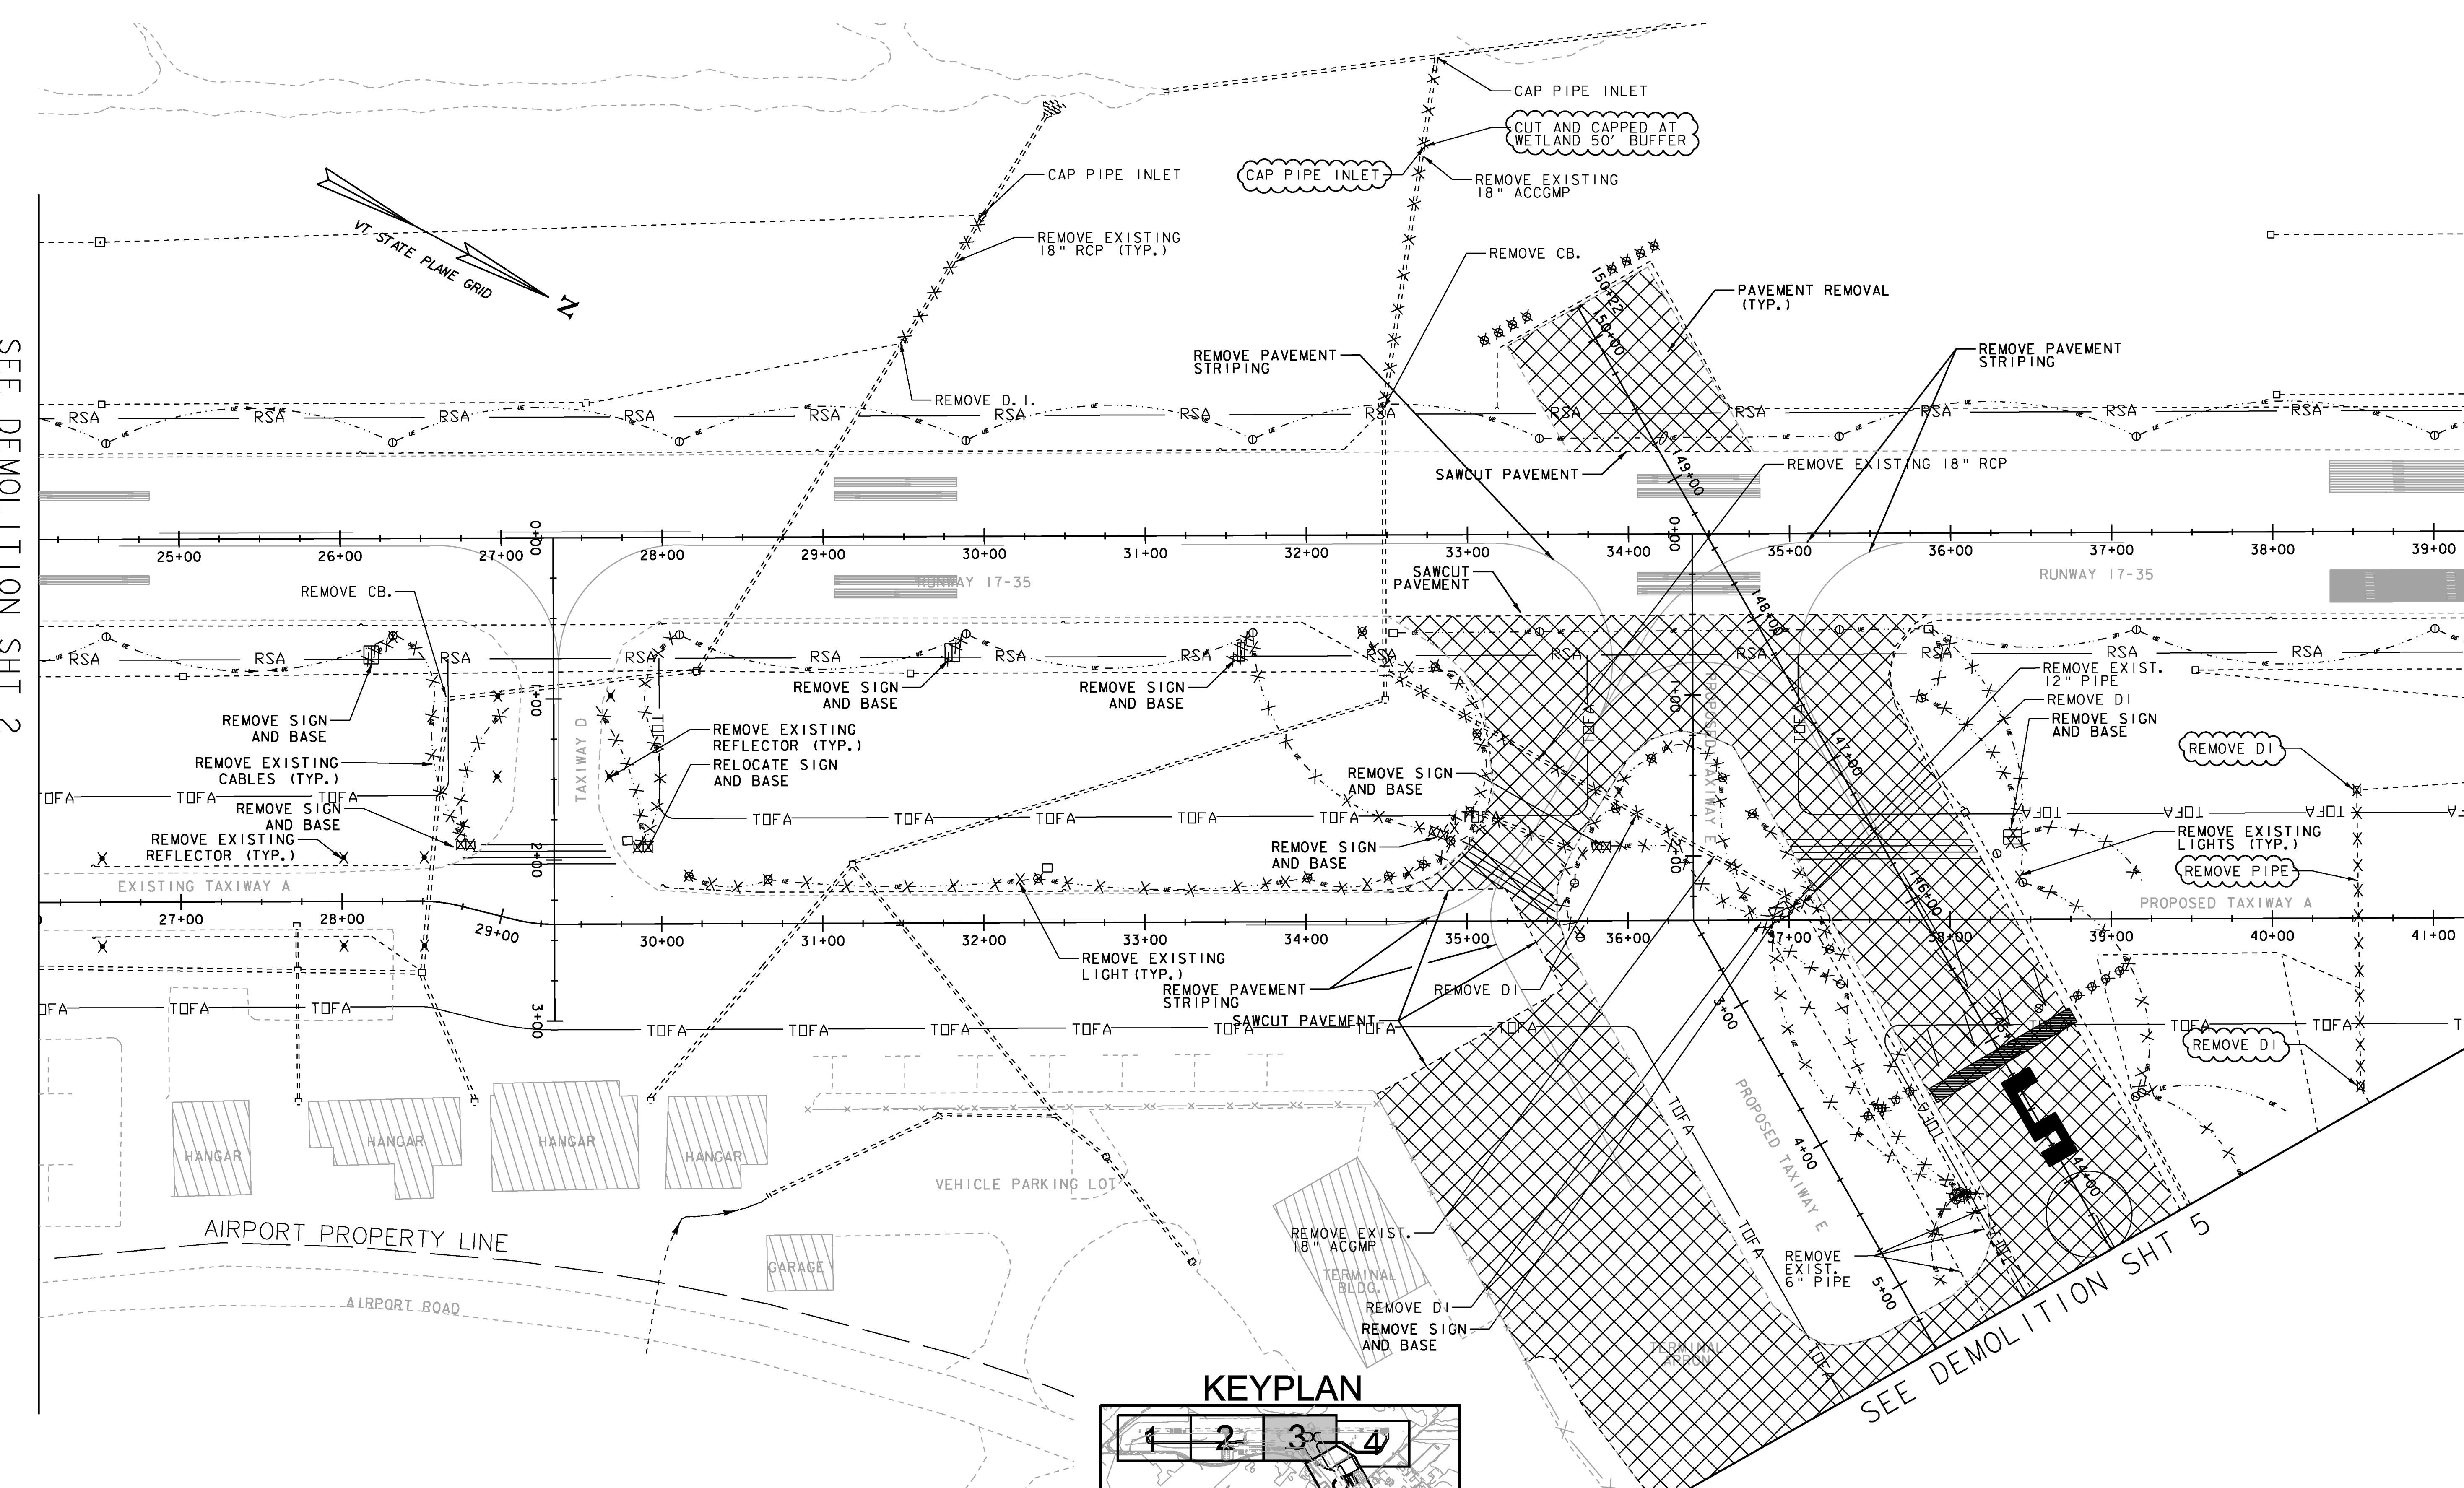


SEE DEMOLITION SHT 2

SEE DEMOLITION SHT 4

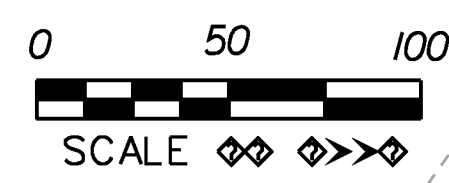

KEYPLAN

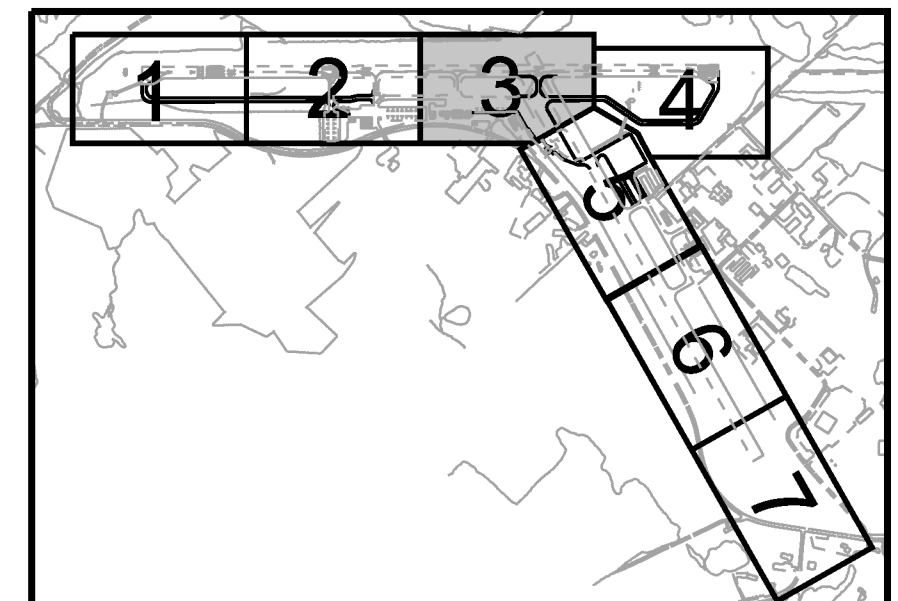

Hoyle, Tanner & Associates, Inc.
 150 Dow Street
 Manchester, NH 03101-1227
 Tel 603-669-5555
 Fax 603-669-4168
 Web Page: www.hoyletanner.com
Hoyle, Tanner & Associates © 2008

PROJECT NAME: E.F. KNAPP STATE AIRPORT A.I.P. 3-50-0001-011-2009 PROJECT NUMBER: BERLIN AIR 04-3216	FILE NAME: 302803_sht_demo.dgn PROJECT LEADER: S. FORTNEY DESIGNED BY: S. BOUCHARD DEMOLITION SHT 3	PLOT DATE: 11/22/2011 DRAWN BY: D. STANDISH CHECKED BY: J. DOWNAR SHEET 61 OF 173
---	--	--

SEE DEMOLITION SHT 5