

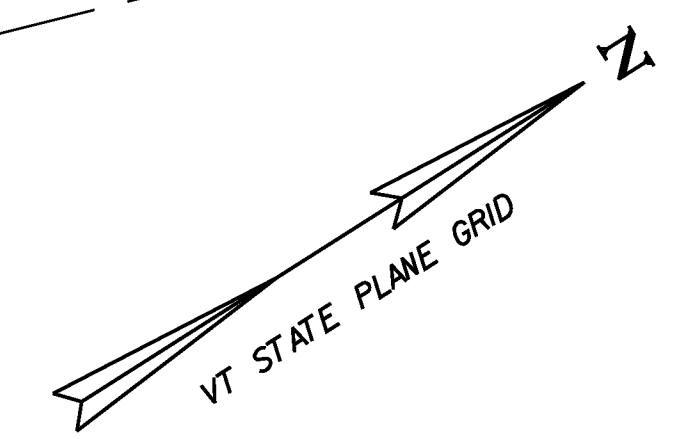


SEE DEMOLITION SHT 6


REMOVE EXISTING CABLE (TYP.)
PAVEMENT REMOVAL (TYP.)
REMOVE EXISTING LIGHTING (TYP.)

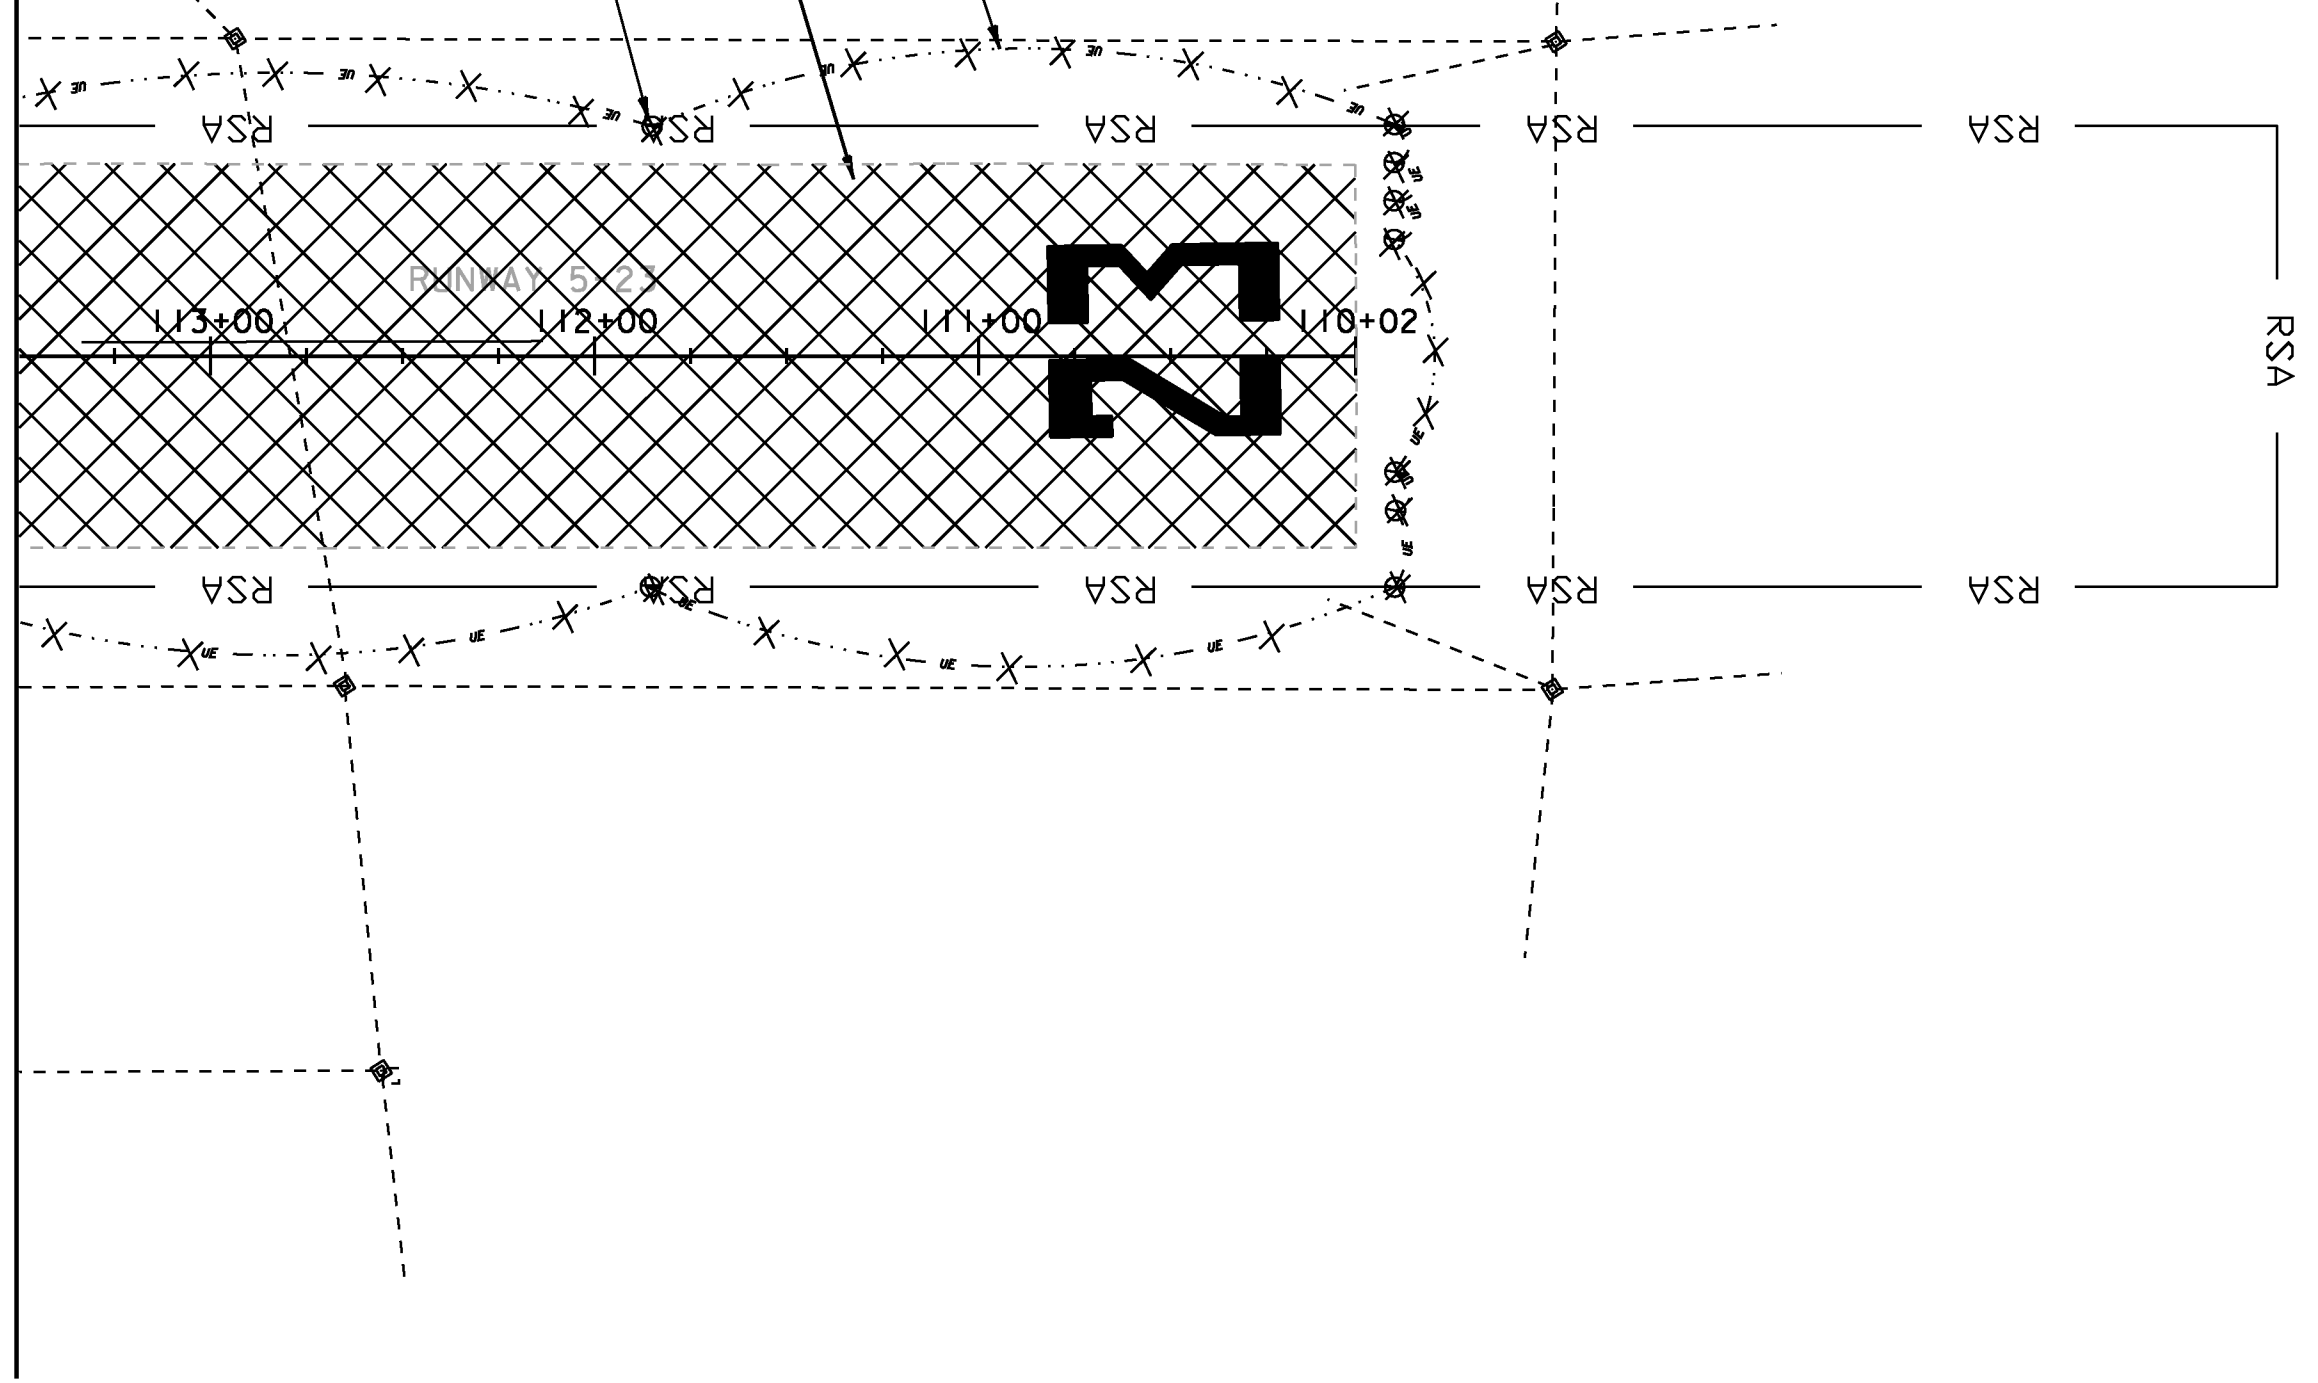

AIRPORT ROAD
AIRPORT PROPERTY LINE

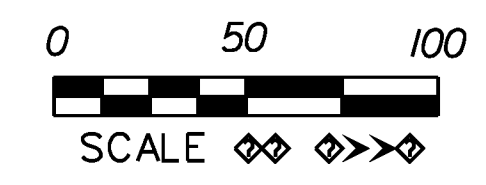

KEYPLAN

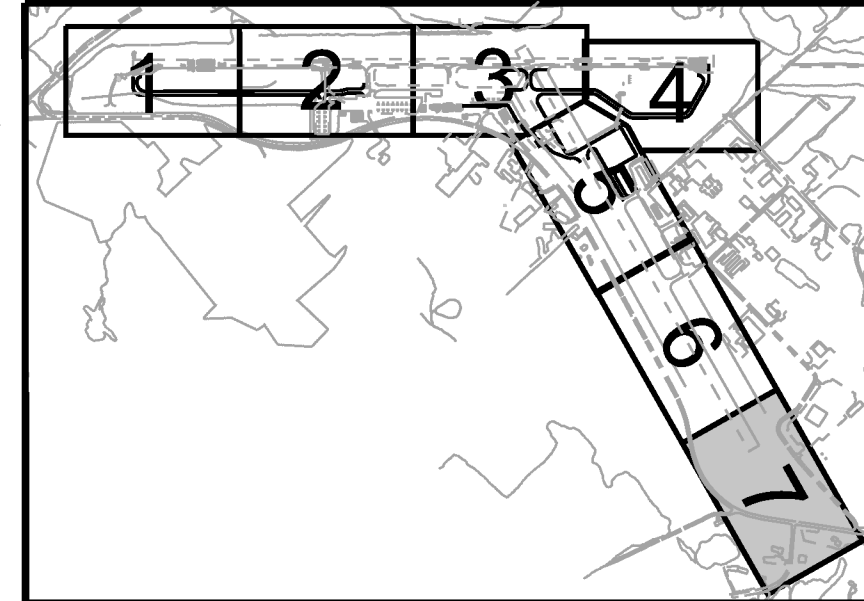

Hoyle, Tanner & Associates, Inc.
150 Dow Street
Manchester, NH 03101-1227
Tel 603-669-5555
Fax 603-669-4168
Web Page: www.hoyletanner.com
Hoyle Tanner & Associates © 2008

PROJECT NAME: E. F. KNAPP STATE AIRPORT
A.I.P. 3-50-0001-011-2009
PROJECT NUMBER: BERLIN AIR 04-3216
FILE NAME: 302803_sht_demo.dgn
PROJECT LEADER: S. FORTNEY
DESIGNED BY: S. BOUCHARD
DEMOLITION SHT 7
PLOT DATE: 11/22/2011
DRAWN BY: D. STANDISH
CHECKED BY: J. DOWNAR
SHEET 65 OF 173