
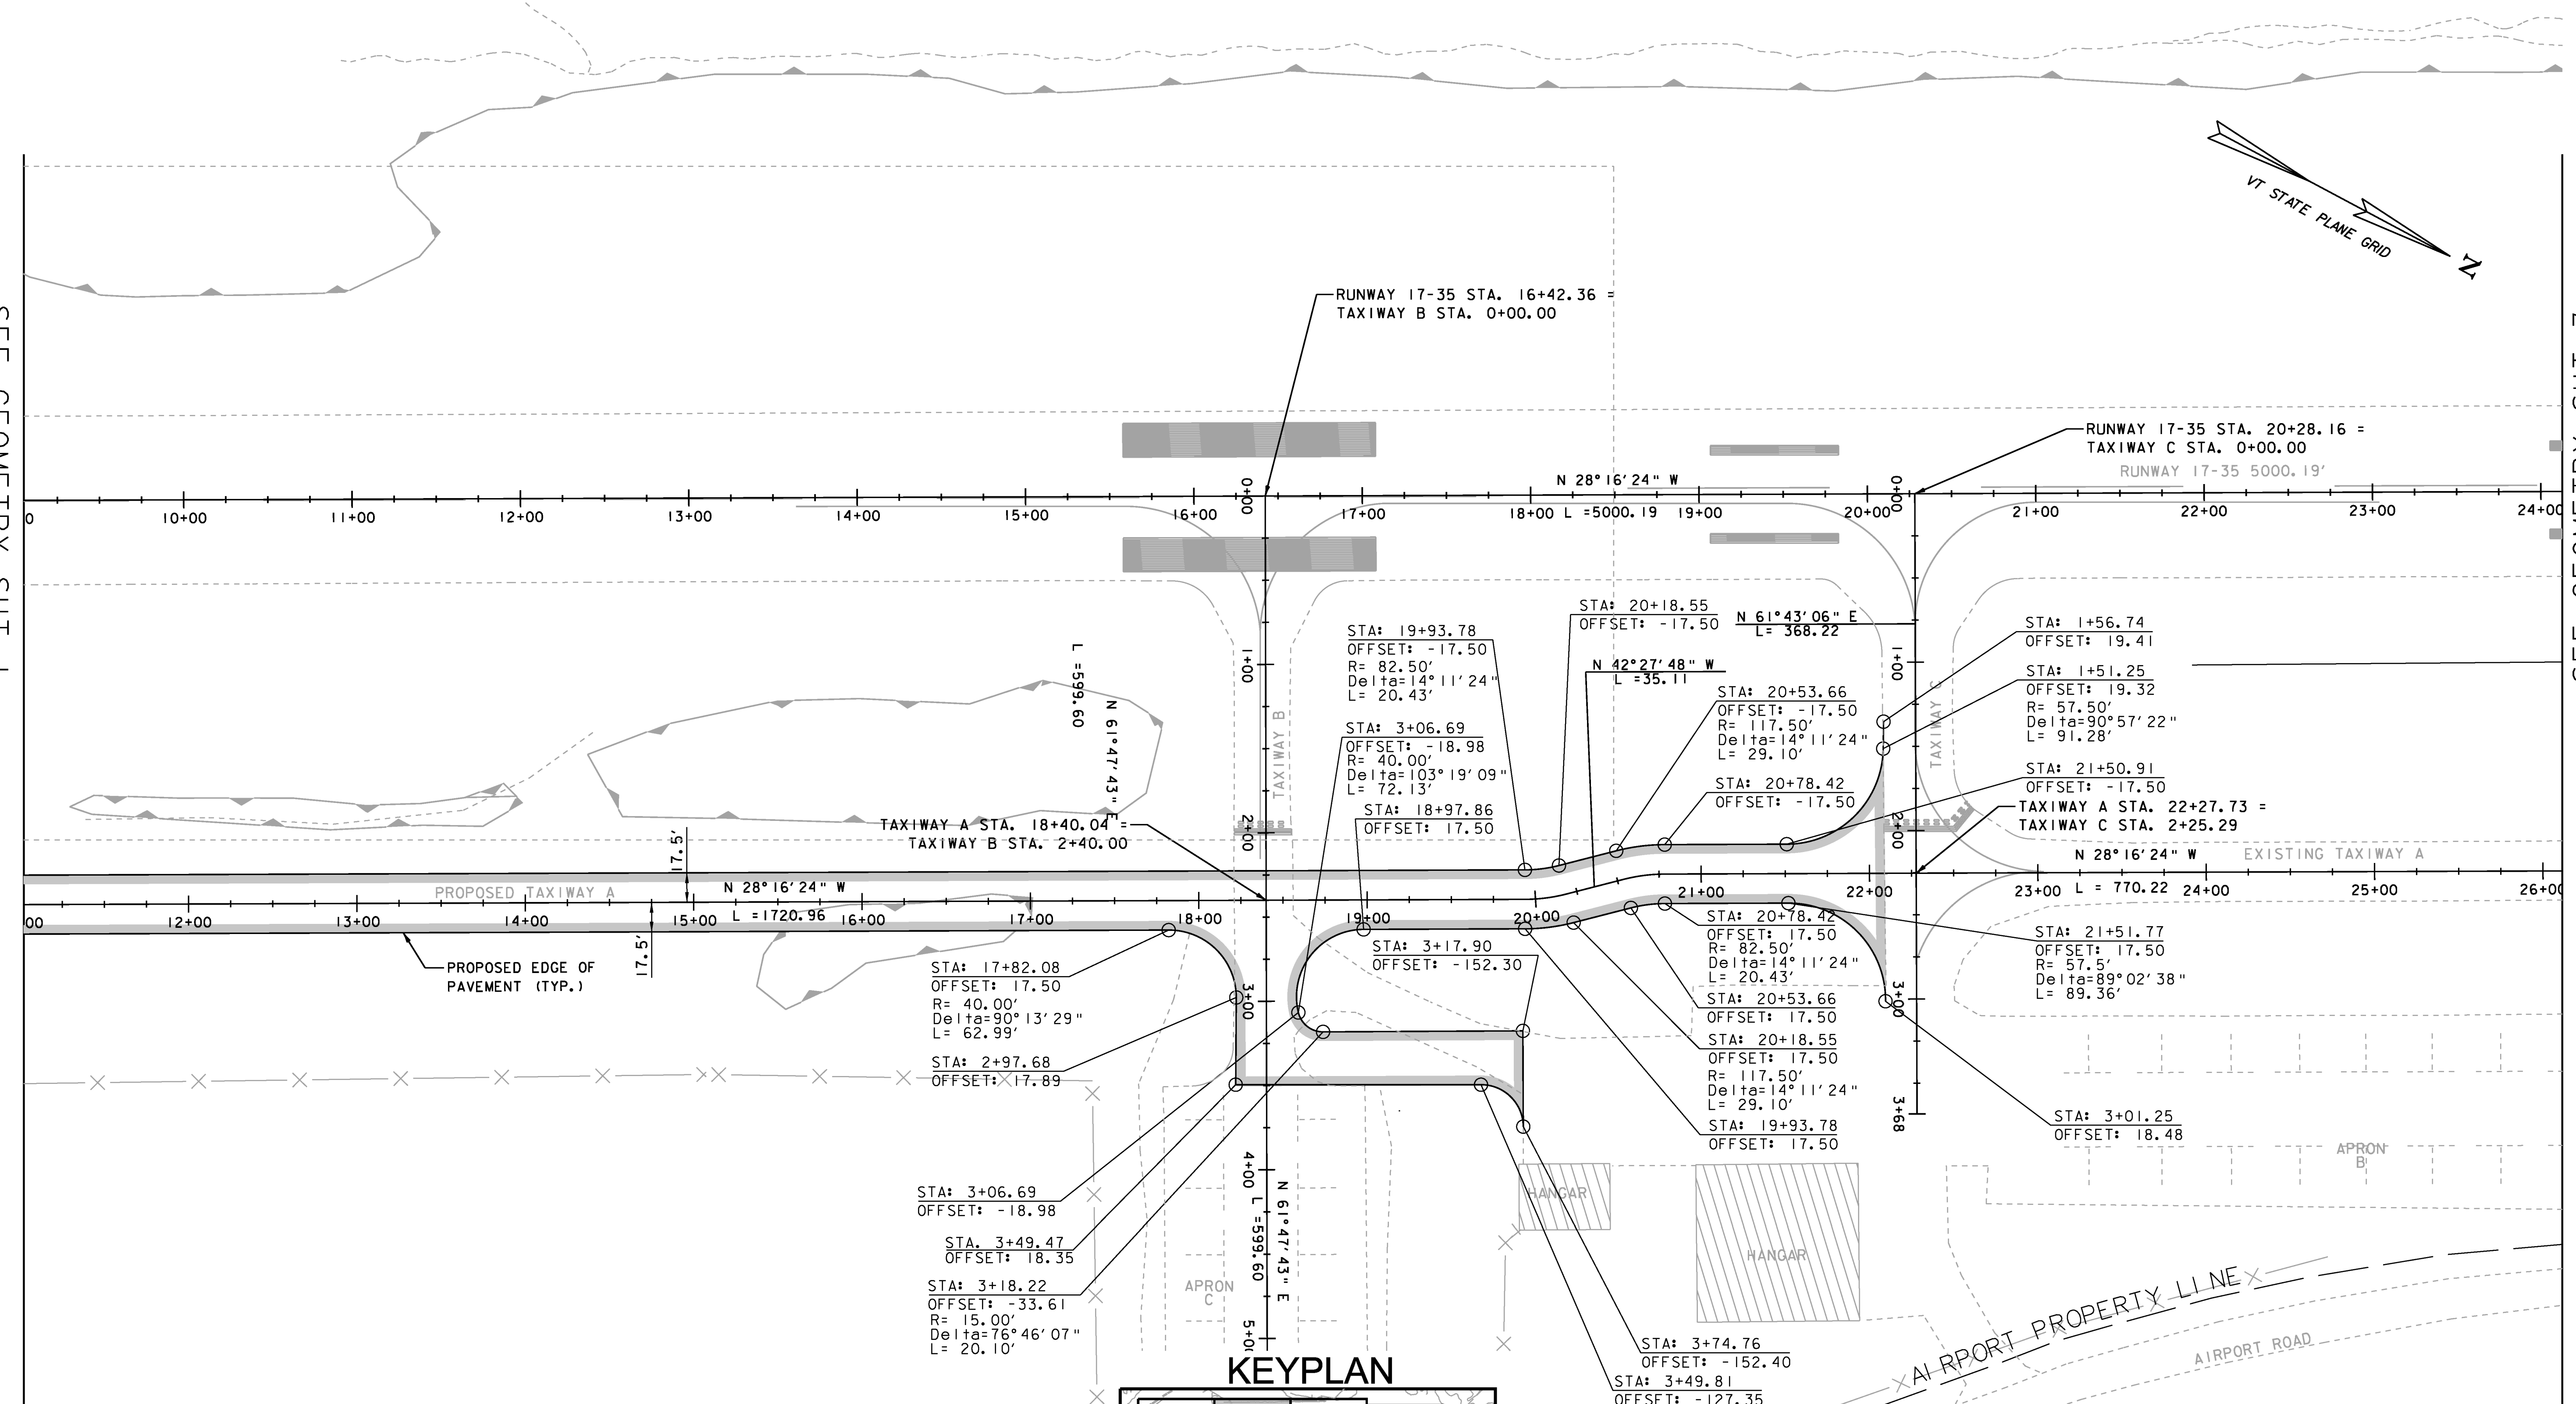




SEE GEOMETRY SHT 1

SEE GEOMETRY SHT 3

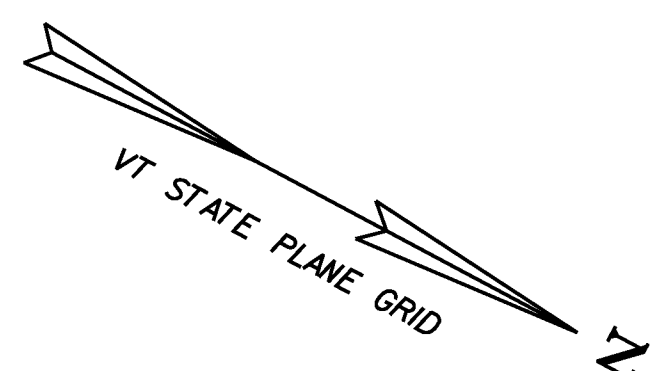

**CURVE C2:**  
 PI= 20+06.23  
 PC= 19+93.78  
 PT= 20+18.55  
 DELTA= 14°11'24"  
 R= 100.00  
 T= 12.45  
 L= 24.77

**CURVE C3:**  
 PI= 20+66.10  
 PC= 20+53.66  
 PT= 20+78.42  
 DELTA= 14°11'24"  
 R= 100.00  
 T= 12.45  
 L= 24.77

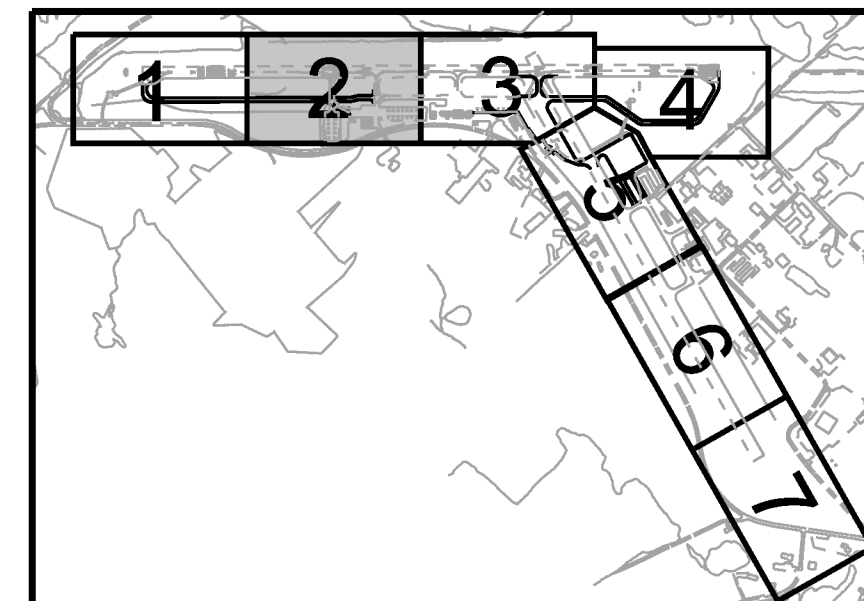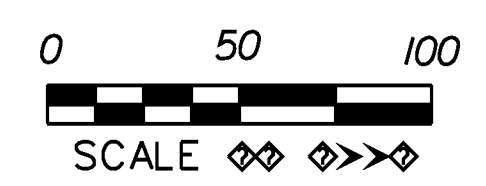

**Hoyle, Tanner & Associates, Inc.**  
 150 Dow Street  
 Manchester, NH 03101-1227  
 Tel 603-669-5555  
 Fax 603-669-4168  
 Web Page: www.hoyletanner.com  
Hoyle, Tanner & Associates © 2008

PROJECT NAME: E. F. KNAPP STATE AIRPORT  
 A.I.P. 3-50-0001-011-2009  
 PROJECT NUMBER: BERLIN AIR 04-3216

FILE NAME: 302803\_sht\_geom.dgn  
 PROJECT LEADER: S. FORTNEY  
 DESIGNED BY: S. BOUCHARD  
 GEOMETRY SHT 2

PLOT DATE: 11/22/2011  
 DRAWN BY: D. STANDISH  
 CHECKED BY: J. DOWNAR  
 SHEET 67 OF 173