

AIRPORT PROPERTY LINE

STA: 126+37.66
 OFFSET: 114.06
 R= 75.00'
 Delta=91°11'21"
 L= 119.37'

STA: 126+01.95
 OFFSET: 110.75
 R= 75.00'
 Delta=88°39'52"
 L= 116.06'

STA: 127+12.64
 OFFSET: 37.50

STA: 125+26.97
 OFFSET: 37.50

REDESIGNATED TAXIWAY H

SEE GEOMETRY SHT 5

SEE GEOMETRY SHT 7

128+00 127+00 126+00 125+00 124+00 123+00 122+00 121+00 L=4020.43 120+00 119+00 118+00 117+00 116+00 115+00 114+00



RUNWAY 5-23
 S 32°25'23" W

PROPOSED EDGE OF PAVEMENT (TYP.)

AIRPORT PROPERTY LINE

AIRPORT ROAD

KEYPLAN

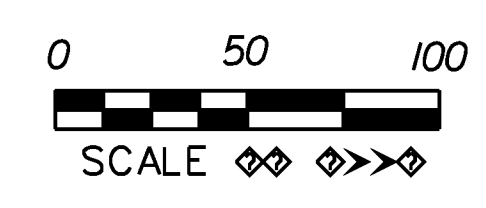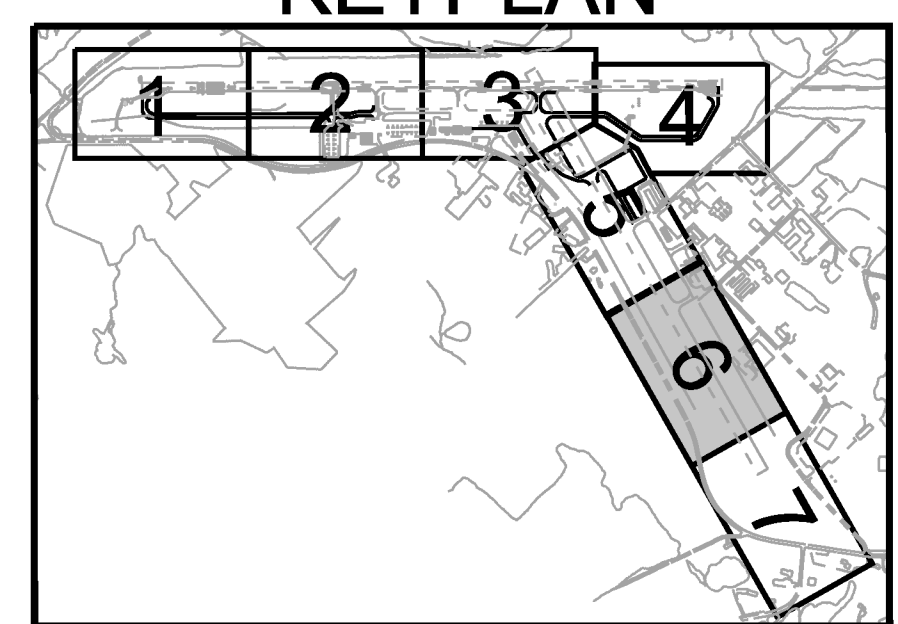

Hoyle, Tanner & Associates, Inc.
 150 Dow Street
 Manchester, NH 03101-1227
 Tel 603-669-5555
 Fax 603-669-4168
 Web Page: www.hoyletanner.com
Hoyle, Tanner & Associates © 2008

PROJECT NAME: E. F. KNAPP STATE AIRPORT	
A.I.P. 3-50-0001-011-2009	
PROJECT NUMBER: BERLIN AIR 04-3216	
FILE NAME: 302803_sht_geom.dgn	PLOT DATE: 11/22/2011
PROJECT LEADER: S. FORTNEY	DRAWN BY: D. STANDISH
DESIGNED BY: S. BOUCHARD	CHECKED BY: J. DOWNAR
GEOMETRY SHT 6	SHEET 71 OF 173