
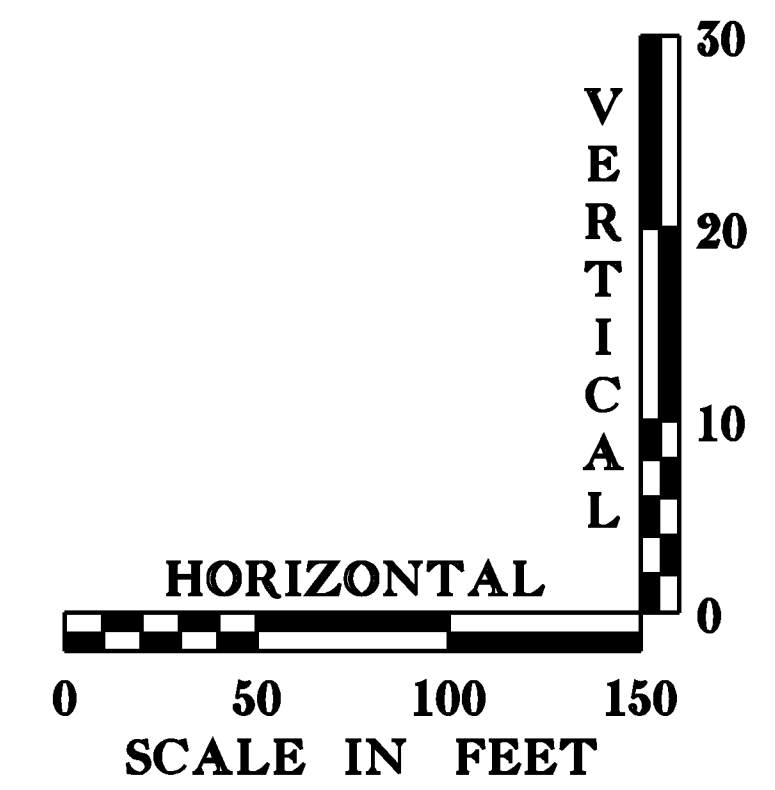


# TAXIWAY F PROFILE

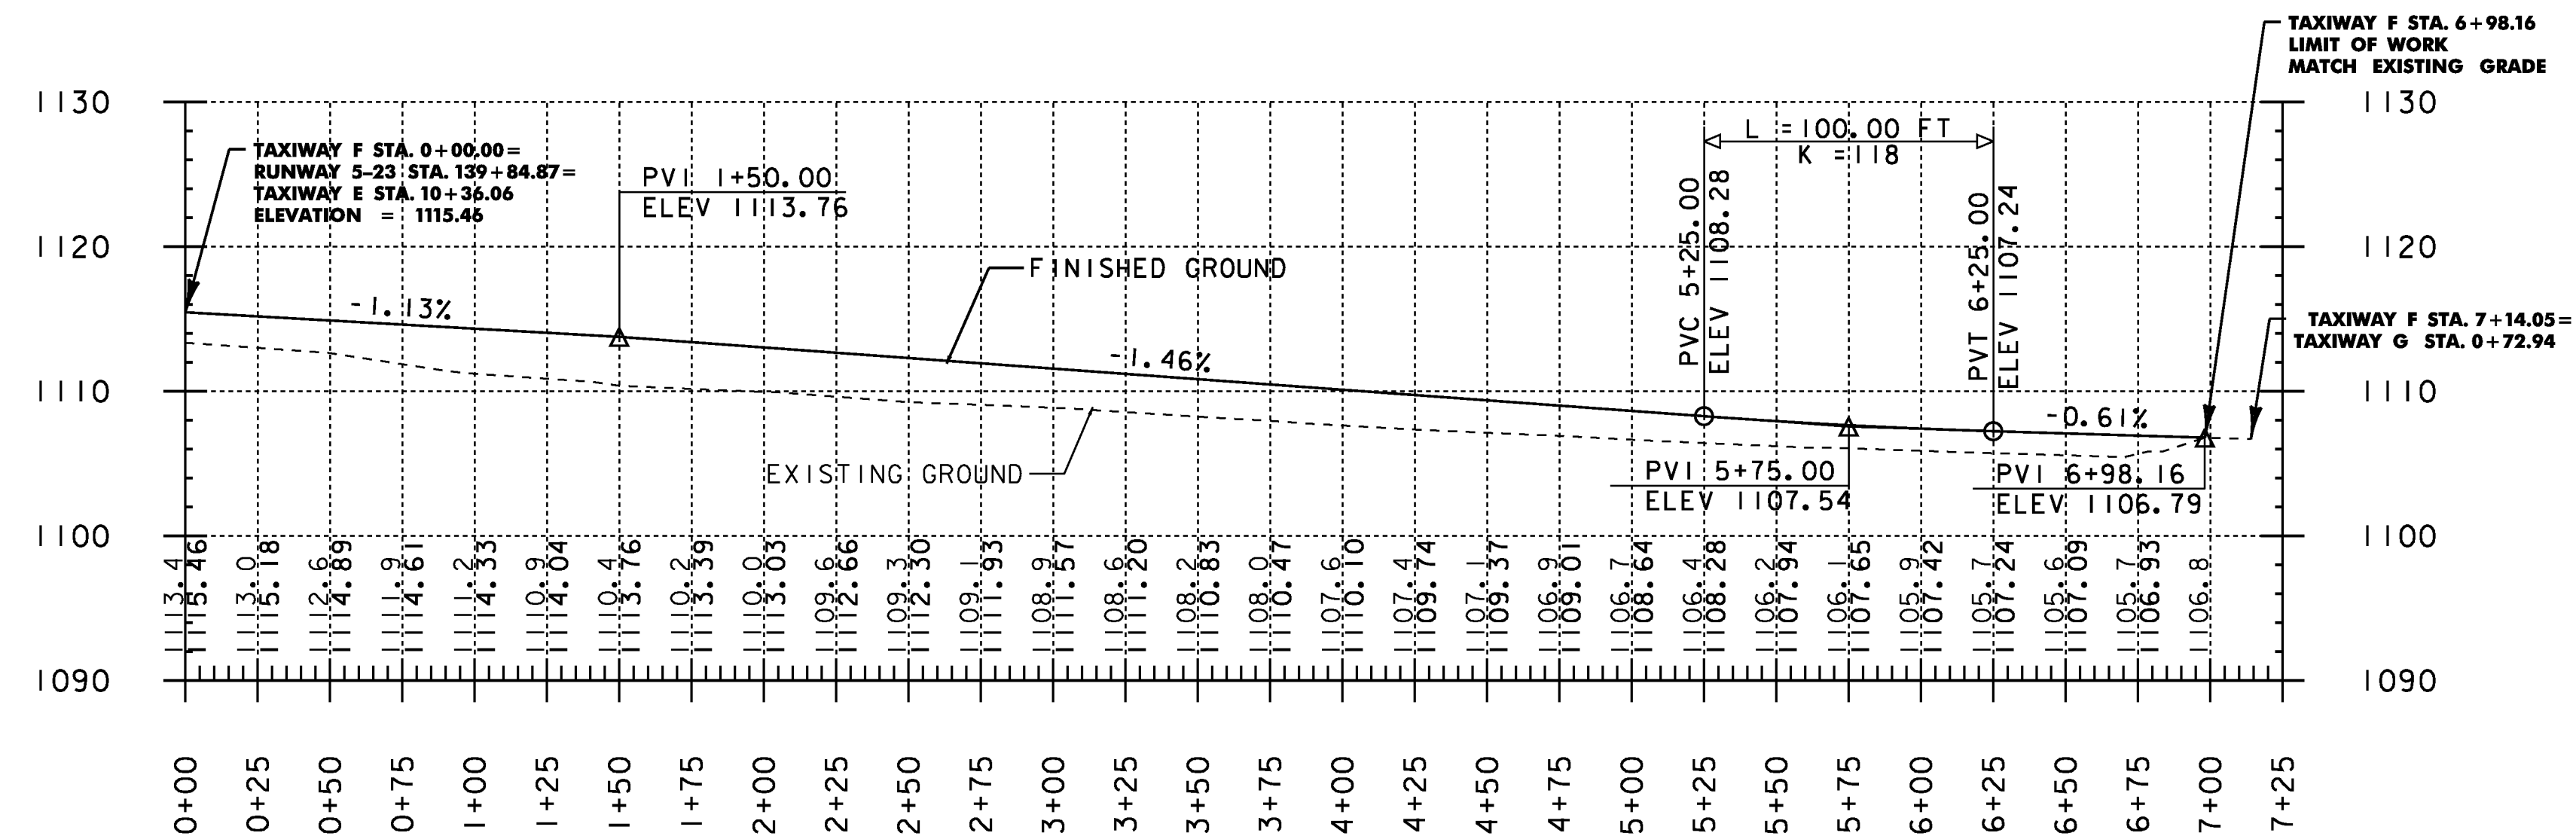

**Hoyle, Tanner & Associates, Inc.**

150 Dow Street  
Manchester, NH 03101-1227  
Tel 603-669-5555  
Fax 603-669-4168  
Web Page: [www.hoyletanner.com](http://www.hoyletanner.com)  
Hoyle, Tanner & Associates © 2008

PROJECT NAME: E. F. KNAPP STATE AIRPORT  
A.I.P. 3-50-0001-011-2009  
PROJECT NUMBER: BERLIN AIR 04-3216

FILE NAME: 302803\_sht\_prof\_F.dgn  
PROJECT LEADER: S. FORTNEY  
DESIGNED BY: S. BOUCHARD  
TAXIWAY F PROFILE

PLOT DATE: 11/22/2011  
DRAWN BY: D. STANDISH  
CHECKED BY: J. DOWNAR  
SHEET 79 OF 173