



RW 5-23

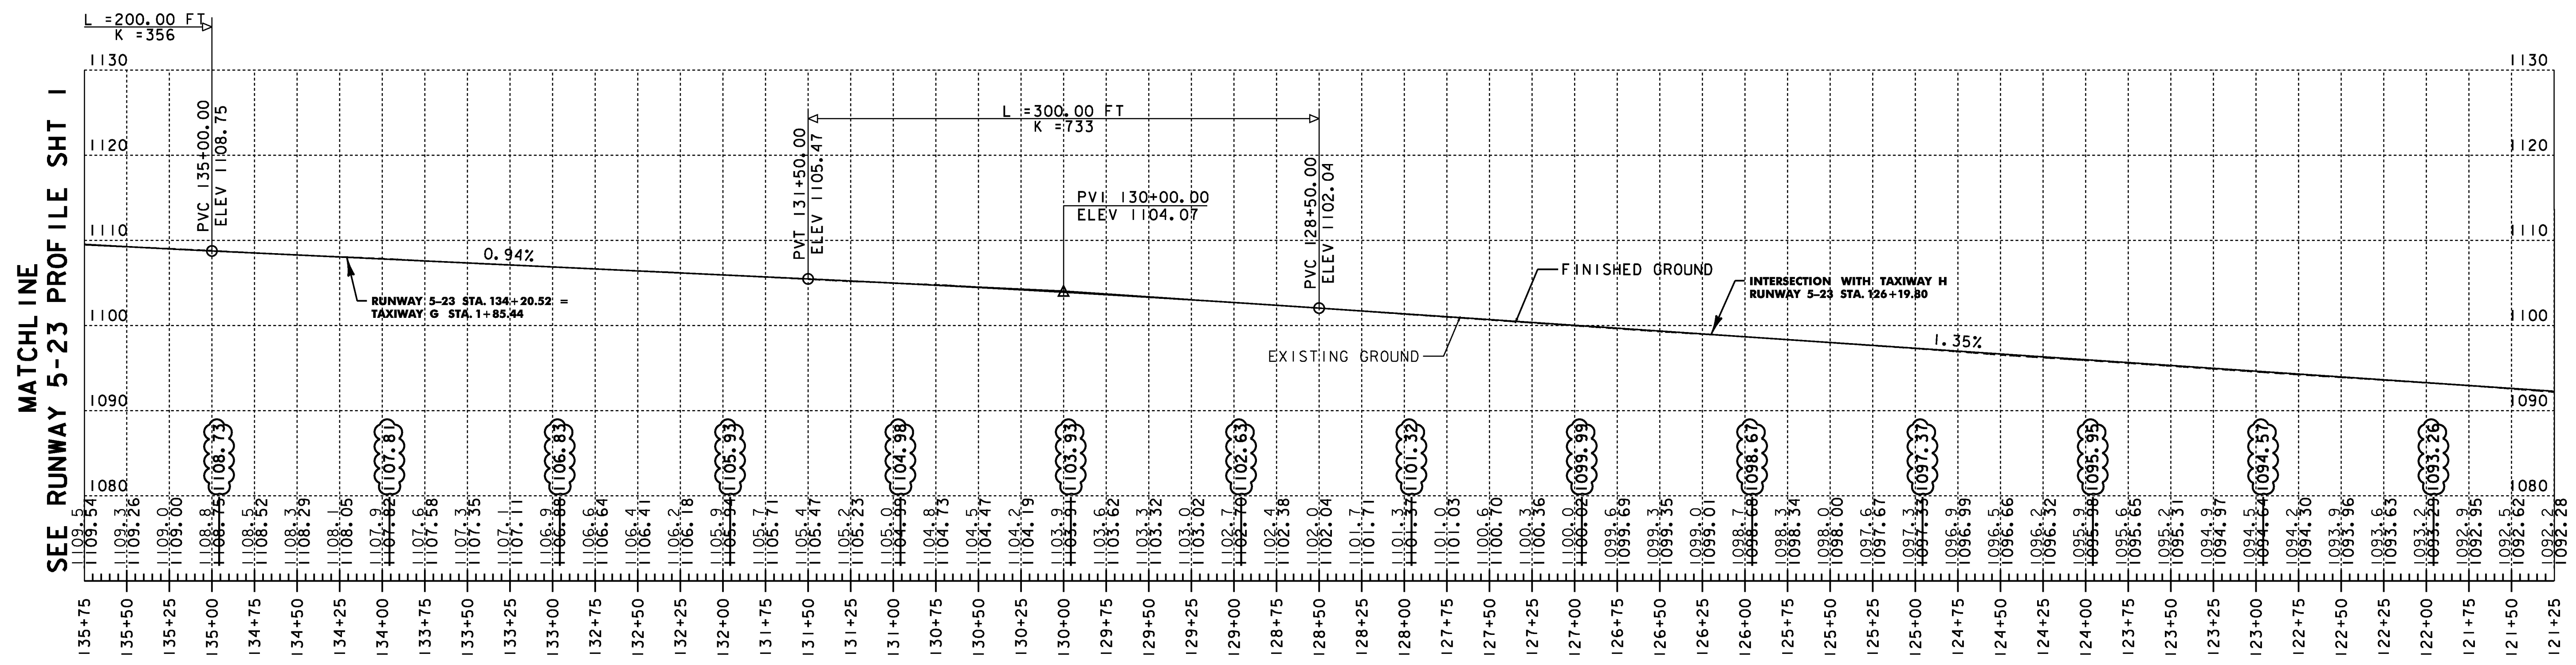

MATCHLINE
SEE RUNWAY 5-23 PROFILE SHT 1

MATCHLINE
SEE RUNWAY 5-23 PROFILE SHT 3

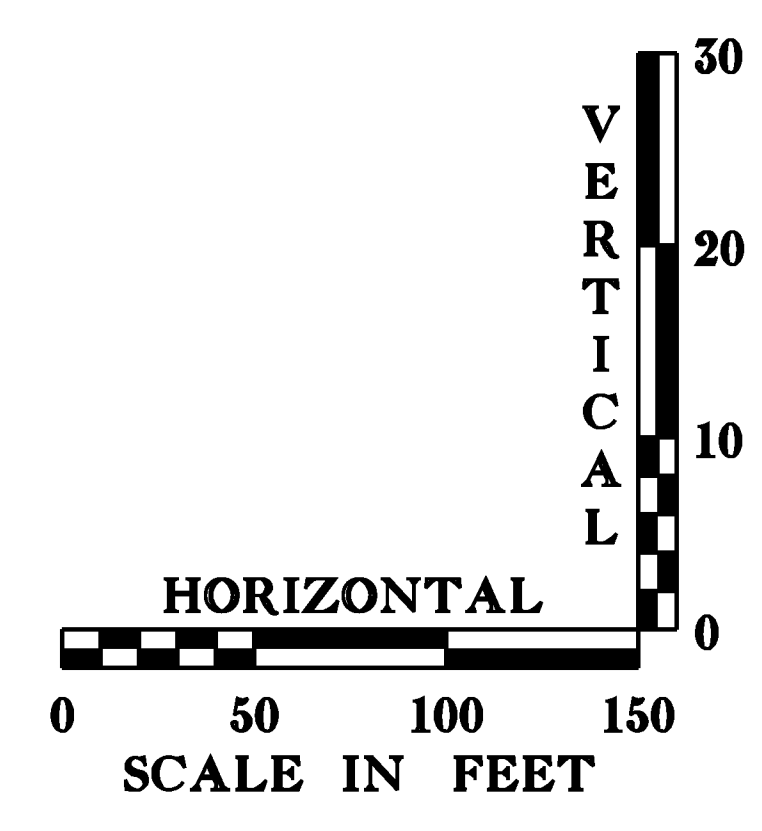

Hoyle, Tanner & Associates, Inc.
 150 Dow Street
 Manchester, NH 03101-1227
 Tel 603-669-5555
 Fax 603-669-4168
 Web Page: www.hoyletanner.com
Hoyle Tanner & Associates © 2008

PROJECT NAME: E. F. KNAPP STATE AIRPORT	PROJECT NUMBER: BERLIN AIR 04-3216
A.I.P. 3-50-0001-011-2009	FILE NAME: 302803_sht_prof_5-23.dgn
PROJECT LEADER: S. FORTNEY	PLOT DATE: 11/22/2011
DESIGNED BY: S. BOUCHARD	DRAWN BY: D. STANDISH
RUNWAY 5-23 PROFILE SHT 2	CHECKED BY: J. DOWNAR
	SHEET 82 OF 173