
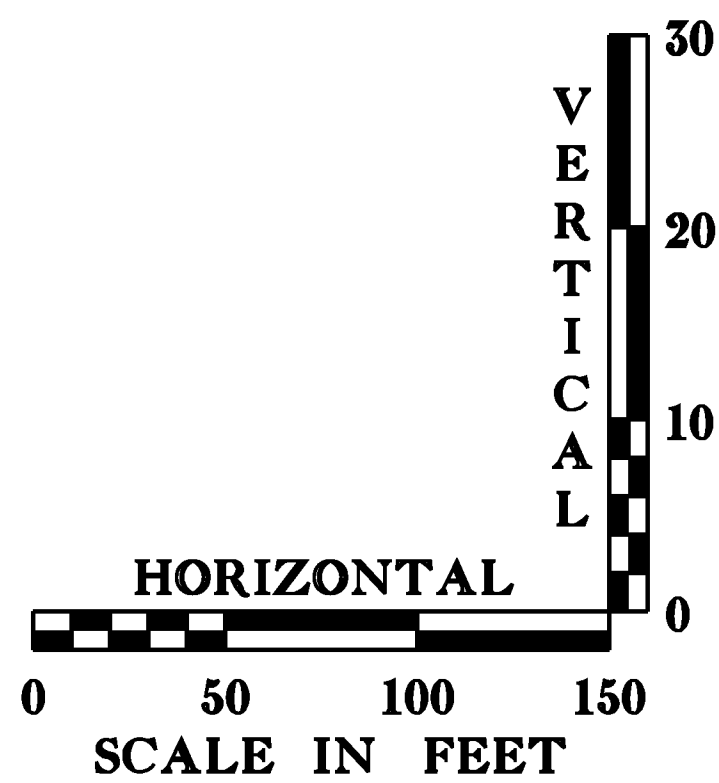


MATCHLINE
SEE RUNWAY 5-23 PROFILE SHT 2

RW 5-23

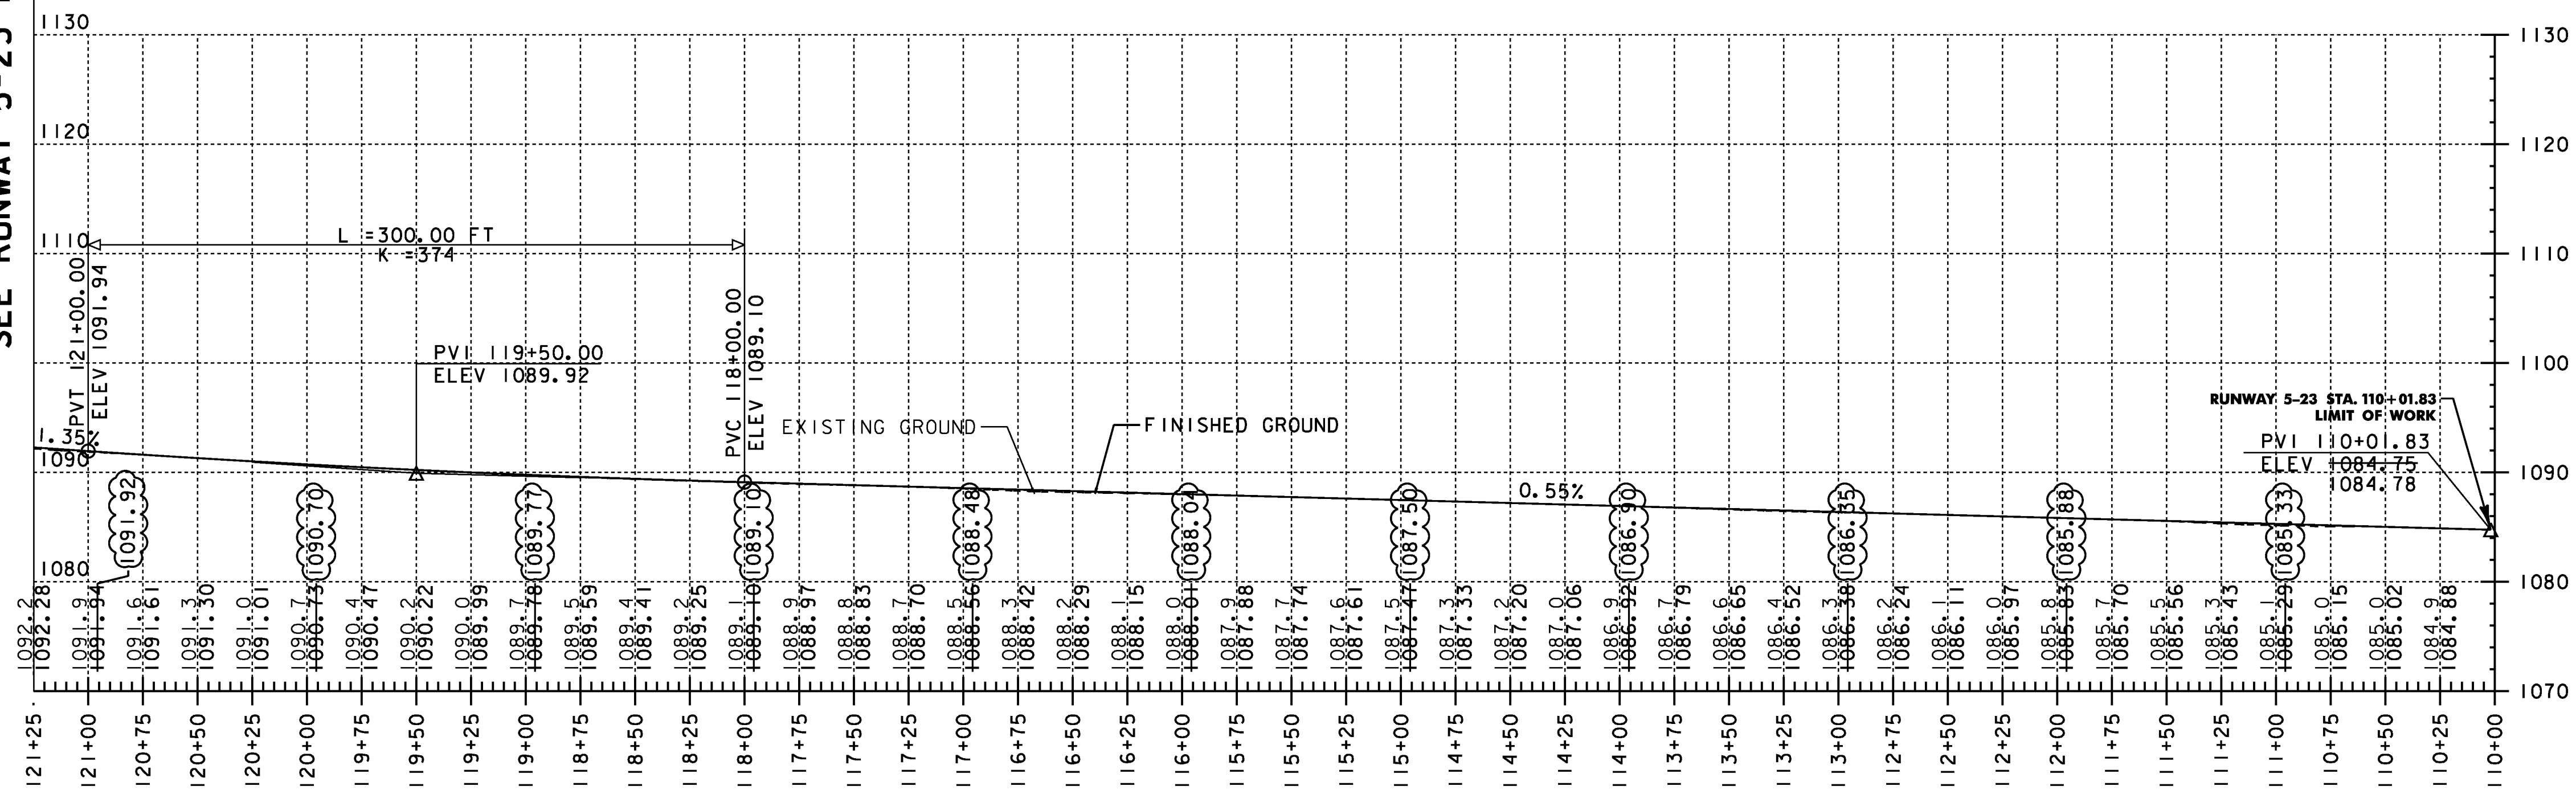

Hoyle, Tanner & Associates, Inc.

150 Dow Street
 Manchester, NH 03101-1227
 Tel 603-669-5555
 Fax 603-669-4168
 Web Page: www.hoyletanner.com
Hoyle Tanner & Associates © 2008

PROJECT NAME: E. F. KNAPP STATE AIRPORT
 A.I.P. 3-50-0001-011-2009
 PROJECT NUMBER: BERLIN AIR 04-3216
 FILE NAME: 302803_sht_prof_5-23.dgn PLOT DATE: 11/22/2011
 PROJECT LEADER: S. FORTNEY DRAWN BY: D. STANDISH
 DESIGNED BY: S. BOUCHARD CHECKED BY: J. DOWNAR
 RUNWAY 5-23 PROFILE SHT 3 SHEET 83 OF 173