
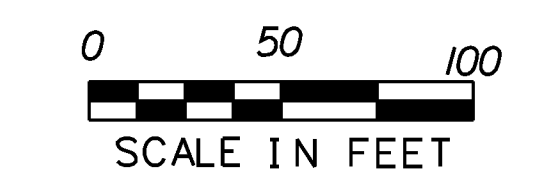


SEE GRADING SHT 3

SEE GRADING SHT 5

- LEGEND**
- WORK AREA
 - PROPOSED PAVEMENT
 - EXISTING WETLANDS SYMBOL
 - EXISTING DRAIN PIPE
 - EXISTING UNDERDRAIN
 - EXISTING CB
 - STABILIZED CONSTRUCTION ENTRANCE
 - PROPOSED CB
 - PROPOSED DRAIN PIPE
 - PROPOSED UNDERDRAIN
 - SLOPE LIMITS
 - LIGHTED BARRICADE
 - RIP RAP

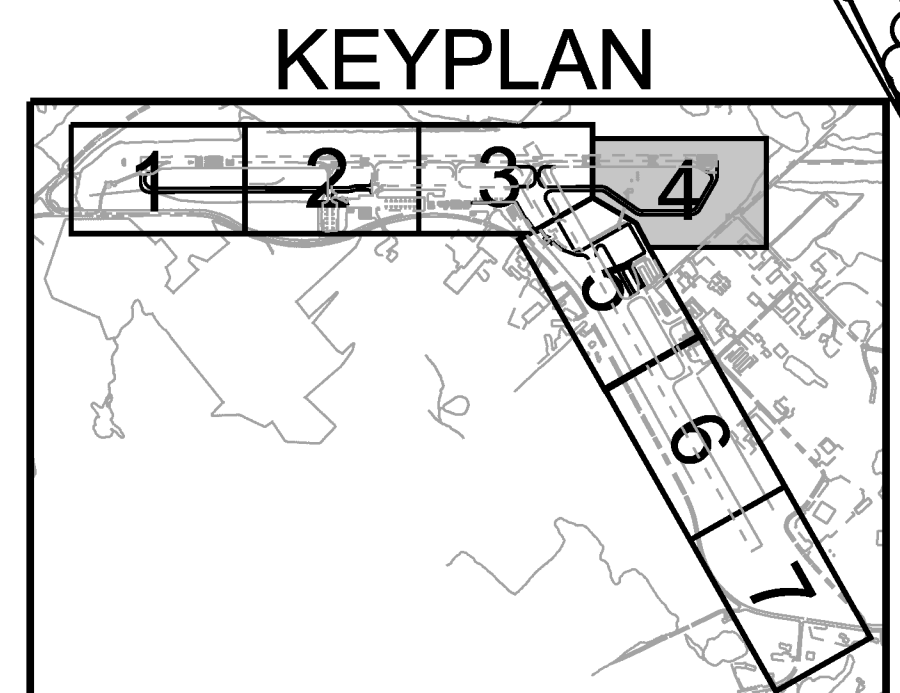

Hoyle, Tanner & Associates, Inc.
 150 Dow Street
 Manchester, NH 03101-1227
 Tel 603-669-5555
 Fax 603-669-4168
 Web Page: www.hoyletanner.com
Hoyle Tanner & Associates © 2008

PROJECT NAME: E. F. KNAPP STATE AIRPORT
 A.I.P. 3-50-0001-011-2009
 PROJECT NUMBER: BERLIN AIR 04-3216
 FILE NAME: 302803_sht_grdg.dgn
 PROJECT LEADER: S. FORTNEY
 DESIGNED BY: S. BOUCHARD
 GRADING SHT 4

PLOT DATE: 11/22/2011
 DRAWN BY: D. STANDISH
 CHECKED BY: J. DOWNAR
 SHEET 87 OF 173