

SEE GRADING SHT 4

SEE GRADING SHT 3


SEE GRADING SHT 6

LEGEND

- | | | | |
|--|----------------------------------|--|---------------------|
| | WORK AREA | | PROPOSED CB |
| | PROPOSED PAVEMENT | | PROPOSED DRAIN PIPE |
| | EXISTING WETLANDS | | PROPOSED UNDERDRAIN |
| | EXISTING DRAIN PIPE | | SLOPE LIMITS |
| | EXISTING UNDERDRAIN | | LIGHTED BARRICADE |
| | EXISTING CB | | RIP RAP |
| | STABILIZED CONSTRUCTION ENTRANCE | | |



KEYPLAN

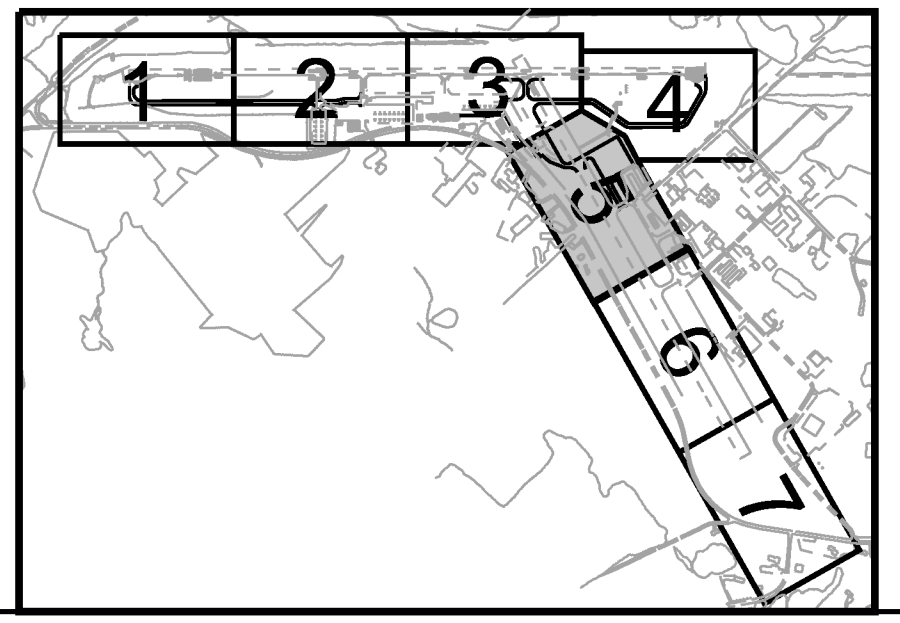

Hoyle, Tanner & Associates, Inc.
 150 Dow Street
 Manchester, NH 03101-1227
 Tel 603-669-5555
 Fax 603-669-4168
 Web Page: www.hoyletanner.com
Hoyle Tanner & Associates © 2008

PROJECT NAME: E. F. KNAPP STATE AIRPORT
 A.I.P. 3-50-0001-011-2009
 PROJECT NUMBER: BERLIN AIR 04-3216
 FILE NAME: 302803_sht_grdg.dgn
 PROJECT LEADER: S. FORTNEY
 DESIGNED BY: S. BOUCHARD
 GRADING SHT 5

PLOT DATE: 11/22/2011
 DRAWN BY: D. STANDISH
 CHECKED BY: J. DOWNAR
 SHEET 88 OF 173