

SEE GRADING SHT 5

SEE GRADING SHT 7

AIRPORT PROPERTY LINE

WINDSOCK RELOCATED TO 115+00, 220.00 LT.

REDESIGNATED TAXIWAY H

RUNWAY 5-23

128+00 127+00 126+00 125+00 124+00 123+00 122+00 121+00 120+00 119+00 118+00 117+00 116+00 115+00 114+00

APPROXIMATE LIMITS OF GRADING (TYP.)




 

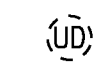
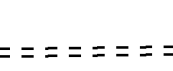
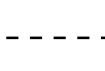
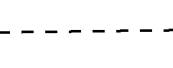
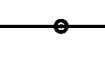
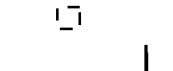
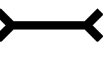
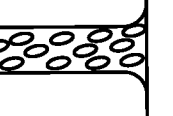
Exist. Wind Cone

AIRPORT PROPERTY LINE

AIRPORT ROAD


RELOCATED WINDSOCK

**LEGEND**

- |   |                                  |   |                     |
|---|----------------------------------|---|---------------------|
|  | WORK AREA                        |  | PROPOSED CB         |
|  | PROPOSED PAVEMENT                |  | PROPOSED DRAIN PIPE |
|  | EXISTING WETLANDS SYMBOL         |  | PROPOSED UNDERDRAIN |
|  | EXISTING DRAIN PIPE              |  | SLOPE LIMITS        |
|  | EXISTING UNDERDRAIN              |  | LIGHTED BARRICADE   |
|  | EXISTING CB                      |  | RIP RAP             |
|  | STABILIZED CONSTRUCTION ENTRANCE |   |                     |



**KEYPLAN**

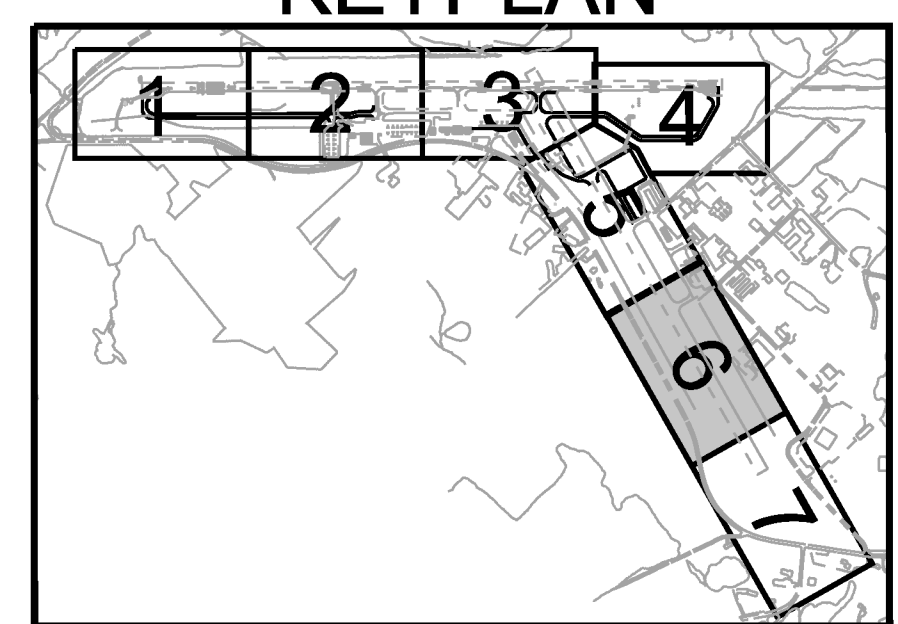

**Hoyle, Tanner & Associates, Inc.**

150 Dow Street  
 Manchester, NH 03101-1227  
 Tel 603-669-5555  
 Fax 603-669-4168  
 Web Page: [www.hoyletanner.com](http://www.hoyletanner.com)  
Hoyle, Tanner & Associates © 2008

PROJECT NAME: E. F. KNAPP STATE AIRPORT	PLOT DATE: 11/22/2011
A.I.P. 3-50-0001-011-2009	DRAWN BY: D. STANDISH
PROJECT NUMBER: BERLIN AIR 04-3216	CHECKED BY: J. DOWNAR
FILE NAME: 302803_sht_grdg.dgn	SHEET 89 OF 173
GRADING SHT 6	