
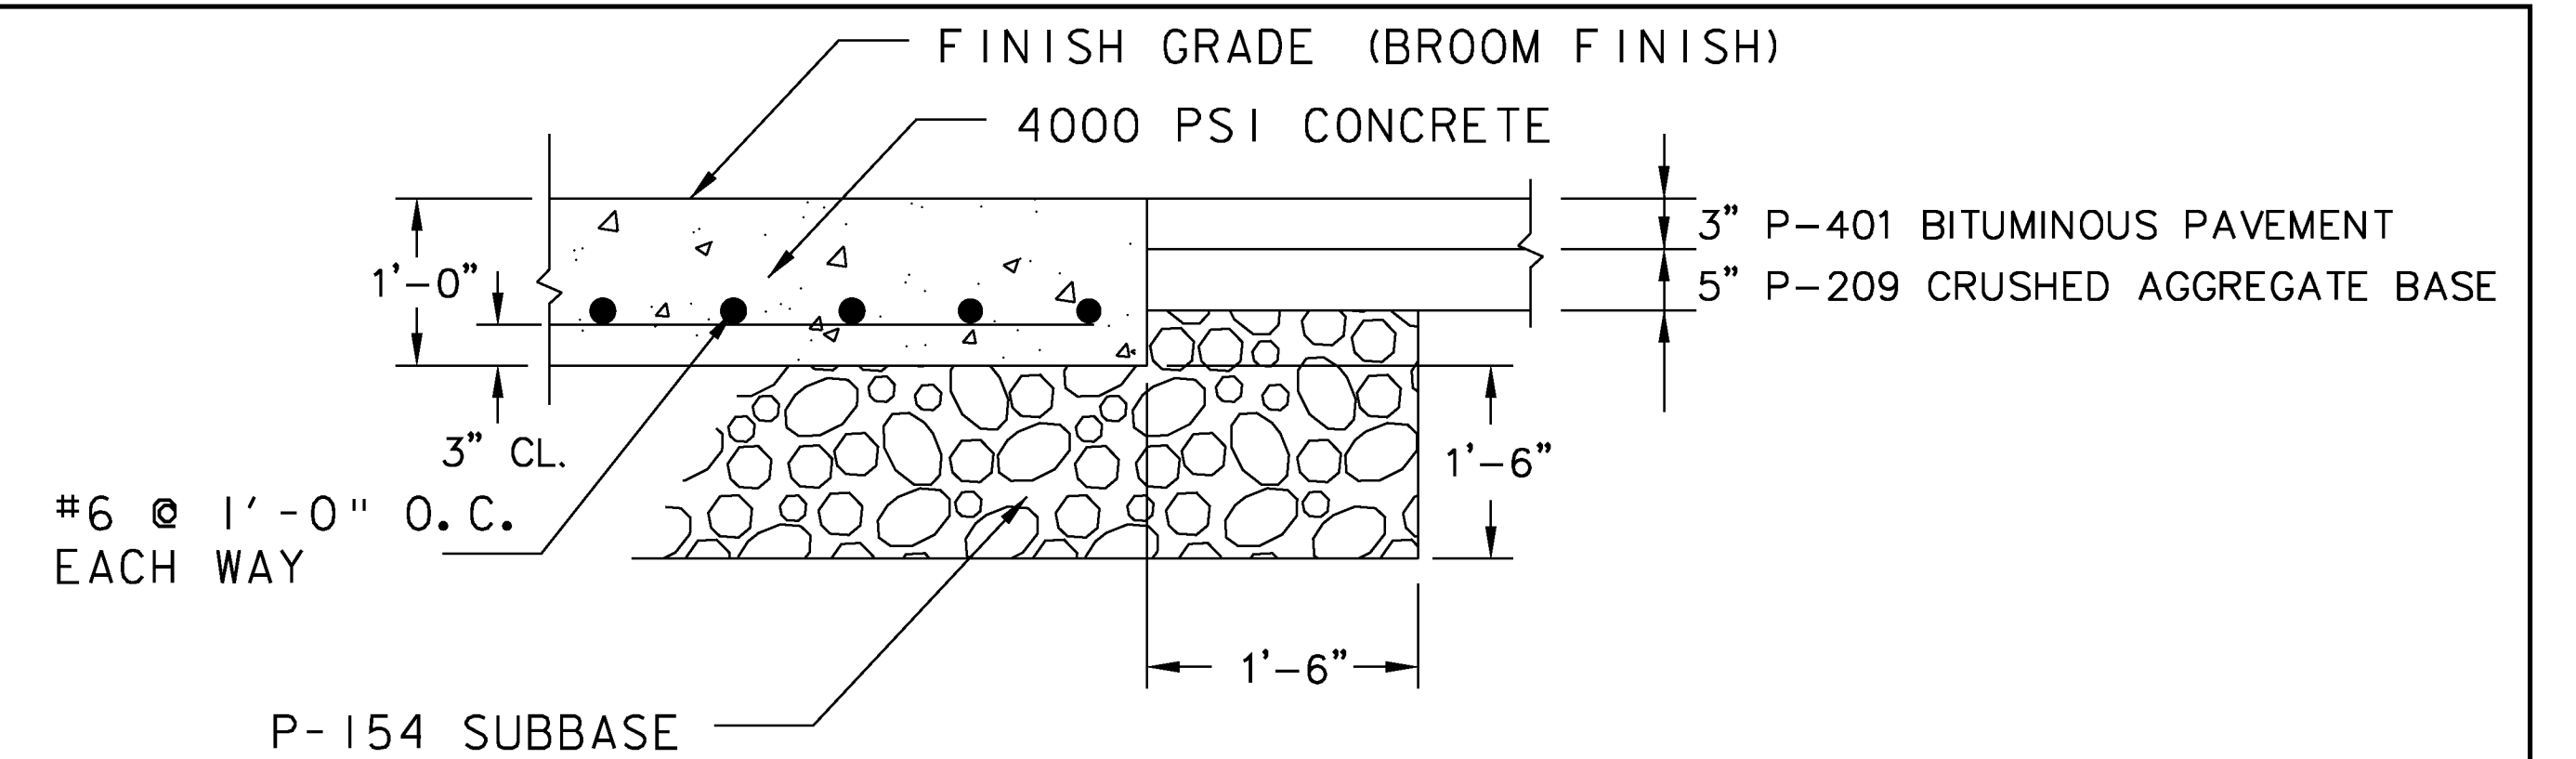



FUEL FACILITY GRADING AND DRAINAGE PLAN

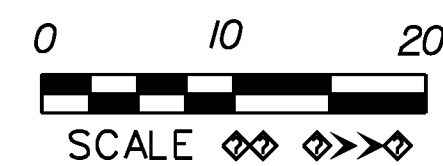

NOTE: HORIZONTAL LAP SPLICE LENGTH TO BE 2'-10" (MINIMUM), ALL SPLICES TO BE STAGGERED.

CONCRETE PAD DETAIL

NOT TO SCALE

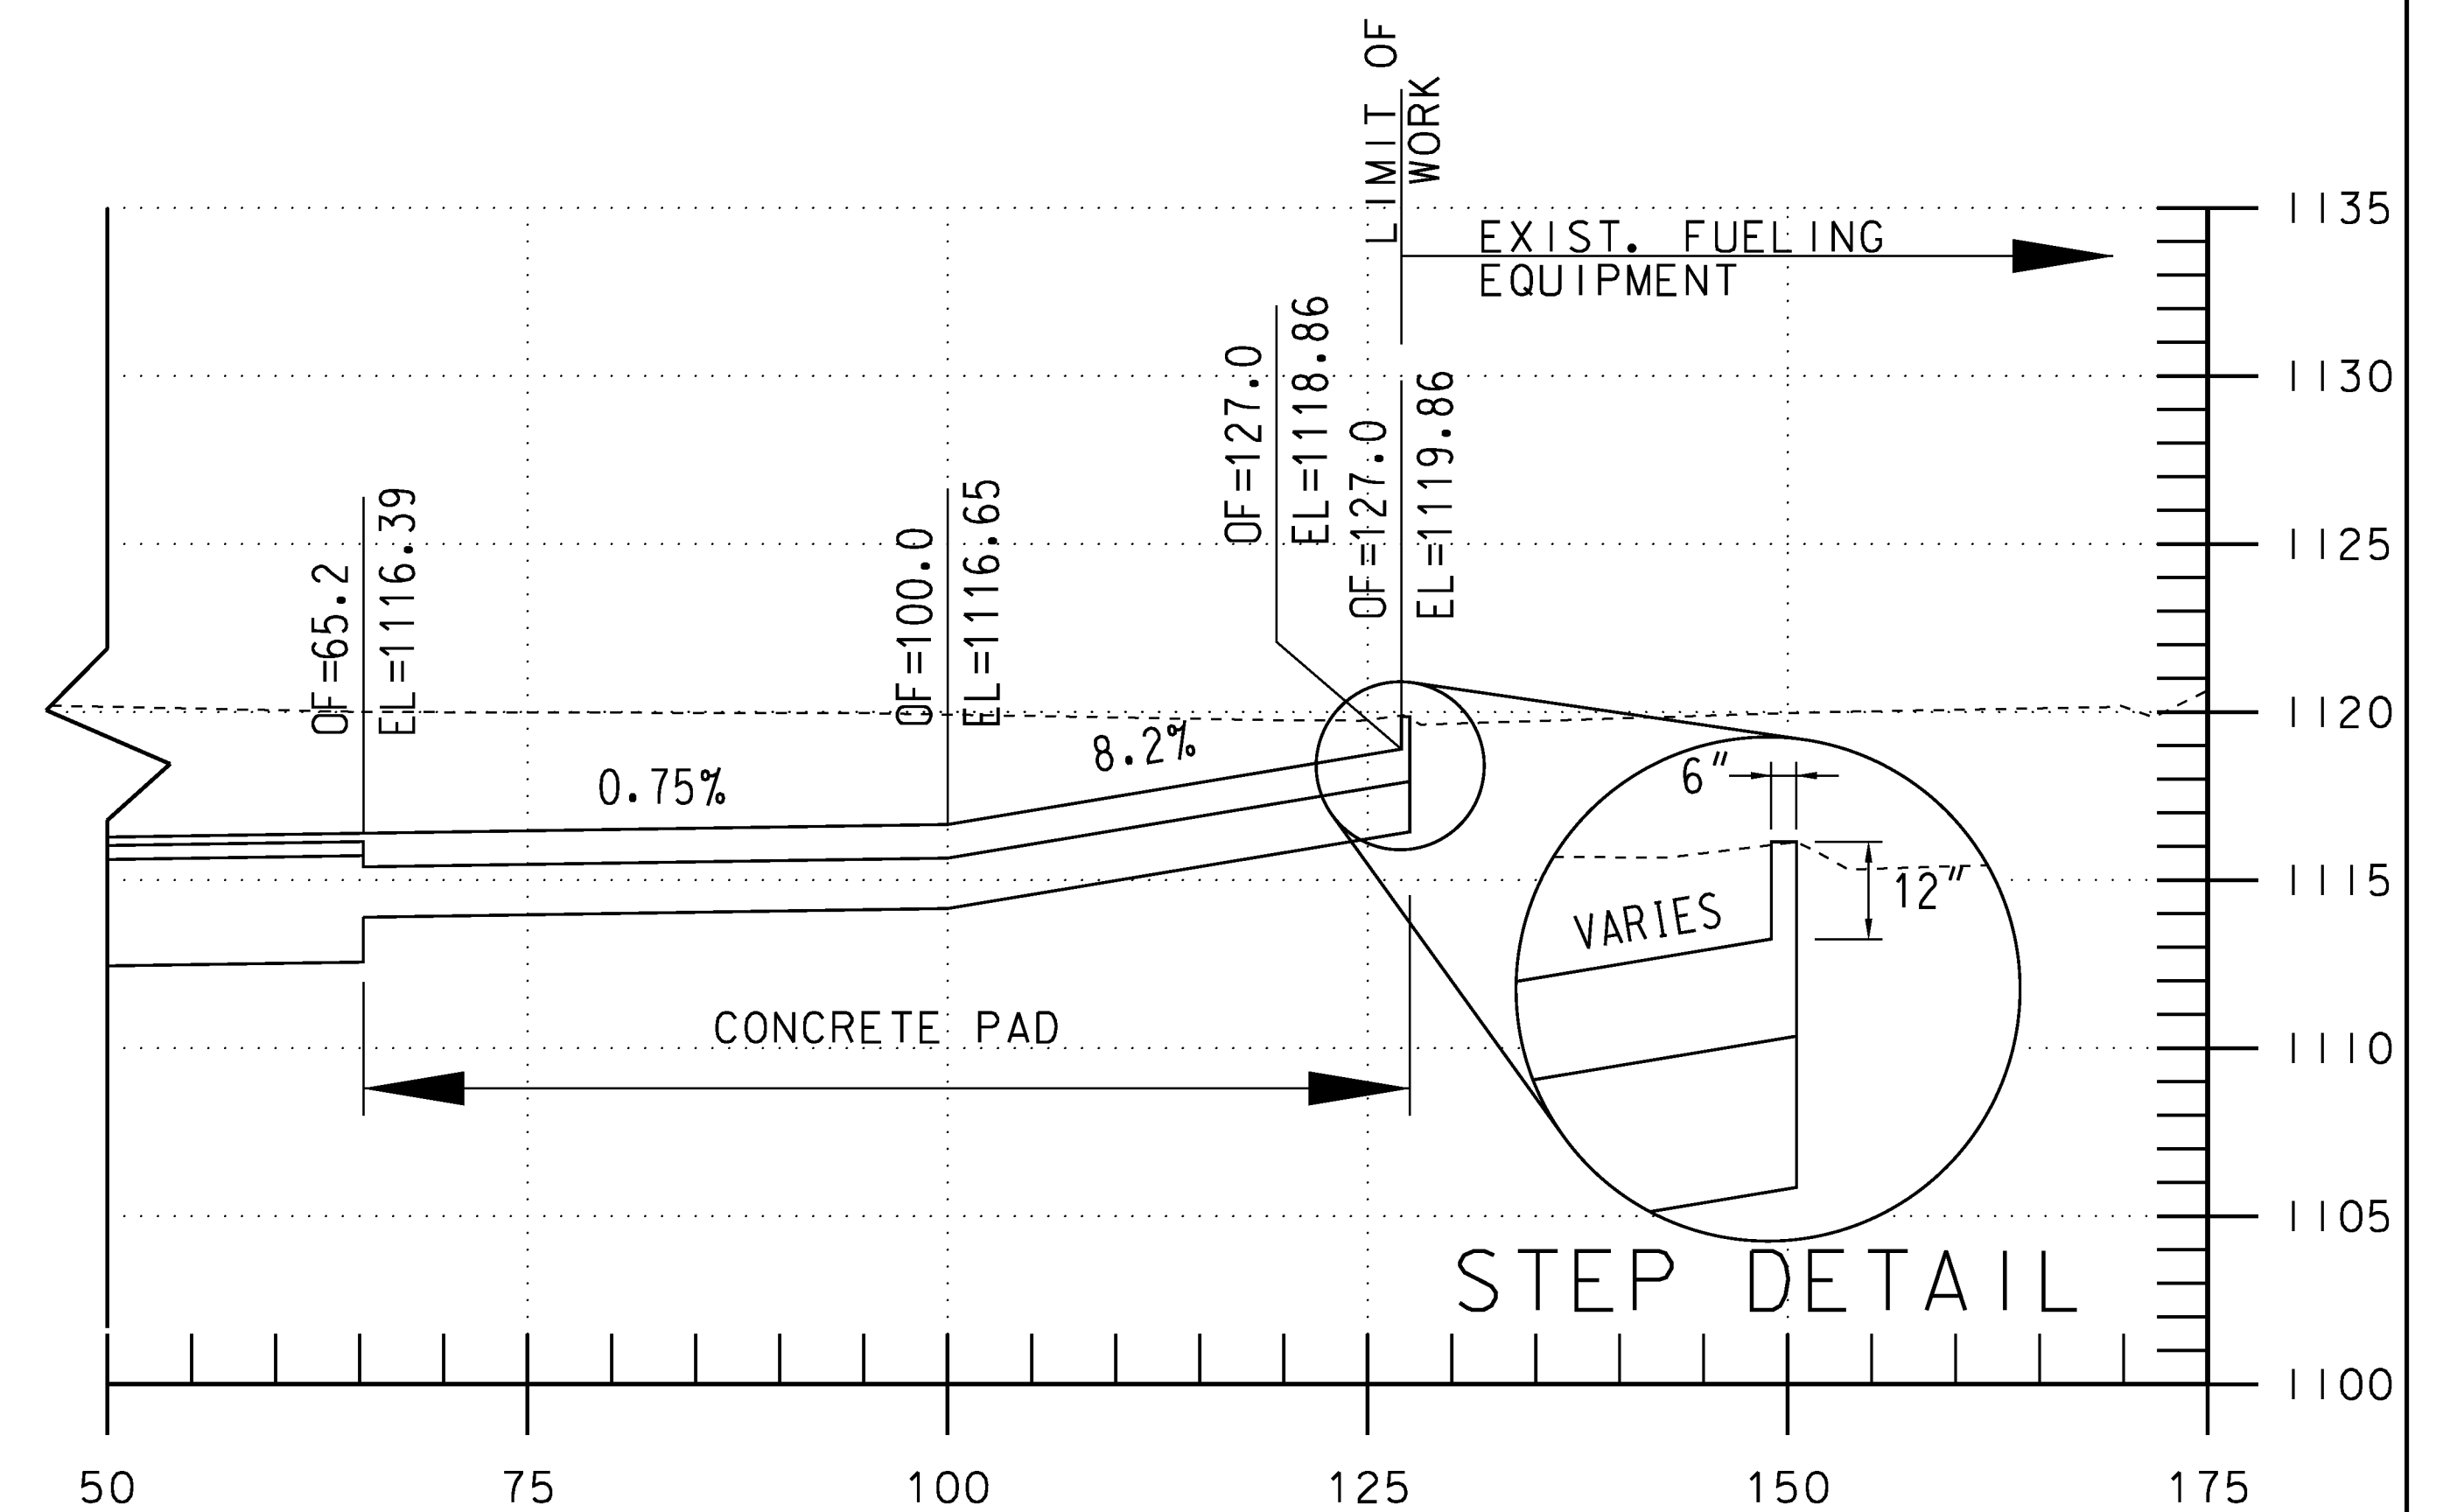

SECTION AT 6+75

NOTES:

1. ALL CROSS SLOPES VARY, SEE GRADING PLANS AND TAXIWAY E CROSS SECTIONS FOR ADDITIONAL INFORMATION.
2. CONCRETE STEP TO BE 12" HIGH AND MATCH EXISTING GROUND.

TYPICAL CONCRETE PAD CROSS SECTION

NOT TO SCALE

Hoyle, Tanner & Associates, Inc.

150 Dow Street
 Manchester, NH 03101-1227
 Tel 603-669-5555
 Fax 603-669-4168
 Web Page: www.hoyletanner.com
 Hoyle Tanner & Associates © 2008

PROJECT NAME: E. F. KNAPP STATE AIRPORT
 A.I.P. 3-50-0001-011-2009
 PROJECT NUMBER: BERLIN AIR 04-3216

FILE NAME: 302803_sht_grdg_def.dgn PLOT DATE: 11/22/2011
 PROJECT LEADER: S. FORTNEY DRAWN BY: D. STANDISH
 DESIGNED BY: S. BOUCHARD CHECKED BY: J. DOWNAR
 FUEL FACILITY DETAILS SHEET 92 OF 173