


**MARKING DATA**

M1  
 R = 75.0'  
 L = 117.81'  
 Tan = 75.0'  
 Delta = 90°00'00"

M2  
 R = 75.0'  
 L = 117.81'  
 Tan = 75.0'  
 Delta = 90°00'00"

**CENTERLINE DATA**



C1  
 R = 57.5'  
 L = 90.32'  
 Tan = 57.5'  
 Delta = 90°00'00"

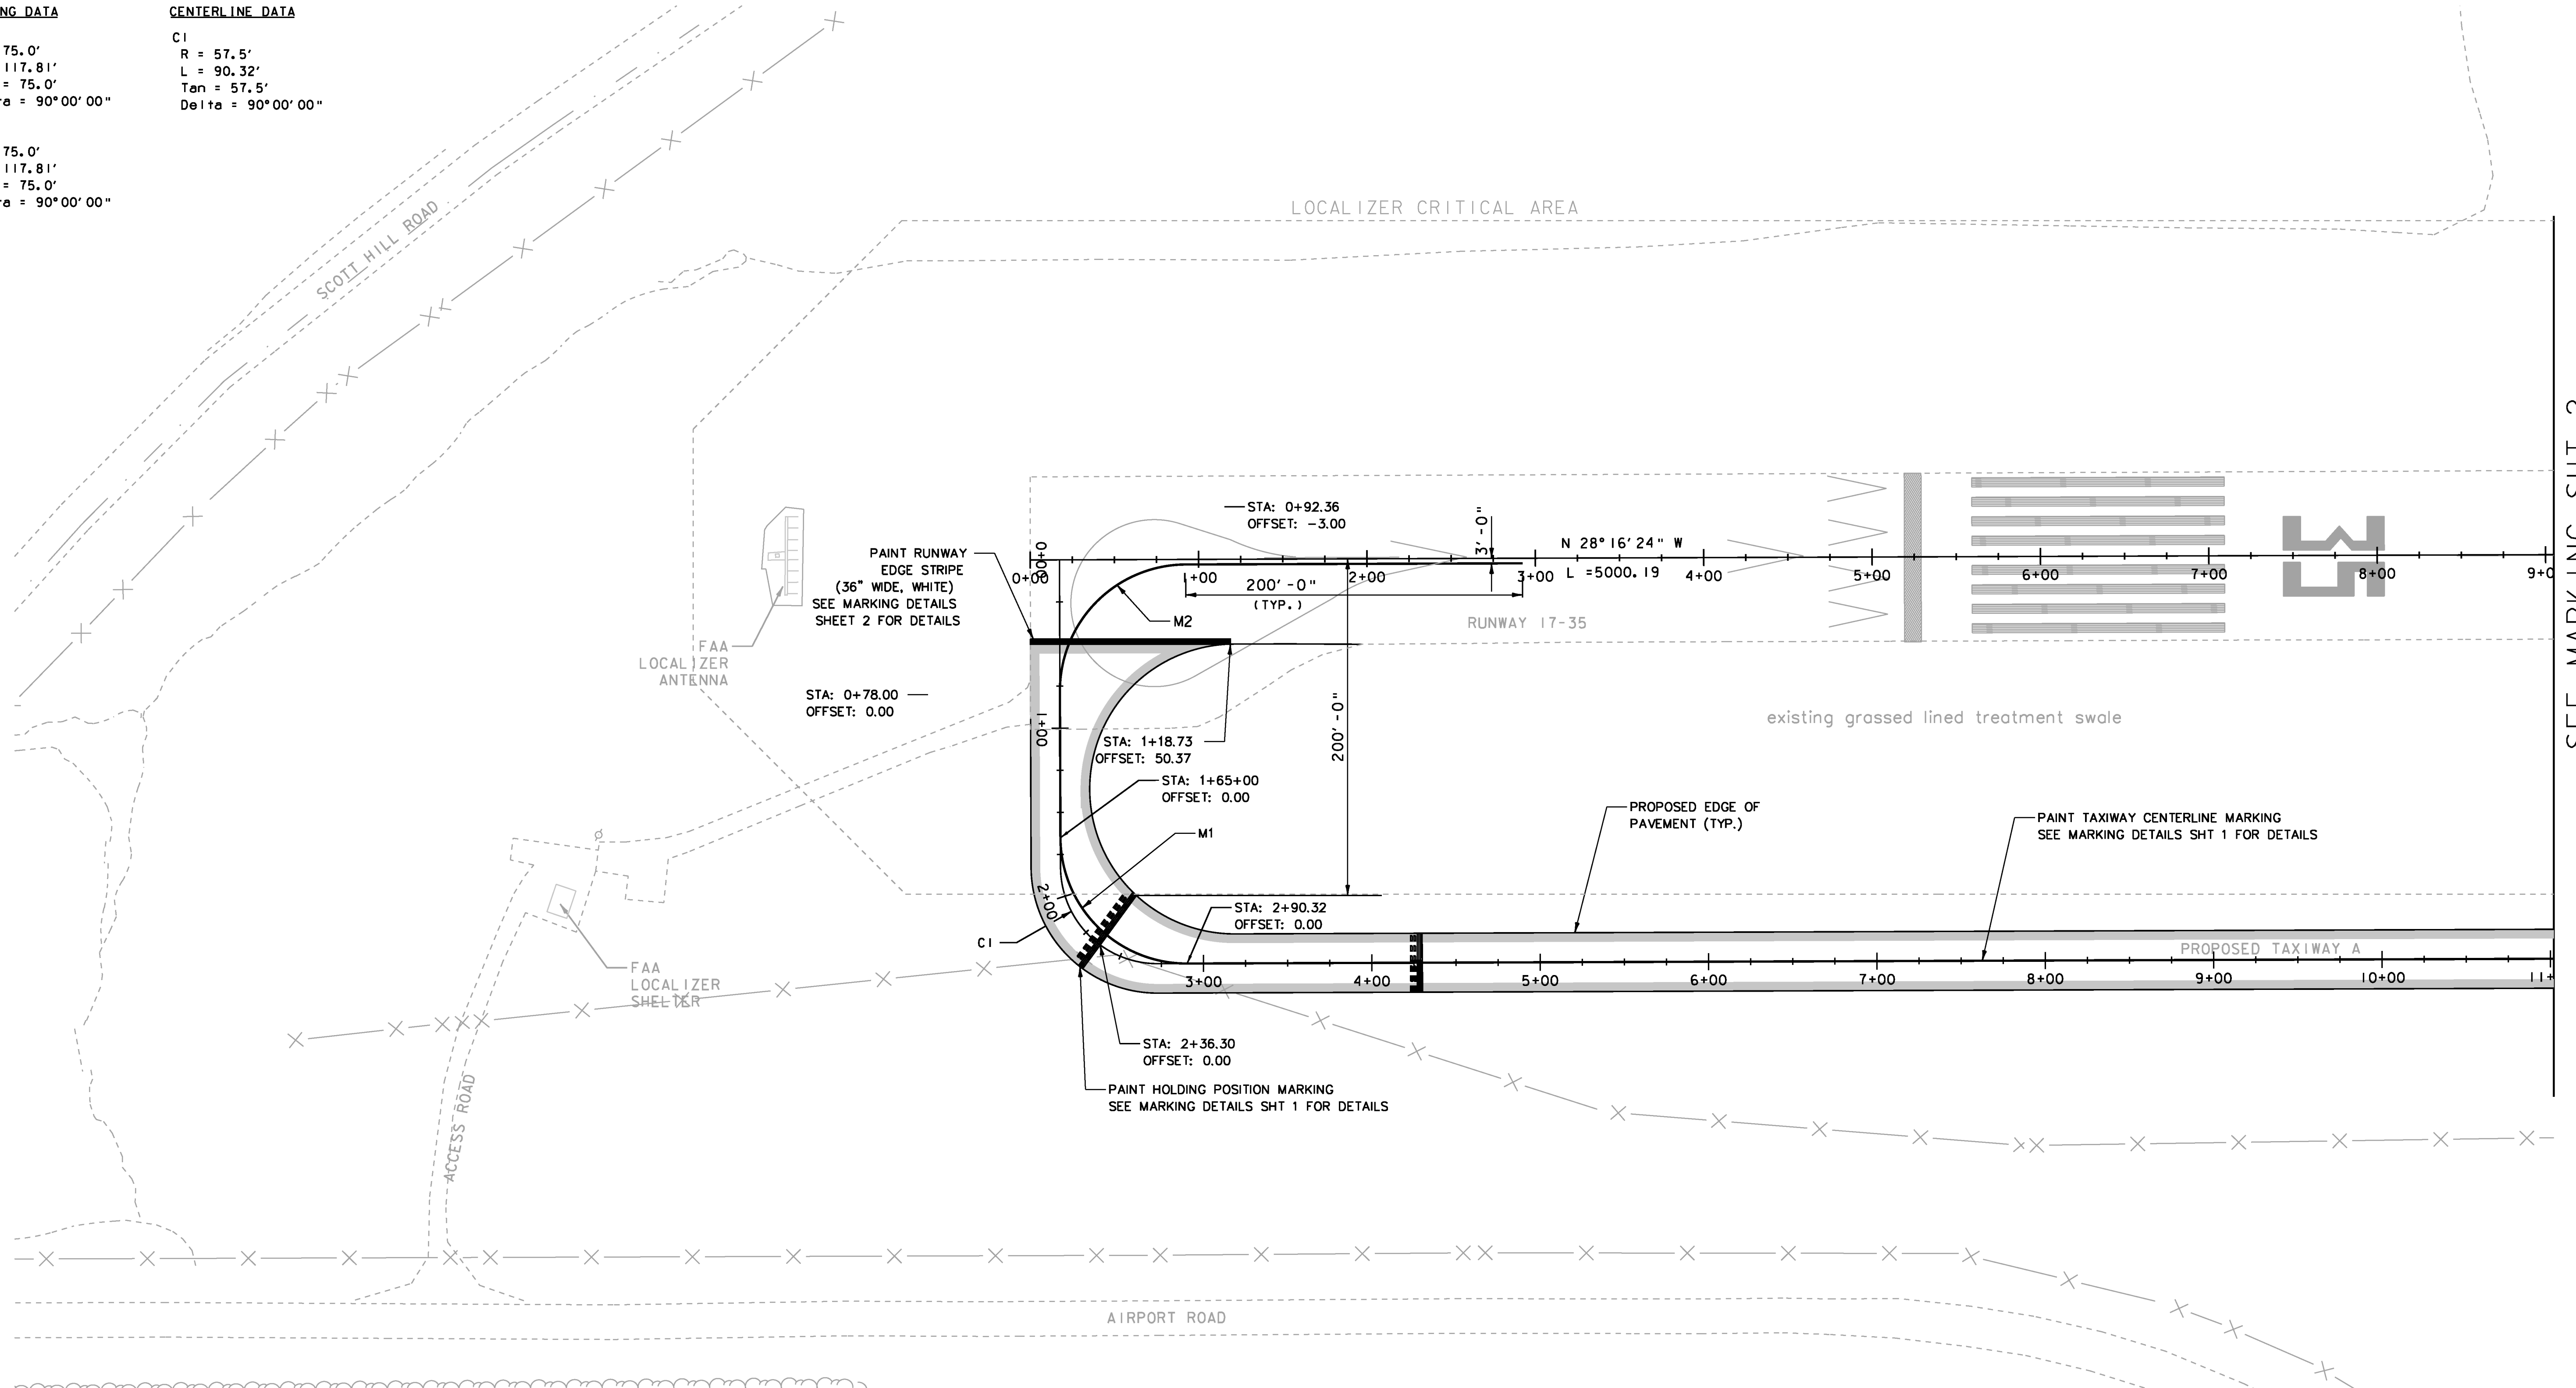

SEE MARKING SHT 2

**NOTE:**

- SEE MARKING DETAILS SHT 1 AND MARKING DETAILS SHT 2 FOR ADDITIONAL INFORMATION.
- RUNWAY MARKINGS ALWAYS TAKE PRECEDENCE OVER TAXIWAY MARKINGS. BREAK TAXIWAY MARKINGS AROUND RUNWAY MARKINGS WHERE NECESSARY.

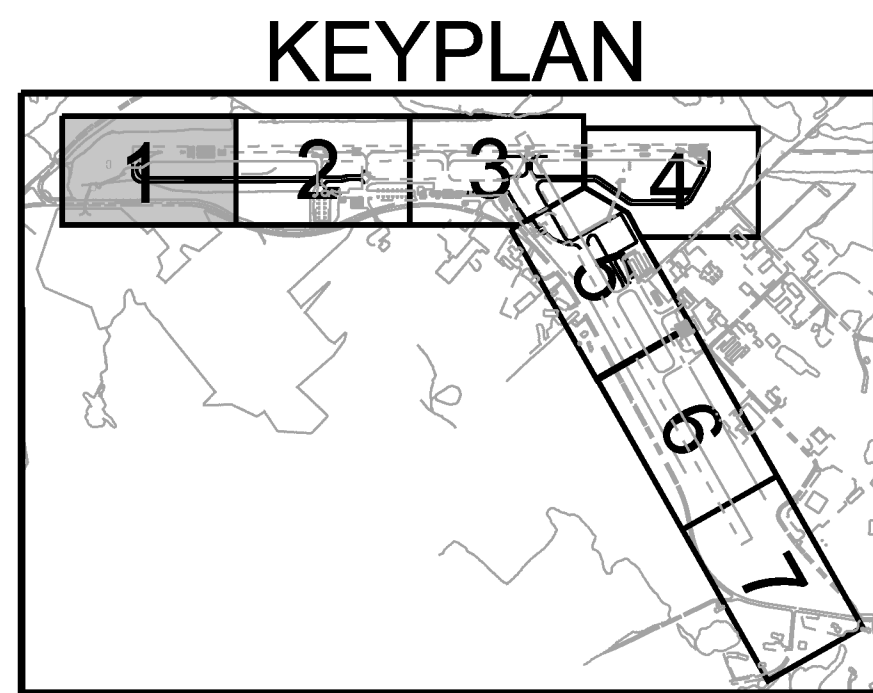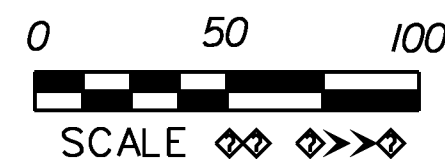

**Hoyle, Tanner & Associates, Inc.**

150 Dow Street  
 Manchester, NH 03101-1227  
 Tel 603-669-5555  
 Fax 603-669-4168  
 Web Page: [www.hoyletanner.com](http://www.hoyletanner.com)  
Hoyle Tanner & Associates © 2008

PROJECT NAME: E. F. KNAPP STATE AIRPORT	
A.I.P. 3-50-0001-011-2009	
PROJECT NUMBER: BERLIN AIR 04-3216	
FILE NAME: z05h378sht.mrk.dgn	PLOT DATE: 11/22/2011
PROJECT LEADER: S. FORTNEY	DRAWN BY: D. STANDISH
DESIGNED BY: S. BOUCHARD	CHECKED BY: J. DOWNAR
MARKING SHT 1	SHEET 110 OF 173