

MARKING DATA


M35
 R = 57.5'
 L = 89.00'
 Tan = 56.2'
 Delta = 88°48'39"

M36
 R = 75.0'
 L = 119.36'
 Tan = 76.6'
 Delta = 91°11'24"


M37
 R = 75.0'
 L = 116.25'
 Tan = 73.5'
 Delta = 88°41'14"

SEE MARKING SHT 5


SEE MARKING SHT 7

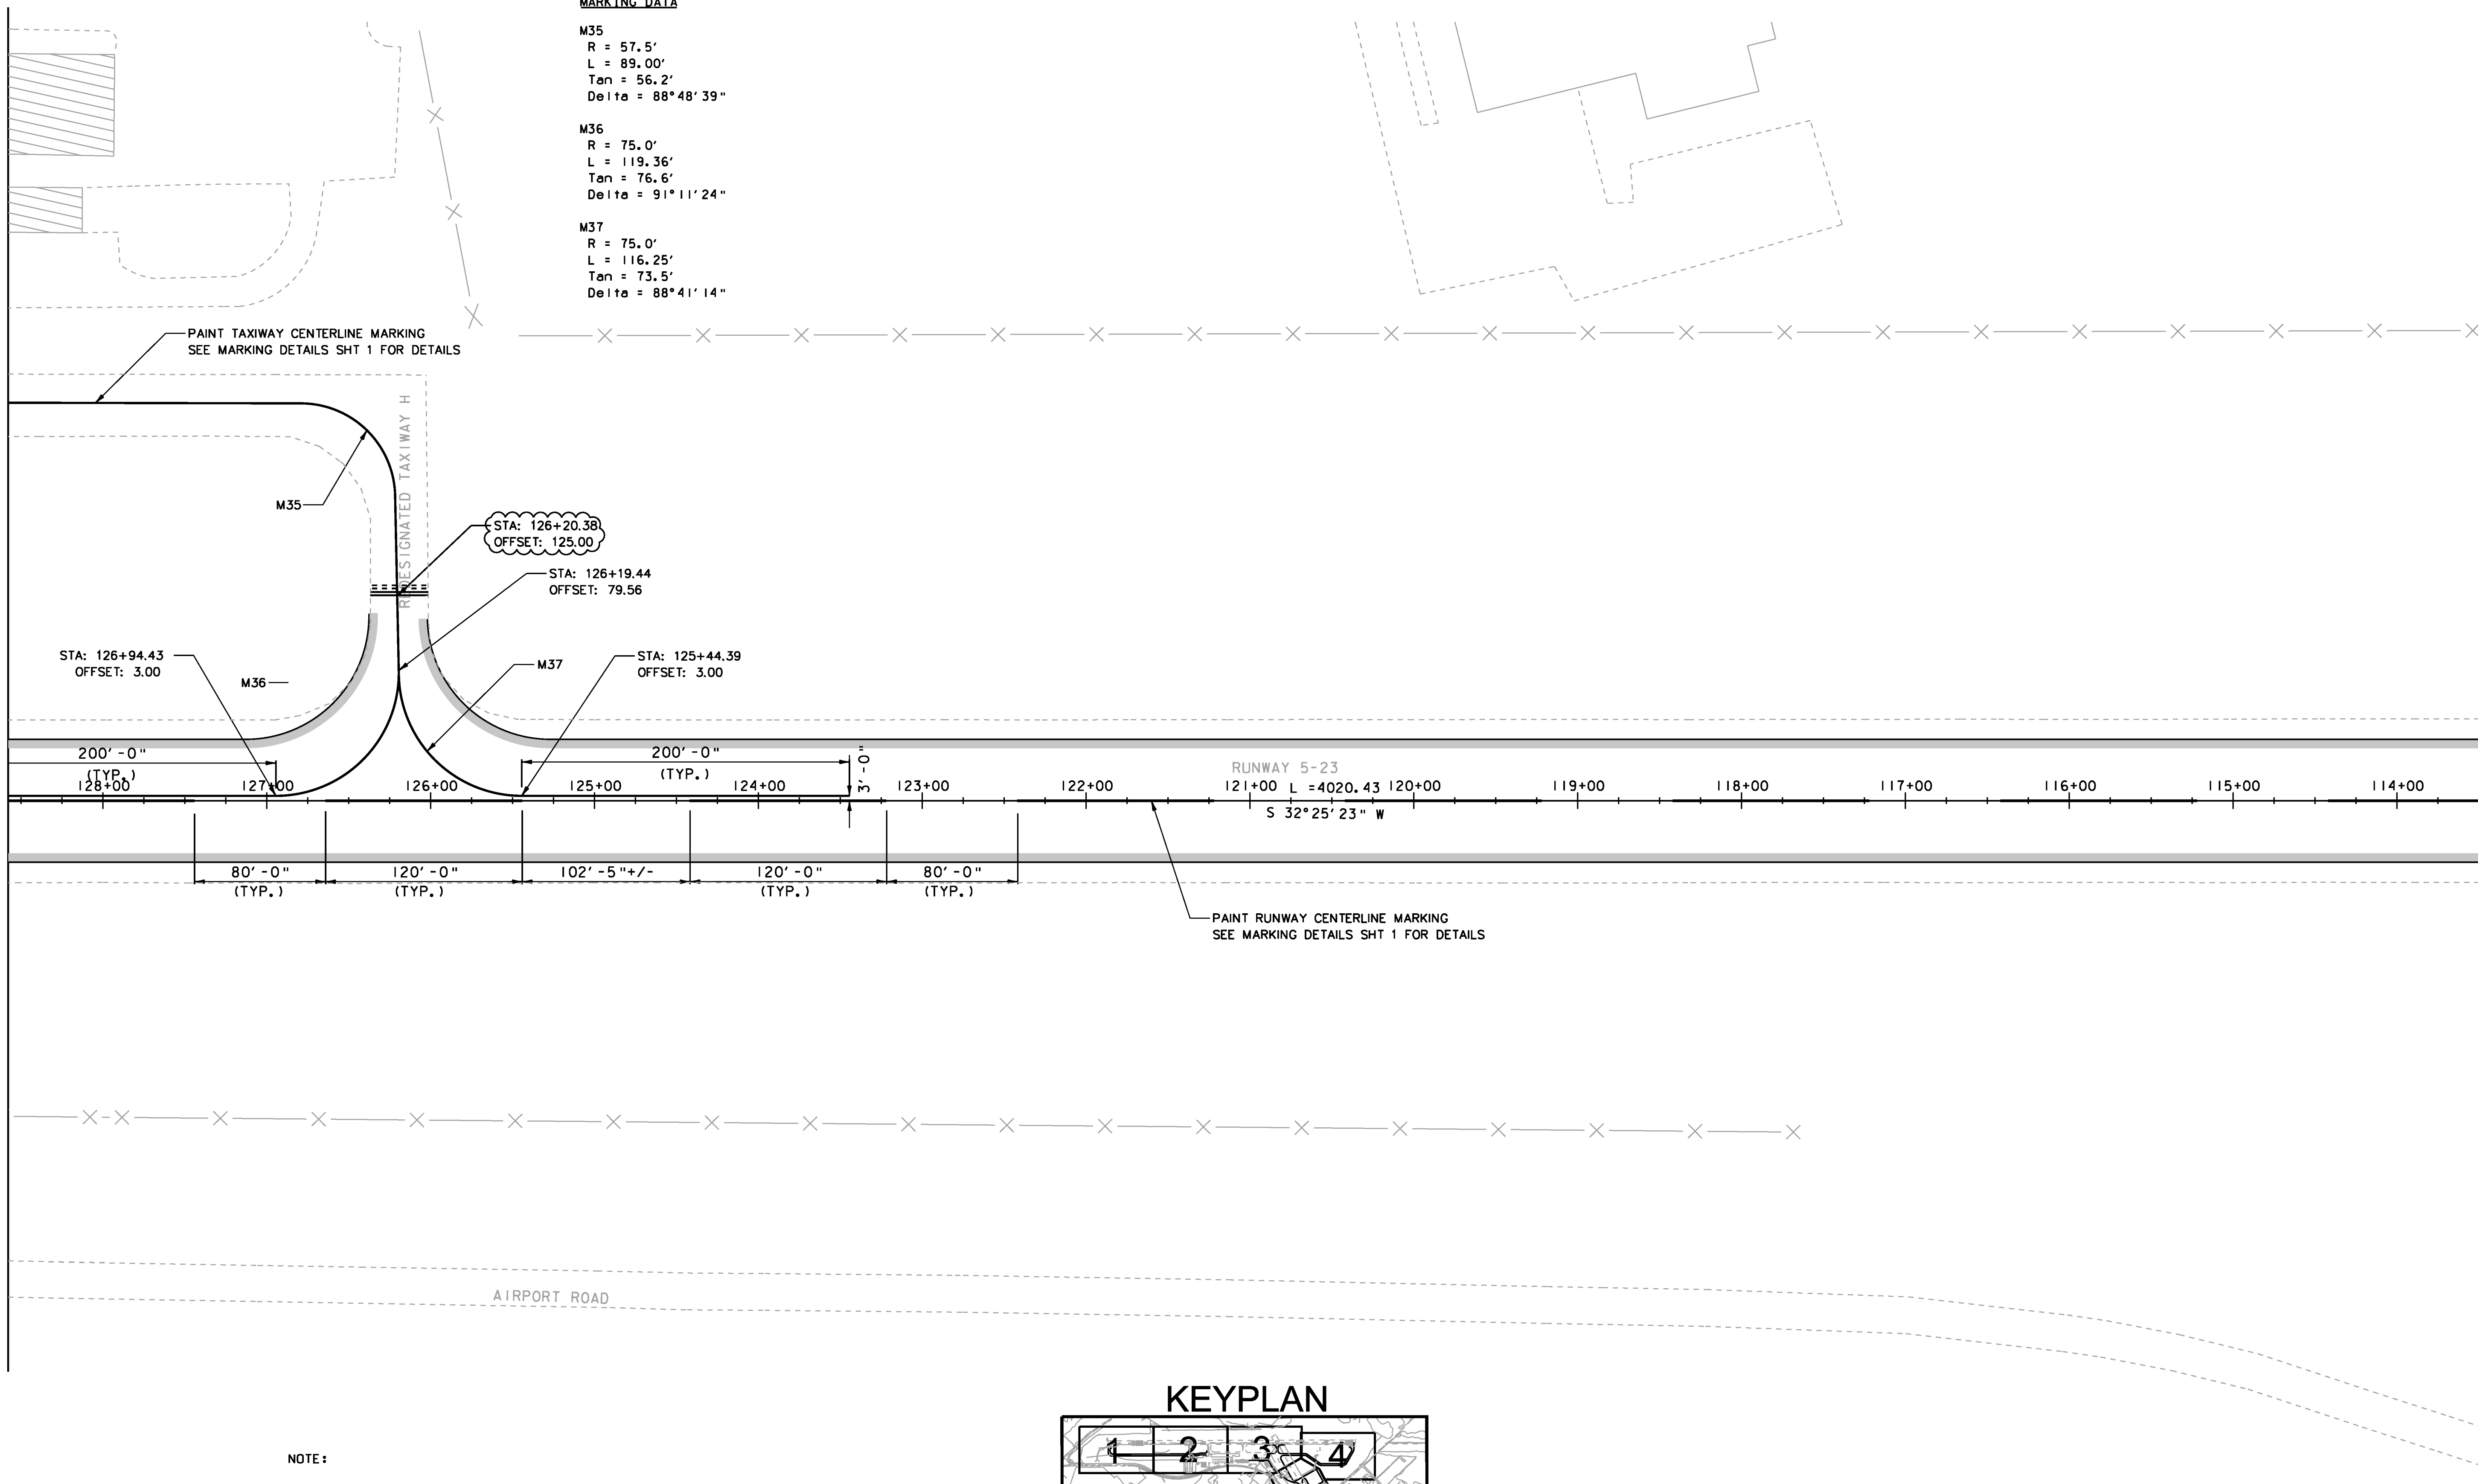

- NOTE:
- SEE MARKING DETAILS SHT 1 AND MARKING DETAILS SHT 2 FOR ADDITIONAL INFORMATION.
 - RUNWAY MARKINGS ALWAYS TAKE PRECEDENCE OVER TAXIWAY MARKINGS. BREAK TAXIWAY MARKINGS AROUND RUNWAY MARKINGS WHERE NECESSARY.

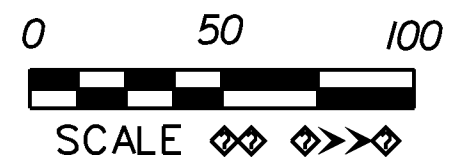

KEYPLAN

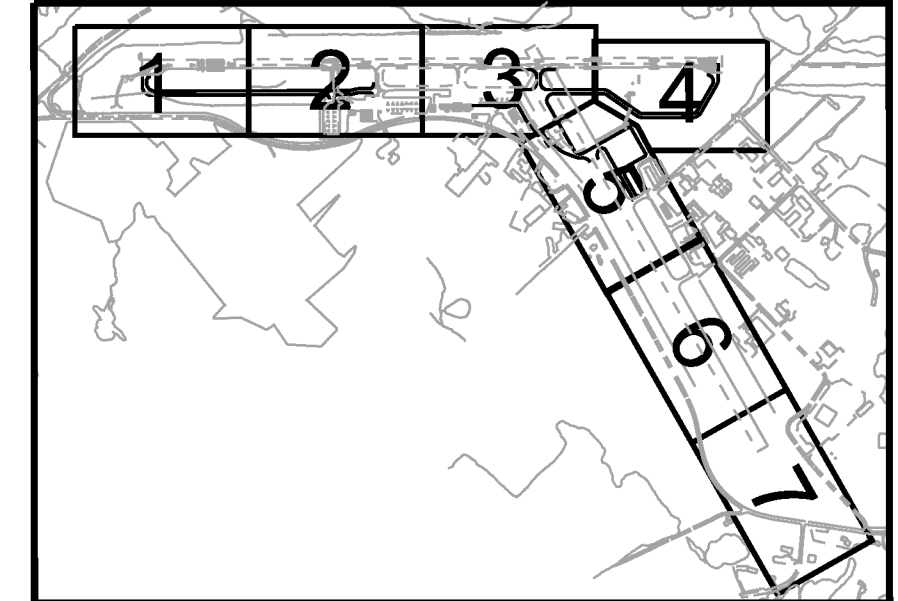

Hoyle, Tanner & Associates, Inc.
 150 Dow Street
 Manchester, NH 03101-1227
 Tel 603-669-5555
 Fax 603-669-4168
 Web Page: www.hoyletanner.com
Hoyle, Tanner & Associates © 2008

| | |
|---|-----------------------|
| PROJECT NAME: E. F. KNAPP STATE AIRPORT | |
| A.I.P. 3-50-0001-011-2009 | |
| PROJECT NUMBER: BERLIN AIR 04-3216 | |
| FILE NAME: z05h378sht.mrk.dgn | PLOT DATE: 11/22/2011 |
| PROJECT LEADER: S. FORTNEY | DRAWN BY: D. STANDISH |
| DESIGNED BY: S. BOUCHARD | CHECKED BY: J. DOWNAR |
| MARKING SHT 6 | SHEET 115 OF 173 |