


SEE MARKING SHT 6

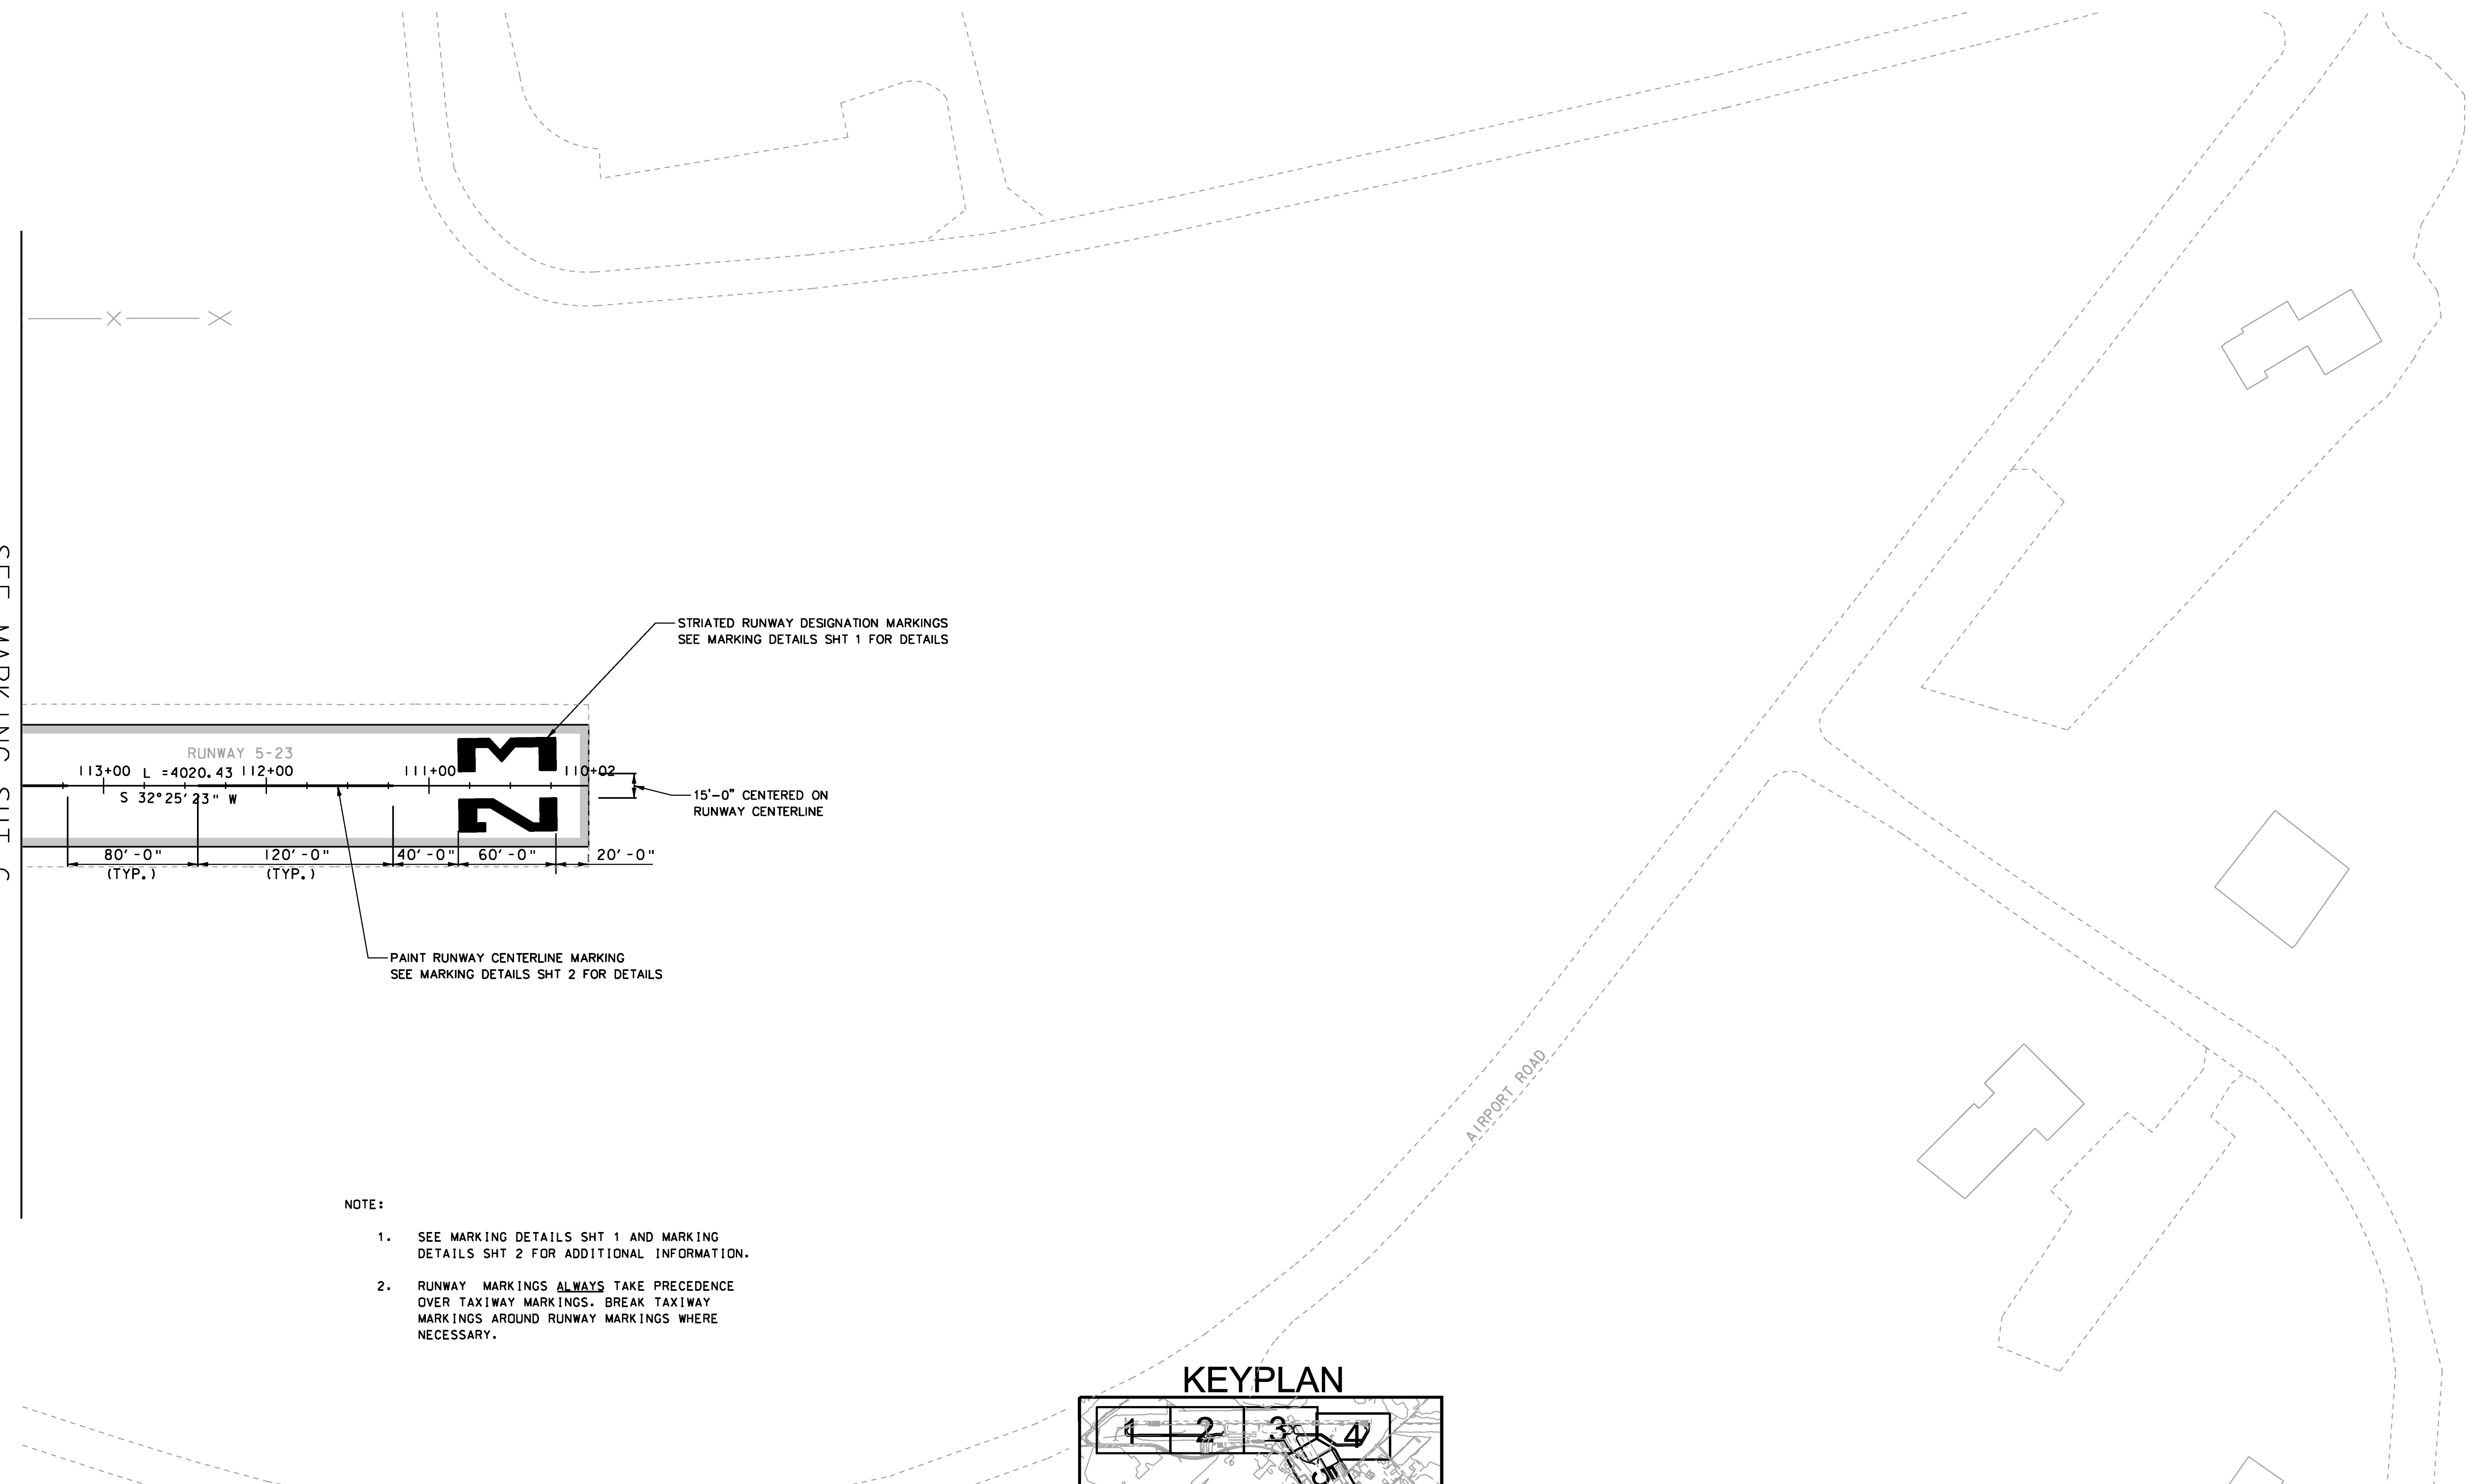

STRIATED RUNWAY DESIGNATION MARKINGS  
SEE MARKING DETAILS SHT 1 FOR DETAILS



15'-0" CENTERED ON  
RUNWAY CENTERLINE

PAINT RUNWAY CENTERLINE MARKING  
SEE MARKING DETAILS SHT 2 FOR DETAILS

**NOTE:**

1. SEE MARKING DETAILS SHT 1 AND MARKING DETAILS SHT 2 FOR ADDITIONAL INFORMATION.
2. RUNWAY MARKINGS ALWAYS TAKE PRECEDENCE OVER TAXIWAY MARKINGS. BREAK TAXIWAY MARKINGS AROUND RUNWAY MARKINGS WHERE NECESSARY.

**KEYPLAN**

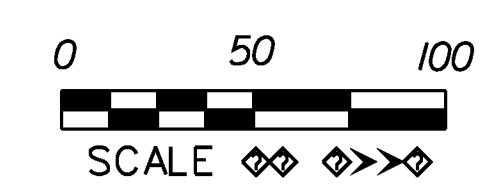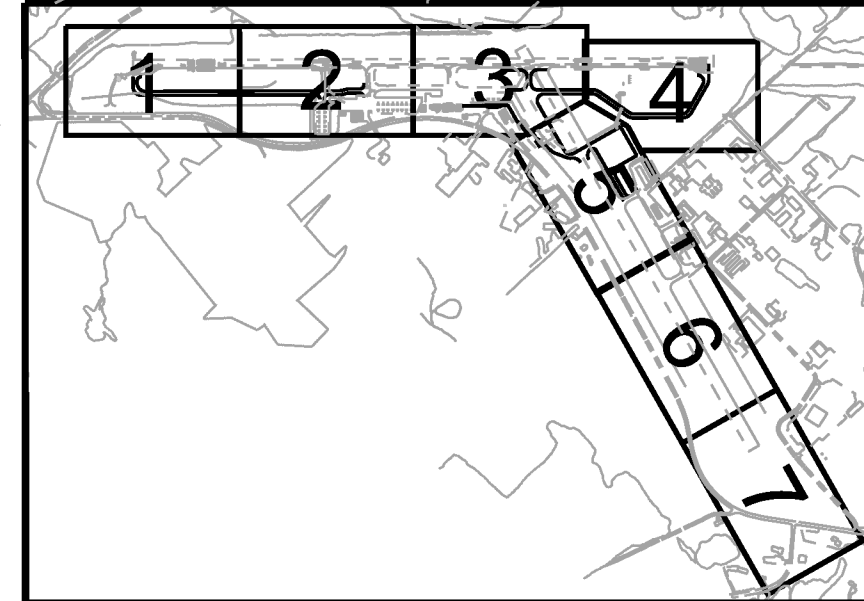

**Hoyle, Tanner & Associates, Inc.**  
 150 Dow Street  
 Manchester, NH 03101-1227  
 Tel 603-669-5555  
 Fax 603-669-4168  
 Web Page: [www.hoyletanner.com](http://www.hoyletanner.com)  
Hoyle Tanner & Associates © 2008

PROJECT NAME: E. F. KNAPP STATE AIRPORT	
A.I.P. 3-50-0001-011-2009	
PROJECT NUMBER: BERLIN AIR 04-3216	
FILE NAME: z05h378sht.mrk.dgn	PLOT DATE: 11/22/2011
PROJECT LEADER: S. FORTNEY	DRAWN BY: D. STANDISH
DESIGNED BY: S. BOUCHARD	CHECKED BY: J. DOWNAR
MARKING SHT 7	SHEET 116 OF 173