


**CENTERLINE AND TAXIWAY
EDGE MARKING DETAIL**


NOT TO SCALE
15' DASH & 25' SPACES IN LENGTH,
6" IN WIDTH COLOR, (YELLOW)

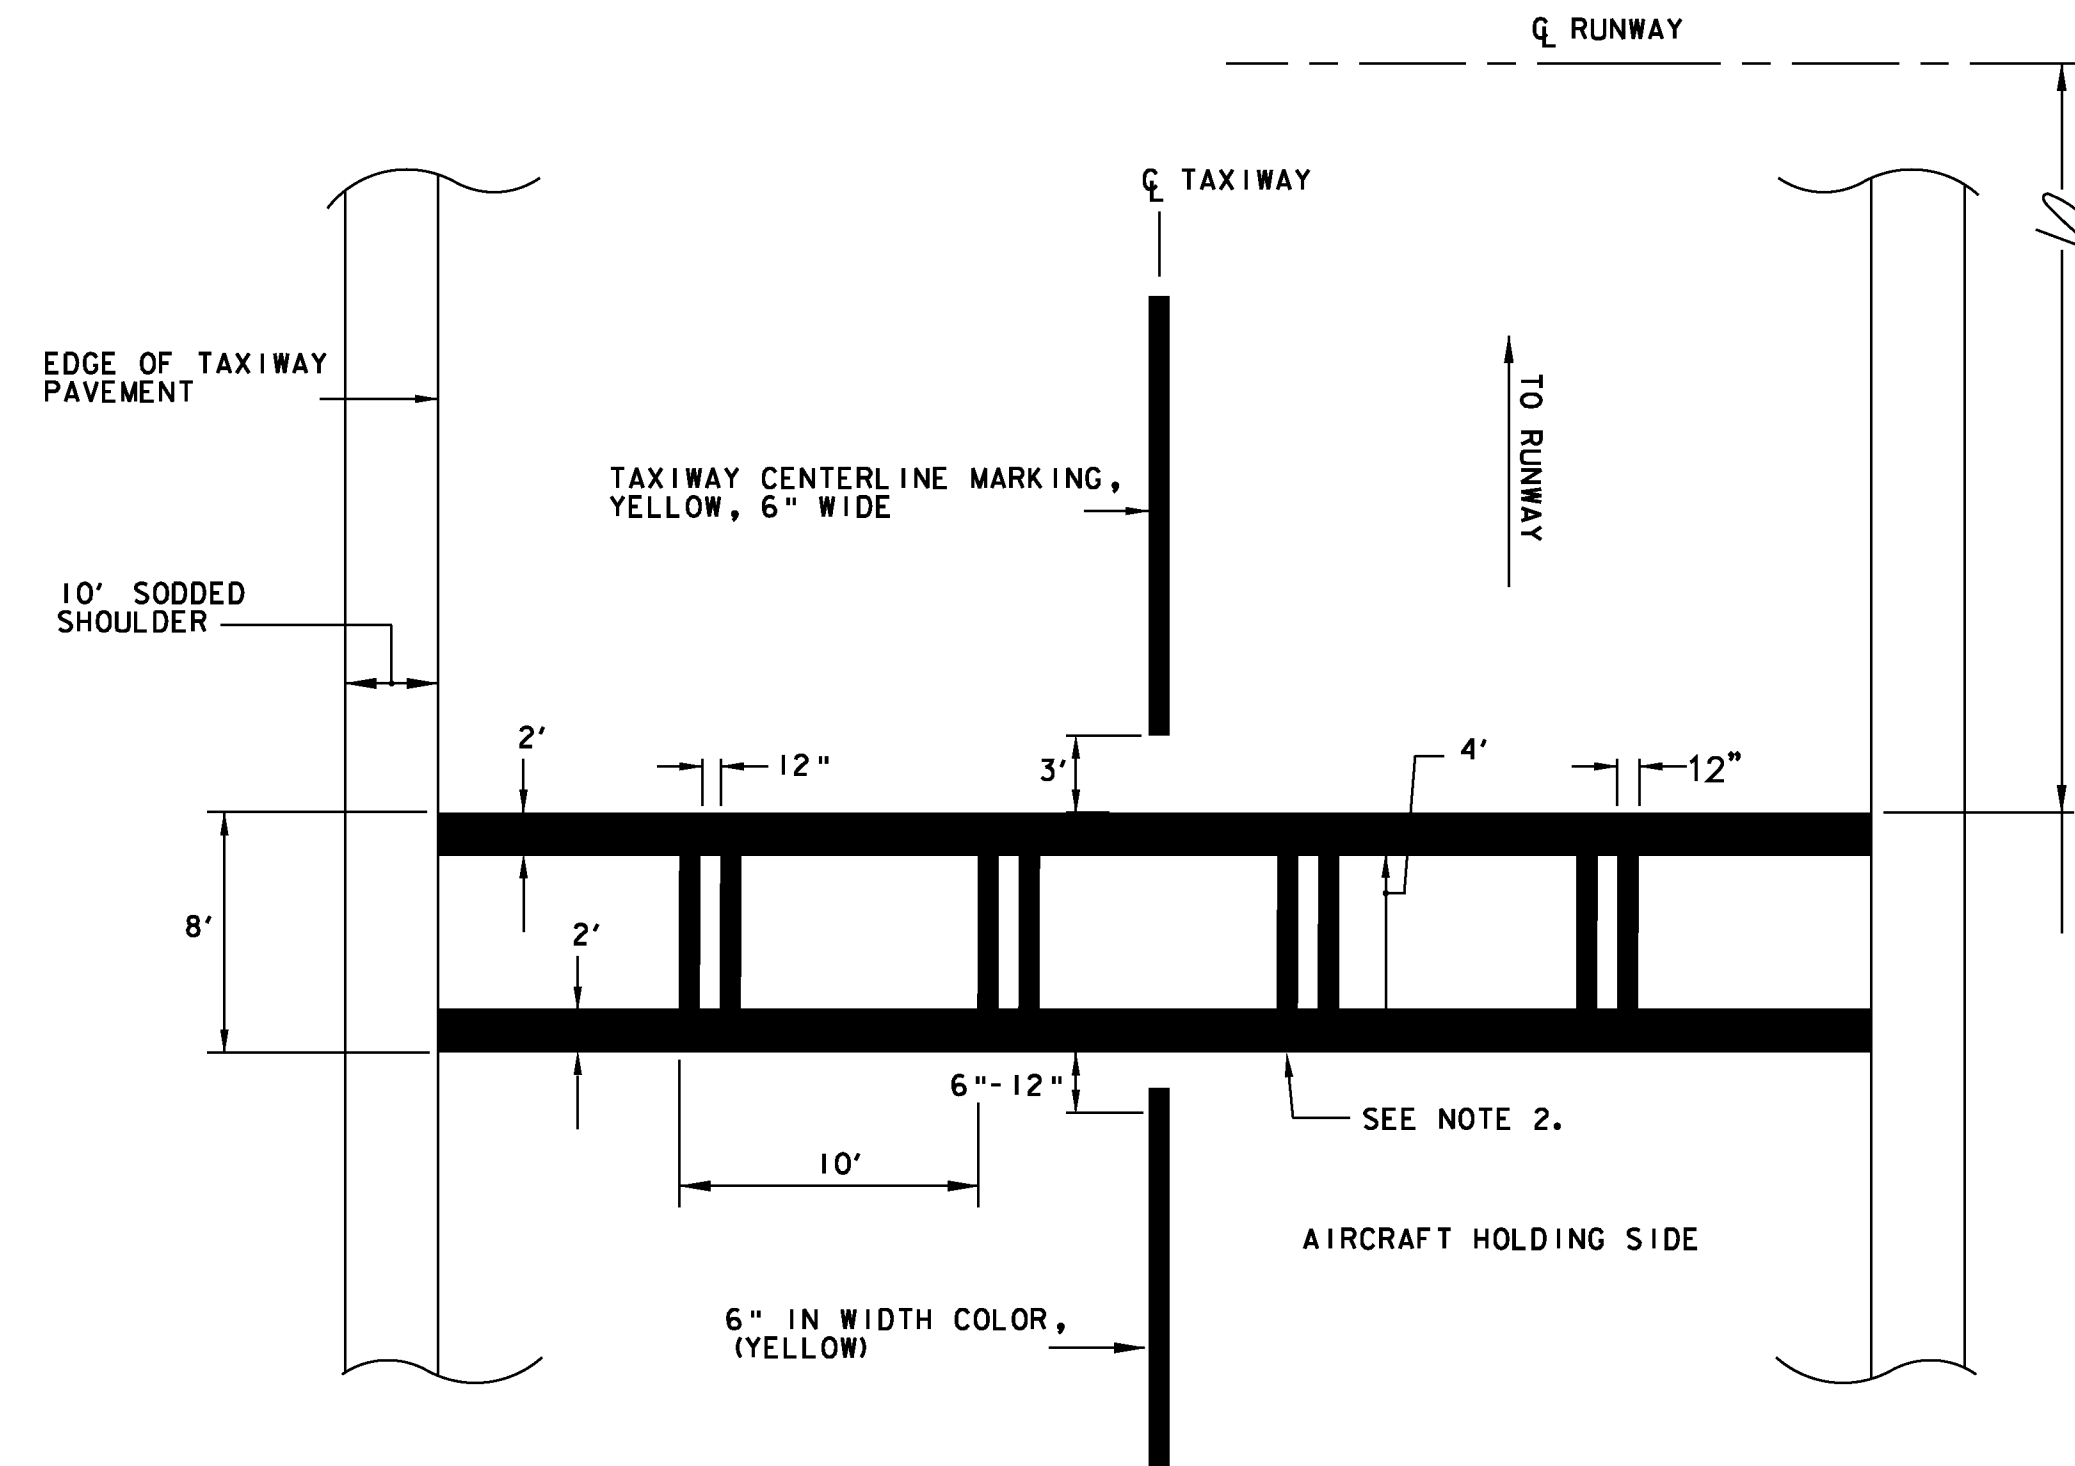

**ILS / MLS HOLDING POSITION MARKING
(PAINTED ON TAXIWAYS)**

NOT TO SCALE


- NOTE:
1. HOLDLINE AND T/W CENTERLINE ARE TO BE PAINTED PER P-620-1.
 2. ALL MARKINGS ARE YELLOW

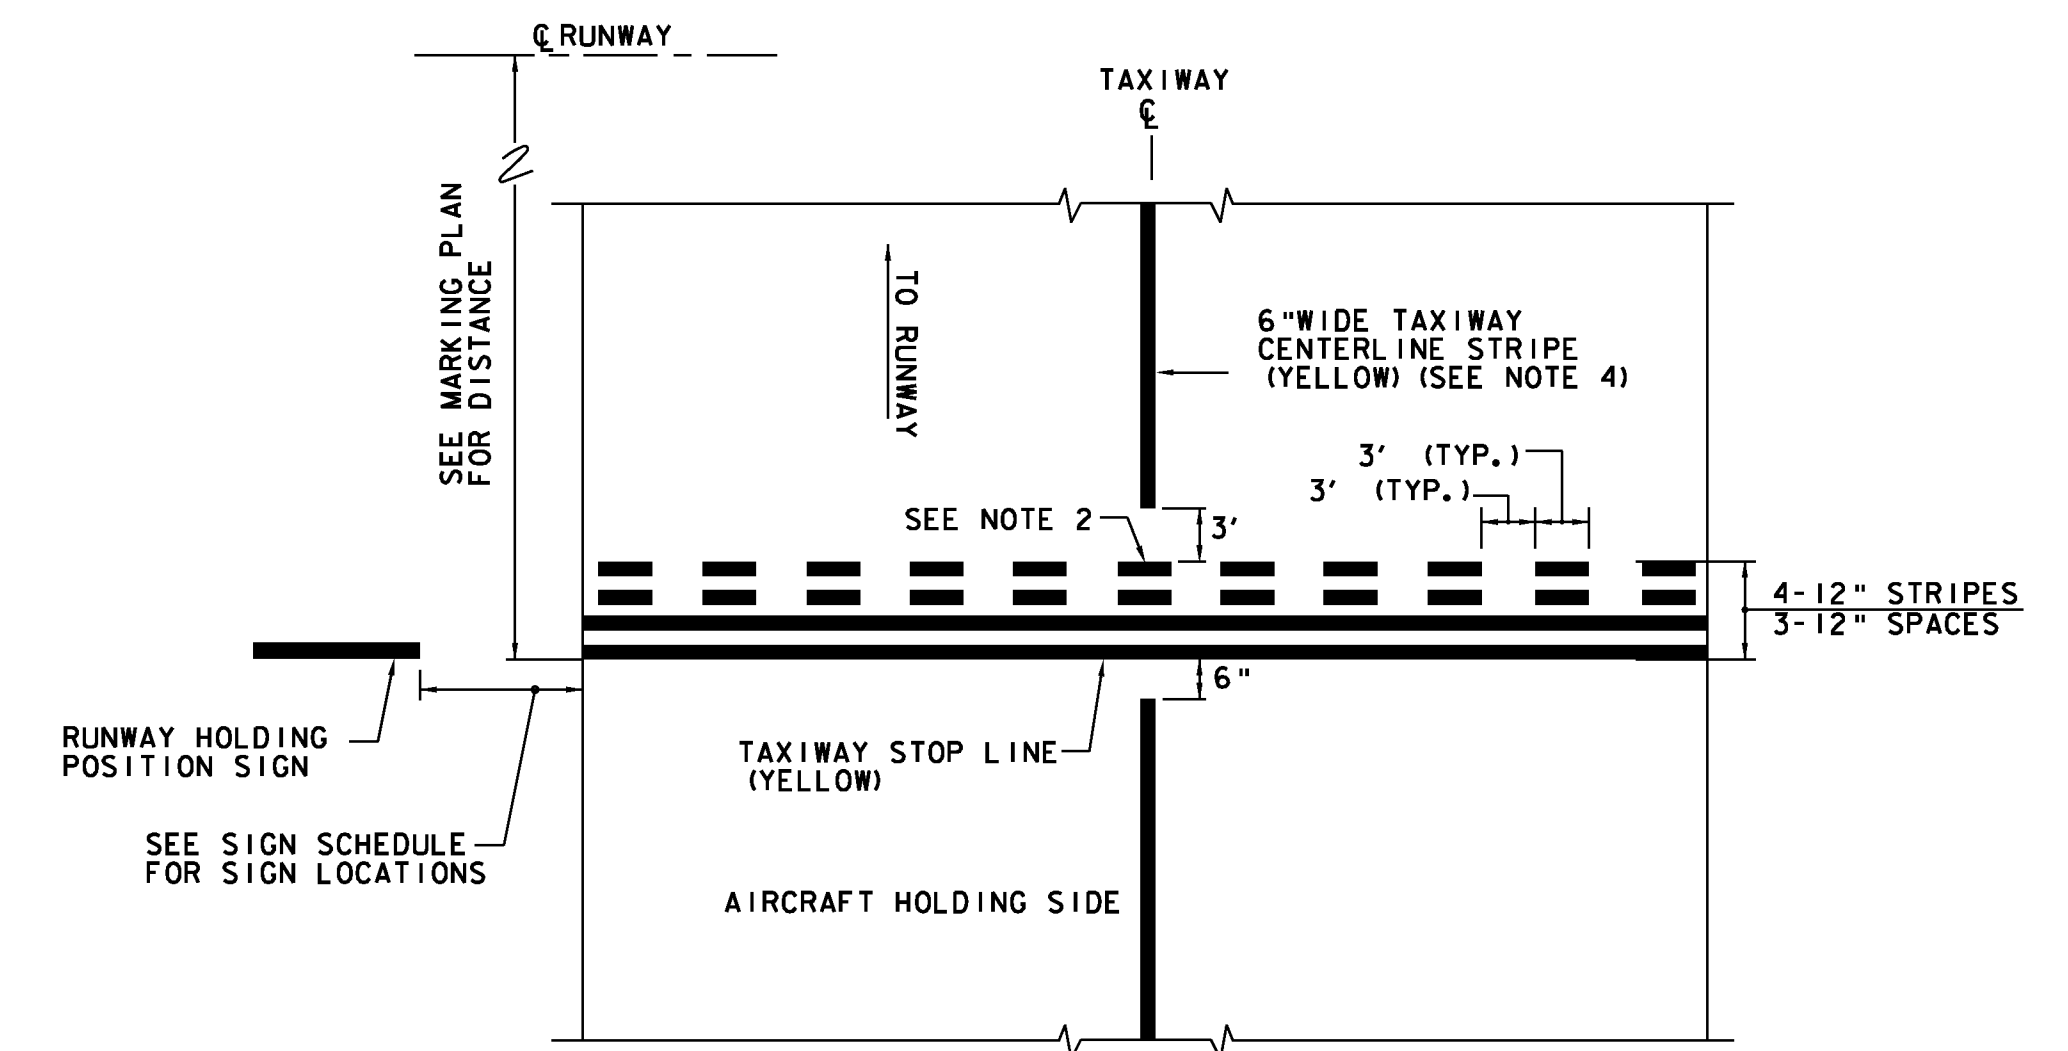

RUNWAY HOLDING POSITION MARKING DETAIL


NOT TO SCALE

- NOTE:
1. HOLDLINE AND T/W CENTERLINE ARE TO BE PAINTED PER P-620-1.
 2. MIDPOINT OF DASHED MARK ALIGNED WITH CENTERLINE OF TAXIWAY.
 3. ALL MARKINGS IN THIS DETAIL ARE YELLOW.
 4. T/W CENTERLINE WIDTH TO BE 6".

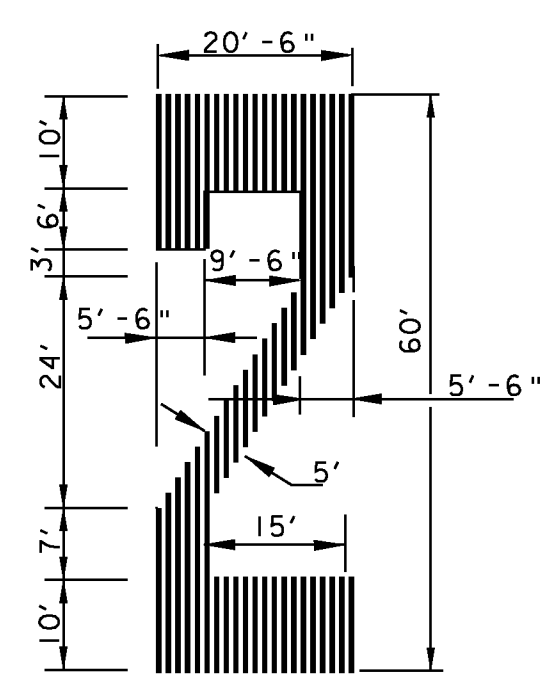


NUMERAL TWO DETAIL

NOT TO SCALE
COLOR IS WHITE

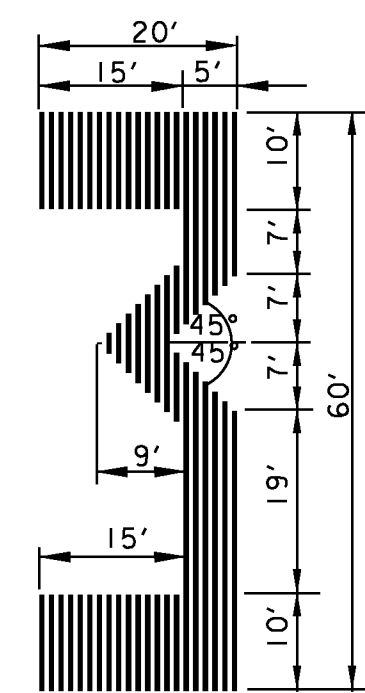


NUMERAL THREE DETAIL

NOT TO SCALE
COLOR IS WHITE

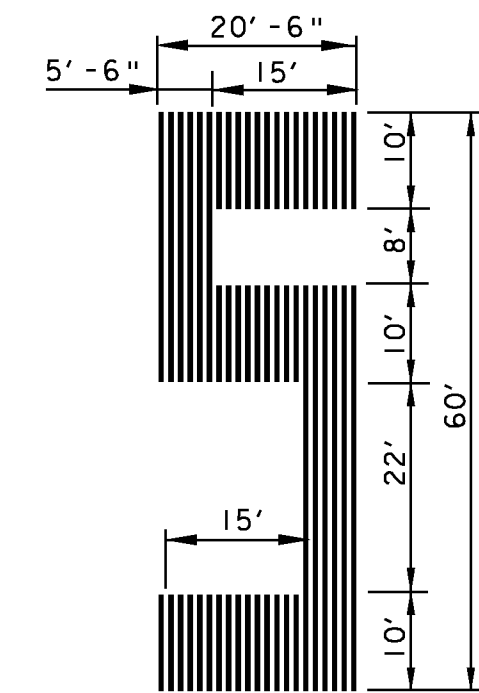

NUMERAL FIVE DETAIL

NOT TO SCALE
COLOR IS WHITE

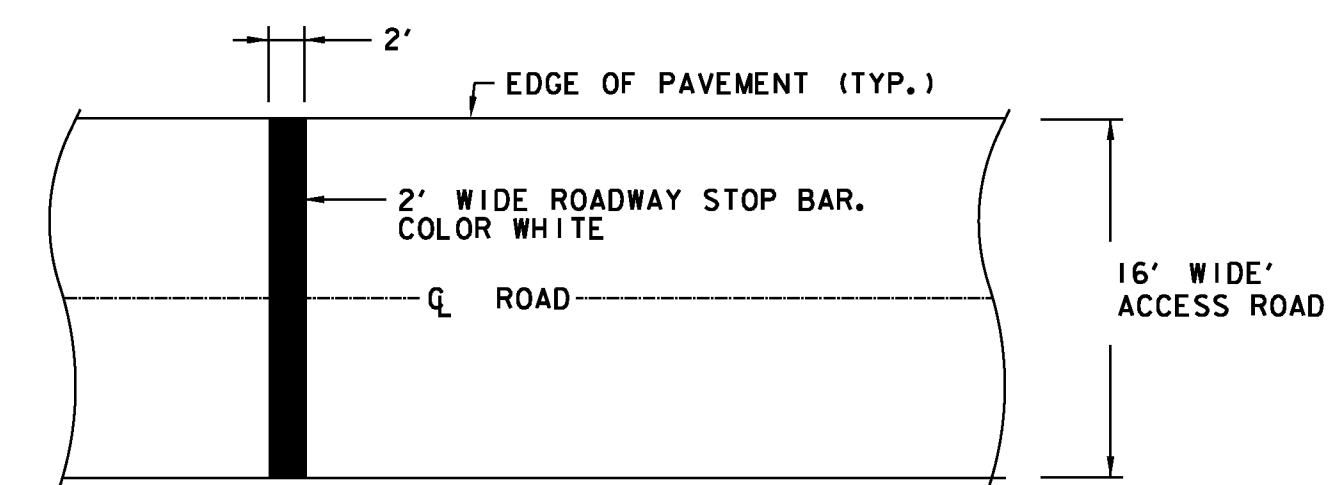

**ACCESS ROAD STOP BAR
STRIPING DETAIL**

NOT TO SCALE

**Hoyle, Tanner
& Associates, Inc.**

150 Dow Street
Manchester, NH 03101-1227
Tel 603-669-5555
Fax 603-669-4168
Web Page: www.hoyletanner.com
Hoyle Tanner & Associates © 2008

PROJECT NAME: E. F. KNAPP STATE AIRPORT
A.I.P. 3-50-0001-011-2009
PROJECT NUMBER: BERLIN AIR 04-3216

FILE NAME: 302803_sht_marking_det.dwg DATE: 11/22/2011
PROJECT LEADER: S. FORTNEY DRAWN BY: D. STANDISH
DESIGNED BY: S. BOUCHARD CHECKED BY: J. DOWNAR
MARKING DETAILS SHT 1 SHEET 117 OF 173