



TAXIWAY LEAD-IN LINE & RUNWAY EDGE STRIPE MARKING DETAIL
NOT TO SCALE

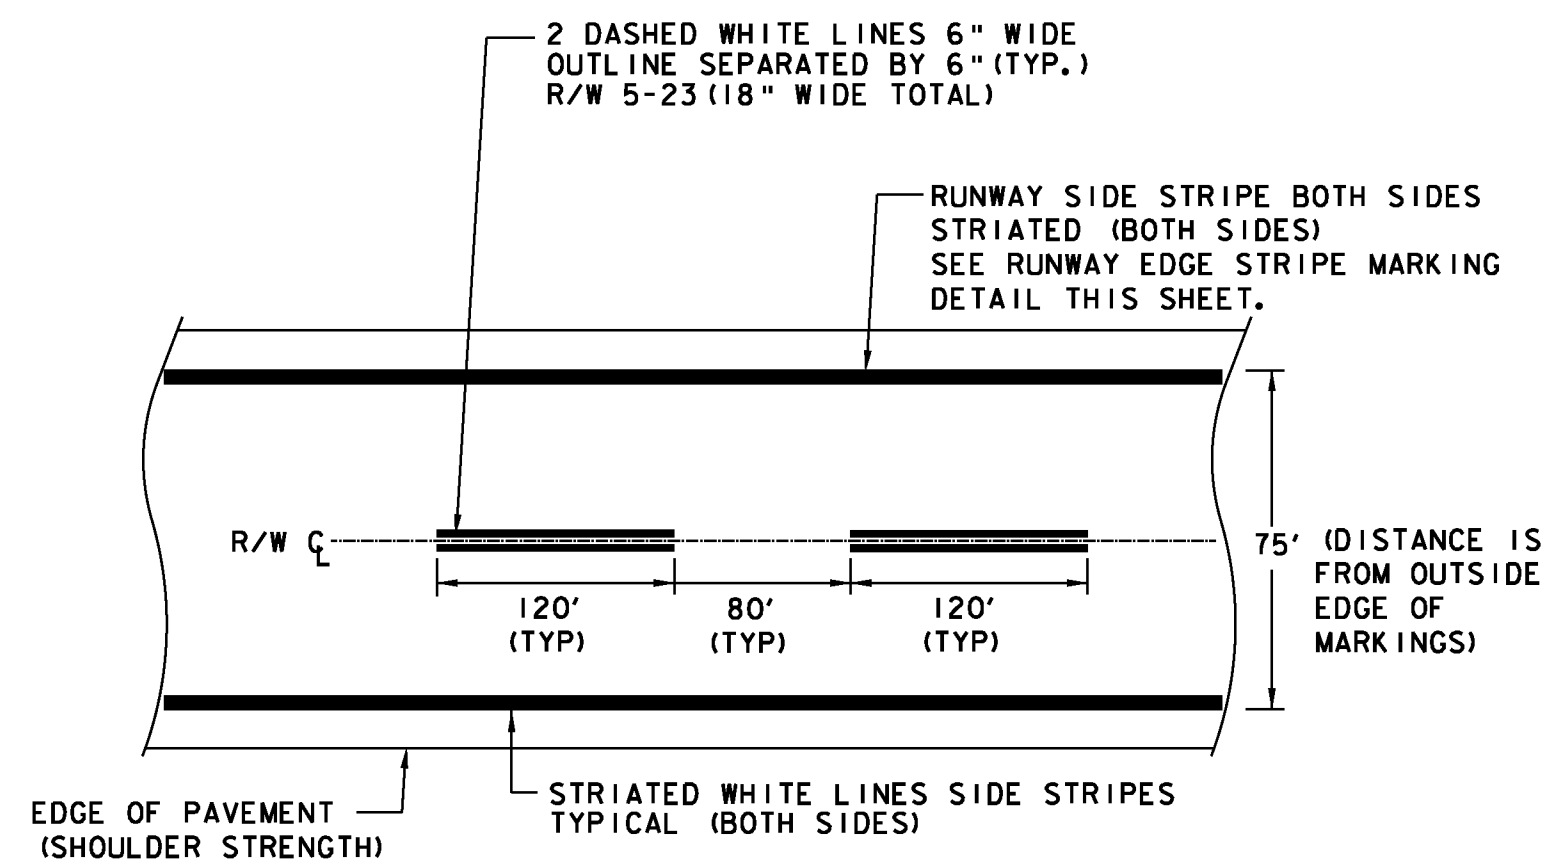


RUNWAY CENTERLINE MARKINGS
NOT TO SCALE

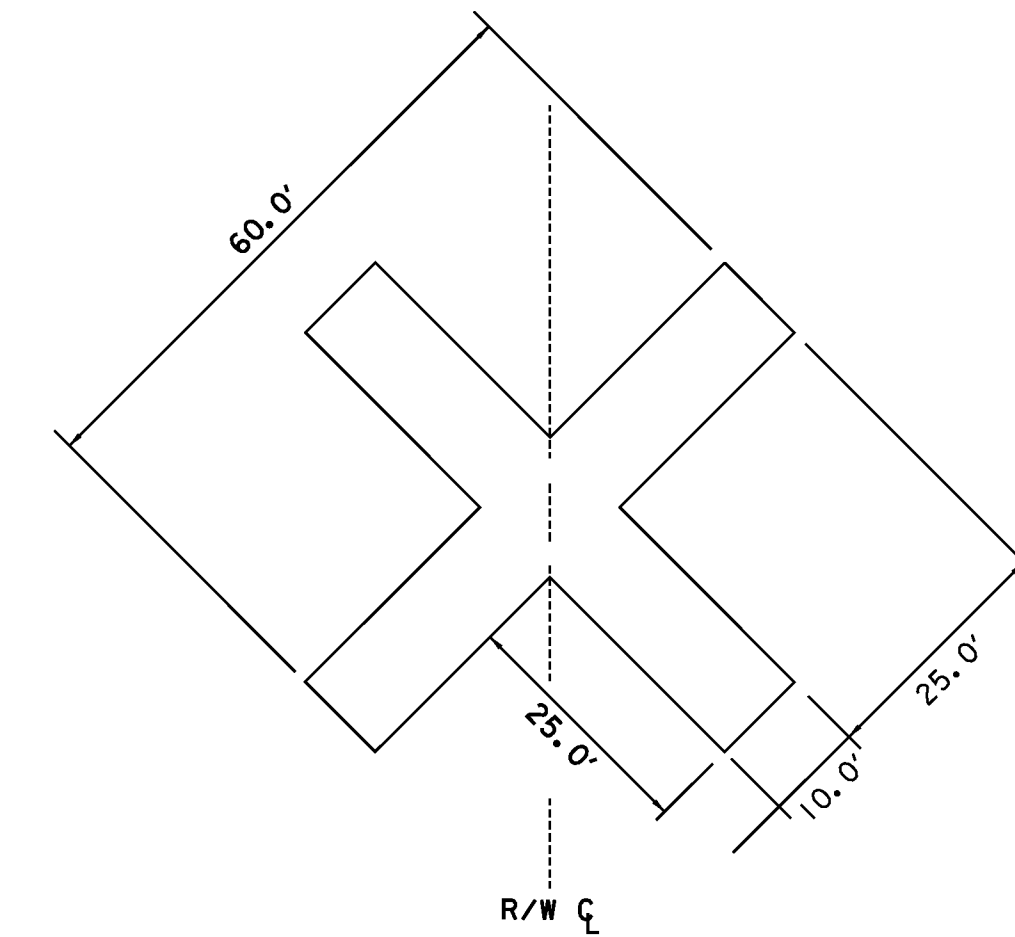


- MARKER NOTES:**
1. 10' x 60' YELLOW THOROWEAVE 700 AIRPORT RUNWAY "X" SAFETY MARKER VINYL COATED POLYESTER STRING WITH HEMMED PERIMETER AND BRASS GROMMETS AT 3' CENTERS. (2 REQUIRED PER SET, 4 REQUIRED PER RUNWAY) OR APPROVED EQUAL.
 2. CLOSED RUNWAY MARKER COST IS INCIDENTAL TO THE PROJECT.

CLOSED RUNWAY MARKER
NOT TO SCALE

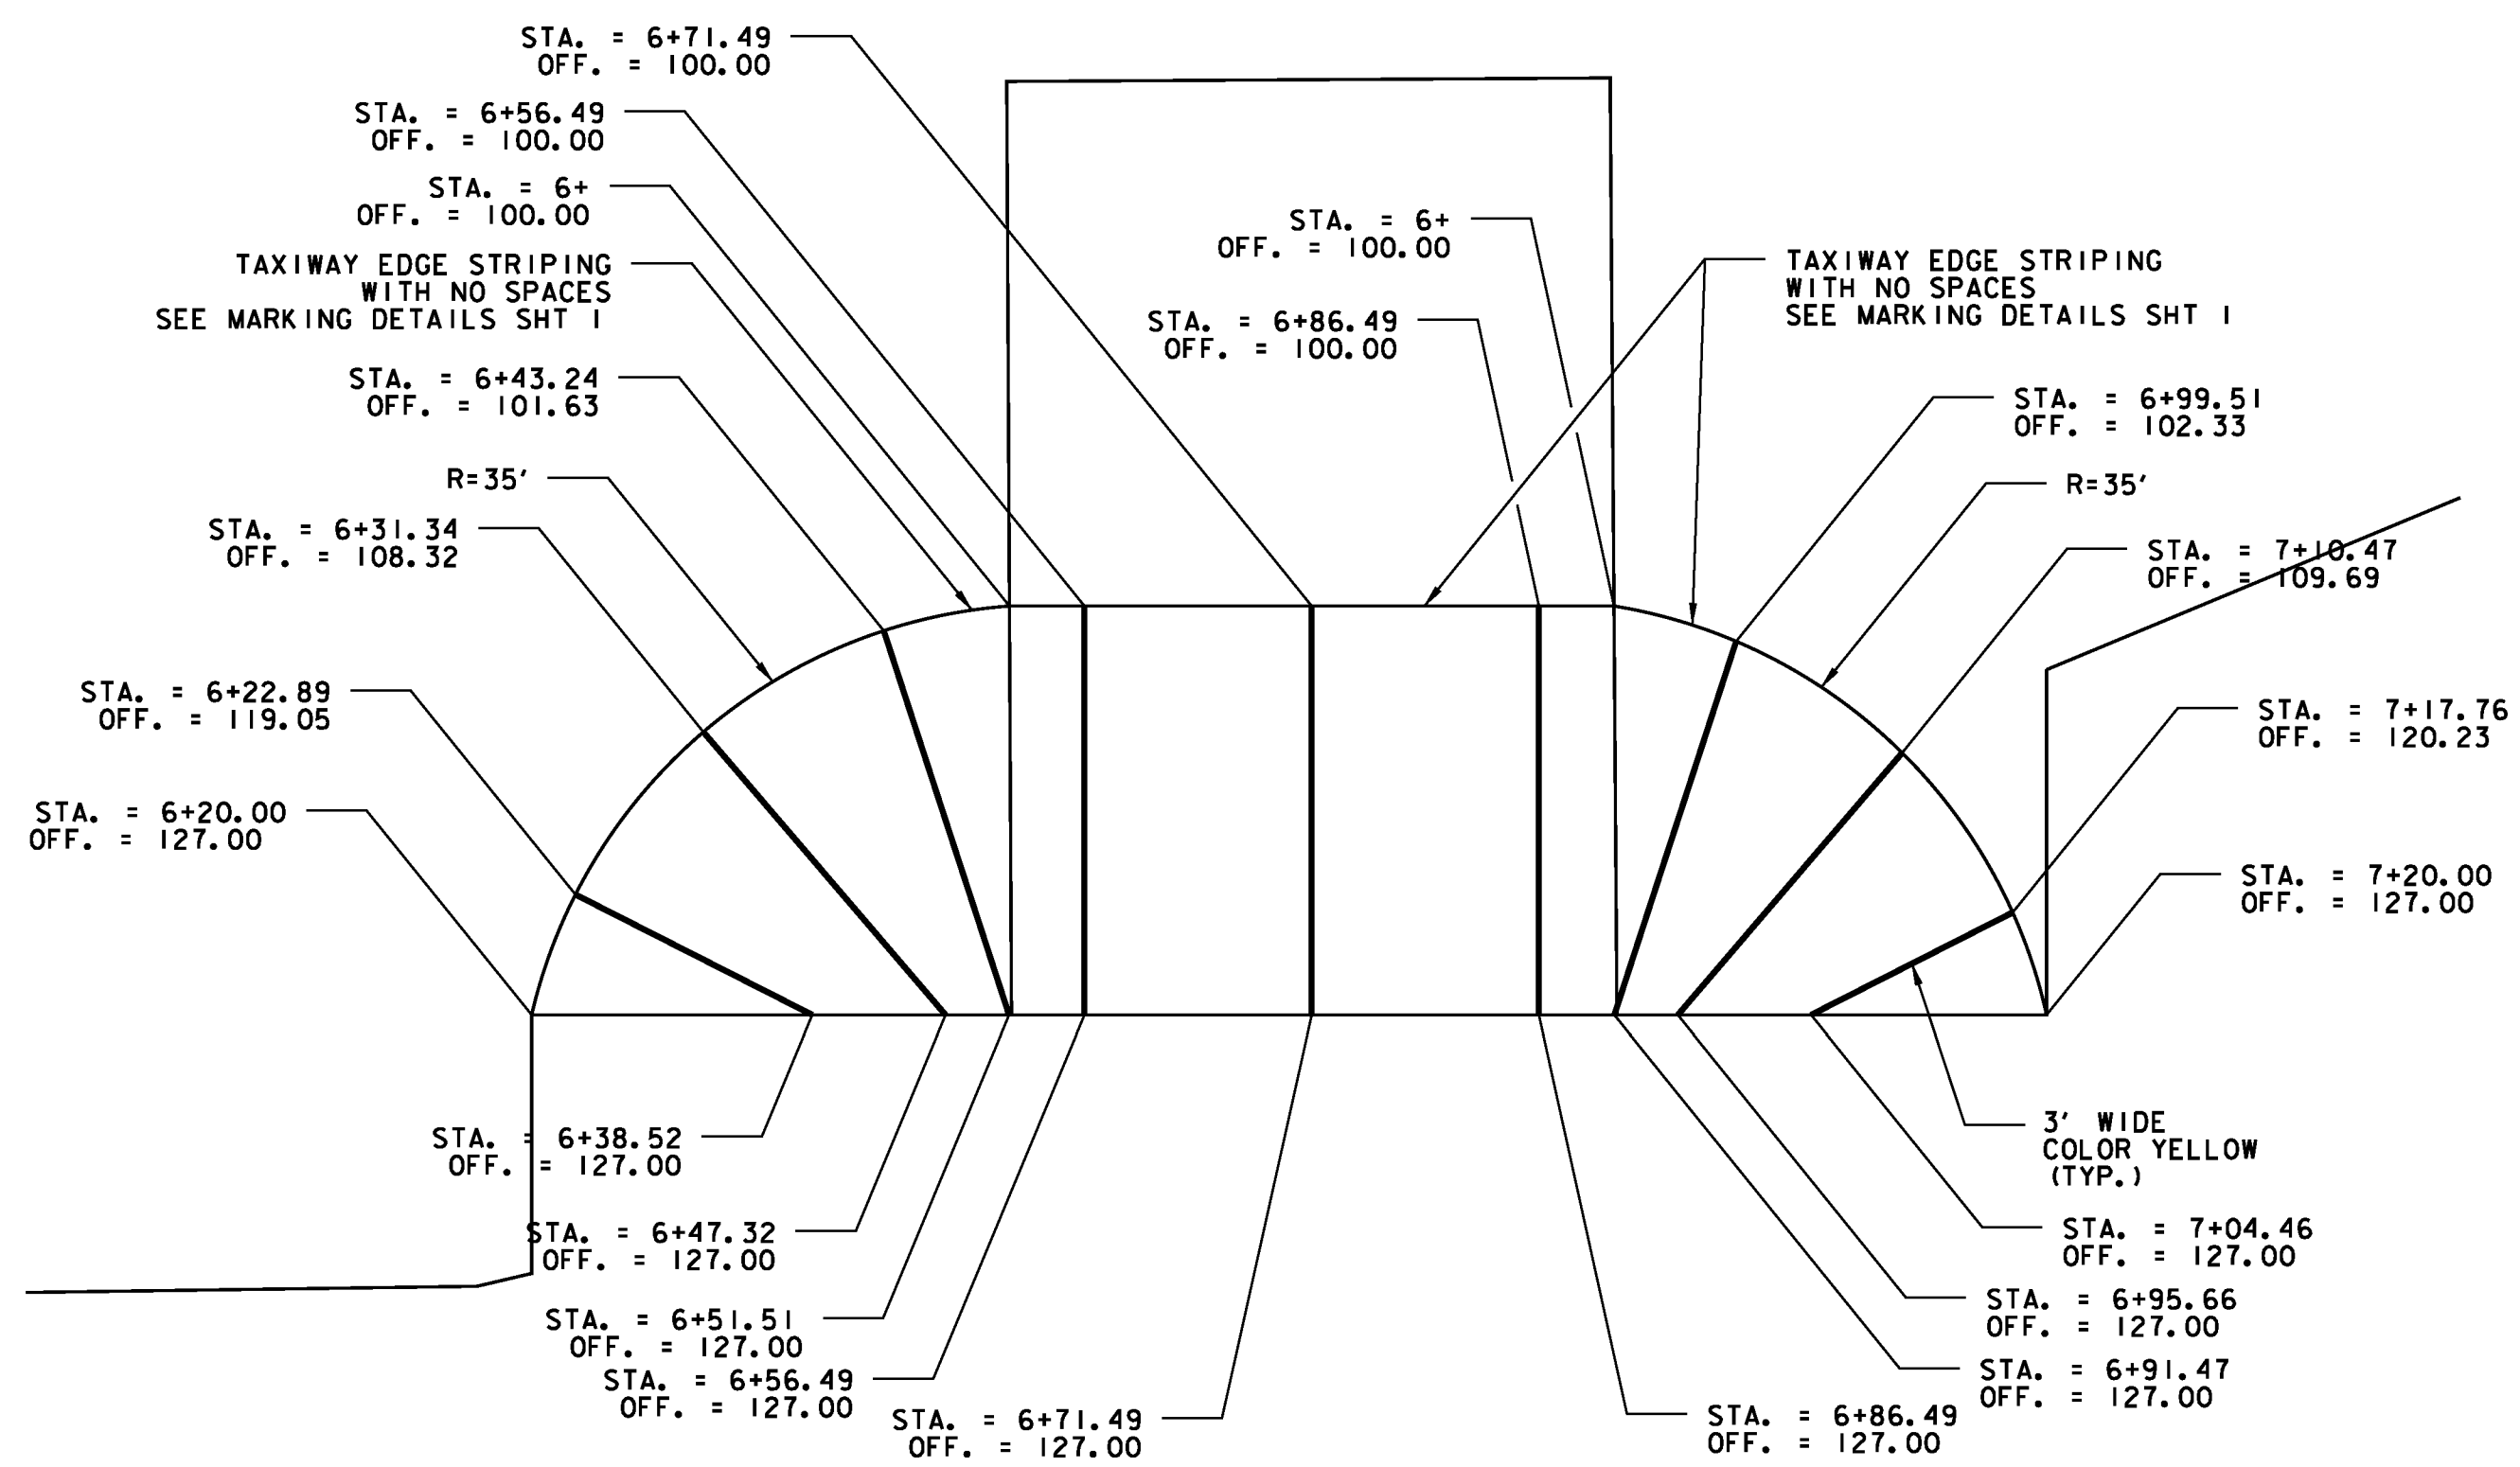


NOTE: STATION AND OFFSET IS FROM TAXIWAY 'E' ALIGNMENT.

FUEL FACILITY NON USABLE AREA
NOT TO SCALE

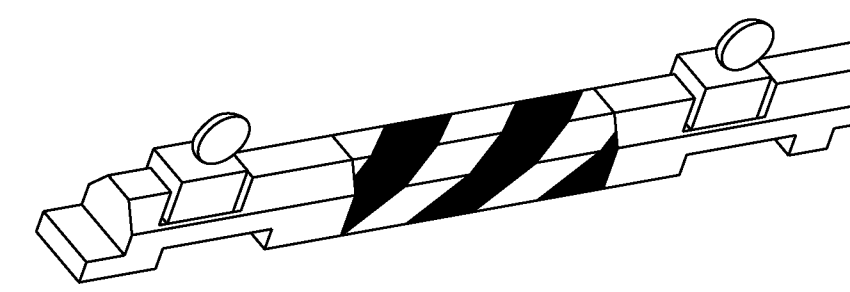

- BARRICADE NOTES:**
1. EACH BARRICADE IS MARKED WITH DIAGONAL, ALTERNATING ORANGE AND WHITE REFLECTIVE GRADE TAPE 6" WIDE. ALSO EACH WILL HAVE TWO 3-WAY APPROVED RED STATE HIGHWAY DEPARTMENT LIGHT.
 2. BARRICADES CAN BE FILLED WITH WATER OR SAND.
 3. DESIGNED TO FAA AC 150/5340-1H & 150/5370-2E SPECIFICATIONS AND PERFORMANCE STANDARDS.
 4. MADE OF DURABLE POLYETHYLENE PLASTIC.
 5. DIMENSIONS: 6" (H) x 6" (W) x 6' (L).
 6. BARRICADE COST IS INCIDENTAL TO THE PROJECT. CONTRACTOR SHALL PROVIDE UNITS TO THE OWNER AT END OF PROJECT.

LOW-PROFILE BARRICADE
NOT TO SCALE

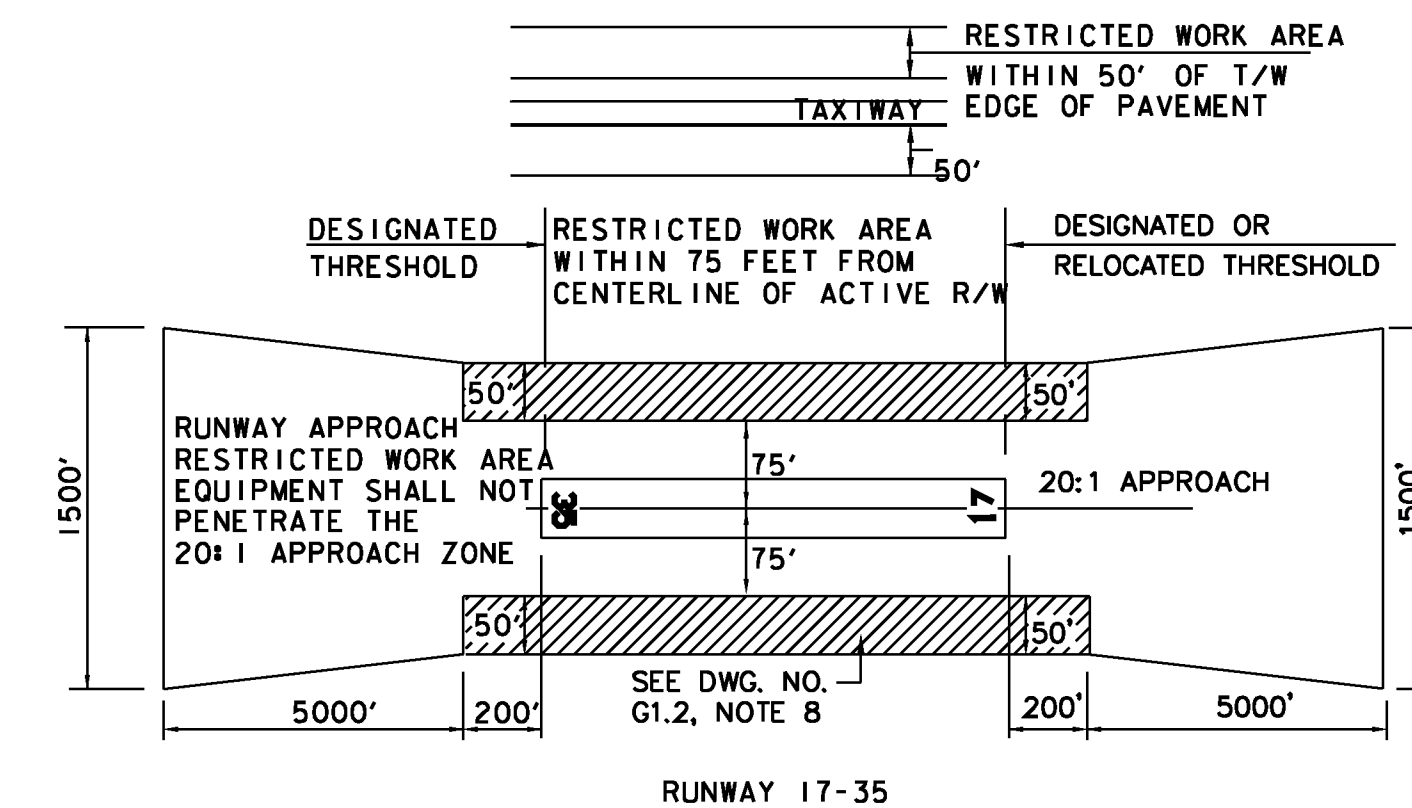

RESTRICTED CONSTRUCTION AREAS
NOT TO SCALE

Hoyle, Tanner & Associates, Inc.

150 Dow Street
Manchester, NH 03101-1227
Tel 603-669-5555
Fax 603-669-4168
Web Page: www.hoyletanner.com
Hoyle Tanner & Associates © 2008

PROJECT NAME: E. F. KNAPP STATE AIRPORT
A.I.P. 3-50-0001-011-2009
PROJECT NUMBER: BERLIN AIR 04-3216

FILE NAME: 302803_sht_marking_det.dwg DATE: 11/22/2011
PROJECT LEADER: S. FORTNEY DRAWN BY: D. STANDISH
DESIGNED BY: S. BOUCHARD CHECKED BY: J. DOWNAR
MARKING DETAILS SHT 2 SHEET 118 OF 173