


STA. 5+50 TO STA. 7+14

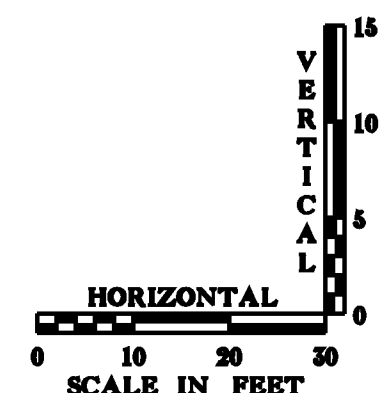

Hoyle, Tanner & Associates, Inc.
 150 Dow Street
 Manchester, NH 03101-1227
 Tel 603-669-5555
 Fax 603-669-4168
 Web Page: www.hoyletanner.com
Hoyle, Tanner & Associates © 2008

PROJECT NAME: E. F. KNAPP STATE AIRPORT
 A.I.P. 3-50-0001-011-2009
 PROJECT NUMBER: BERLIN AIR 04-3216
 FILE NAME: 302803_sht.cxsec.F.dgn
 PROJECT LEADER: S. FORTNEY
 DESIGNED BY: S. BOUCHARD
 TAXIWAY F CROSS SECTION SHT 4
 PLOT DATE: 11/22/2011
 DRAWN BY: D. STANDISH
 CHECKED BY: J. DOWNAR
 SHEET 140 OF 173

TAXIWAY F CROSS SECTION SHT 4