
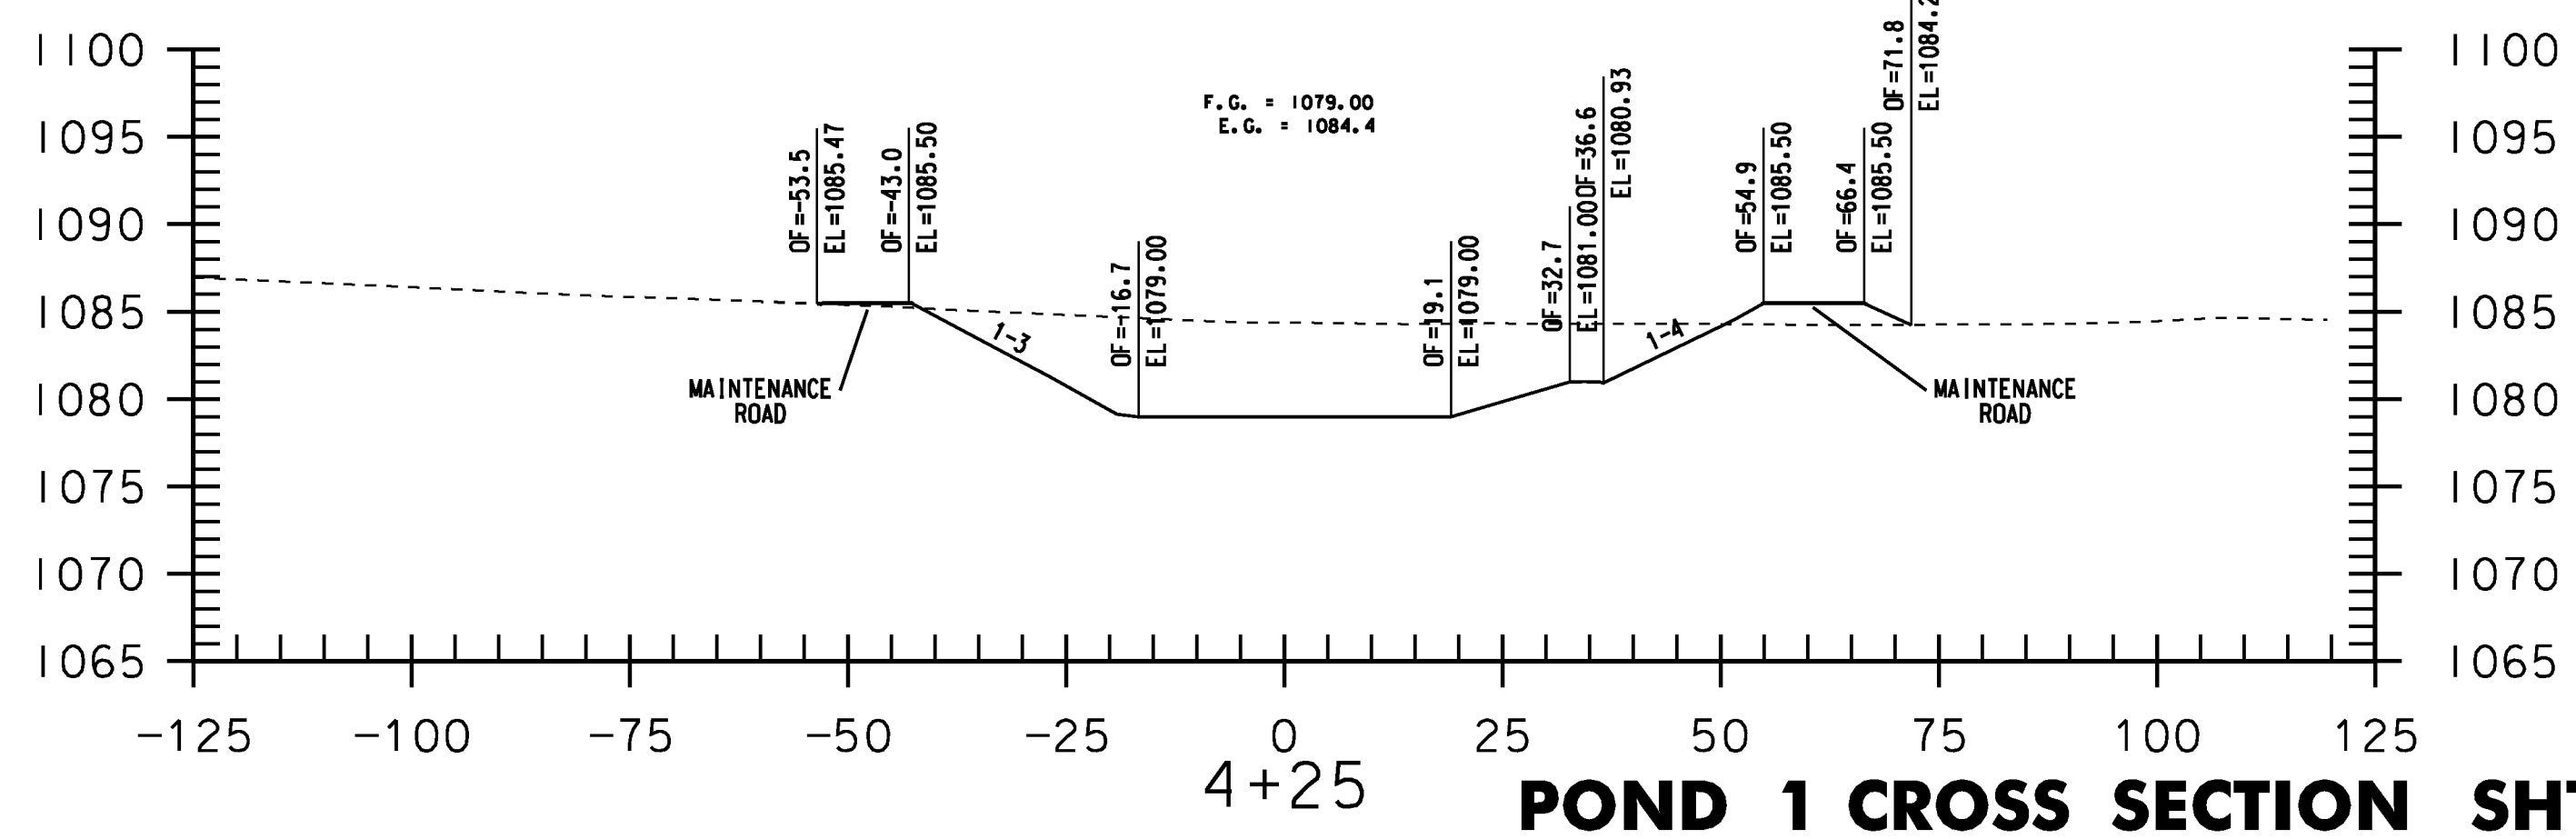
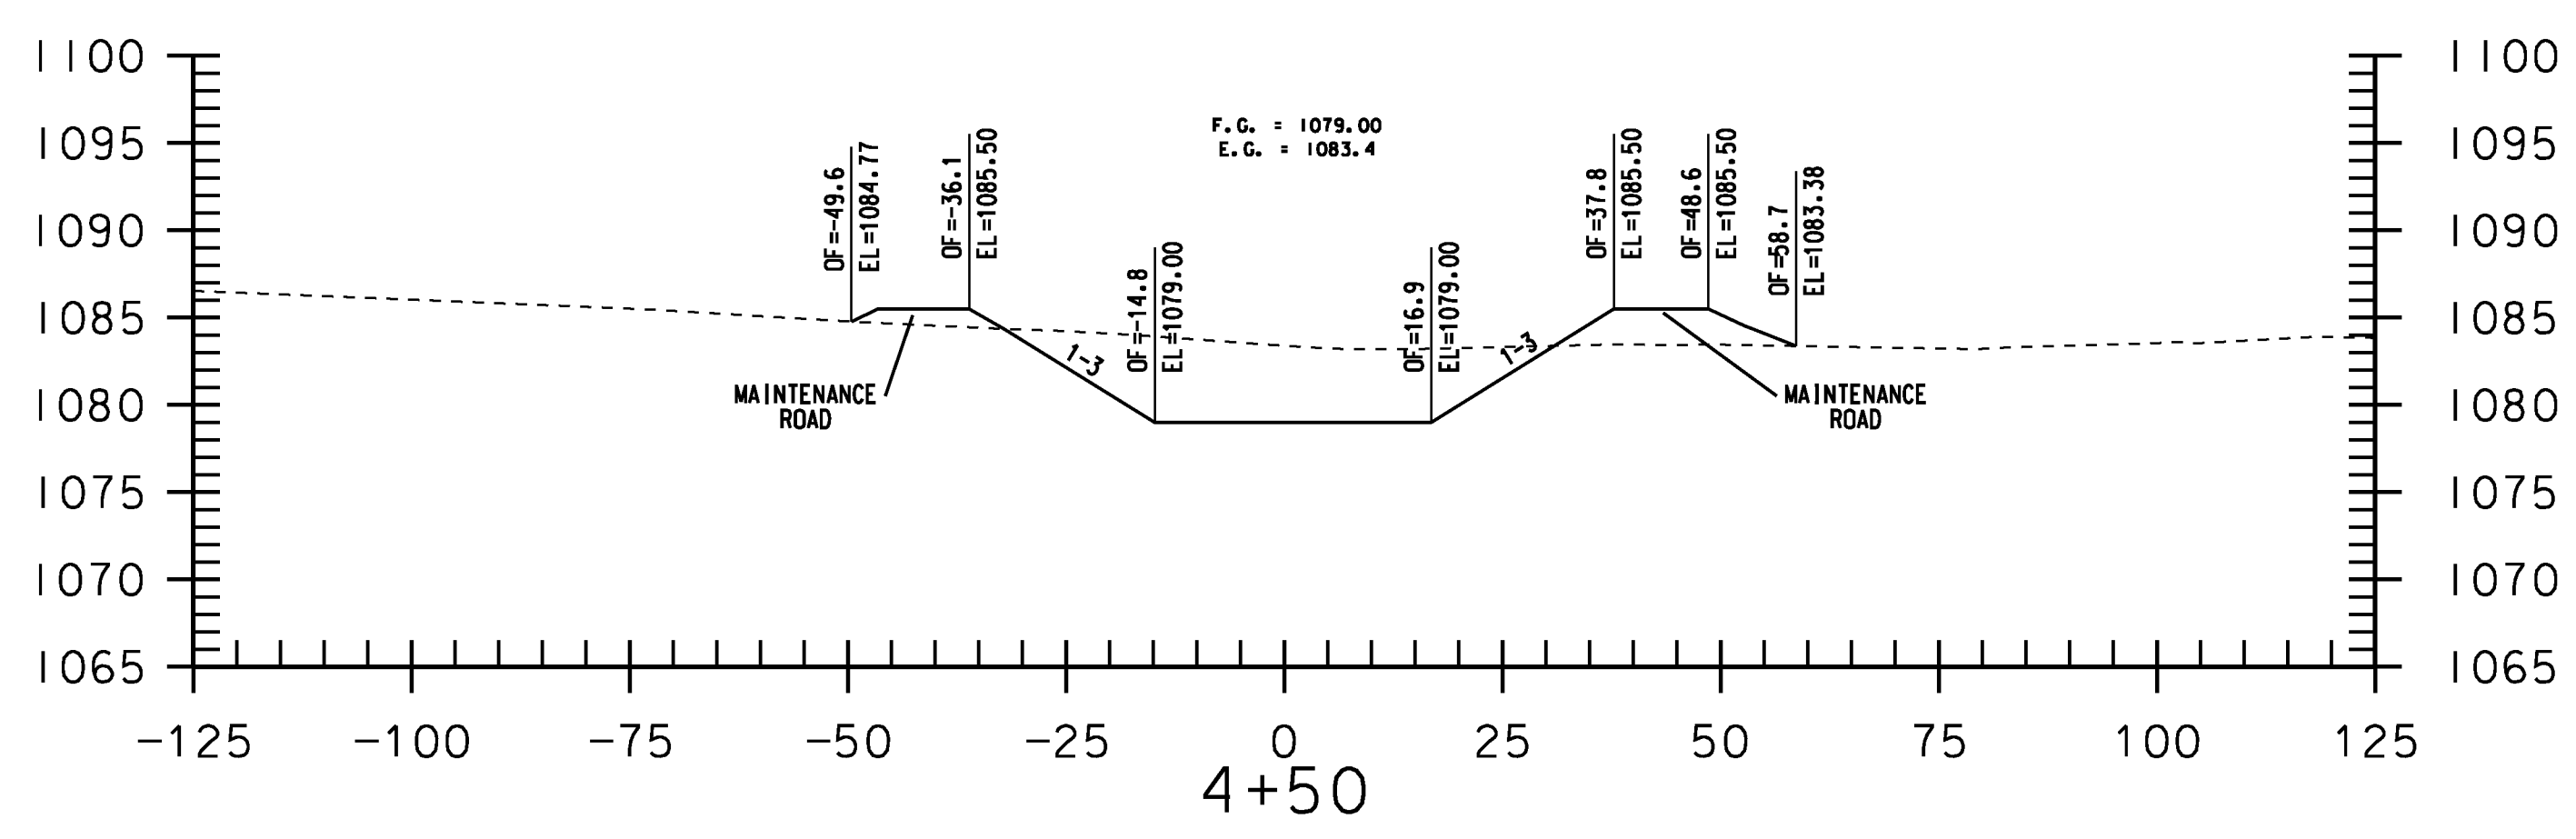
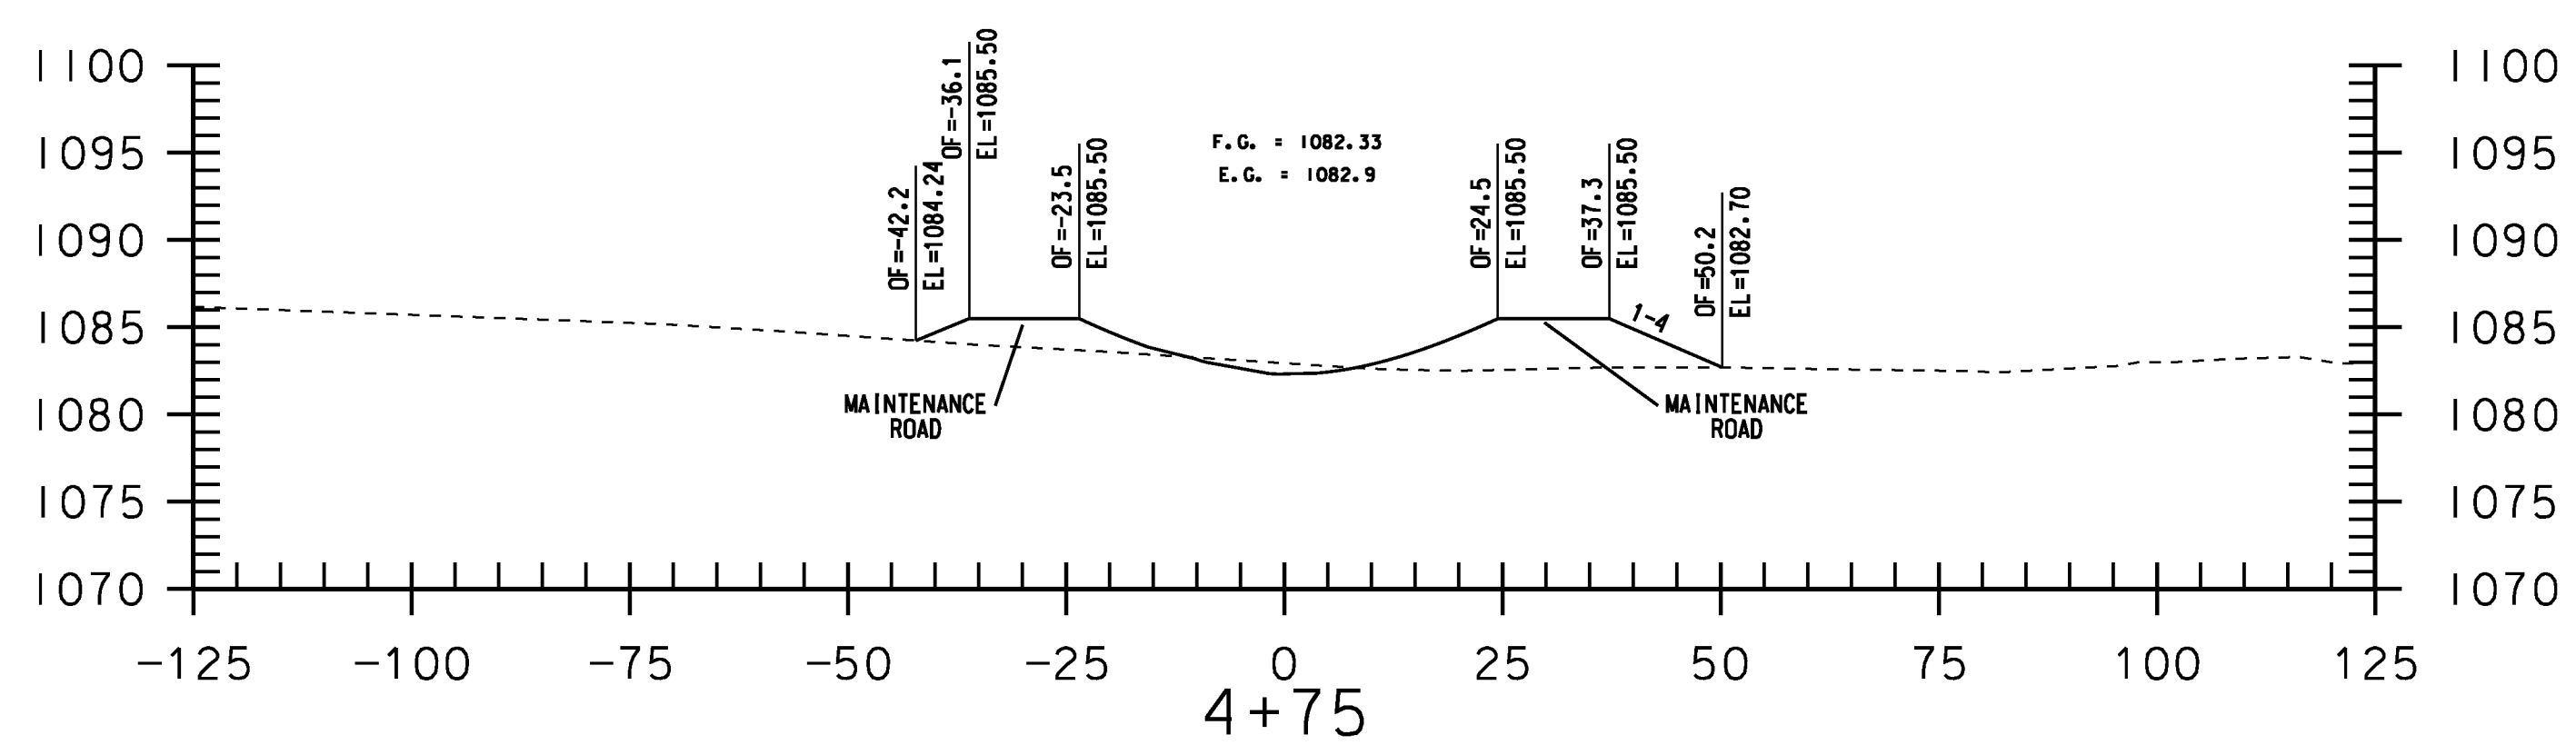
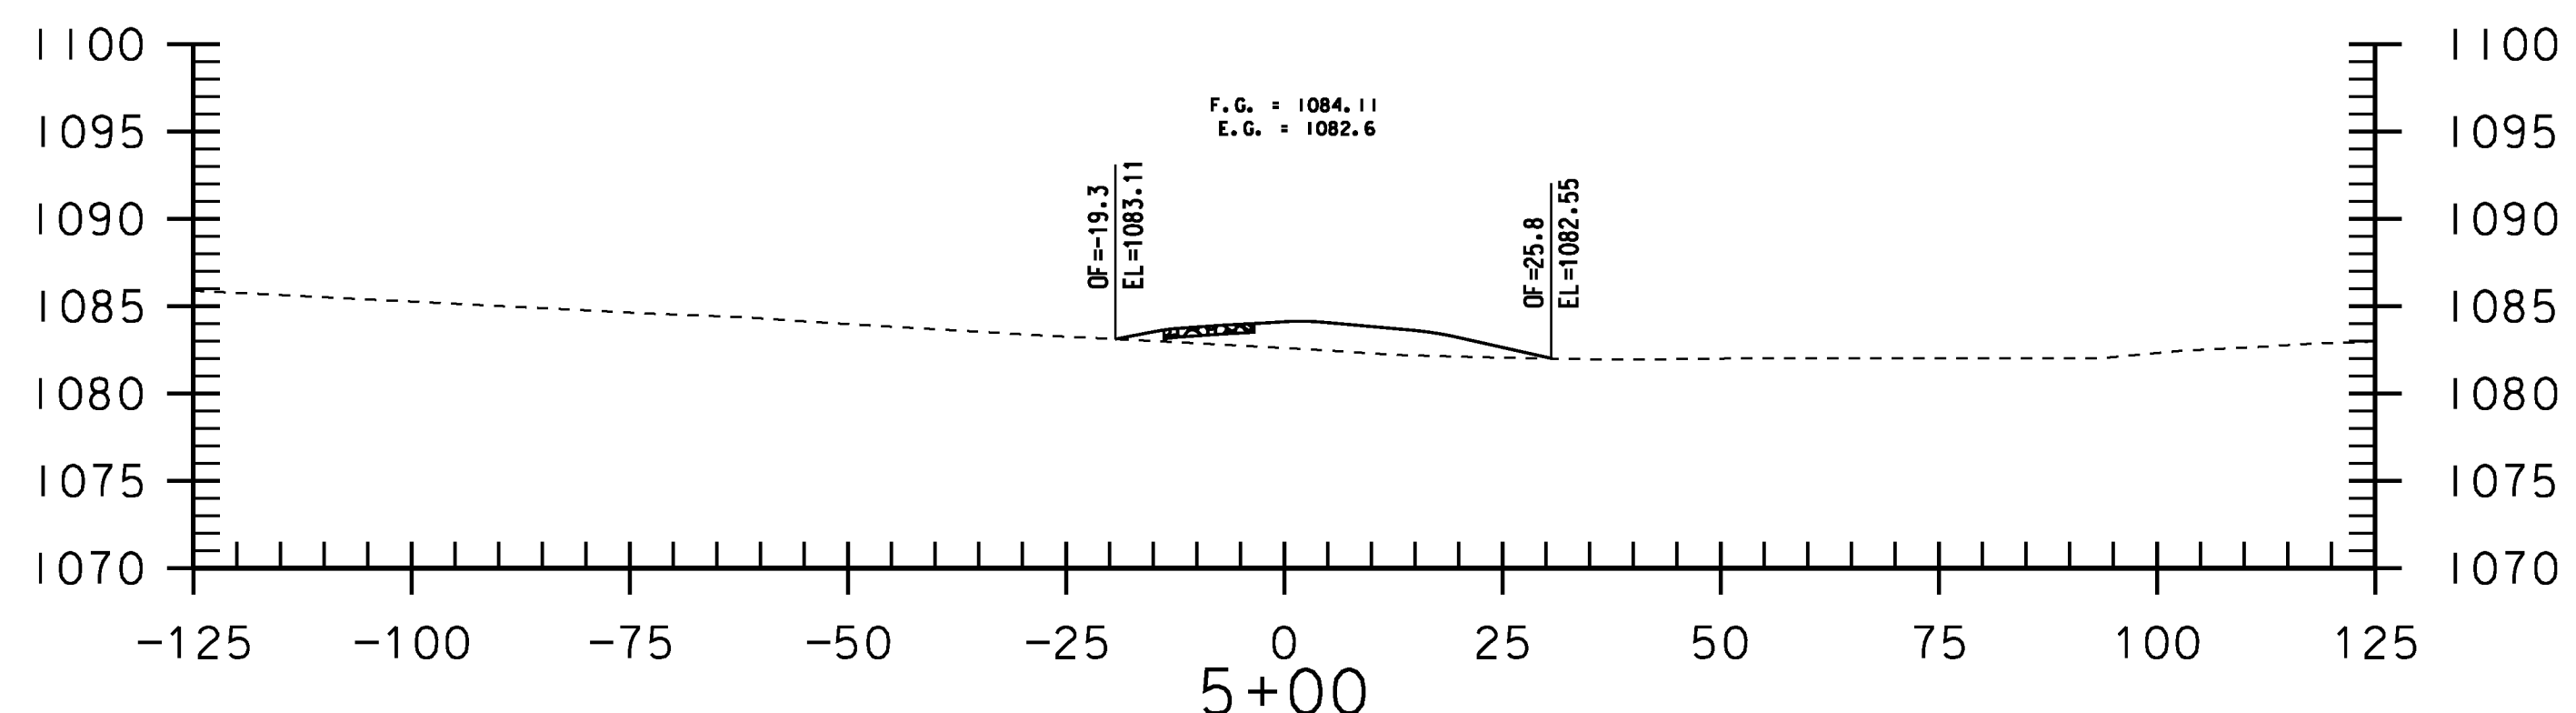


STA. 3+50 TO STA. 5+00

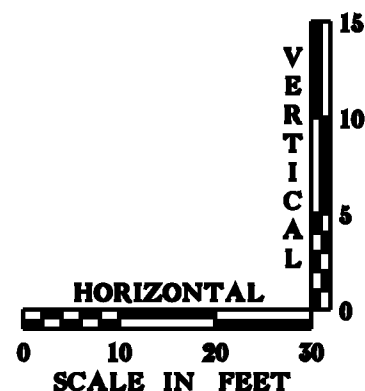

**POND 1 CROSS SECTION SHT 2**

PROJECT NAME: E. F. KNAPP STATE AIRPORT  
 A.I.P. 3-50-0001-011-2009  
 PROJECT NUMBER: BERLIN AIR 04-3216  
 FILE NAME: z05h378sht\_1\_Pond1.dgn PLOT DATE: 11/22/2011  
 PROJECT LEADER: S. FORTNEY DRAWN BY: D. STANDISH  
 DESIGNED BY: S. BOUCHARD CHECKED BY: J. DOWNAR  
 POND 1 CROSS SECTION SHT 2 SHEET 142 OF 173

**Hoyle, Tanner & Associates, Inc.**  
 150 Dow Street  
 Manchester, NH 03101-1227  
 Tel 603-669-5555  
 Fax 603-669-4168  
 Web Page: www.hoyletanner.com  
Hoyle Tanner & Associates © 2008