


STA. 20+00 TO STA. 21+25

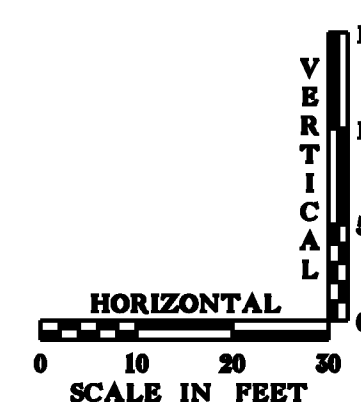

**Hoyle, Tanner & Associates, Inc.**  
150 Dow Street  
Manchester, NH 03101-1227  
Tel 603-669-5555  
Fax 603-669-4168  
Web Page: [www.hoyletanner.com](http://www.hoyletanner.com)  
Hoyle, Tanner & Associates © 2008

**POND 2 CROSS SECTION SHT 1**

PROJECT NAME: E. F. KNAPP STATE AIRPORT  
A.I.P. 3-50-0001-011-2009  
PROJECT NUMBER: BERLIN AIR 04-3216  
FILE NAME: z05h378sht\_.xs2\_Pond2.dgn PLOT DATE: 11/22/2011  
PROJECT LEADER: S. FORTNEY DRAWN BY: D. STANDISH  
DESIGNED BY: S. BOUCHARD CHECKED BY: J. DOWNAR  
POND 2 CROSS SECTION SHT 1 SHEET 143 OF 173