


STA. 3+25 TO STA. 4+04

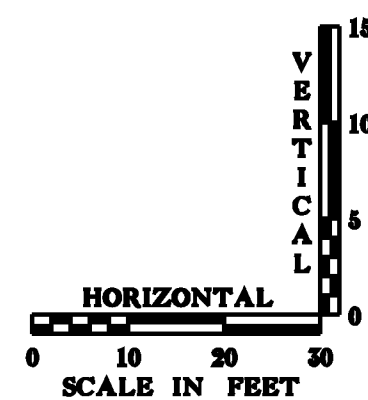

**Hoyle, Tanner & Associates, Inc.**  
 150 Dow Street  
 Manchester, NH 03101-1227  
 Tel 603-669-5555  
 Fax 603-669-4168  
 Web Page: www.hoyletanner.com  
Hoyle, Tanner & Associates © 2008

PROJECT NAME: E. F. KNAPP STATE AIRPORT  
 A.I.P. 3-50-0001-011-2009  
 PROJECT NUMBER: BERLIN AIR 04-3216

**MALSAR CROSS SECTION SHT 3**

PROJECT LEADER: S. FORTNEY  
 DESIGNED BY: S. BOUCHARD  
 MALSAR CROSS SECTION SHT 3  
 DRAWN BY: D. STANDISH  
 CHECKED BY: J. DOWNAR  
 SHEET 148 OF 173