


STA. 138+00 TO STA. 141+50

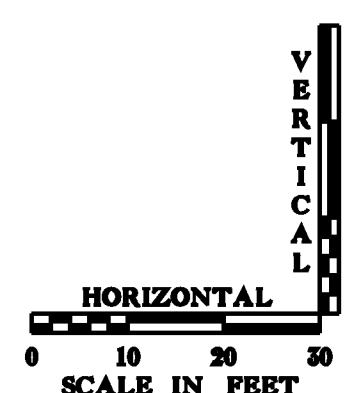

Hoyle, Tanner & Associates, Inc.
150 Dow Street
Manchester, NH 03101-1227
Tel 603-669-5555
Fax 603-669-4168
Web Page: www.hoyletanner.com
Hoyle, Tanner & Associates © 2008

RUNWAY 5-23 CROSS SECTIONS

PROJECT NAME: E. F. KNAPP STATE AIRPORT
A.I.P. 3-50-0001-011-2009
PROJECT NUMBER: BERLIN AIR 04-3216
FILE NAME: 302803_sht.cxsec.5-23.dgn
PROJECT LEADER: S. FORTNEY
DESIGNED BY: S. BOUCHARD
RUNWAY 5-23 CROSS SECTIONS

LOT DATE: 11/22/2011
DRAWN BY: D. STANDISH
CHECKED BY: J. DOWNAR
SHEET 150 OF 173