



STATE OF VERMONT AGENCY OF TRANSPORTATION

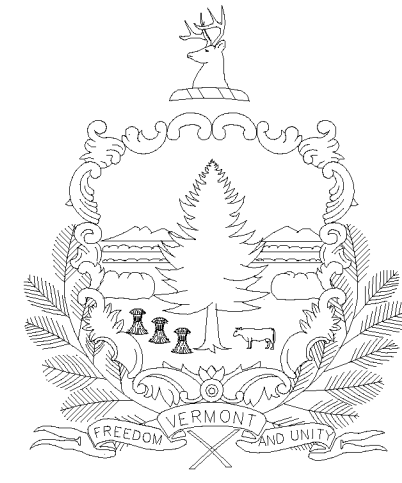


HARTNESS STATE AIRPORT HAZARD BEACON REPLACEMENT SPRINGFIELD, VERMONT

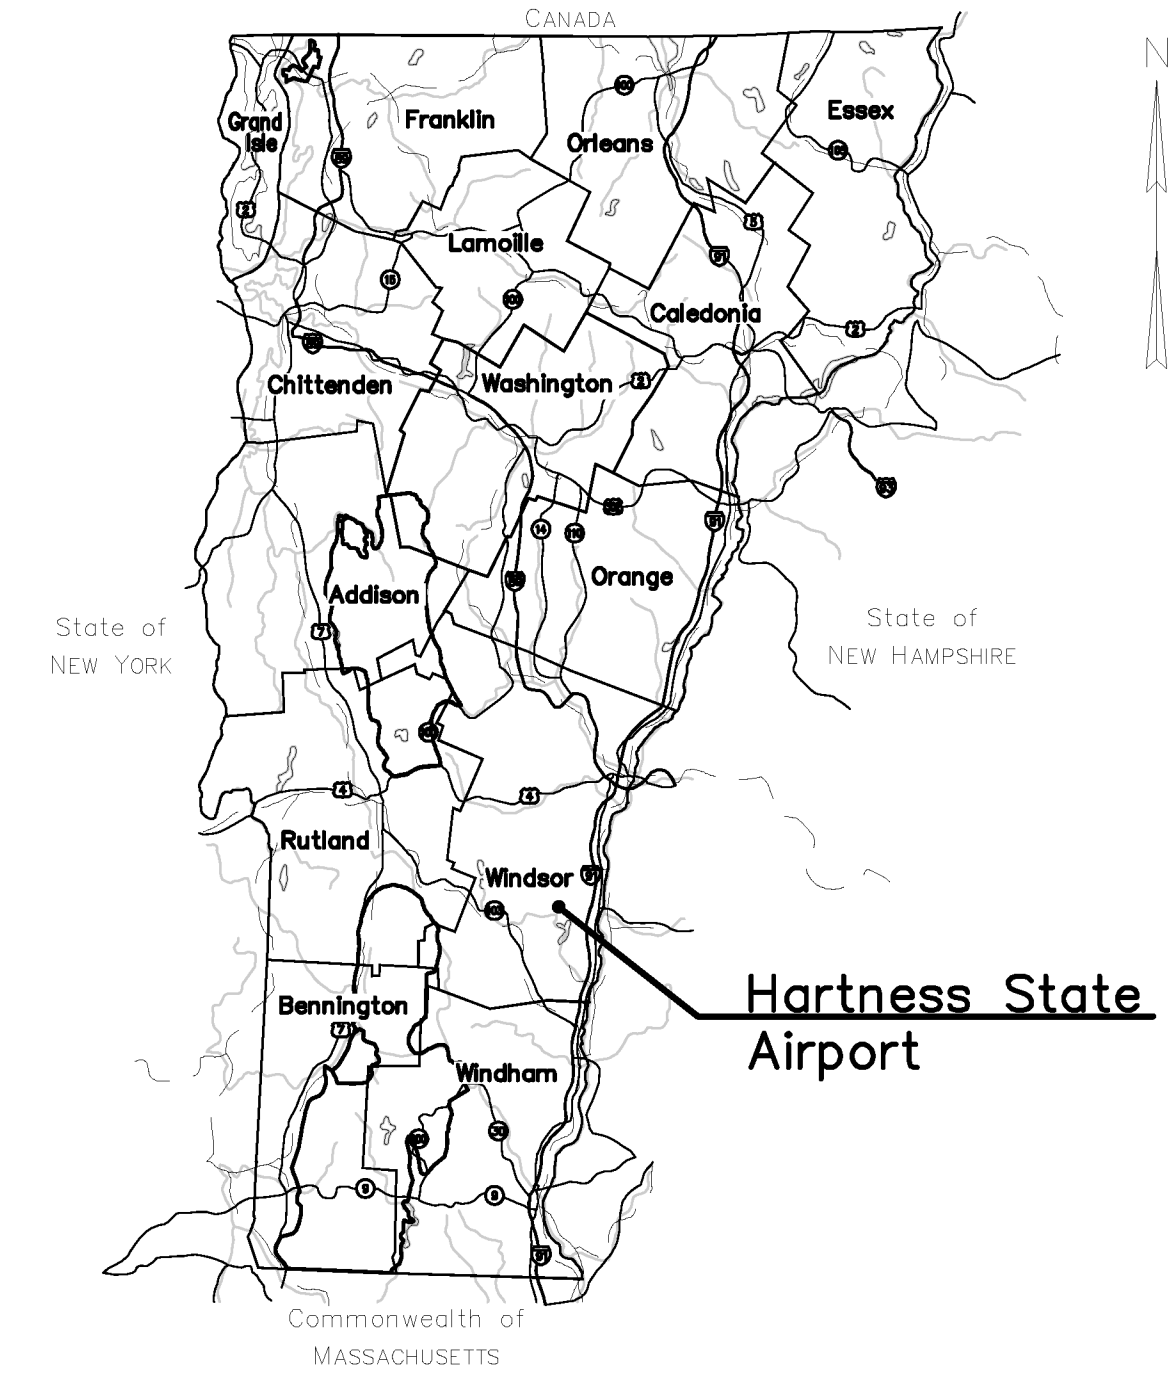

STATE OF VERMONT
NOT TO SCALE

INDEX OF SHEETS:


- C-001 TITLE SHEET
- C-002 GENERAL NOTES
- C-003 SUBSURFACE LOGS
- C-004 SUBSURFACE LOGS
- C-005 SUBSURFACE LOG PLANS
- C-101 BEACON 1 SITE PLAN
- C-102 BEACON 17 SITE PLAN
- C-103 BEACON 18 SITE PLAN
- C-104 BEACON 19 SITE PLAN
- E-001 ELECTRICAL LEGEND & NOTES
- E-401 ELECTRICAL DETAILS
- E-402 ELECTRICAL DETAILS
- S-101 STRUCTURAL DETAILS
- S-102 STRUCTURAL DETAILS

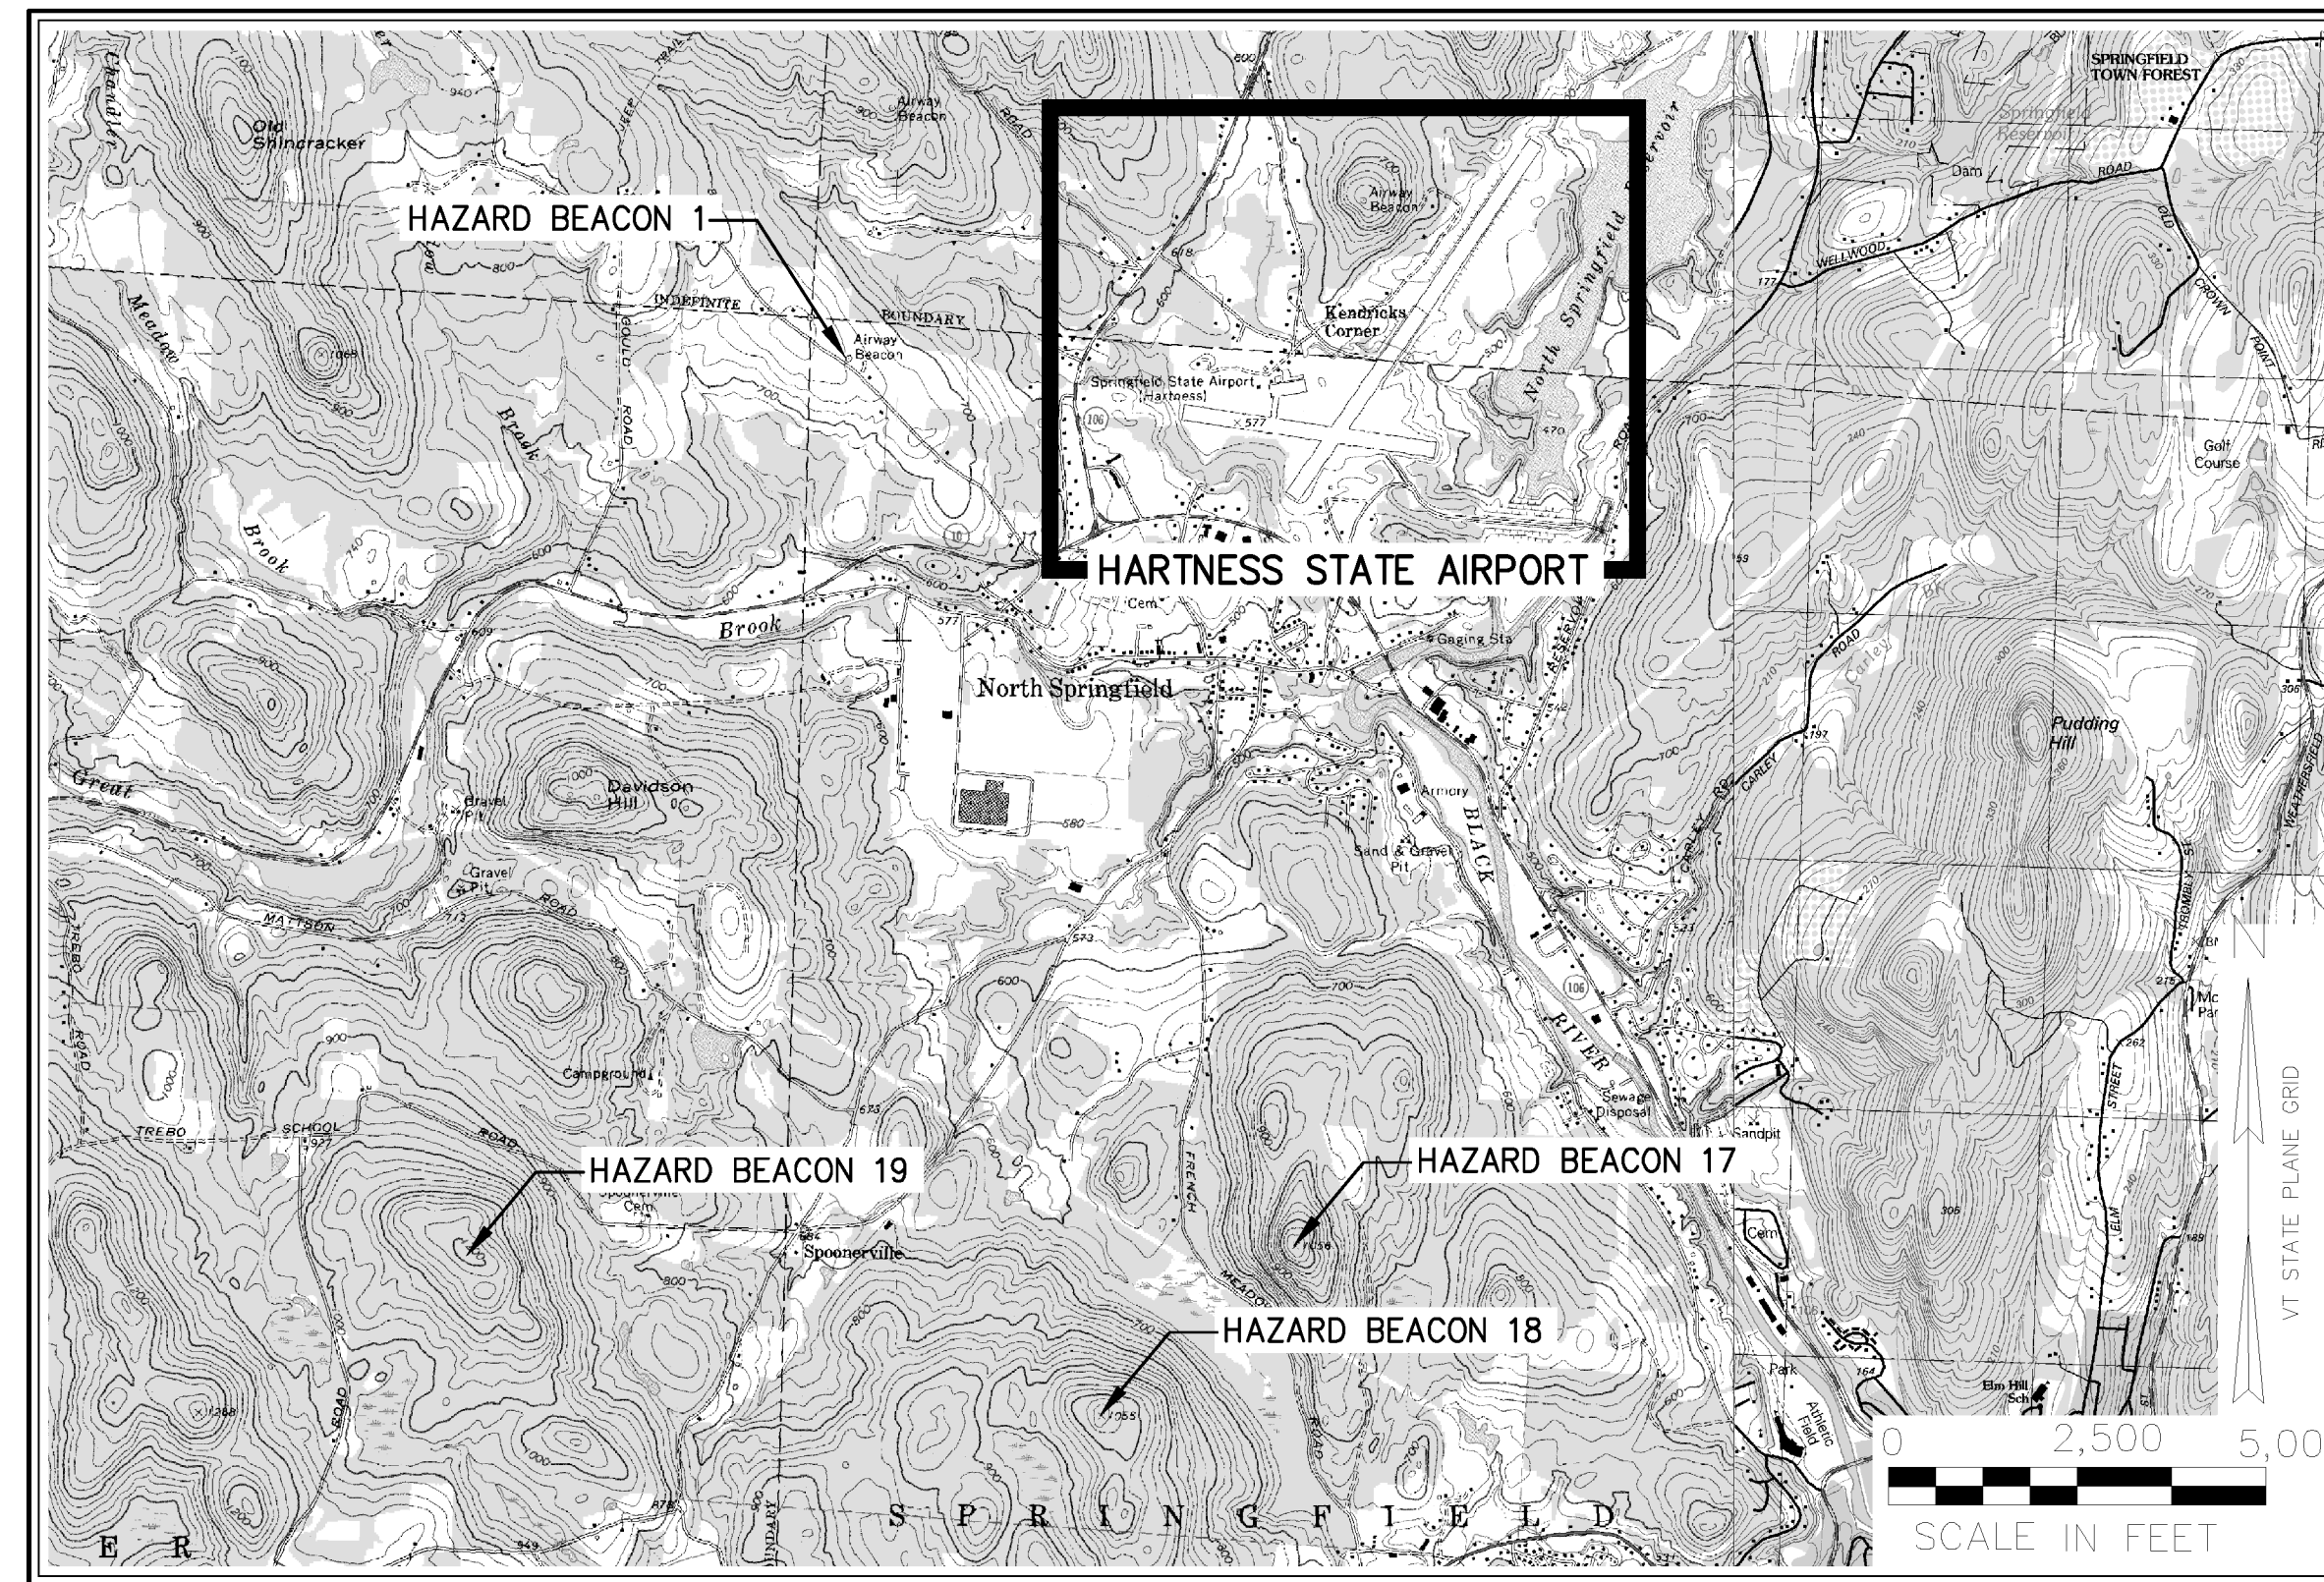

BEACON LOCATION MAP
SCALE: AS NOTED

App'd By	Date
HAW	07/07/13
Submitted / Revision	
RECORD DRAWINGS	

STATE OF VERMONT
AGENCY OF TRANSPORTATION

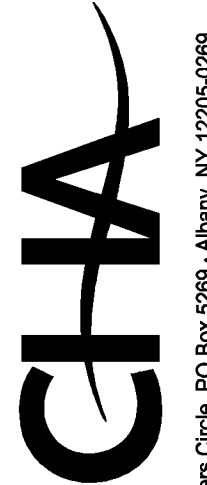

 III Winners Circle, PO Box 5089 - Albany, NY 12205-0289
 Main: (518) 453-4500 • www.chacompanies.com

Designed: HAW | Drawn: HAW | Checked: TYL
UNAUTHORIZED ALTERATION OR ADDITION OF ANY INFORMATION IS PROHIBITED AND WILL BE SUBJECT TO APPLICABLE STATE AND/OR LOCAL LAWS

HARTNESS STATE AIRPORT
 HAZARD BEACON REPLACEMENT
 TITLE SHEET

Issue Date: 03/18/11 | Project No.: 21674 | Scale: As Shown

RECORD DRAWING 07/07/13

C-001

File: V:\PROJECTS\WV\21674\CADD\ACAD\...SHEET_FILES\C001-21674.DWG
 Saved: 1/4/2013 4:14:12 PM Printed: 1/4/2013 4:25:25 PM User: WyoJ, Heather LastSavedBy: 2789

GENERAL NOTES:

1. ALL WORK SHALL BE DONE IN STRICT COMPLIANCE WITH ALL APPLICABLE NATIONAL, STATE, AND LOCAL CODES, STANDARDS, ORDINANCES, RULES, AND REGULATIONS.
2. THE ENGINEER RESERVES THE RIGHT TO EXAMINE ANY WORK DONE ON THIS PROJECT AT ANY TIME TO DETERMINE THE CONFORMANCE WITH THE REQUIREMENTS OF THE CONTRACT DOCUMENTS OF THIS PROJECT, AS INTENDED AND INTERPRETED BY THE ENGINEER.
3. ALL SITE WORK SHALL BE AS INDICATED ON THE DRAWINGS AND STIPULATED IN THE PROJECT SPECIFICATIONS.
4. STORAGE AREAS FOR CONTRACTOR'S EQUIPMENT AND MATERIALS SHALL BE WITHIN THE EASEMENT LIMITS ONLY.
5. THE CONTRACTOR SHALL:
 - A. VERIFY ALL CONDITIONS IN THE FIELD PRIOR TO COMMENCEMENT OF WORK AND NOTIFY THE ENGINEER OF ANY DISCREPANCIES.
 - B. EXAMINE THE SITE AND INCLUDE IN HIS WORK THE EFFECT OF ALL EXISTING CONDITIONS ON THE WORK.
 - C. PROVIDE AND INSTALL ALL MATERIALS AND PERFORM ALL WORK IN ACCORDANCE WITH RECOGNIZED GOOD STANDARD PRACTICE.
 - D. HOLD THE OWNER HARMLESS AGAINST ANY AND ALL CLAIMS ARISING FROM WORK DONE BY THE CONTRACTOR ON THE SITE.
6. RUBBISH, DEBRIS, AND OTHER REFUSE SHALL BE REMOVED FROM THE SITE AND DISPOSED OF LEGALLY.
7. ALL EXISTING ACTIVE ELECTRIC AND OTHER UTILITIES WHERE ENCOUNTERED IN THE WORK, SHALL BE PROTECTED AT ALL TIMES, AND WHERE REQUIRED FOR THE PROPER EXECUTION OF THE WORK, SHALL BE RELOCATED AS DIRECTED BY ENGINEERS. EXTREME CAUTION SHOULD BE USED BY THE CONTRACTOR WHEN EXCAVATING OR PIER DRILLING AROUND OR NEAR UTILITIES. CONTRACTOR SHALL PROVIDE SAFETY TRAINING FOR THE WORKING CREW.
8. CONTRACTOR SHALL MINIMIZE DISTURBANCE TO EXISTING SITE DURING CONSTRUCTION. EROSION CONTROL MEASURES, IF REQUIRED DURING CONSTRUCTION, SHALL BE IN CONFORMANCE WITH STATE OF VERMONT GUIDELINES FOR EROSION AND SEDIMENT CONTROL AND COORDINATED WITH THE TOWN/COUNTY CODE ENFORCEMENT OFFICE.
9. FOR PROJECTS IN SIMILAR LOCATIONS, A GIN POLE TOWER ERECTION TECHNIQUE HAS BEEN USED AS A COST-EFFECTIVE CONSTRUCTION PRACTICE. HOWEVER, THE TOWER ERECTION MEANS AND METHODS ARE THE CONTRACTOR'S RESPONSIBILITY. NOTE THAT AT THE TOWER SITES, THE CONTRACTOR WILL NOT GENERALLY HAVE ACCESS TO PROPERTY BEYOND THE LIMITS OF THE BEACON TOWER EASEMENTS (AS ILLUSTRATED), WHICH SHOULD BE RECOGNIZED WHEN CONSIDERING ERECTION TECHNIQUES.

REMOVAL NOTES:

1. ALL EXISTING ITEMS REQUIRING REMOVAL SHALL BE REMOVED DOWN TO GRADE, UNLESS OTHERWISE NOTED.
2. ALL EXISTING GUY ANCHORS CAN BE CUT DOWN TO GRADE.
3. ALL EXISTING WOOD DISTRIBUTION POLES SUPPLYING POWER TO THE EXISTING BEACON TOWER SHALL BE CUT 6" BELOW GRADE. THE REMAINING PORTION OF THE POLE UNDERGROUND WILL BE COVERED WITH INSITU SOIL.
4. ALL EXISTING STRUCTURES TO BE REMOVED SHALL BE REMOVED AND DISPOSED OF AT THE CONTRACTORS EXPENSE.
5. ALL ITEMS MARKED FOR REMOVAL AND INCIDENTAL REMOVALS NECESSARY FOR PROPOSED CONSTRUCTION, EXCEPT FOR TREES, SHALL BE DISPOSED OF OFF-SITE AT THE CONTRACTOR'S EXPENSE, INCLUDING ALL CONSTRUCTION DEBRIS.
6. THE CONTRACTOR SHALL RESTORE AREA TO ORIGINAL OR BETTER CONDITION UPON SUBSTANTIAL COMPLETION OF WORK.


RECORD DRAWING 01/07/13

C-002

HARTNESS STATE AIRPORT
HAZARD BEACON REPLACEMENT

GENERAL NOTES


Issue Date: 03/18/11 | Project No.: 21674 | Scale: As Shown

Design: Copyright © 2011

 III Winners Circle, PO Box 5589 - Albany, NY 12205-0289
 Main: (518) 453-4500 • www.chacompanies.com
 Designed: HAW | Drawn: HAW | Checked: TYL

UNAUTHORIZED ALTERATION OR ADDITION
 OF THIS DRAWING IS PROHIBITED BY APPLICABLE STATE AND/OR LOCAL LAWS

STATE OF VERMONT
AGENCY OF TRANSPORTATION

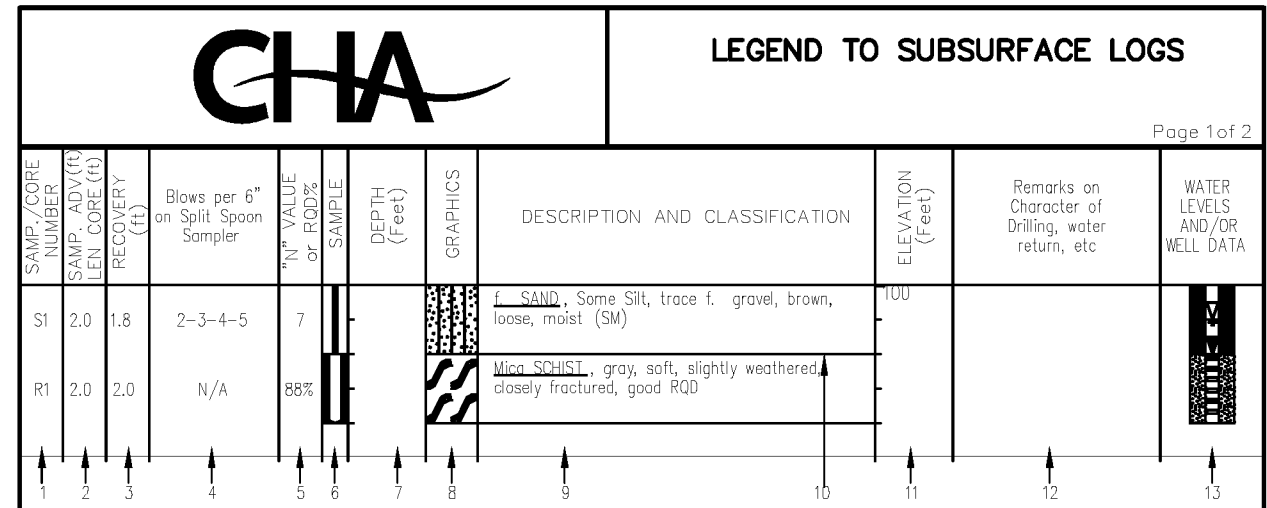No.	Submitted / Revision	App'd By	Date
1	RECORD DRAWINGS	HAW	01/07/13



Subsurface Logs present material classifications, test data, and observations from subsurface investigations of the subject site as required by the requesting geologist or engineer. In some cases, the classifications may be made based on laboratory test data when available. It should be noted that the investigation procedures only recover a small portion of the subsurface materials at the site. Therefore, actual conditions between borings and sampled intervals may differ from those presented on the Subsurface Logs. The information presented on the logs provide a basis for an evaluation of the subsurface conditions and may indicate the need for additional exploration. Any evaluation of the conditions reported on the logs must be performed by Professional Engineers or Geologists.

- SAMPLE CORE NUMBER** - Samples are numbered for identification on containers, laboratory reports or in text reports.
- SAMPLE ADVANCE/CORE** - Length of sampler advance or length of coring run measured in feet.
- RECOVERY** - Amount of sample actually recovered after withdrawing sampler or core barrel from bore hole measured in feet.
- SAMPLE BLOW COUNT** - Unless otherwise noted, blow counts represent values obtained by driving a 2" (50.8 mm) diameter split spoon sampler into the subsurface strata with a 140 pound weight falling 30" on ASTM D 1586. After an initial penetration of 6" to test the sampler into undisturbed material, the sampler is then driven an additional 2 or 3 six inch increments.
- "N" VALUE or RQD %** - "N" VALUE - The sum of the second and third sample blow increments is generally termed the Standard Penetration Test (SPT) "N" value. CORE RQD - Core Rock Quality Designation, RQD, is defined as the summed length of all pieces of core equal to or longer than 4 inches divided by the total length of the coring run. Fresh, irregular breaks distinguishable as being caused by drilling or recovery operations are ignored and the pieces are counted as intact lengths. RQD values are valid only for cores obtained with six size core barrels.
- SAMPLE** - Graphical presentation of sample type and advance or core run length. See Table 1.
- DEPTH** - Depth as measured from the ground surface in feet.
- GRAPHICS** - Graphical presentation of subsurface materials. See Table 4. Dual soil classification and rock graphics may vary and are not shown on Table 4.
- DESCRIPTION AND CLASSIFICATION** - Soil - Recovered samples are visually classified in the field by the supervising geologist or engineer unless otherwise noted. Particle size and plasticity classification is based on field observations and using the Unified Soil Classification System (USCS). See Table 4. USCS symbols are presented in parentheses following the soil description. Where necessary, dual symbols may be used for combinations of soil types. Relative proportions, by weight and/or plasticity, are described in general accordance with "Suggested Methods of Test for Identification of Soils" by J.M. Burmeister, ASTM Spec. Publication #79, 6-1973. See Table 2. Soil density or consistency description is based on the penetration resistance. See Table 3. Soil moisture description is based on the observed wetness of the soil recovered being dry, moist, wet, or saturated. Water introduced into the soil during drilling may affect the moisture content of the materials. Other geologic terms may also be used to further describe the subsurface materials. Rock flow rate descriptions are based on the engineer's observations and may be expanded and described in greater detail by the project engineer or geologist. Terms used in the description of rock core are presented in Table 5.
- BOUNDARIES** - Division lines between deposits are based on field observations and changes in recovered material. Soil lines depict contacts between two deposits of different geologic depositional environment or flow elevation. Dashed lines represent estimated elevation of contacts between two deposits of different geologic depositional environment. Dotted lines depict transitions of deposits within the same depositional environment, such as grain size or density.
- ELEVATION** - Elevation of strata changes in feet.
- REMARKS** - Miscellaneous observations.
- WATER LEVELS & WELL DATA** - Hollow water level symbol, if present, represents level at which first saturated sample of water level was encountered. Solid water level symbol, if present, depicts the most probable static water elevation at the time of drilling or as measured in an installed observation well at a later date. Subsurface water conditions are influenced by factors such as precipitation, stratigraphic composition, and drilling/coring methods. Conditions at other times may differ from those described on the logs. For graphical presentation of observation/measurement well construction, see Table 6. Elevations of changes in construction are noted at the bottom of each section.

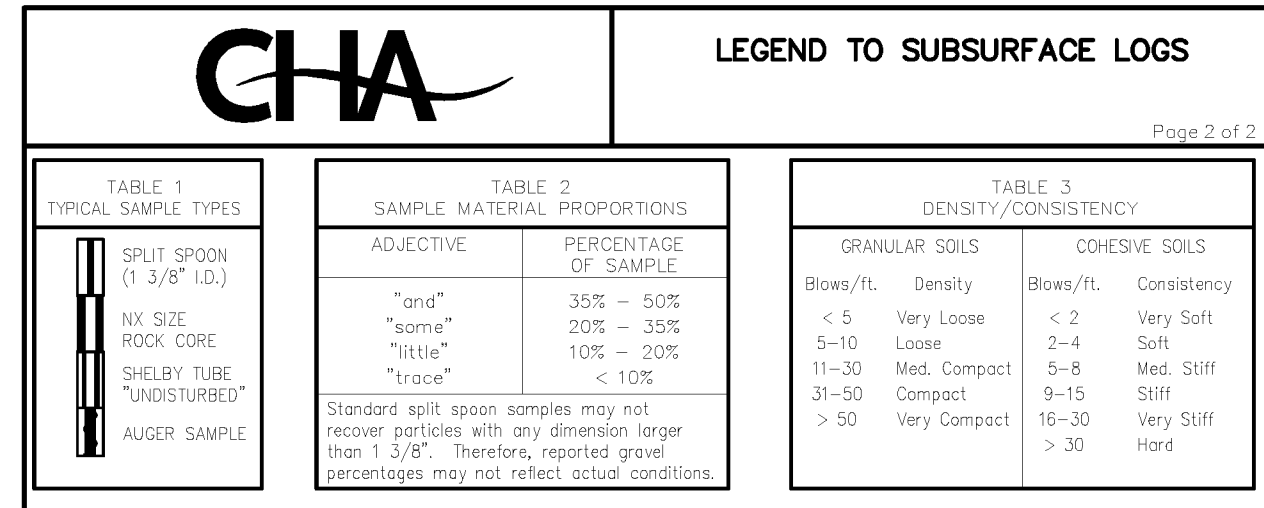


TABLE 1 TYPICAL SAMPLE TYPES

SOIL NUMBER	SOIL TYPE	RECOVERY (%)	DEPTH (Feet)	GRAPHICS
S1	TOPSOIL	100	0-2	[Symbol]
R1	GRAVEL	100	2-3	[Symbol]
R1	SAND	100	3-4	[Symbol]
R1	SILT & CLAY	100	4-5	[Symbol]

TABLE 2 SAMPLE MATERIAL PROPORTIONS

ADJECTIVE	PERCENTAGE OF SAMPLE
"sand"	35% - 50%
"silty"	20% - 35%
"clayey"	10% - 20%
"trace"	< 10%

TABLE 3 DENSITY/CONSISTENCY

GRAVEL/FL. DENSITY	COHESIVE SOILS
Blows/ft. Density	Blows/ft. Consistency
< 5 Very Loose	< 2 Very Soft
5-10 Loose	2-4 Soft
11-30 Med. Compact	5-8 Med. Stiff
31-50 Compact	9-15 Stiff
> 50 Very Compact	> 30 Very Stiff

TABLE 4 USCS CLASSIFICATION, PARTICLE SIZE, & GRAPHICS






MAJOR PARTICLE SIZE DIVISION	USCS SYMBOL	GENERAL DESCRIPTION	HARDNESS
GRAVEL Coarse #10-#40 Fine #40-#200	GW	Well graded gravels, gravel & sand mix.	Very Soft
GW	GP	Poorly graded gravels, gravel & sand mix.	Soft
GM	GM	Gravel, sand and silt mix.	Med. Hard
GC	GC	Gravel, sand and clay mix.	Hard
SAND Coarse #40-#200 Fine #200-#425	SW	Well graded sand, sand & gravel mix.	Very Hard
SP	SP	Poorly graded sand, sand & gravel mix.	
SM	SM	Sand and silt mix.	
SC	SC	Sand and clay mix.	
MUDCLAY	ML	Inorganic silt, low plasticity.	
CLAY	CL	Inorganic clay, low plasticity.	
CL	OL	Organic silt/clay, low plasticity.	
MUDCLAY	MH	Inorganic silt, high plasticity.	
CLAY	CH	Inorganic clay, high plasticity.	
CL	OH	Organic silt/clay, high plasticity.	
PEAT	PT	Peat and other highly organic soils.	
FILL	FI	Miscellaneous fill materials.	

TABLE 5 ROCK CLASSIFICATION TERMS

GRAVEL/FL. DENSITY	COHESIVE SOILS
Blows/ft. Density	Blows/ft. Consistency
< 5 Very Loose	< 2 Very Soft
5-10 Loose	2-4 Soft
11-30 Med. Compact	5-8 Med. Stiff
31-50 Compact	9-15 Stiff
> 50 Very Compact	> 30 Very Stiff

TABLE 6 WELL CONSTRUCTION

WELL TYPE	CONSTRUCTION
SOLID PVC PIPE	BENTONITE GRAD
SCREENED PVC PIPE	AIR ENTRAINED CEMENT
STAINLESS STEEL SCREENED PIPE	NATURAL SOIL/ROCK FILL
FINE GRAINED WASHED SAND	BENTONITE/CEMENT GROUT
WASHED SAND	

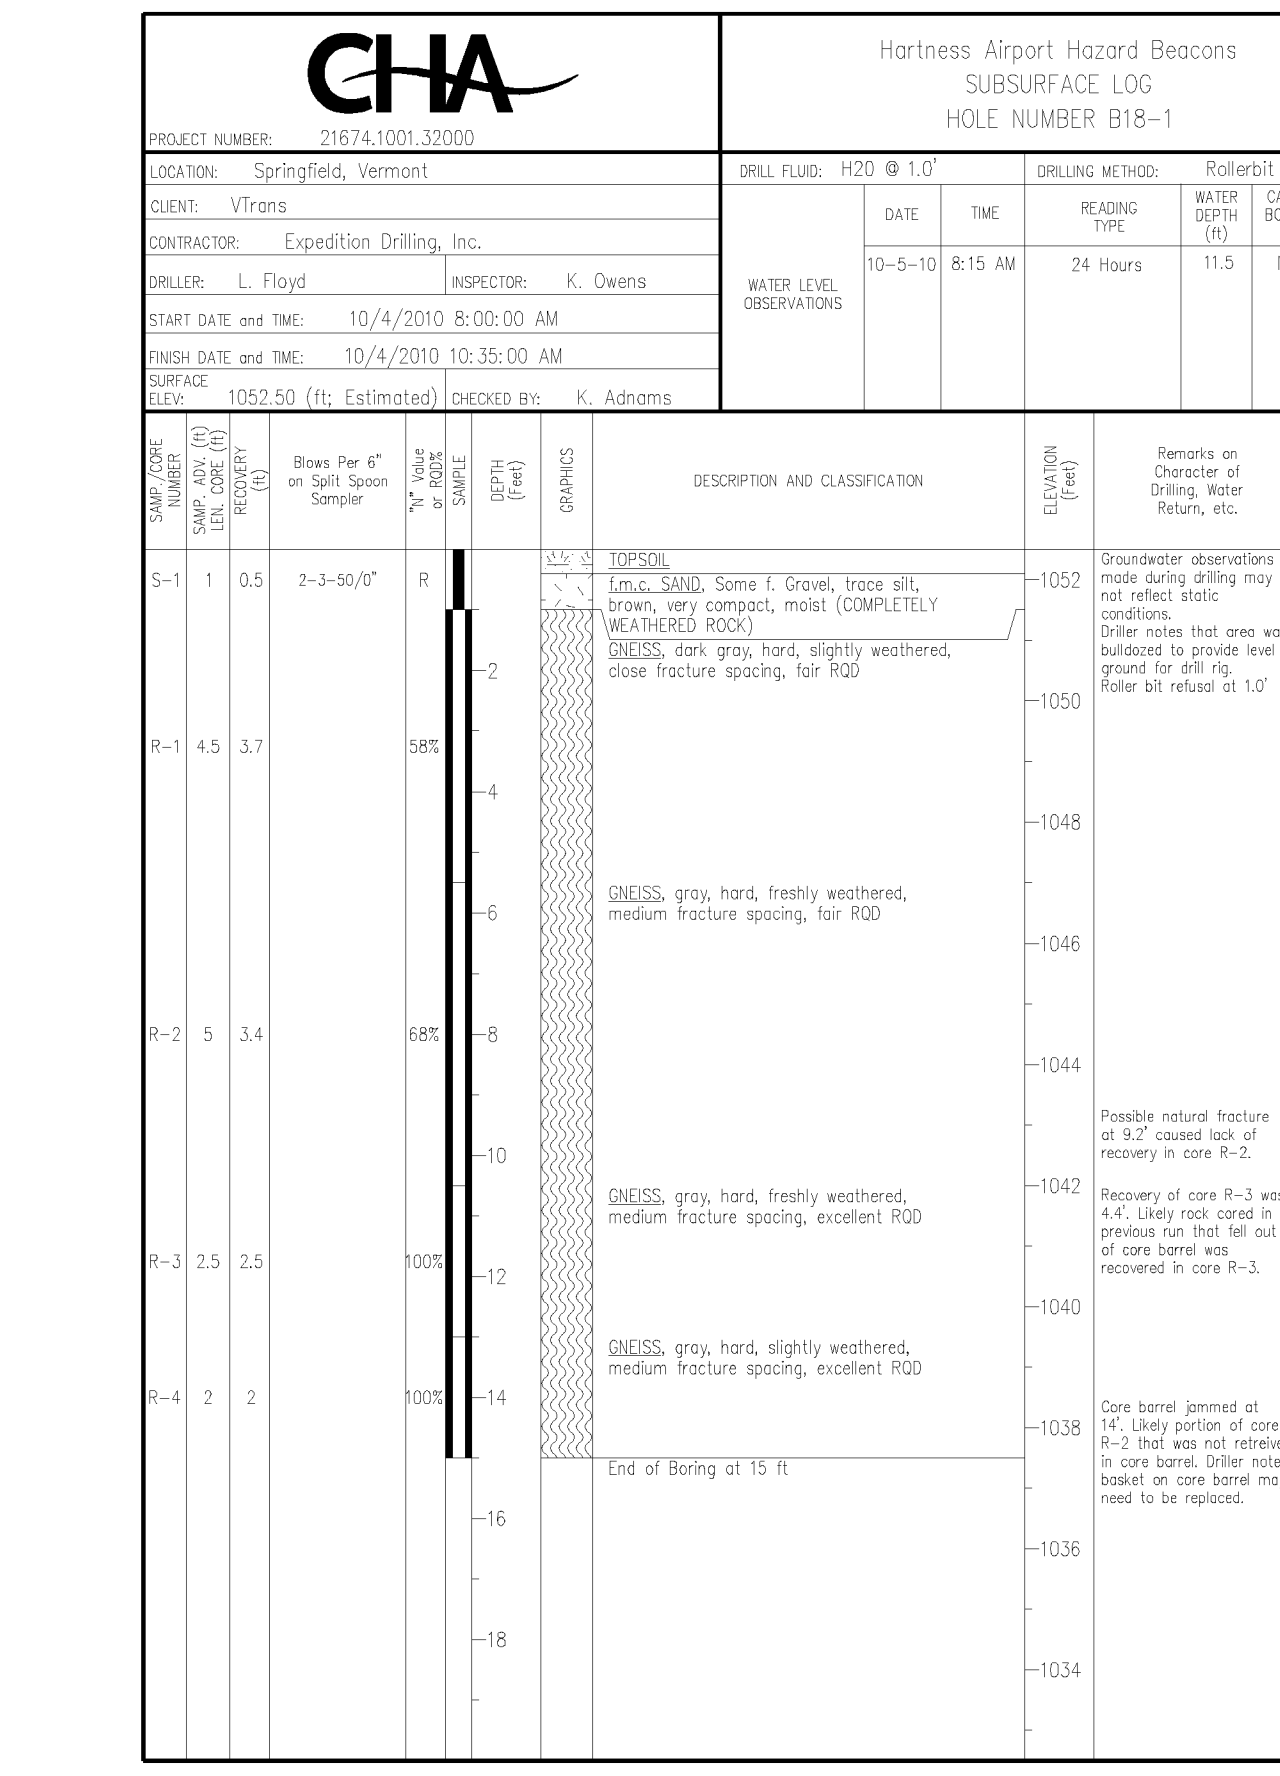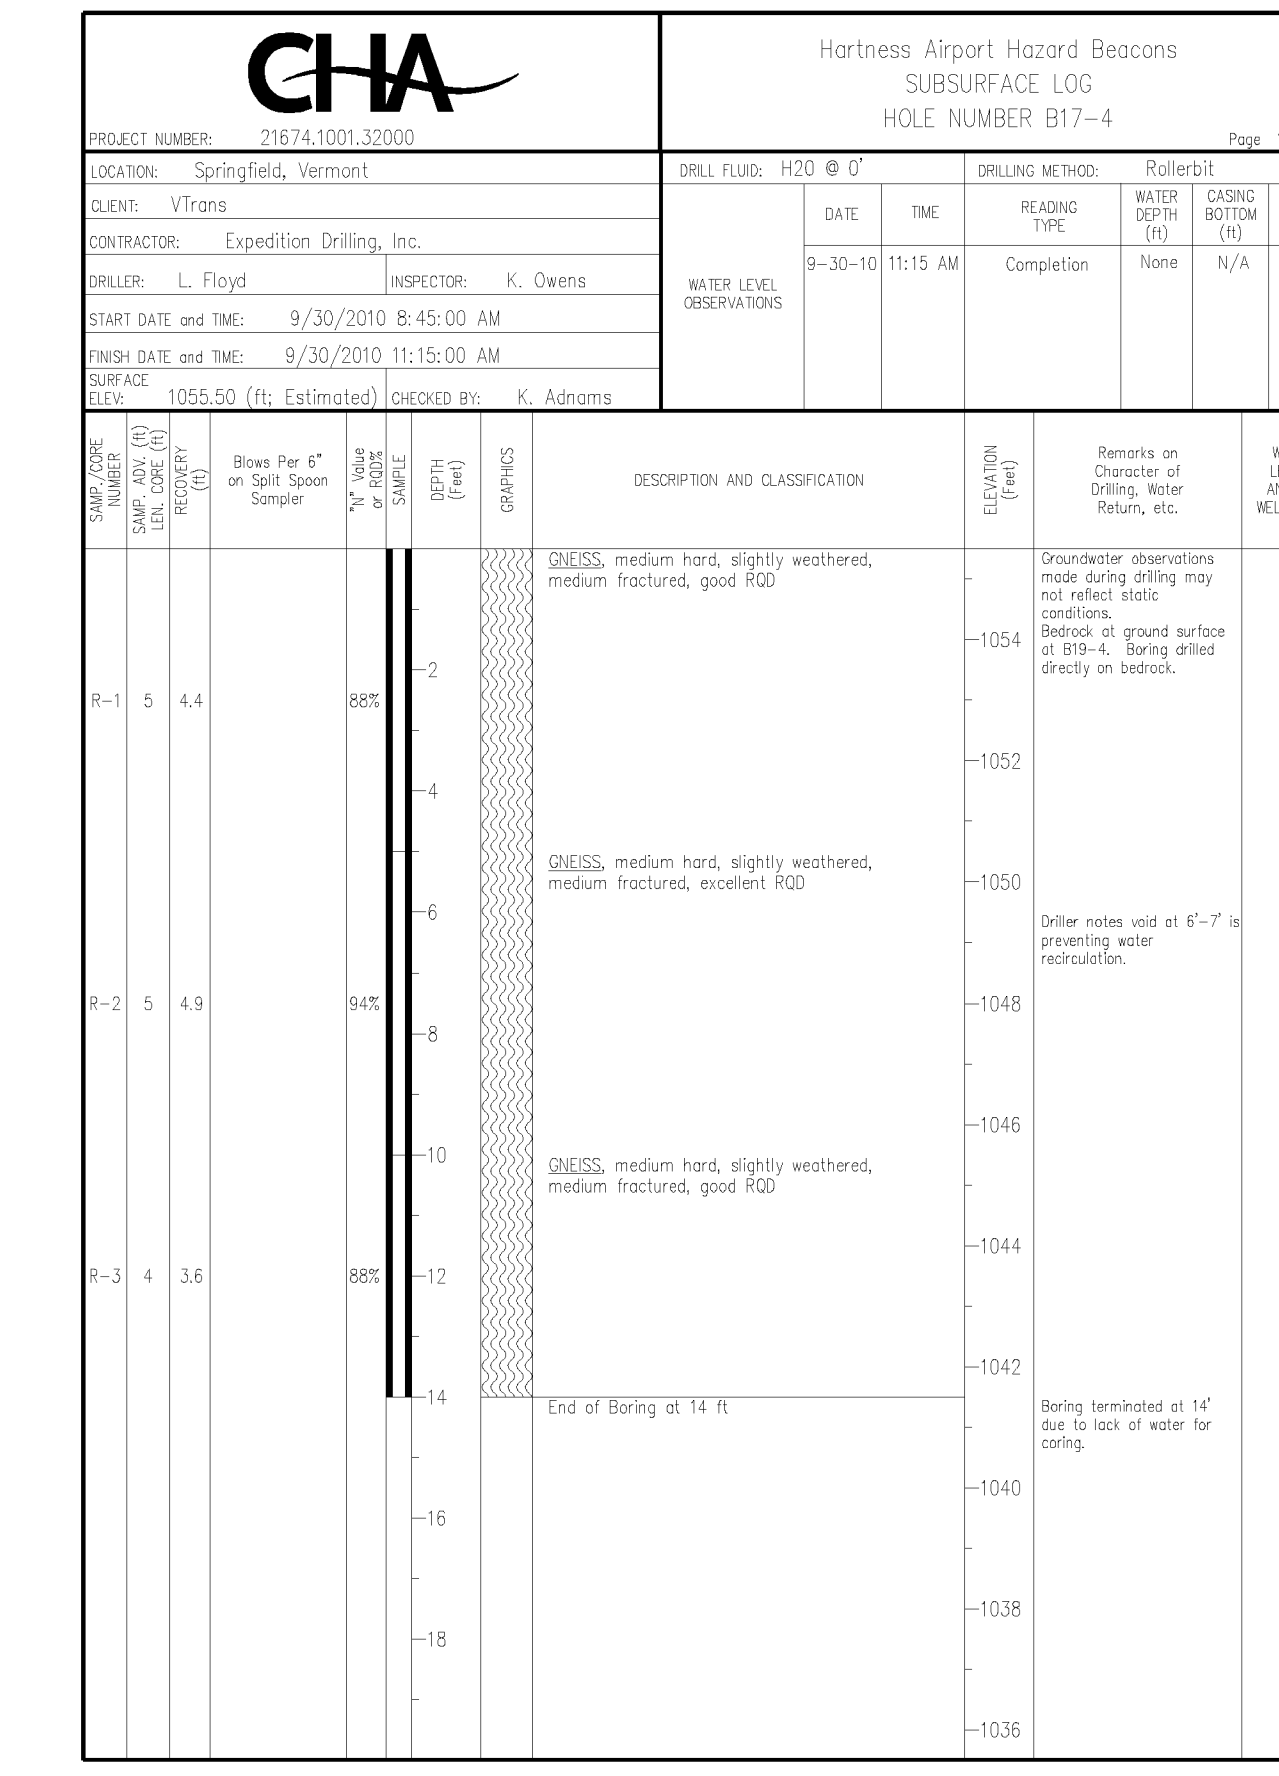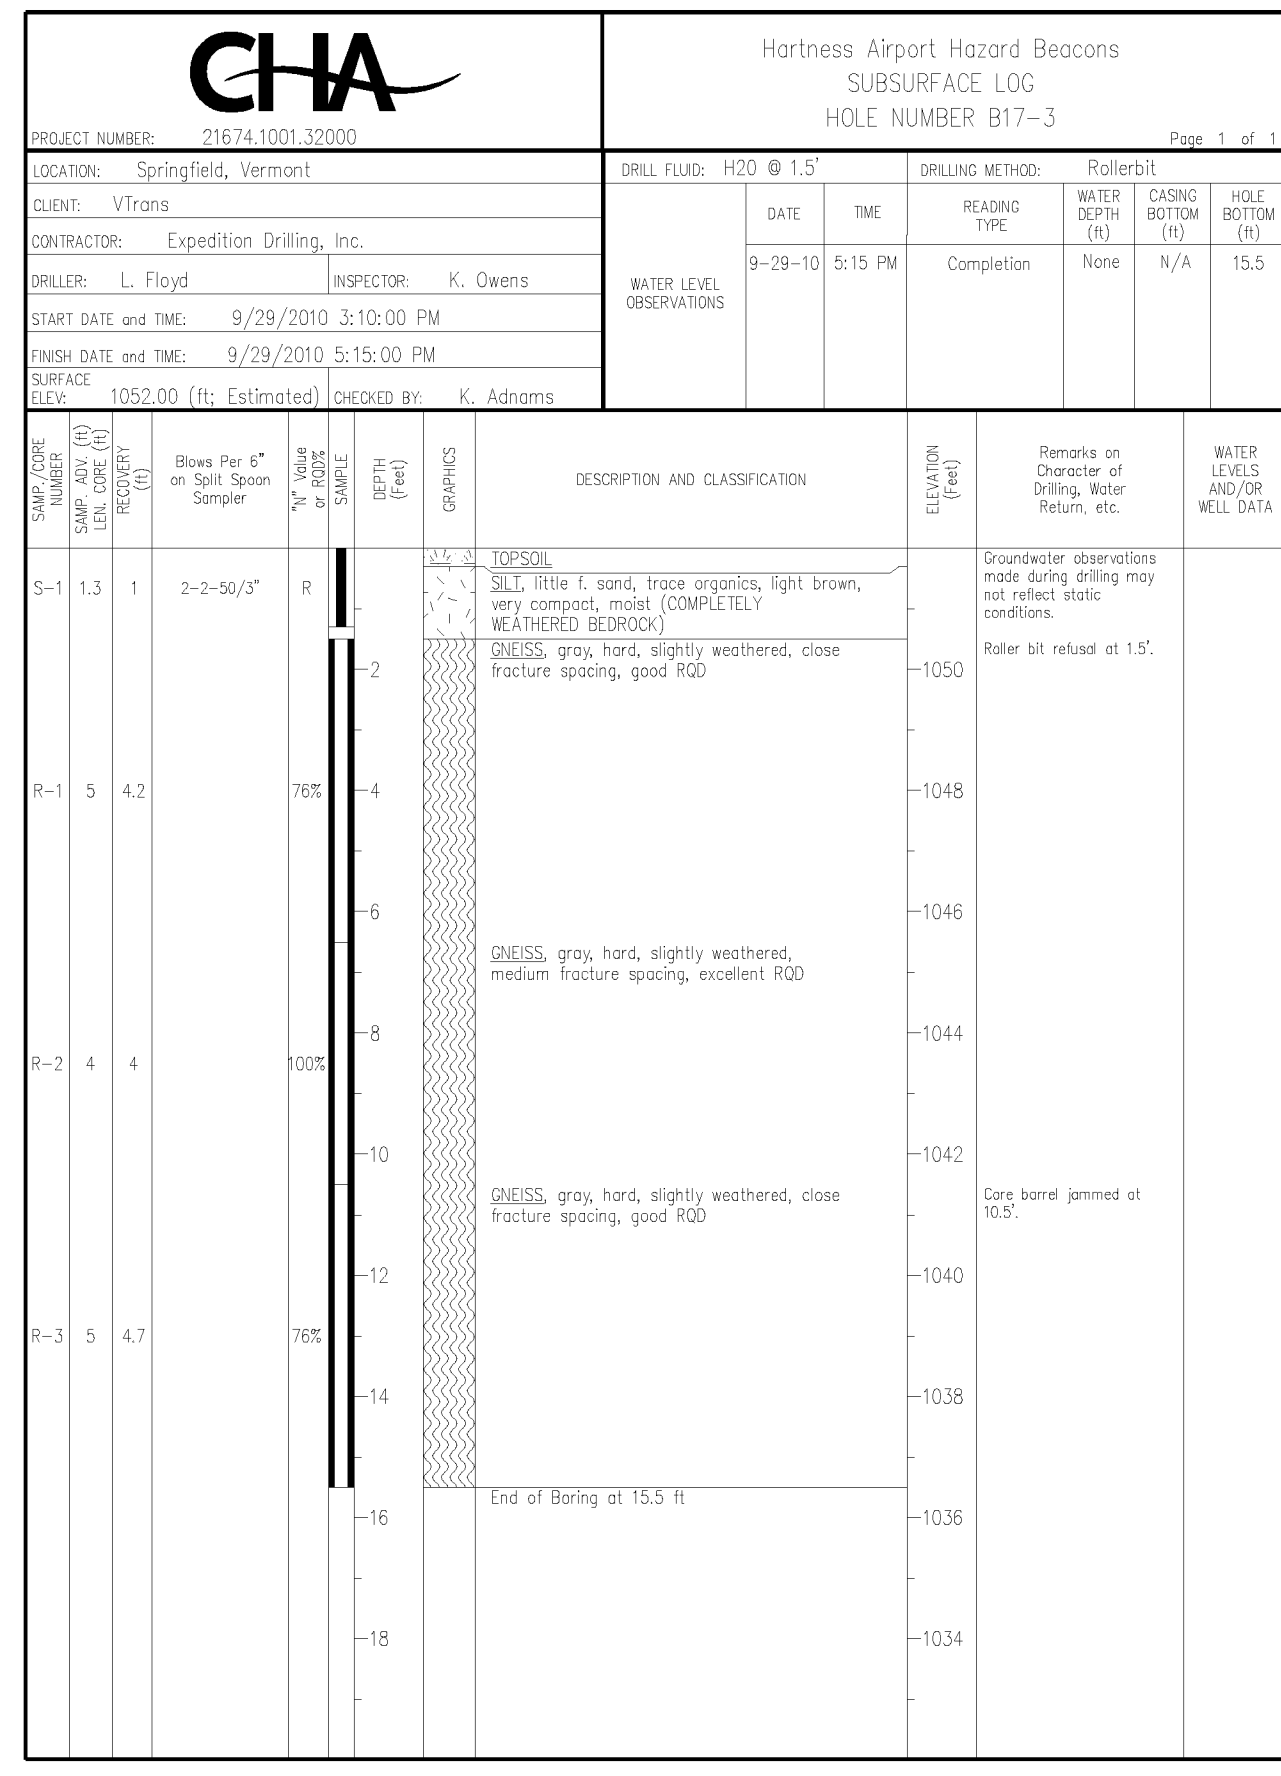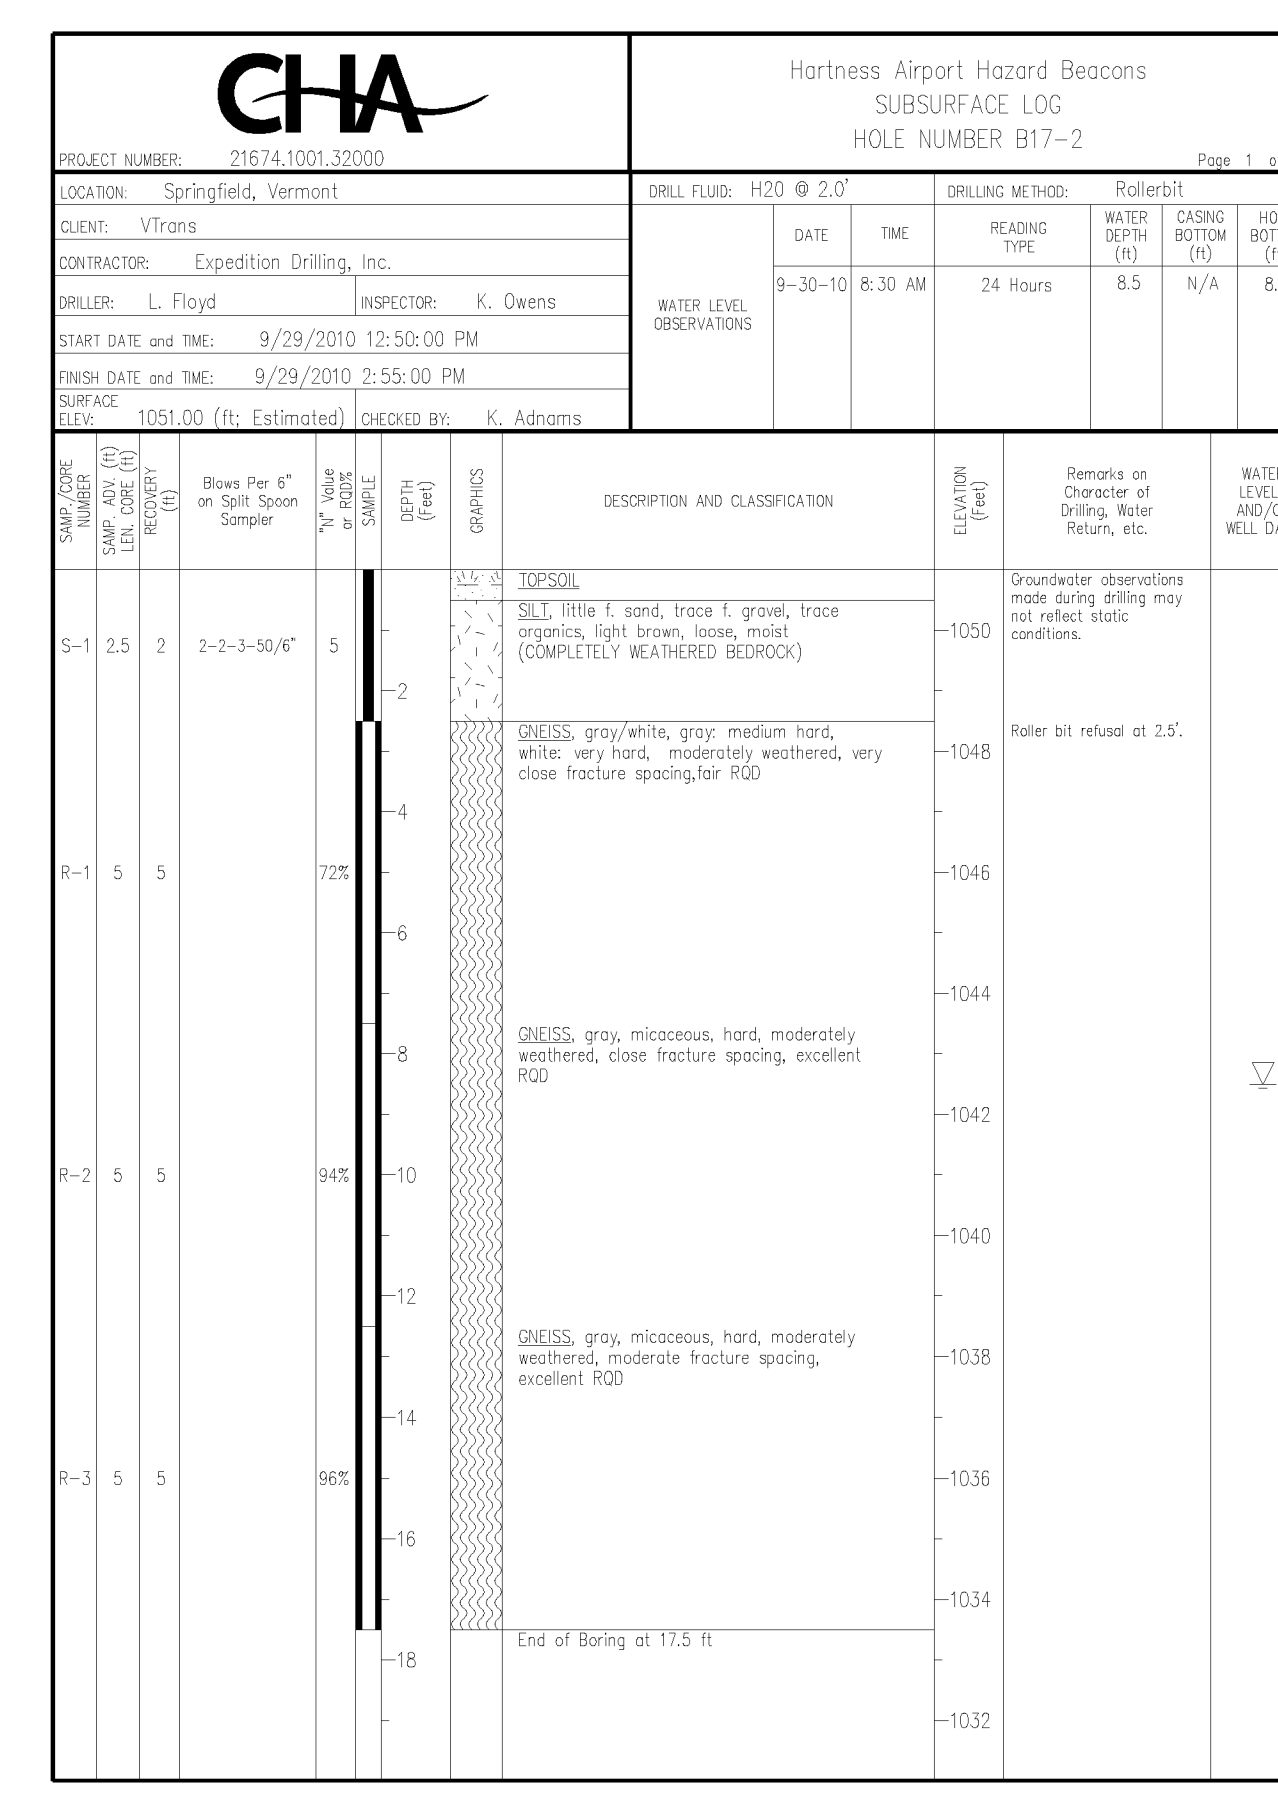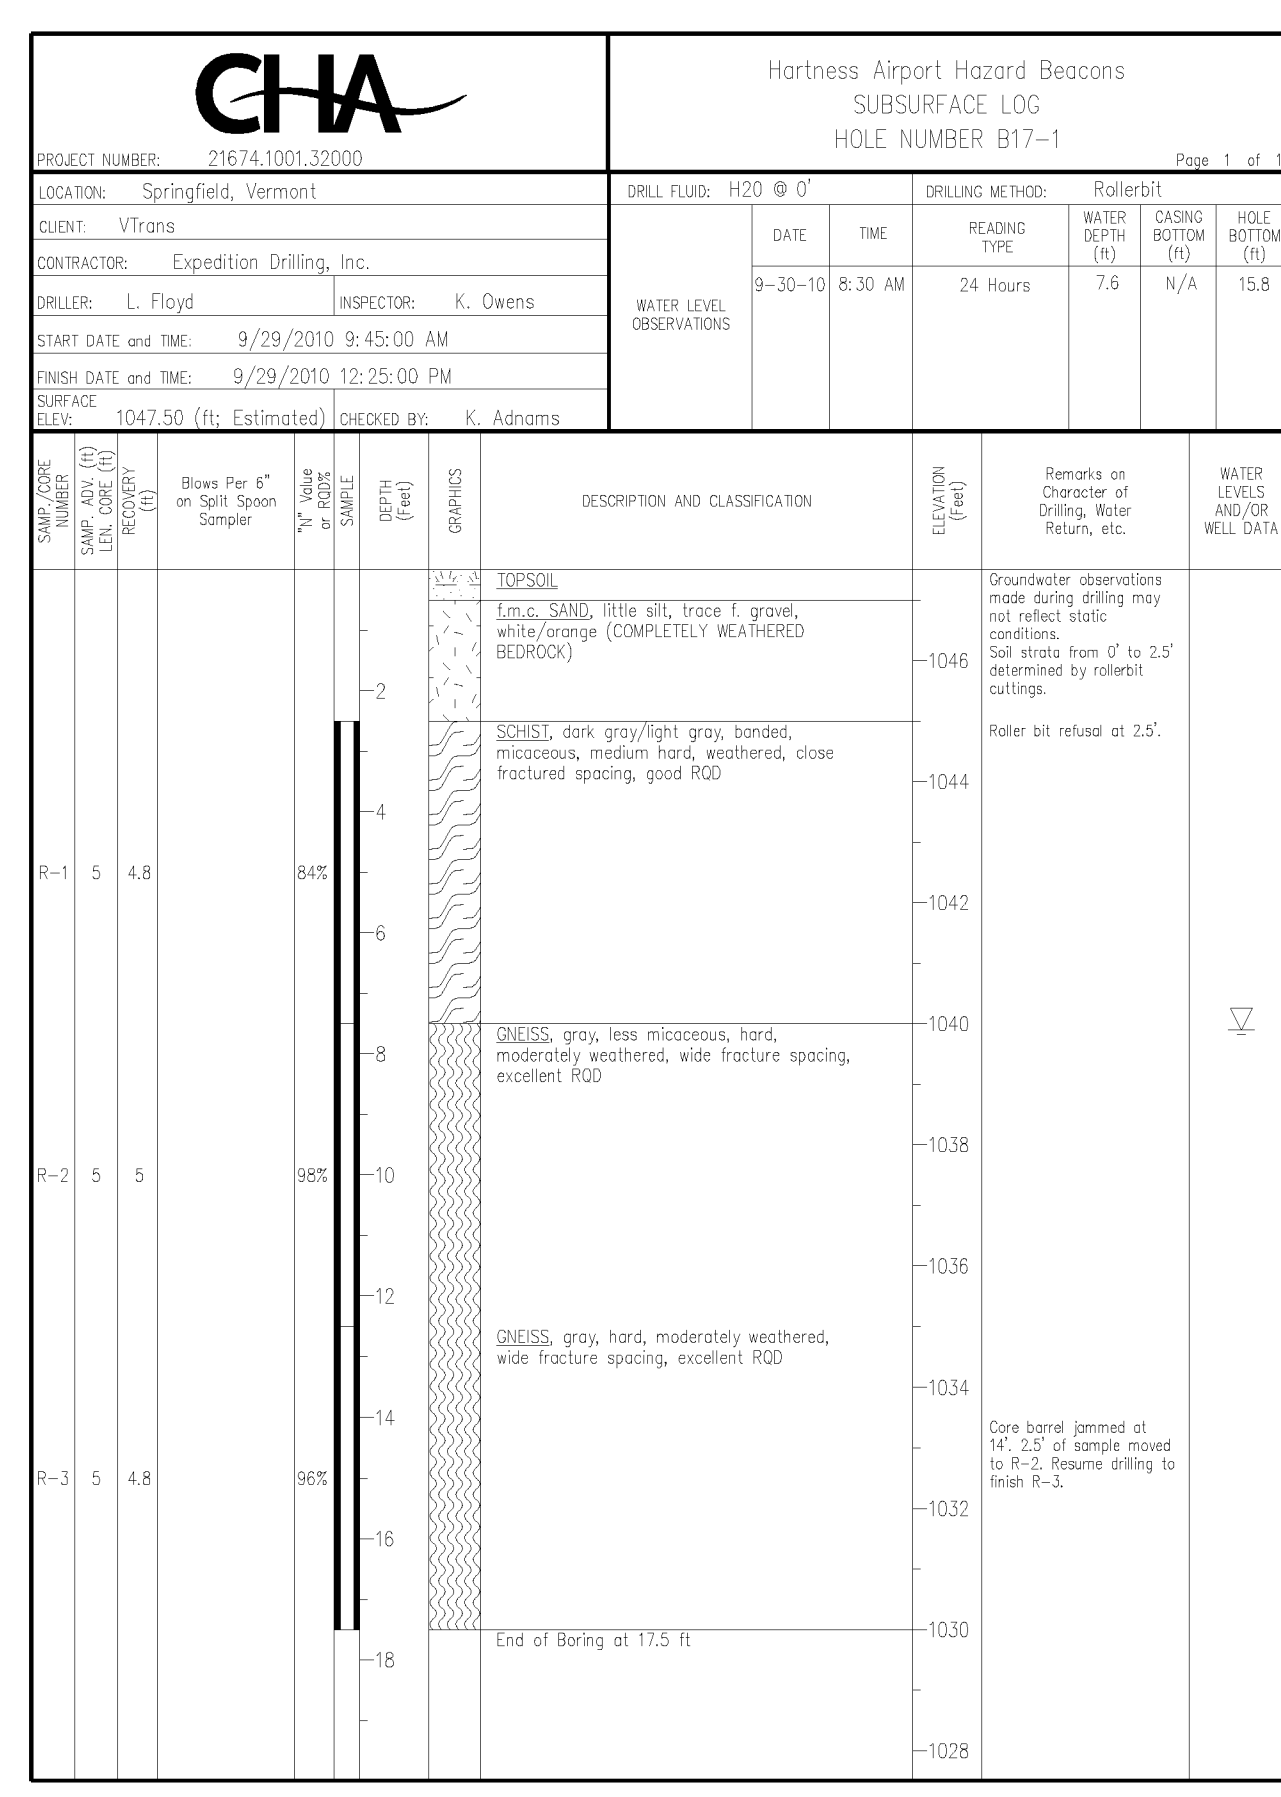

RECORD DRAWING 07/07/13

Submitter / Revision

Appr. By: HAW HAW 07/07/13

Date: 07/07/13

STATE OF VERMONT
AGENCY OF TRANSPORTATION

DESIGNED: HAW HAW
DRAWN: HAW HAW
CHECKED: TYL

UNAUTHORIZED ALTERATION OR ADDITION OF INFORMATION IS PROHIBITED AND/OR APPLICABLE STATE AND/OR LOCAL LAWS

CHA
111 Winners Circle, PO Box 5089 - Albany, NY 12205-0289
Main: (518) 453-4500 • www.chaconline.com








HARTNESS STATE AIRPORT
HAZARD BEACON REPLACEMENT

SUBSURFACE LOGS

Issue Date: 03/18/11 Project No.: 21674 Scale: As Shown

C-003


File: V:\PROJECTS\ANYA\21674\CADD\CADD_SHEET_FILES\C003-4-21674.DWG
Saved: 1/4/2013 4:15:31 PM Printed: 1/4/2013 4:26:54 PM User: WyoJ, Heather Last Saved By: 2789

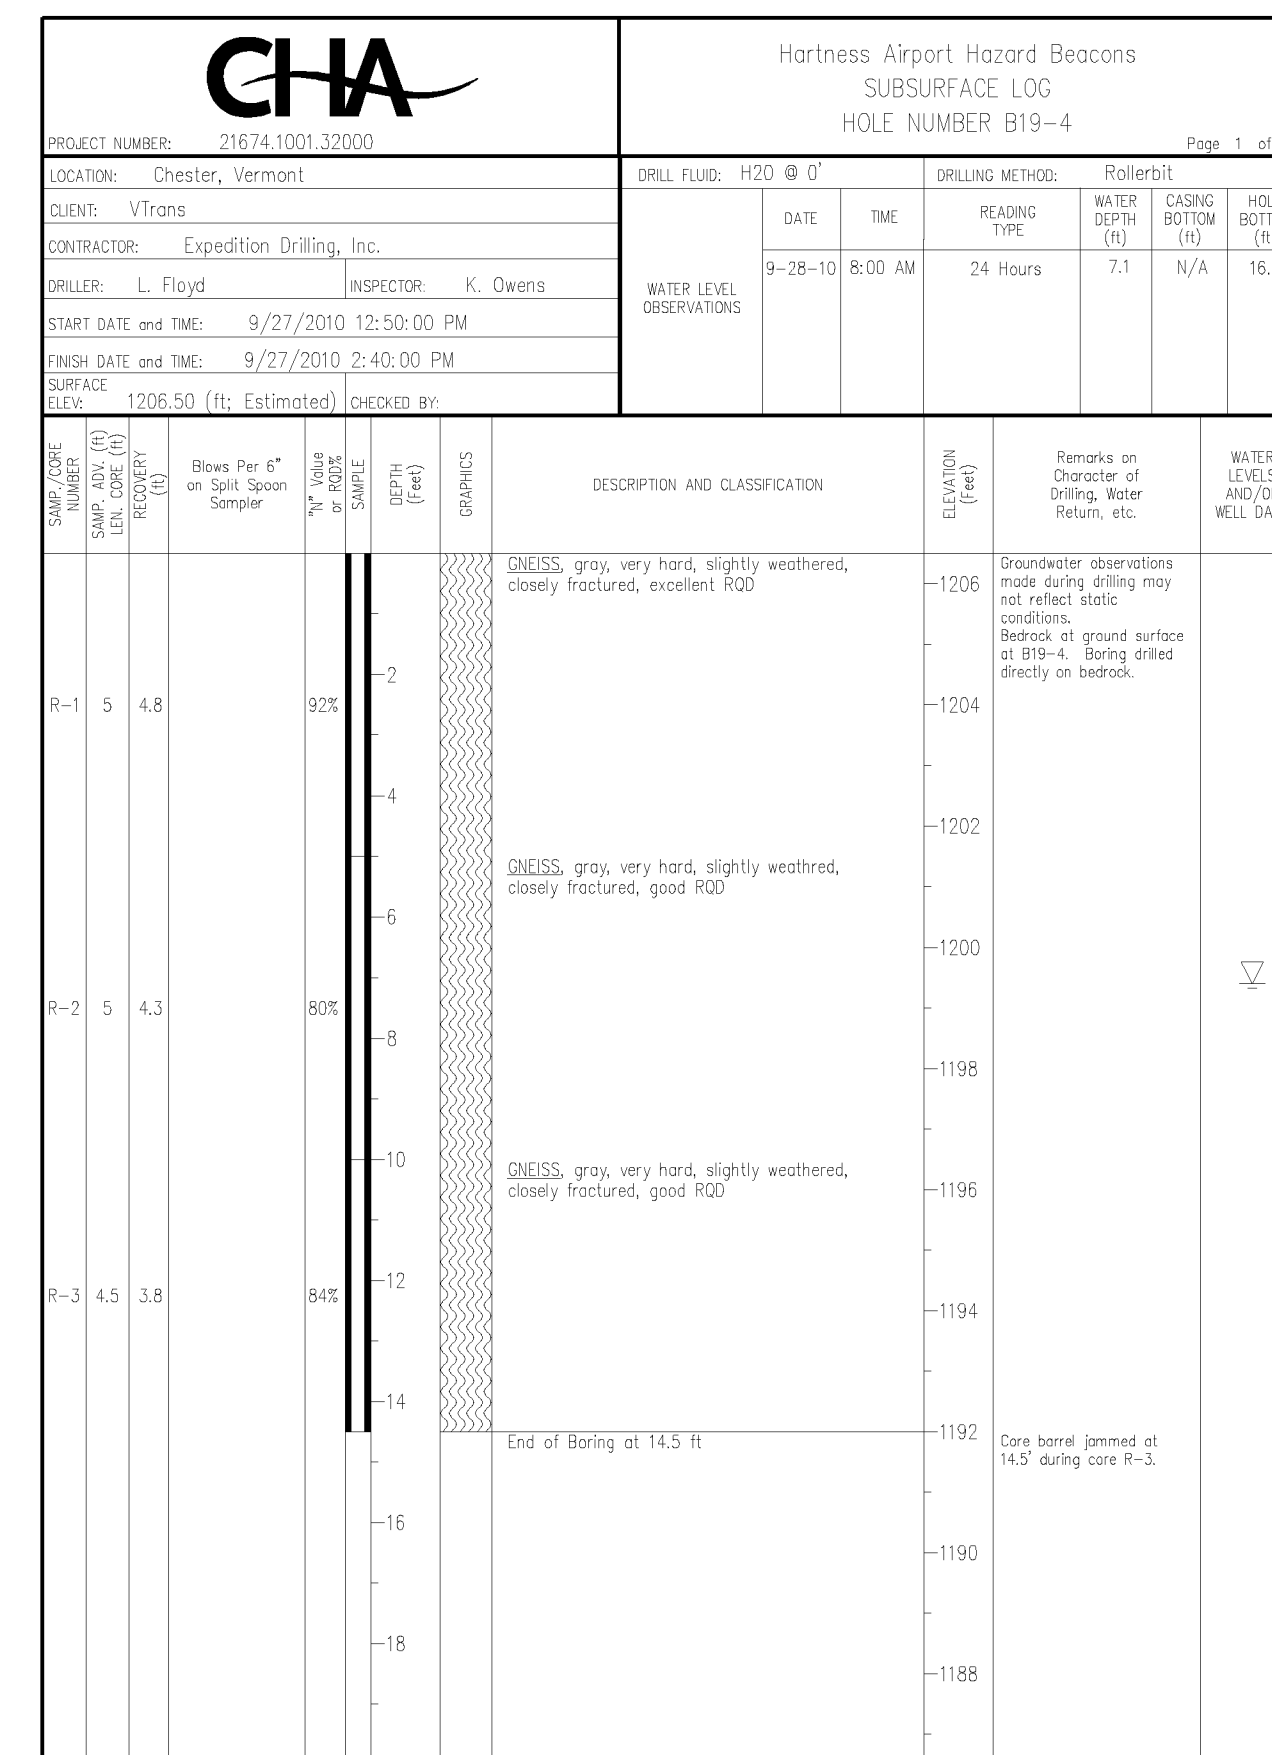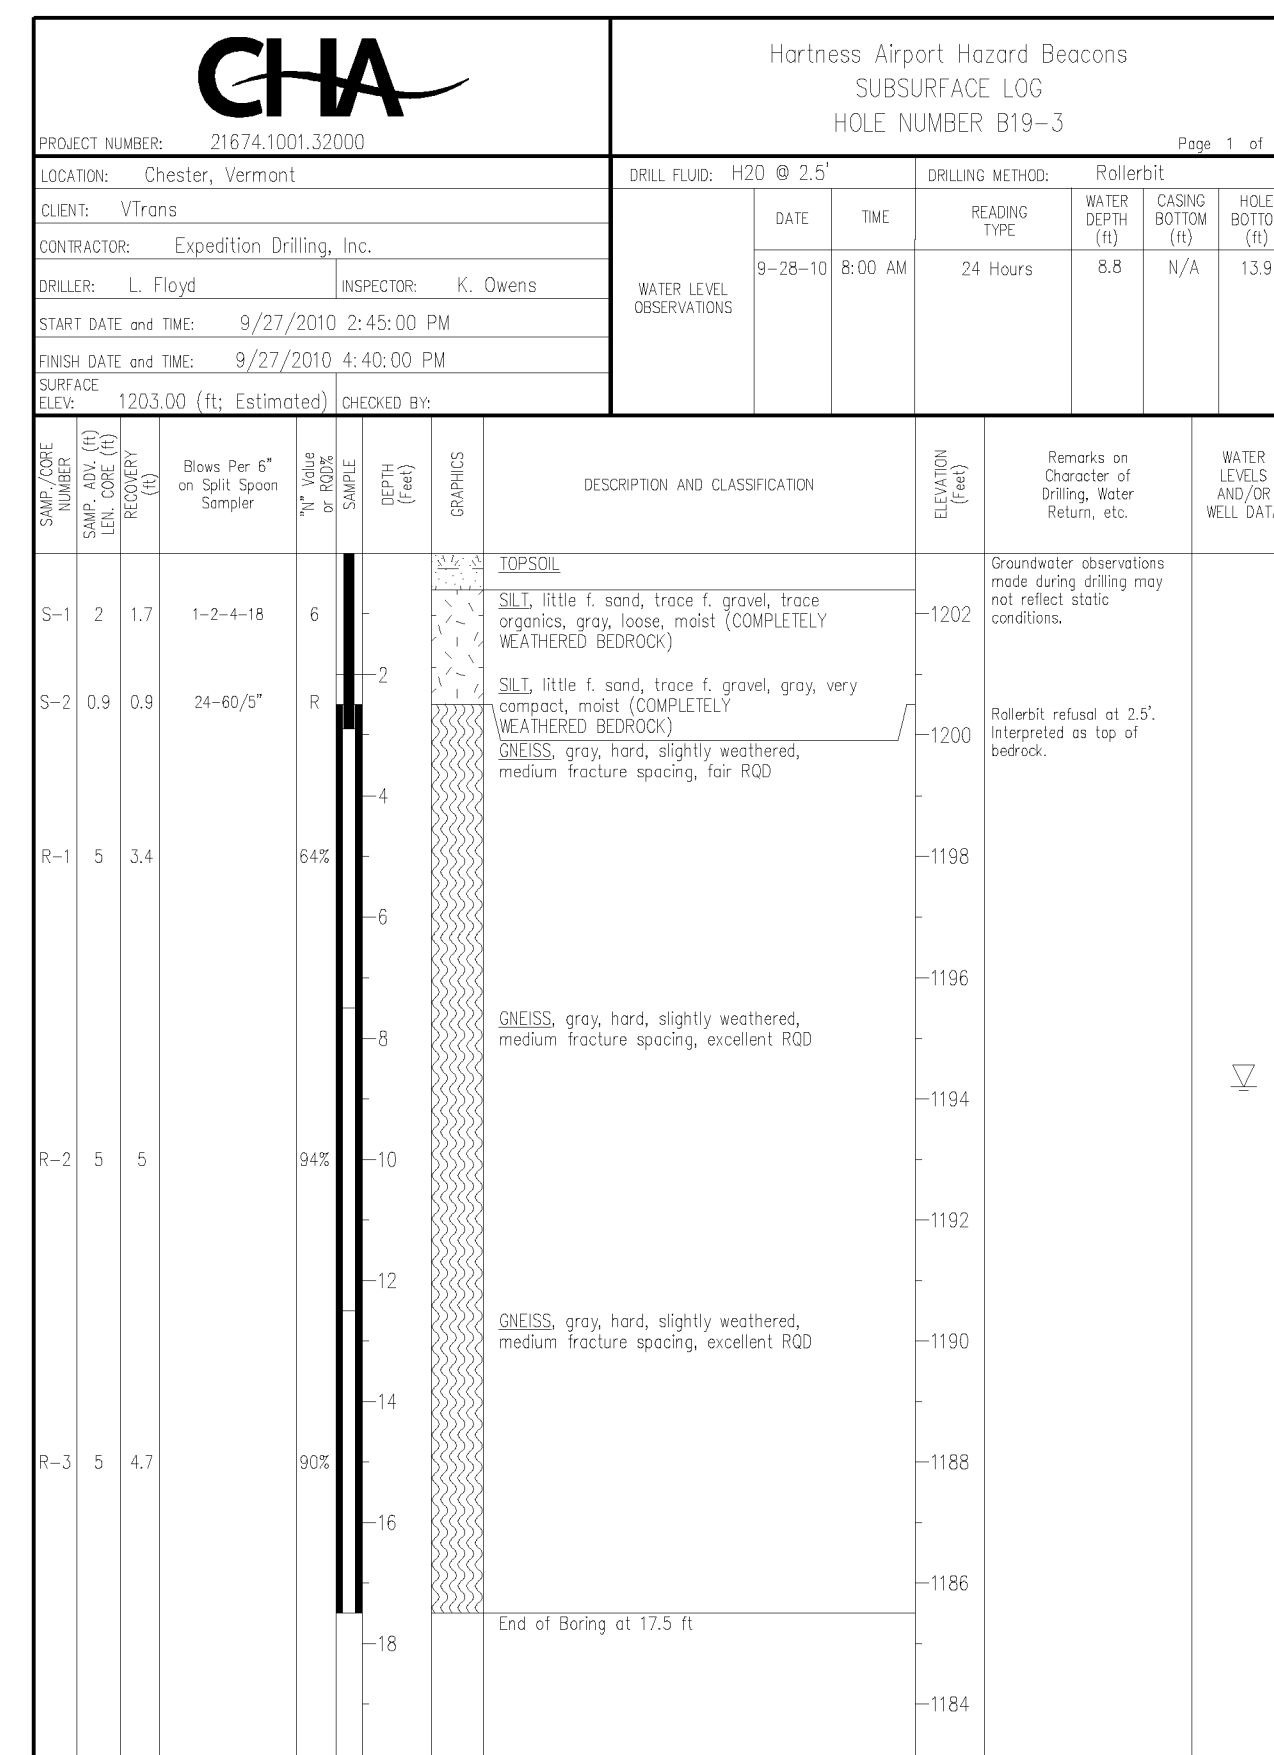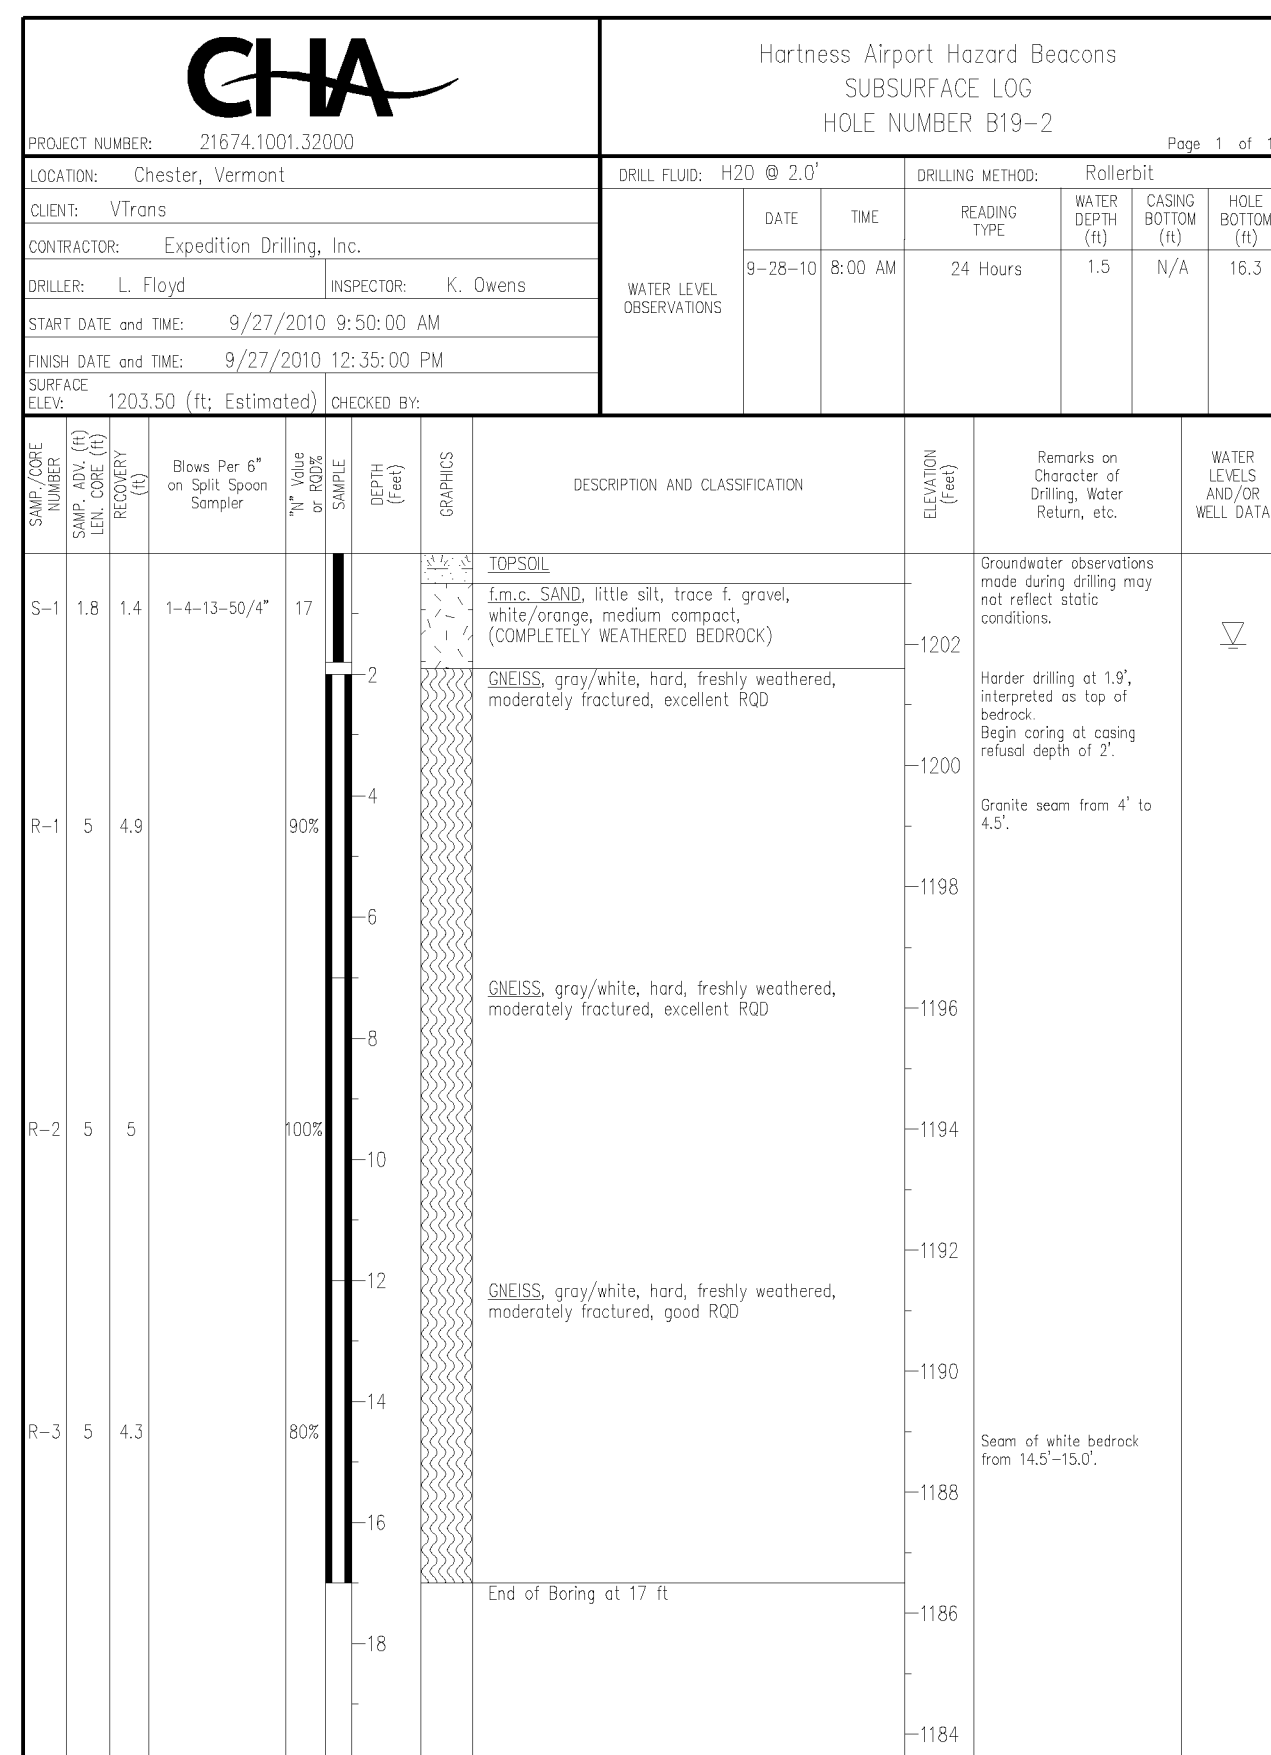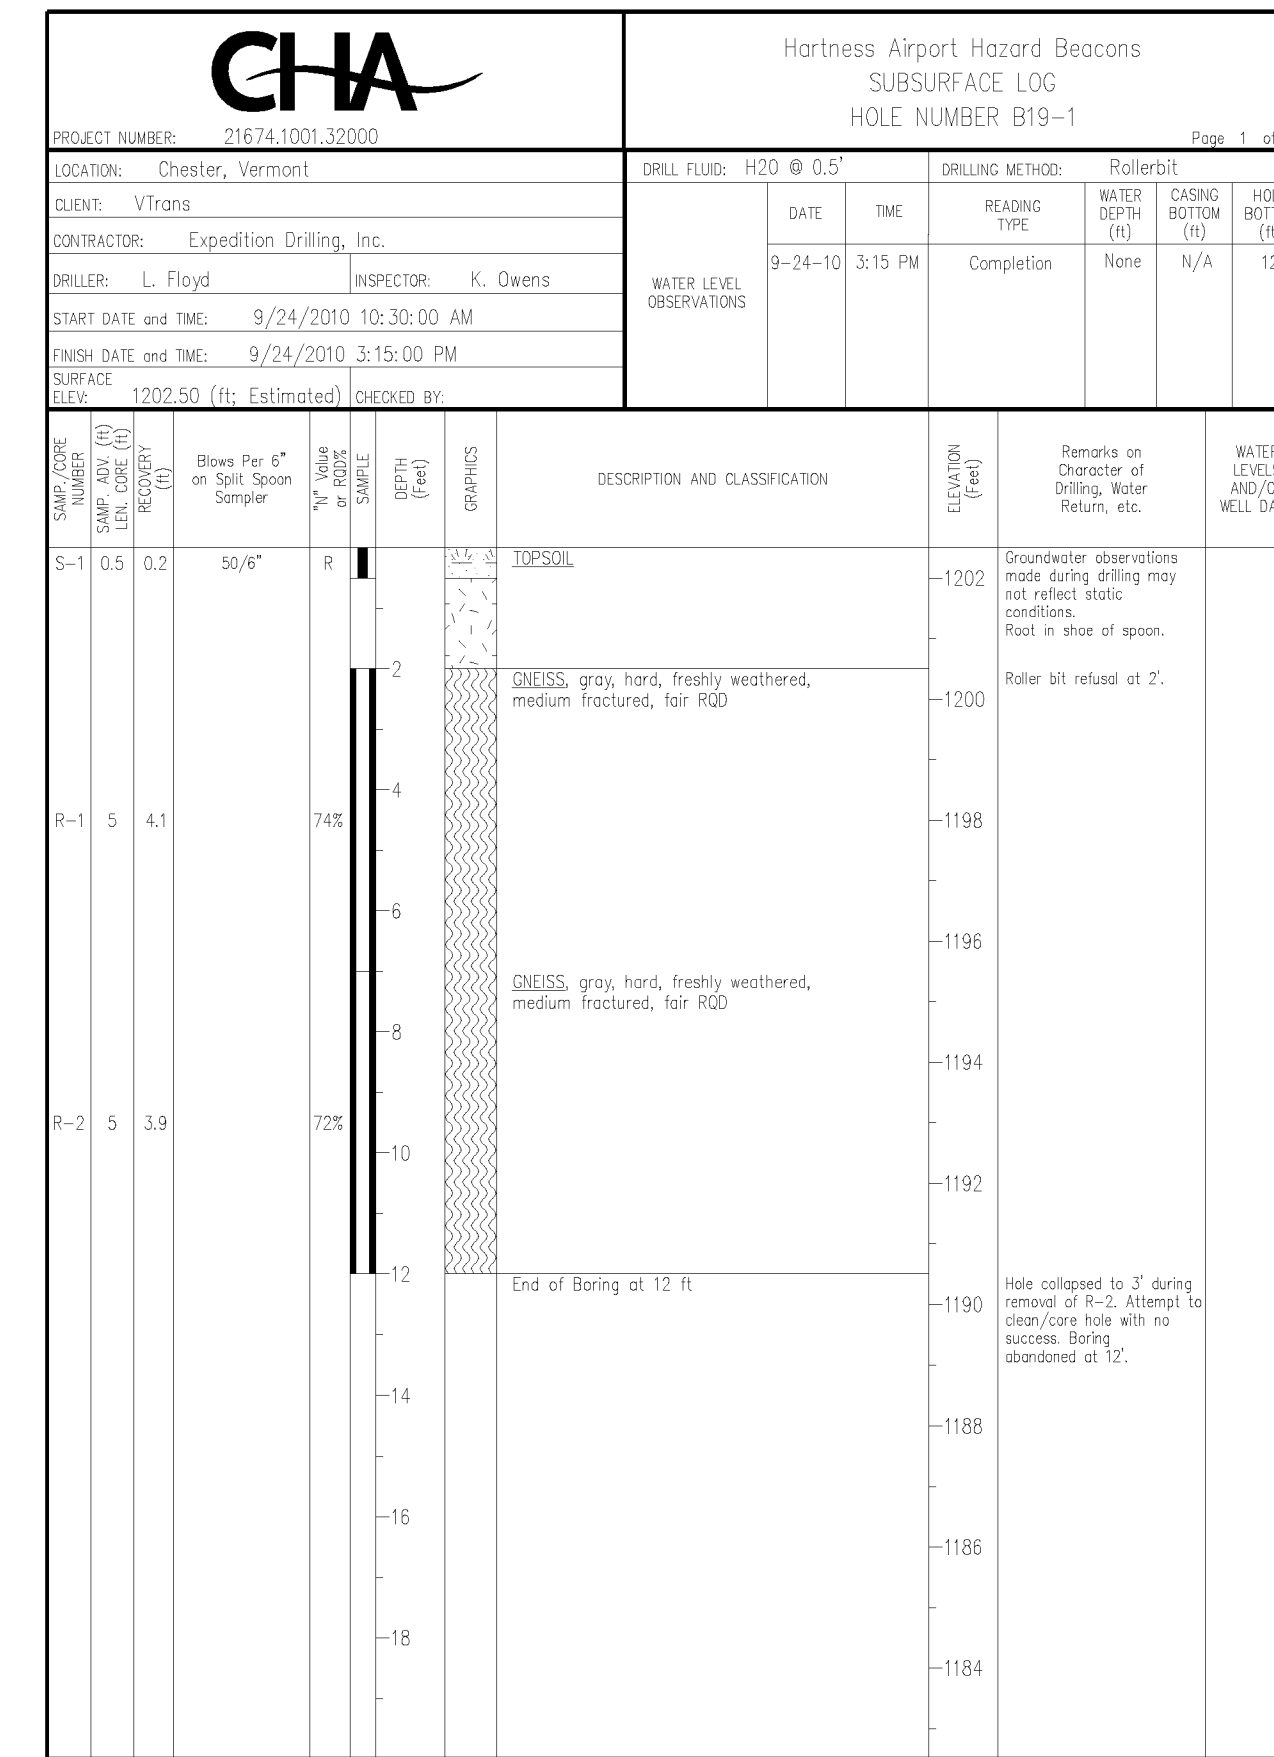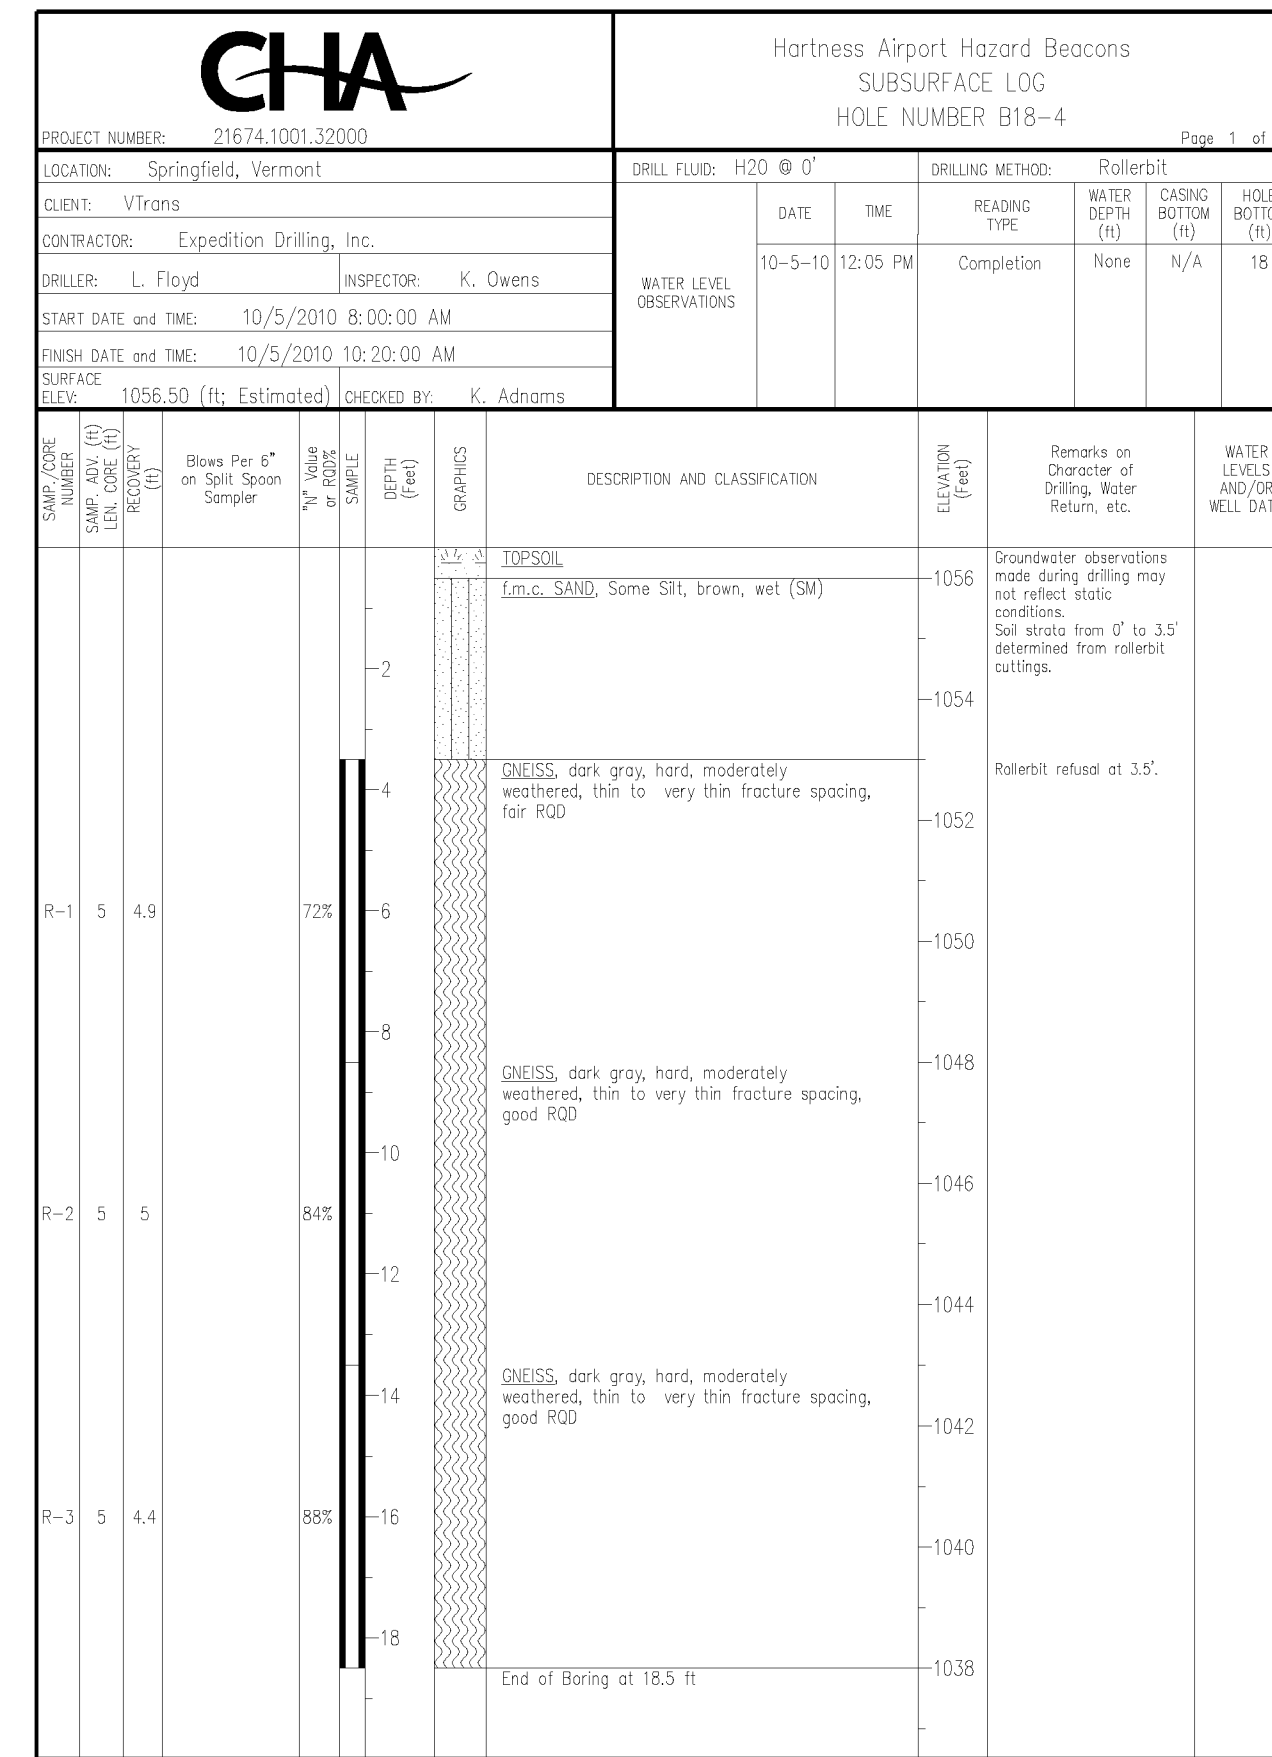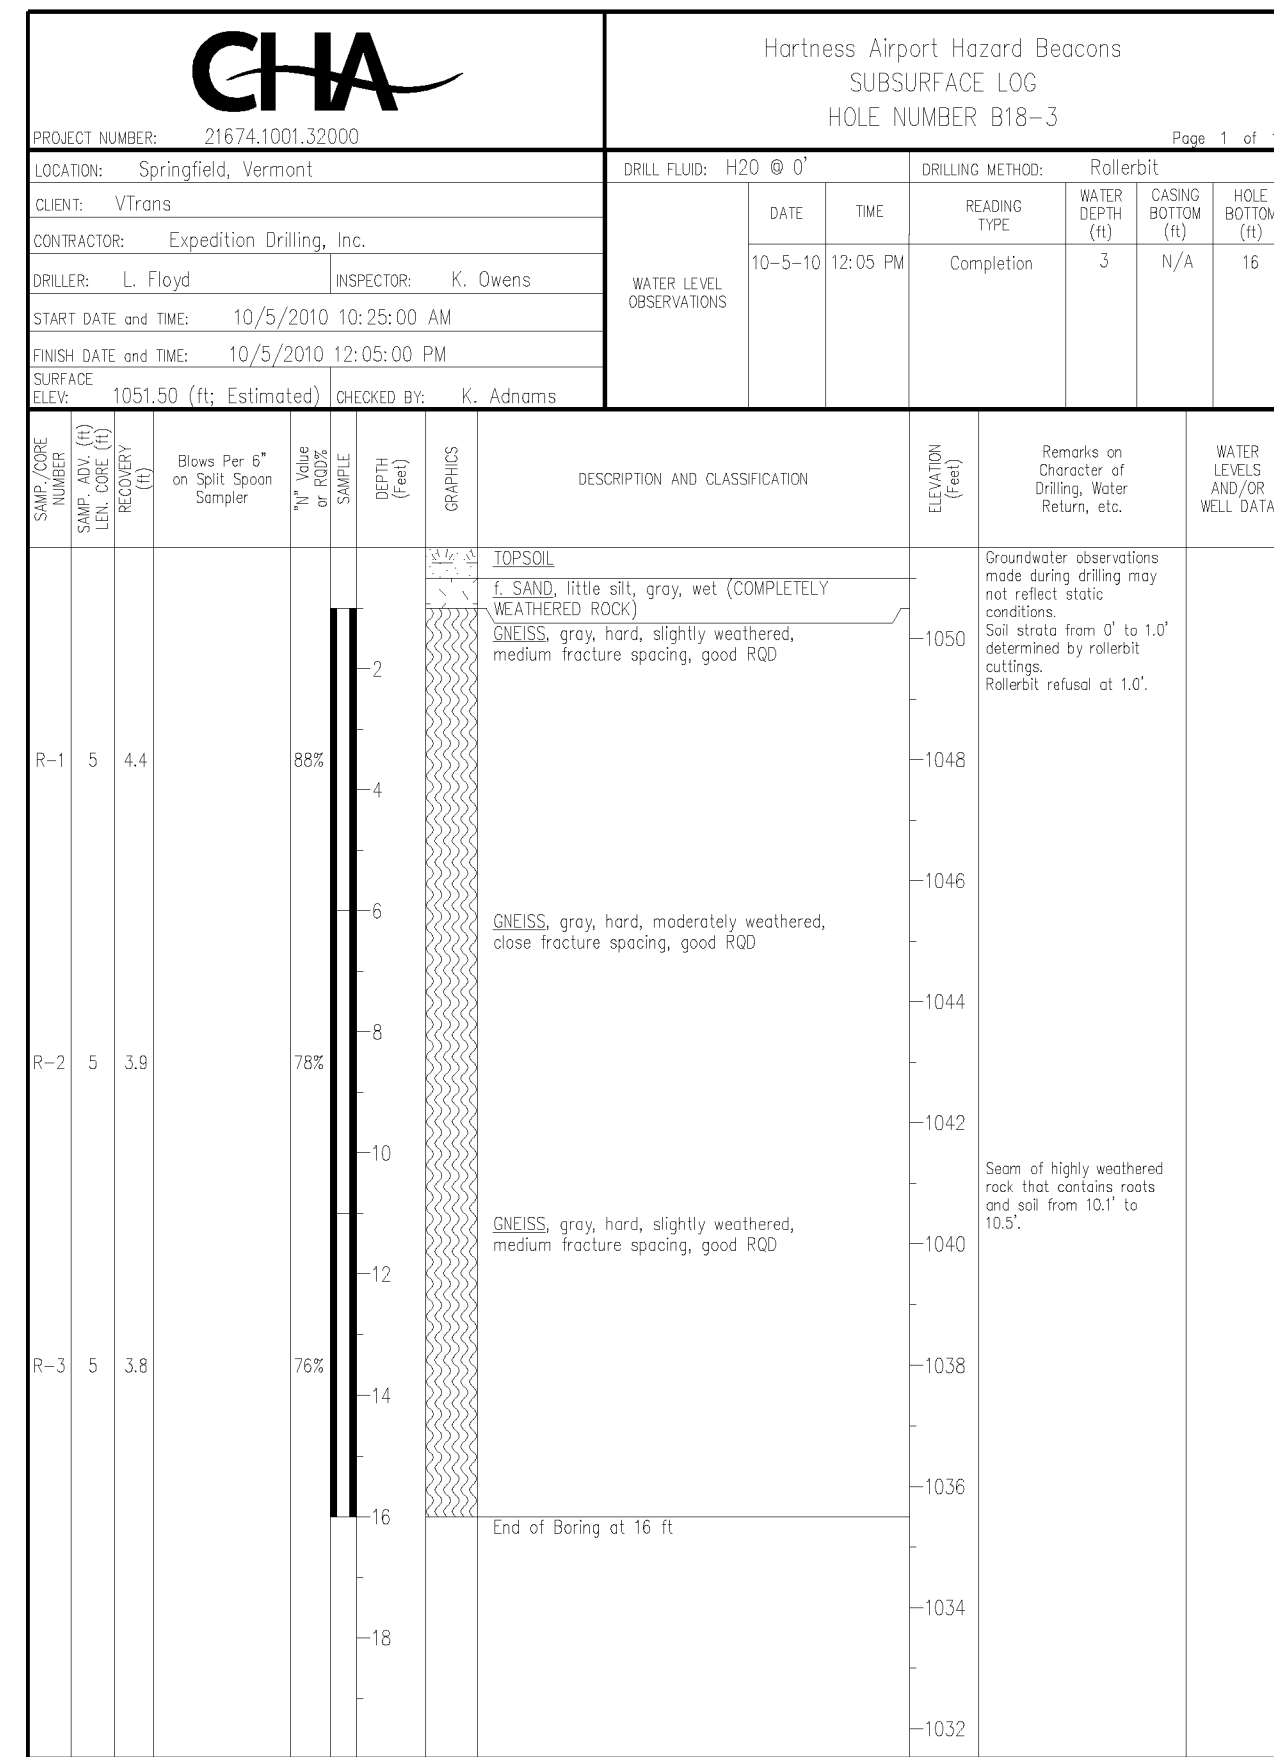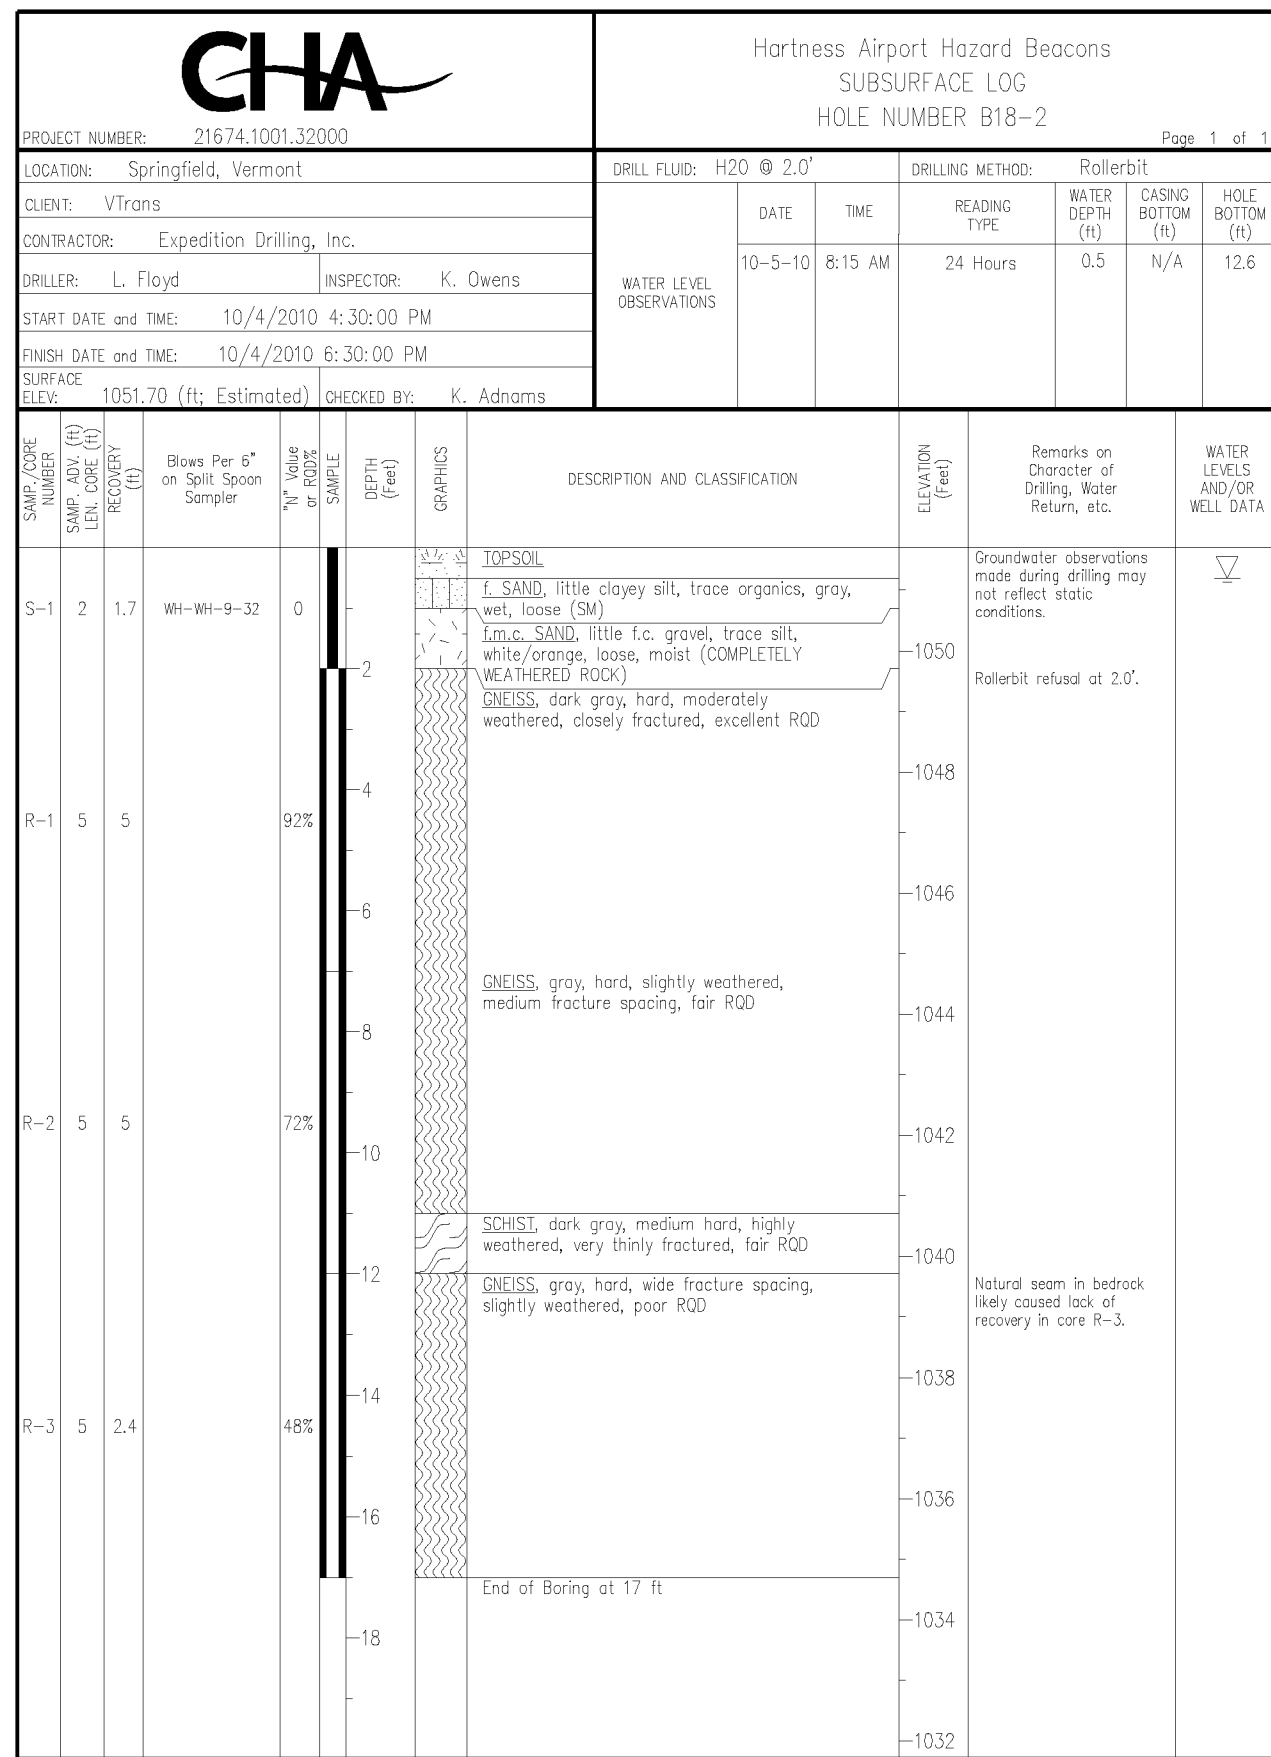

File: V:\PROJECTS\ANY\21674\CADD\CADD\PROJECT_FILES\C003-4-21674.DWG
 Sheet: 1/4/2013 4:15:31 PM Printed: 1/4/2013 4:27:08 PM User: Wyo, Heather Last Saved By: 2789

Submitter / Revision	Date
HAW	07/07/13
RECORD DRAWINGS	


STATE OF VERMONT
 AGENCY OF TRANSPORTATION

DESIGNED: HAW | DRAWN: HAW | CHECKED: TYL

 III Winners Circle, PO Box 5089 - Albany, NY 12205-0289
 Main: (518) 483-4500 • www.chacompanies.com


HARTNESS STATE AIRPORT
 HAZARD BEACON REPLACEMENT
 SUBSURFACE LOGS
 Issue Date: 03/18/11 | Project No.: 21674 | Scale: As Shown

RECORD DRAWING 07/07/13

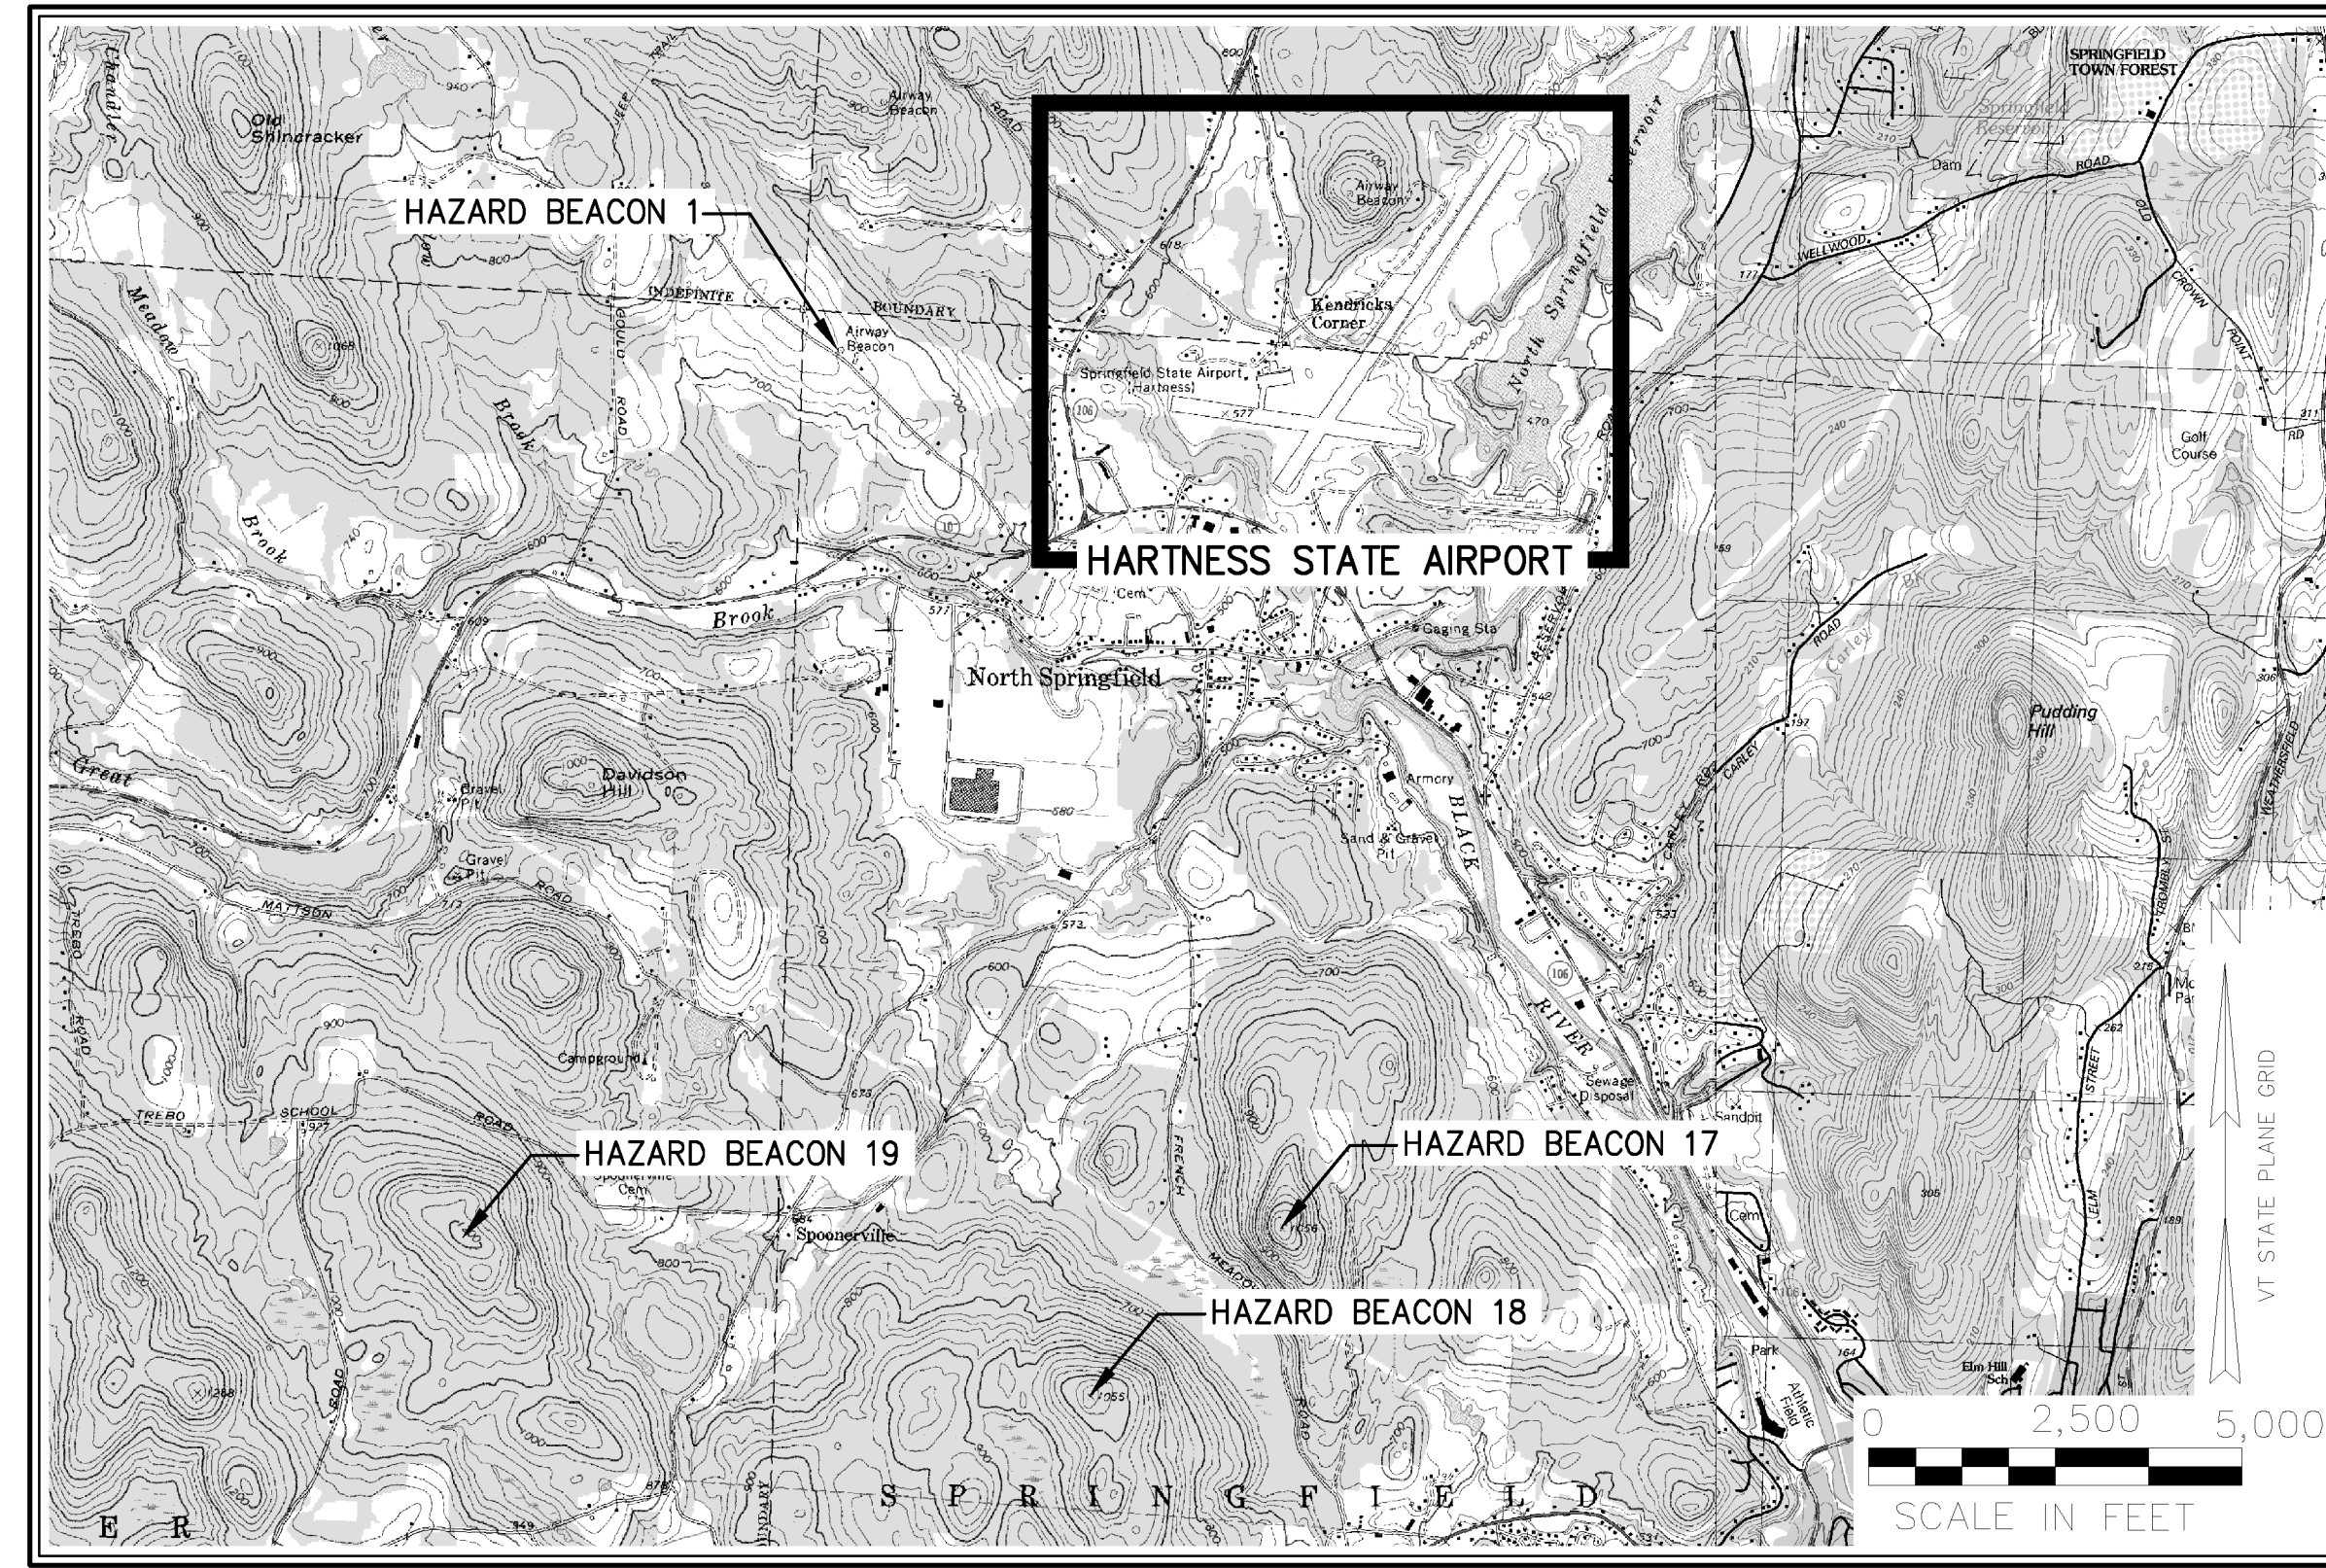
C-004




SUBSURFACE LOG LOCATION MAP
SCALE: AS NOTED

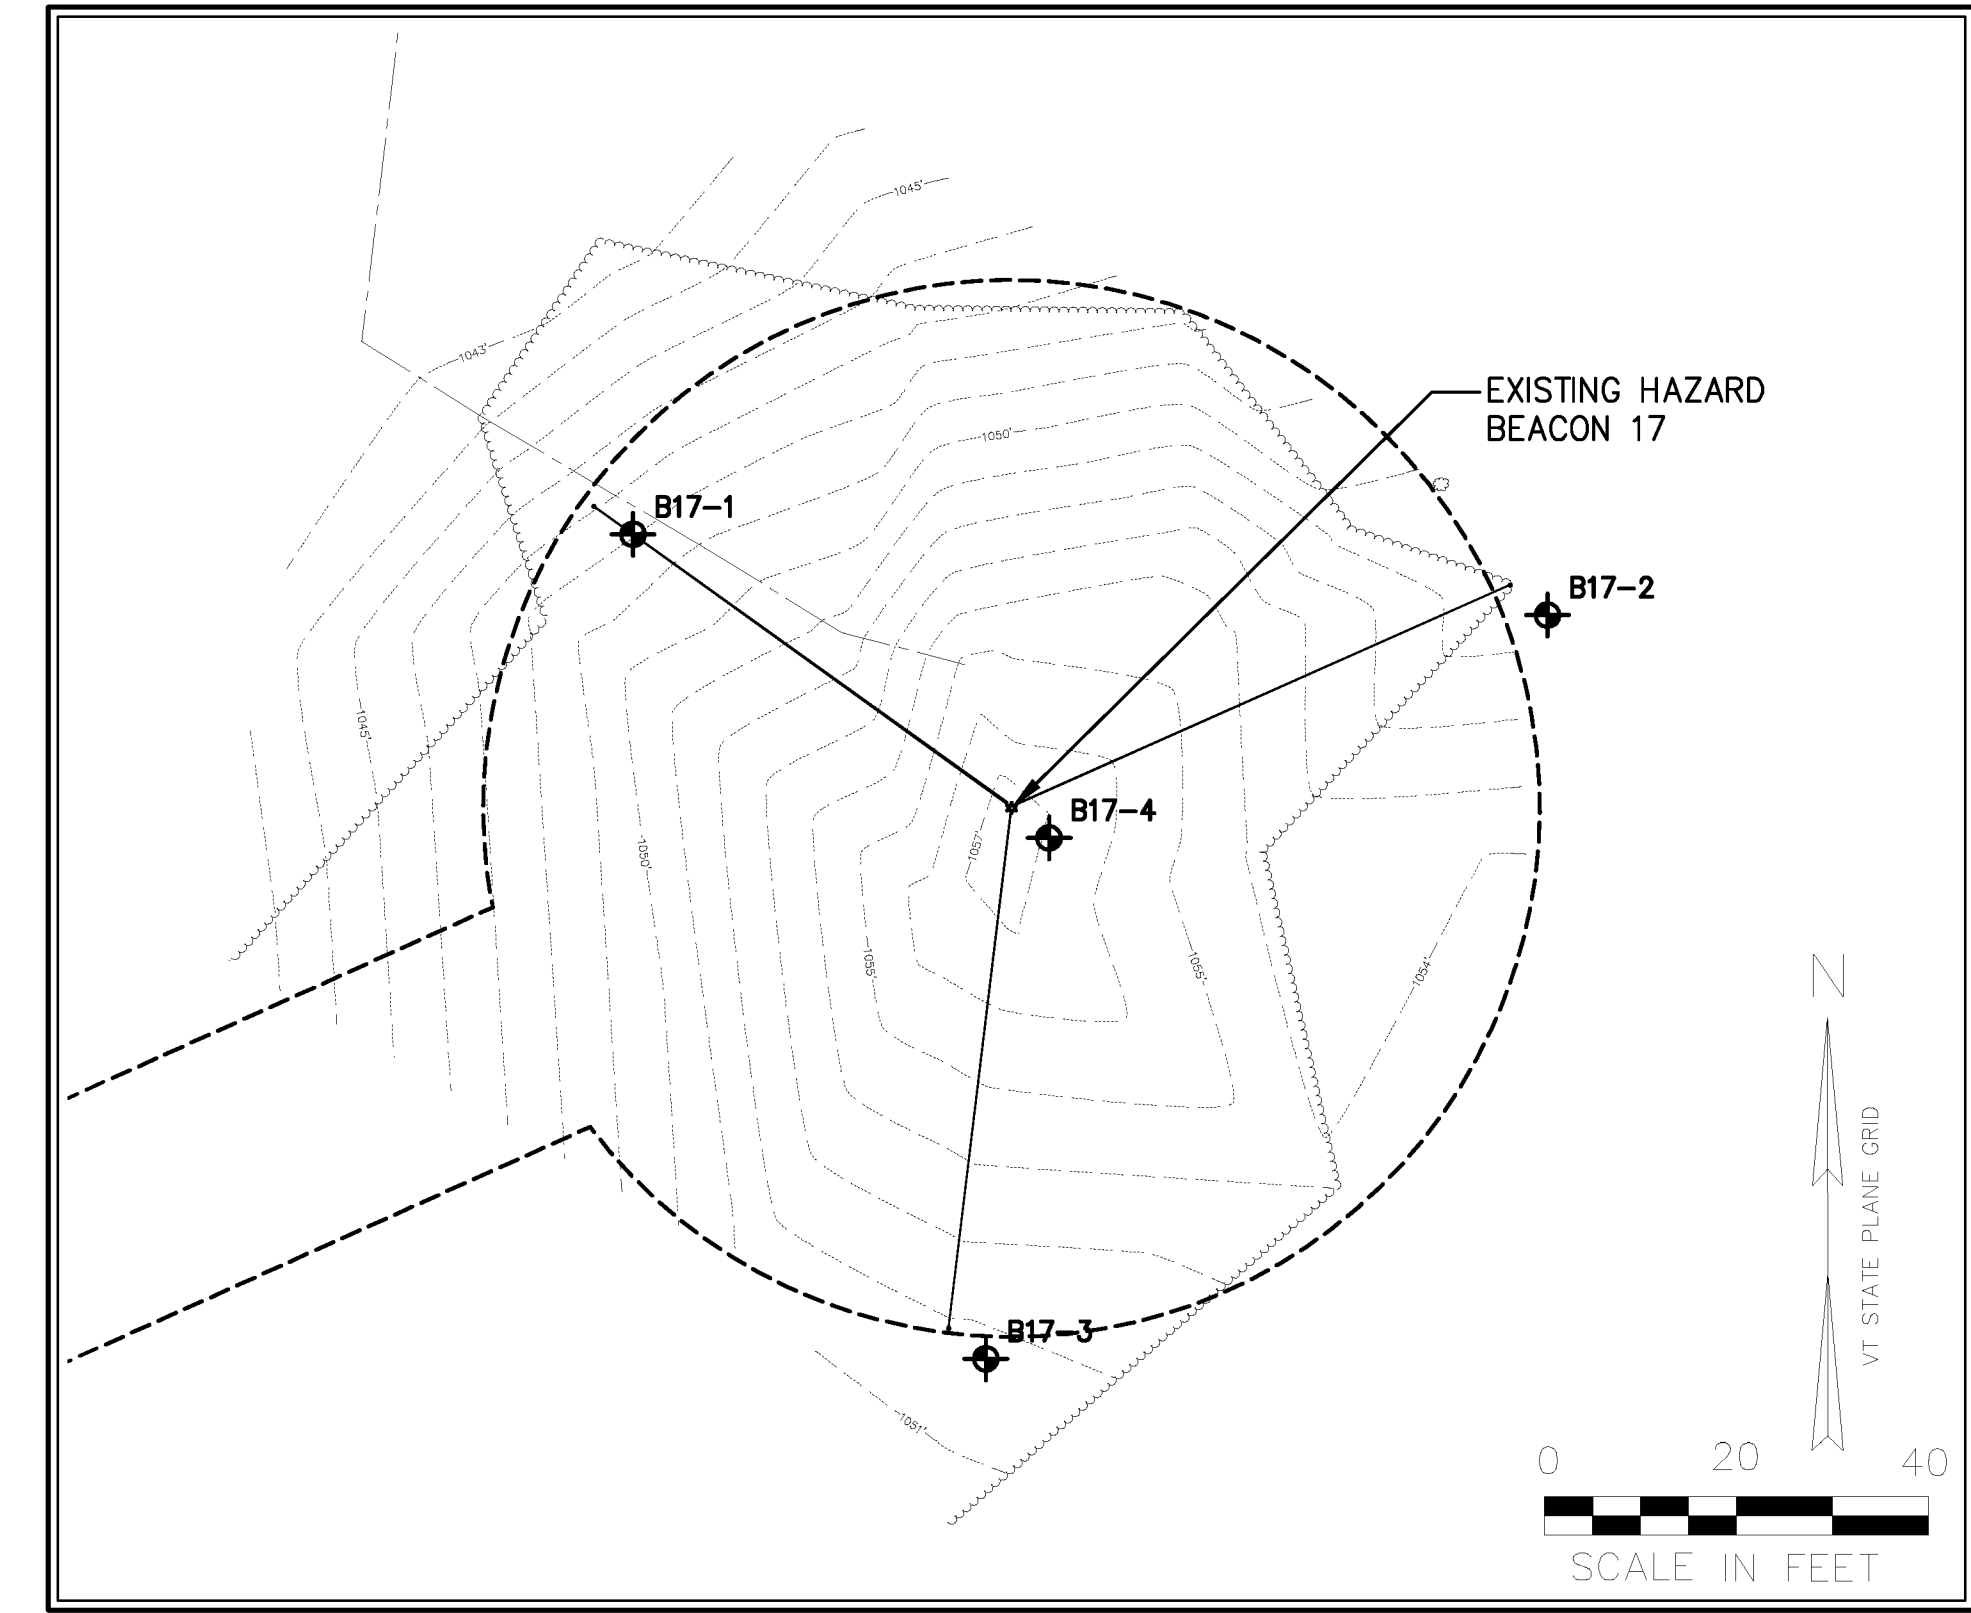

HAZARD BEACON #17 SUBSURFACE LOGS
SCALE: AS NOTED

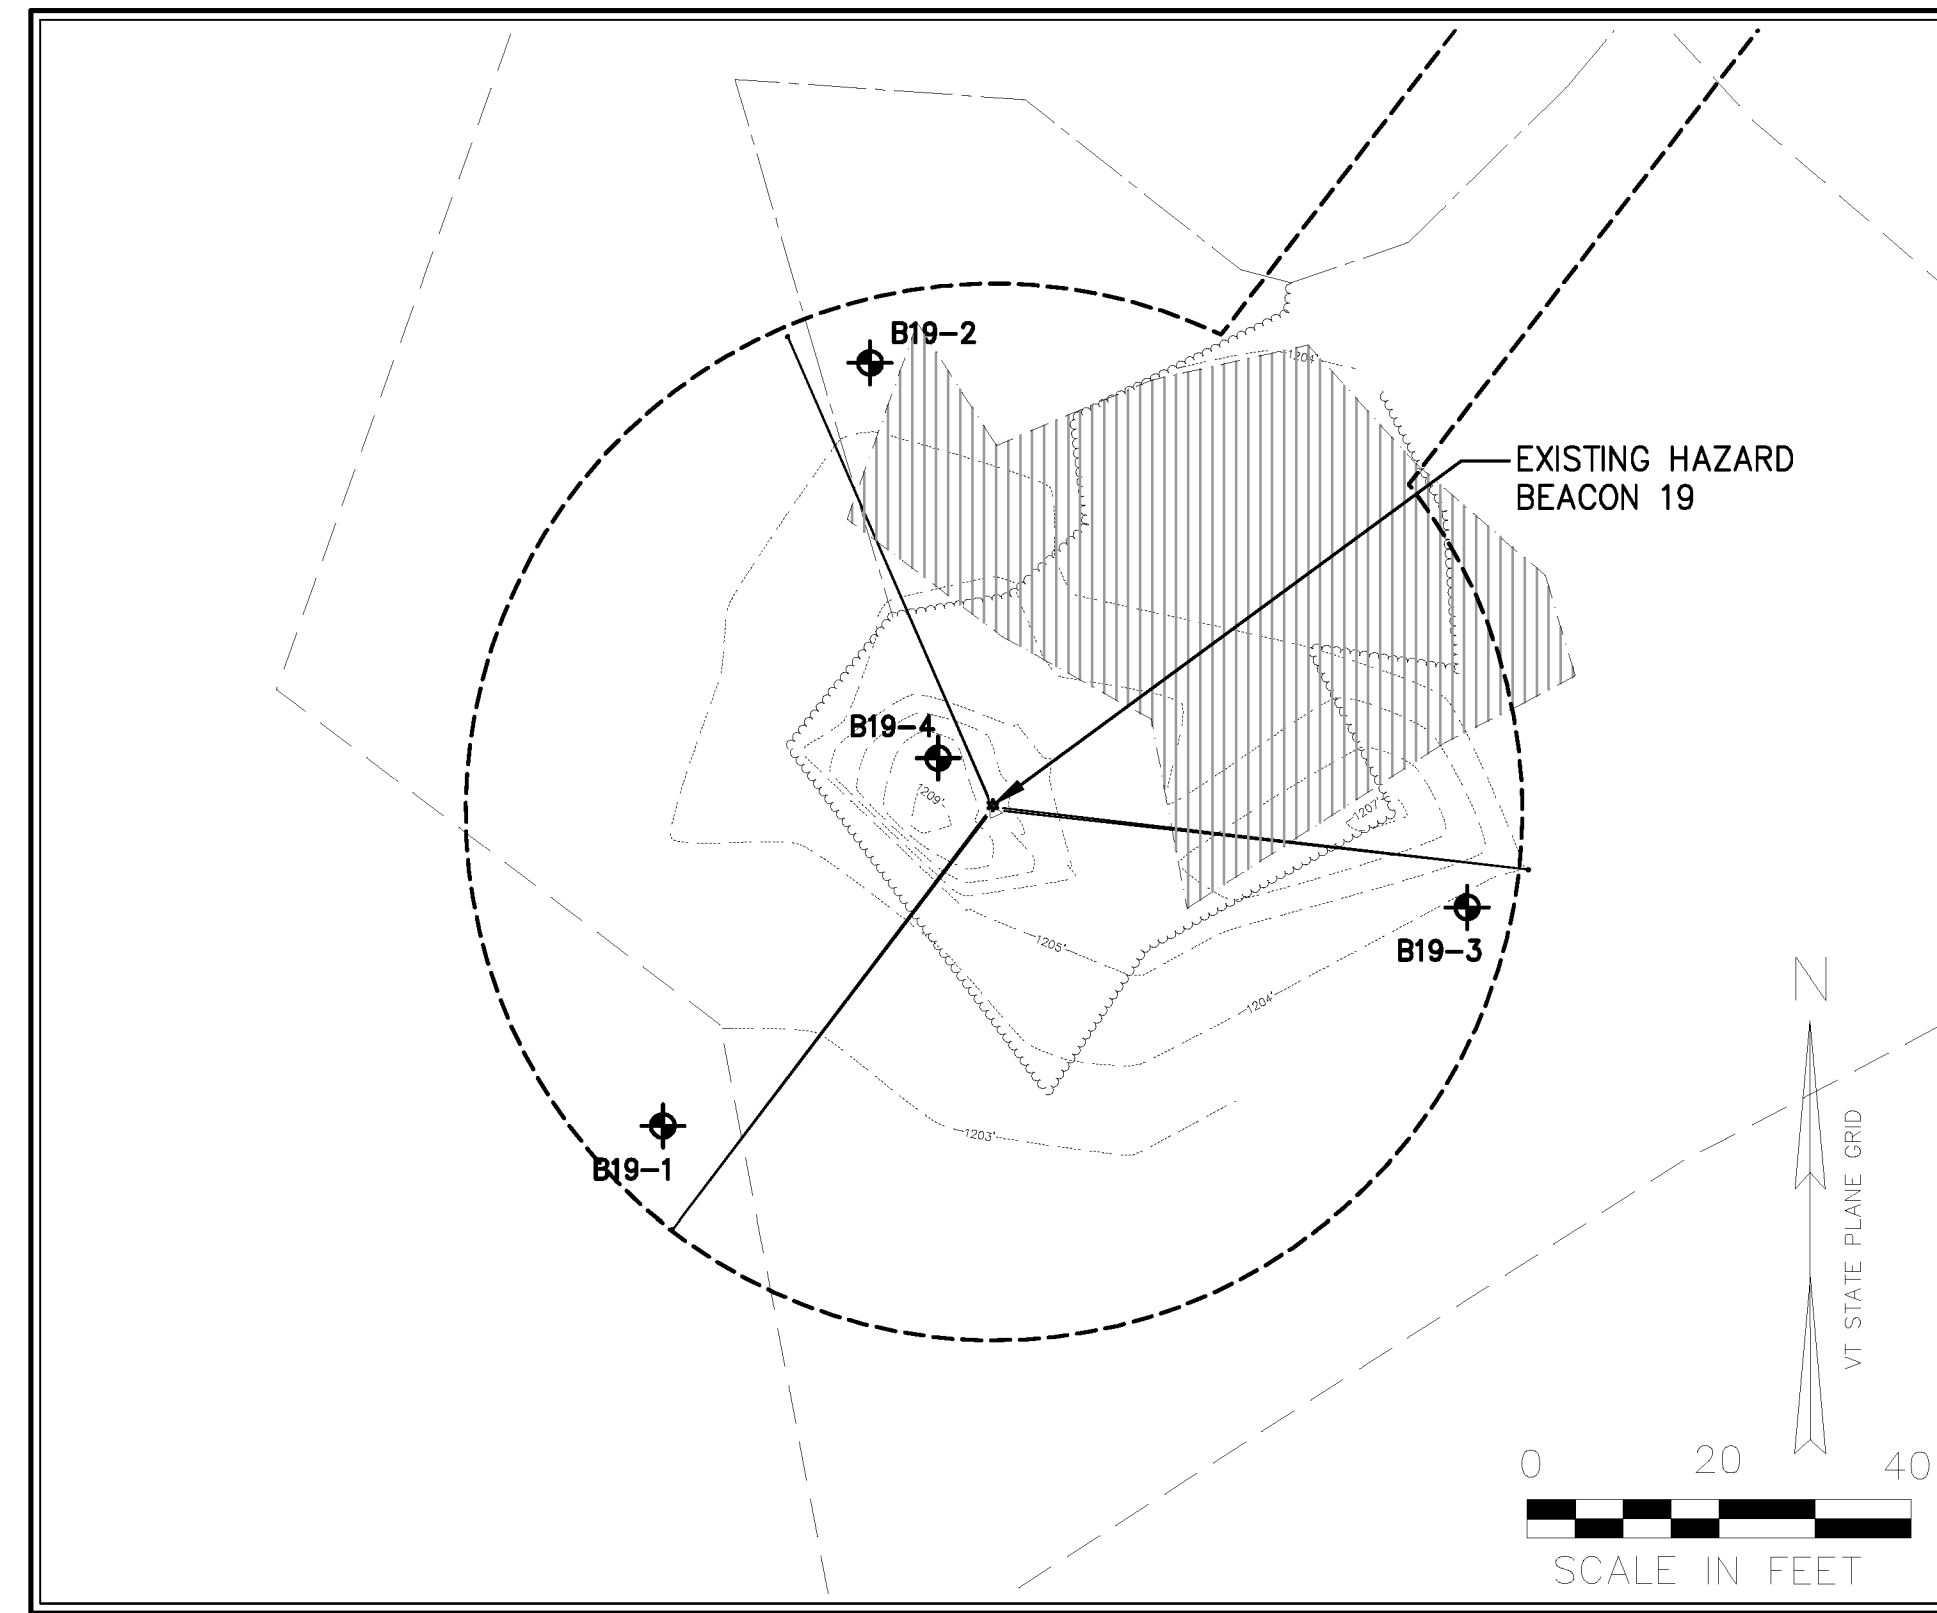

HAZARD BEACON #19 SUBSURFACE LOGS
SCALE: AS NOTED

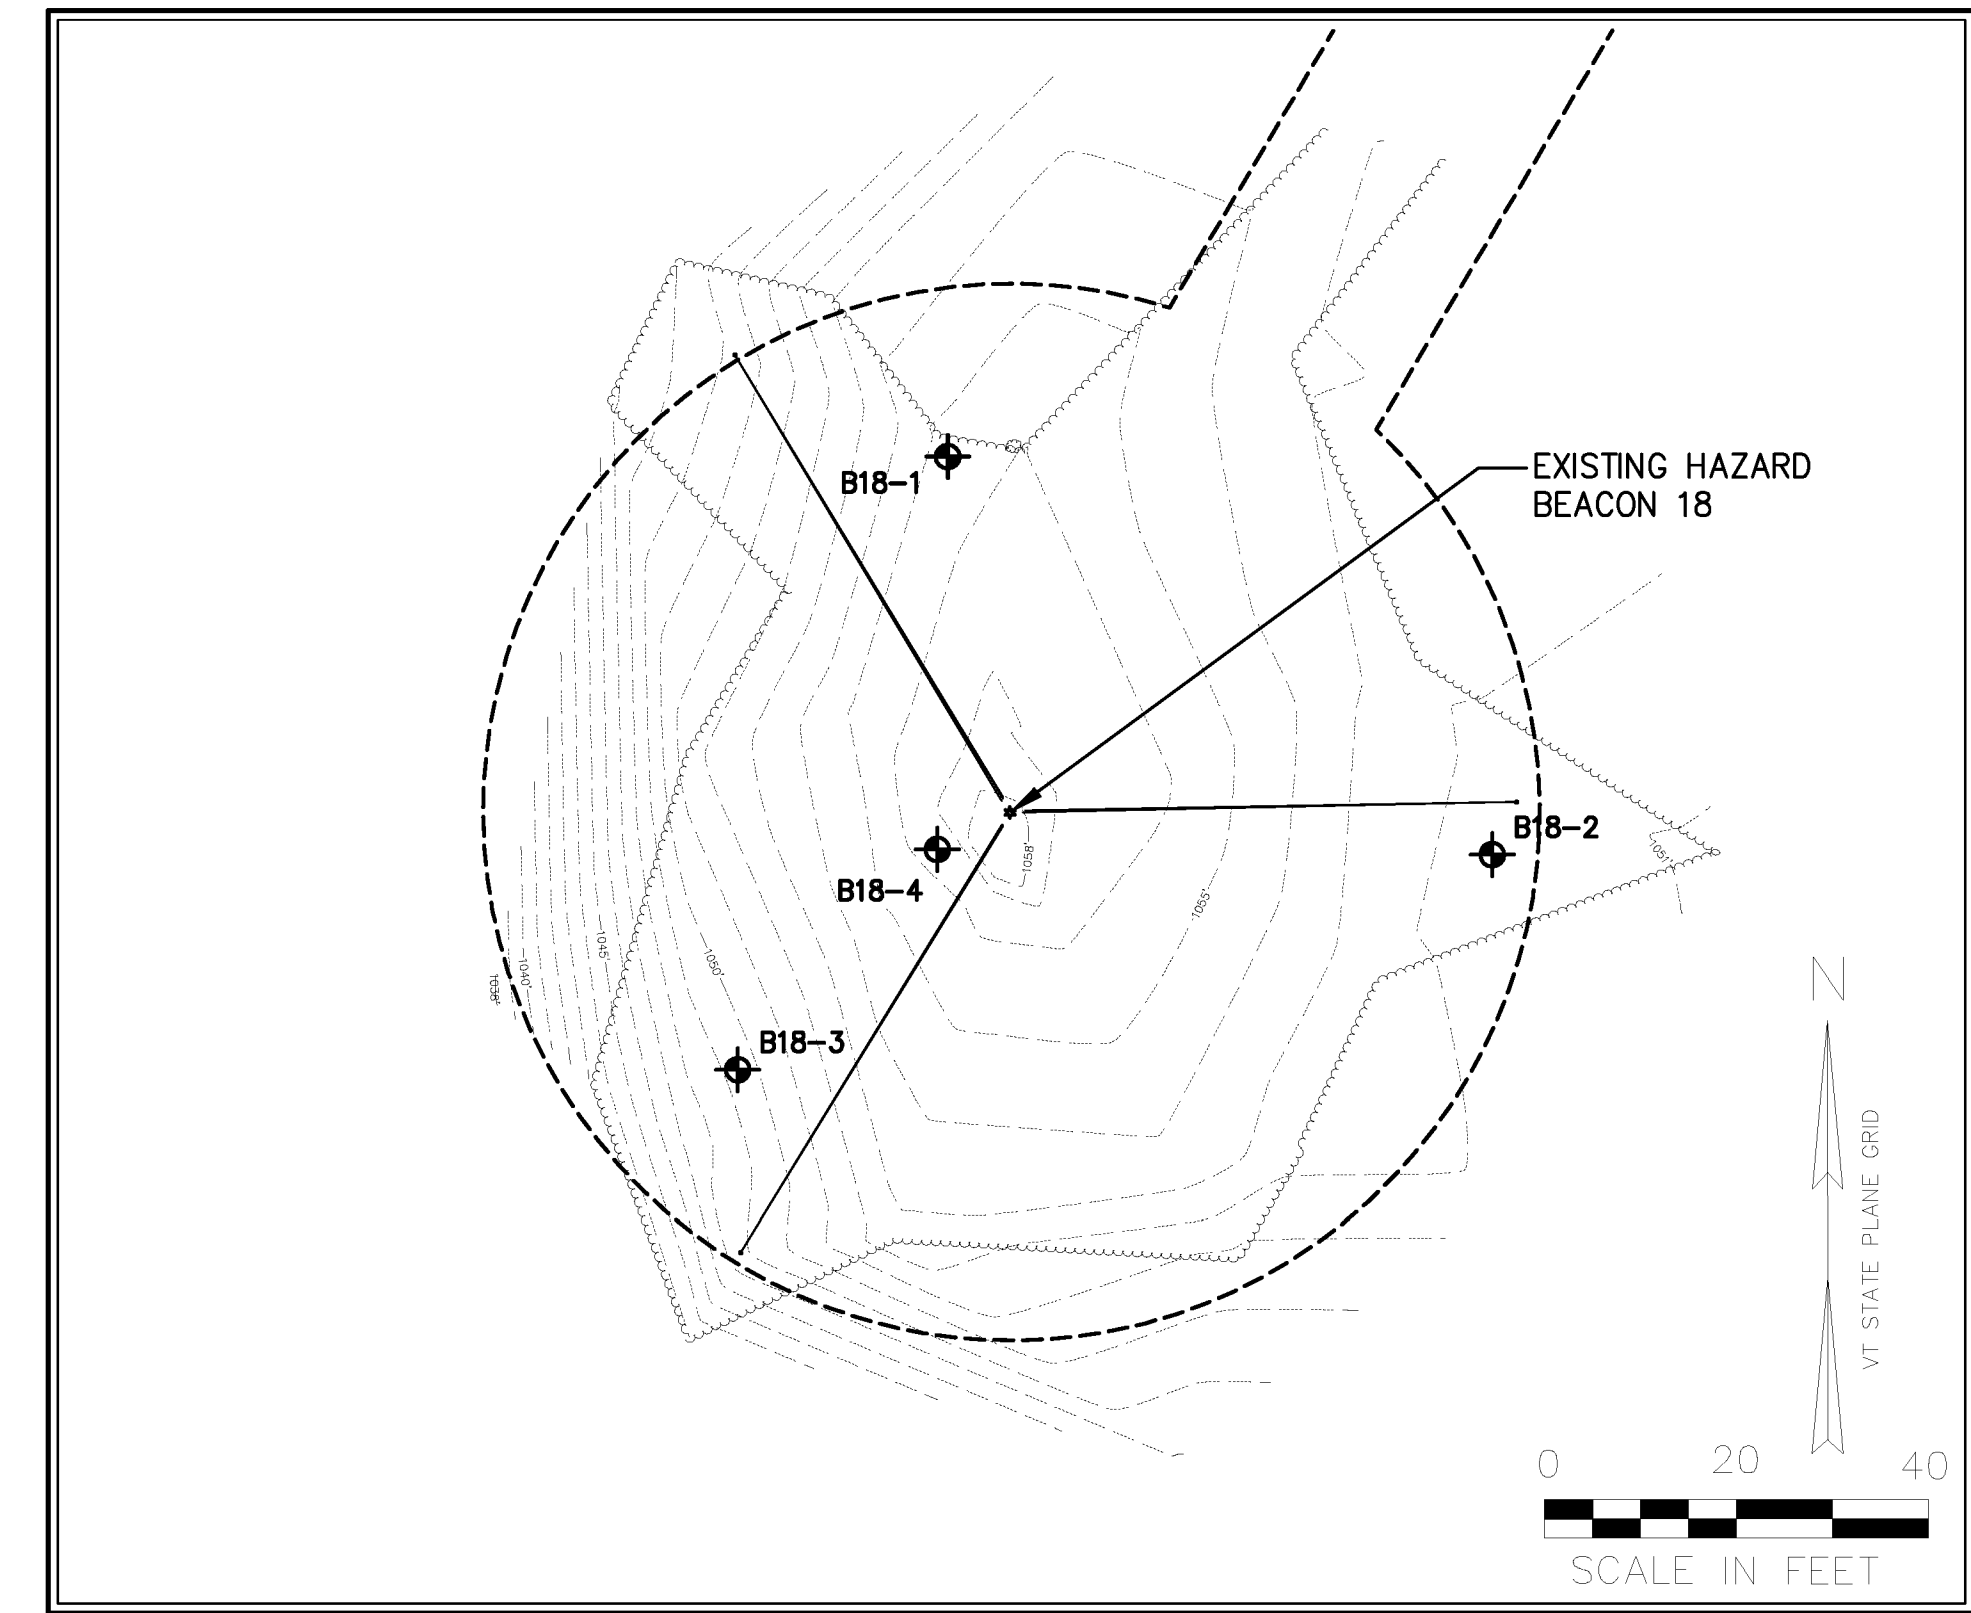


HAZARD BEACON #18 SUBSURFACE LOGS
SCALE: AS NOTED

LEGEND	
B17-1	APPROXIMATE BORING LOCATION

No.	Submittal / Revision	App'd. By	Date
1	RECORD DRAWINGS	HAW HAW	07/07/13

STATE OF VERMONT
AGENCY OF TRANSPORTATION

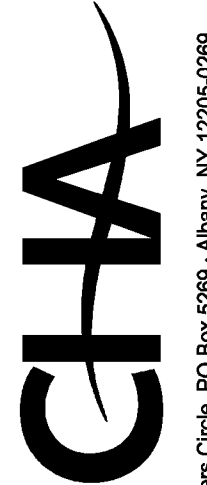
 III Winners Circle, PO Box 5089 - Albany, NY 12205-0289
 Main: (616) 433-4500 • www.chiacompanies.com
 Designed: HAW | Drawn: HAW | Checked: TYL


HARTNESS STATE AIRPORT
 HAZARD BEACON REPLACEMENT
 SUBSURFACE LOG PLANS
 Issue Date: 03/18/11 | Project No.: 21674 | Scale: As Shown

RECORD DRAWING 07/07/13


C-005

File: V:\PROJECTS\NYA\21674\CADD\ACAD\...SHEET_FILES\C005-21674.DWG
 Saved: 1/4/2013 4:15:56 PM Plotted: 1/4/2013 4:27:32 PM User: Wjrd, Heather LostSvedBy: 2789

File: V:\PROJECTS\NYA\21674\CADD\CADD\...SHEET_FILES\C101-21674.DWG
 Saved: 1/4/2013 4:16:20 PM Printed: 1/4/2013 4:28:54 PM User: Wjvd, Heather LastSavedBy: 2789

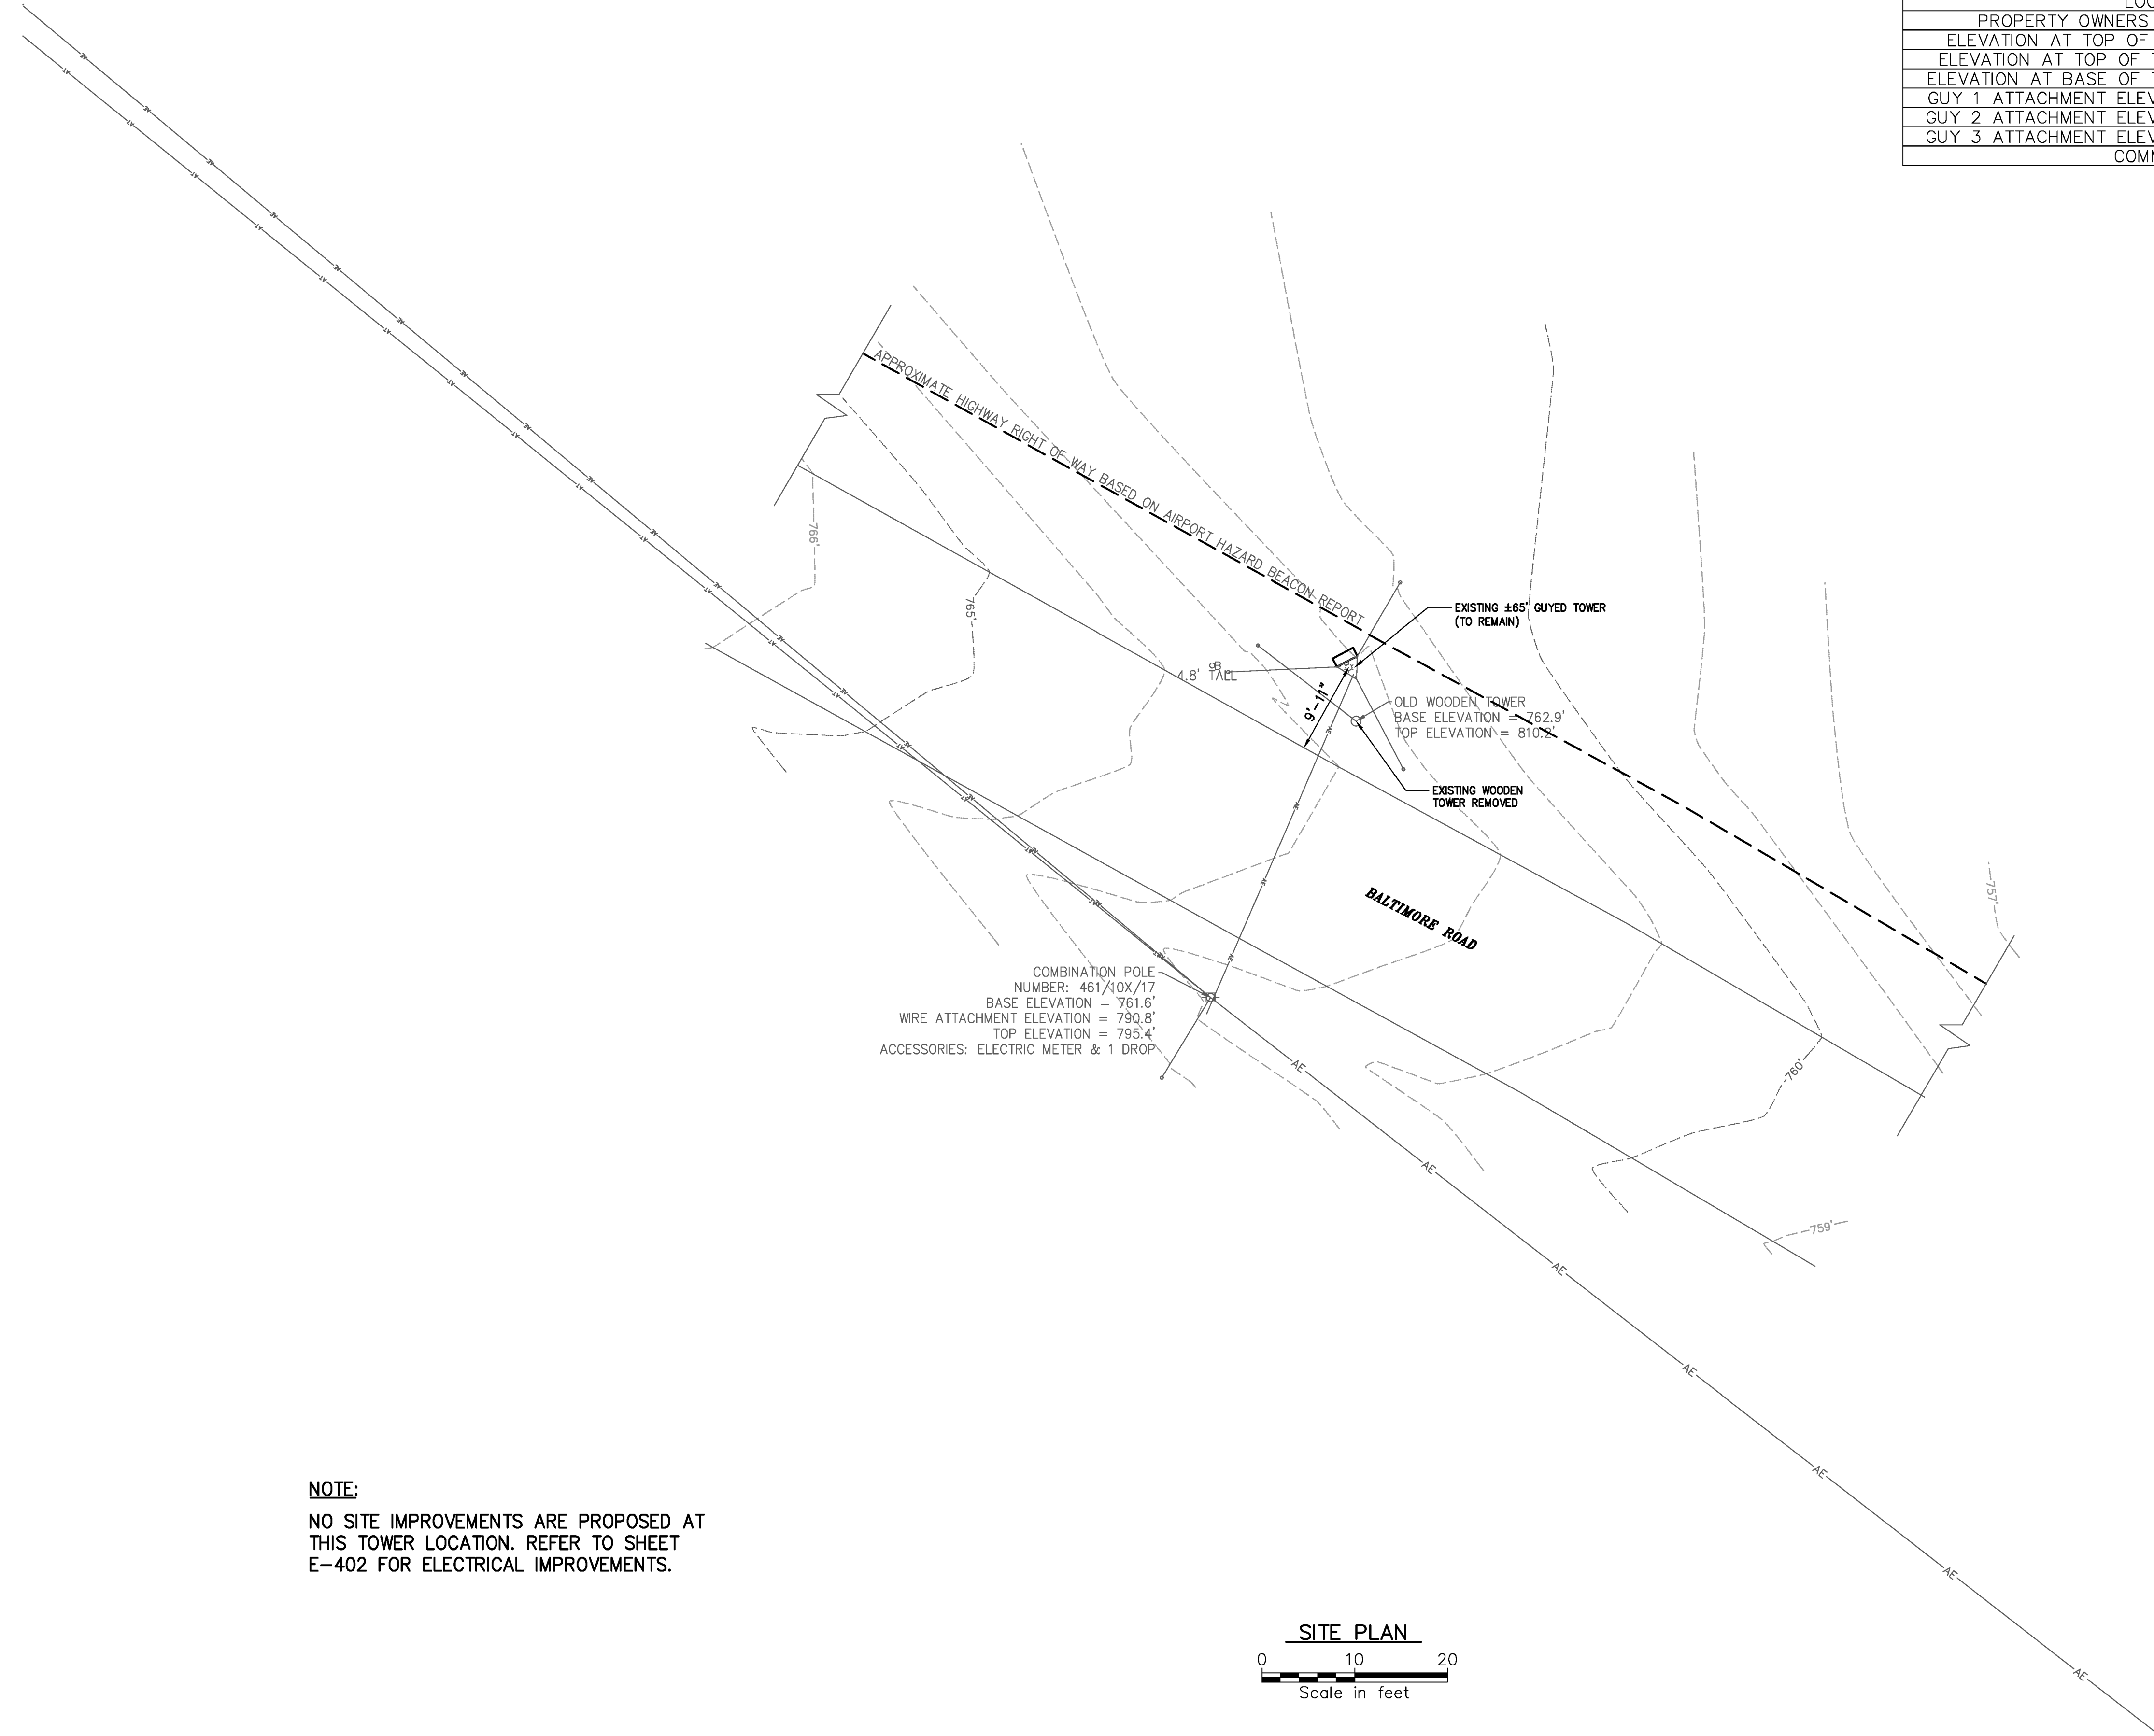

NOTE:
 NO SITE IMPROVEMENTS ARE PROPOSED AT THIS TOWER LOCATION. REFER TO SHEET E-402 FOR ELECTRICAL IMPROVEMENTS.

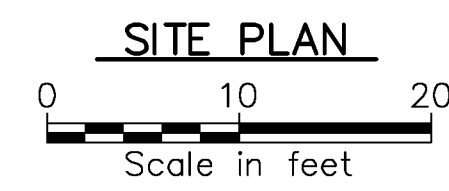

EXISTING SITE STATISTICS

BEACON #	1
LOCATION	BIBBENS
PROPERTY OWNERS NAME	TOWN HIGHWAY # 8 R.O.W.
ELEVATION AT TOP OF LIGHT	830.5'
ELEVATION AT TOP OF TOWER	827.8'
ELEVATION AT BASE OF TOWER	762.3'
GUY 1 ATTACHMENT ELEVATION	797.8'
GUY 2 ATTACHMENT ELEVATION	797.8'
GUY 3 ATTACHMENT ELEVATION	797.8'
COMMENTS	THERE ARE NO TREES NEAR THIS TOWER

App'd By	Date
HAW HAW	01/07/13
RECORD DRAWINGS	

STATE OF VERMONT
 AGENCY OF TRANSPORTATION

UNAUTHORIZED ALTERATION OR ADDITION
 OF ANY PART OF THIS DRAWING IS PROHIBITED
 APPLICABLE STATE AND/OR LOCAL LAWS

Designed: HAW Drawn: HAW Checked: TYL

111 Winners Circle, PO Box 5089 - Albany, NY 12205-0289
 Main: (518) 433-4500 • www.ch2a.com

HARTNESS STATE AIRPORT
 HAZARD BEACON REPLACEMENT



BEACON 1 SITE PLAN

Issue Date: 03/18/11 Project No.: 21674 Scale: As Shown


RECORD DRAWING 01/07/13

C-101

File: V:\PROJECTS\AVIA\21674\CADD\CADD_SHEET_FILES\C103-21674.DWG
 Sheet: 1/4/2013 4:17:07 PM Plotted: 1/4/2013 4:28:40 PM User: Wjvd, Heather LastSavedBy: 2789

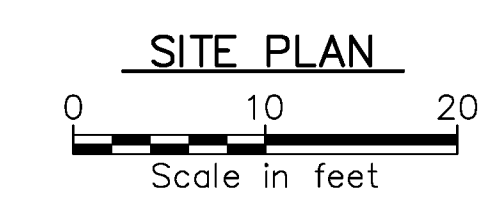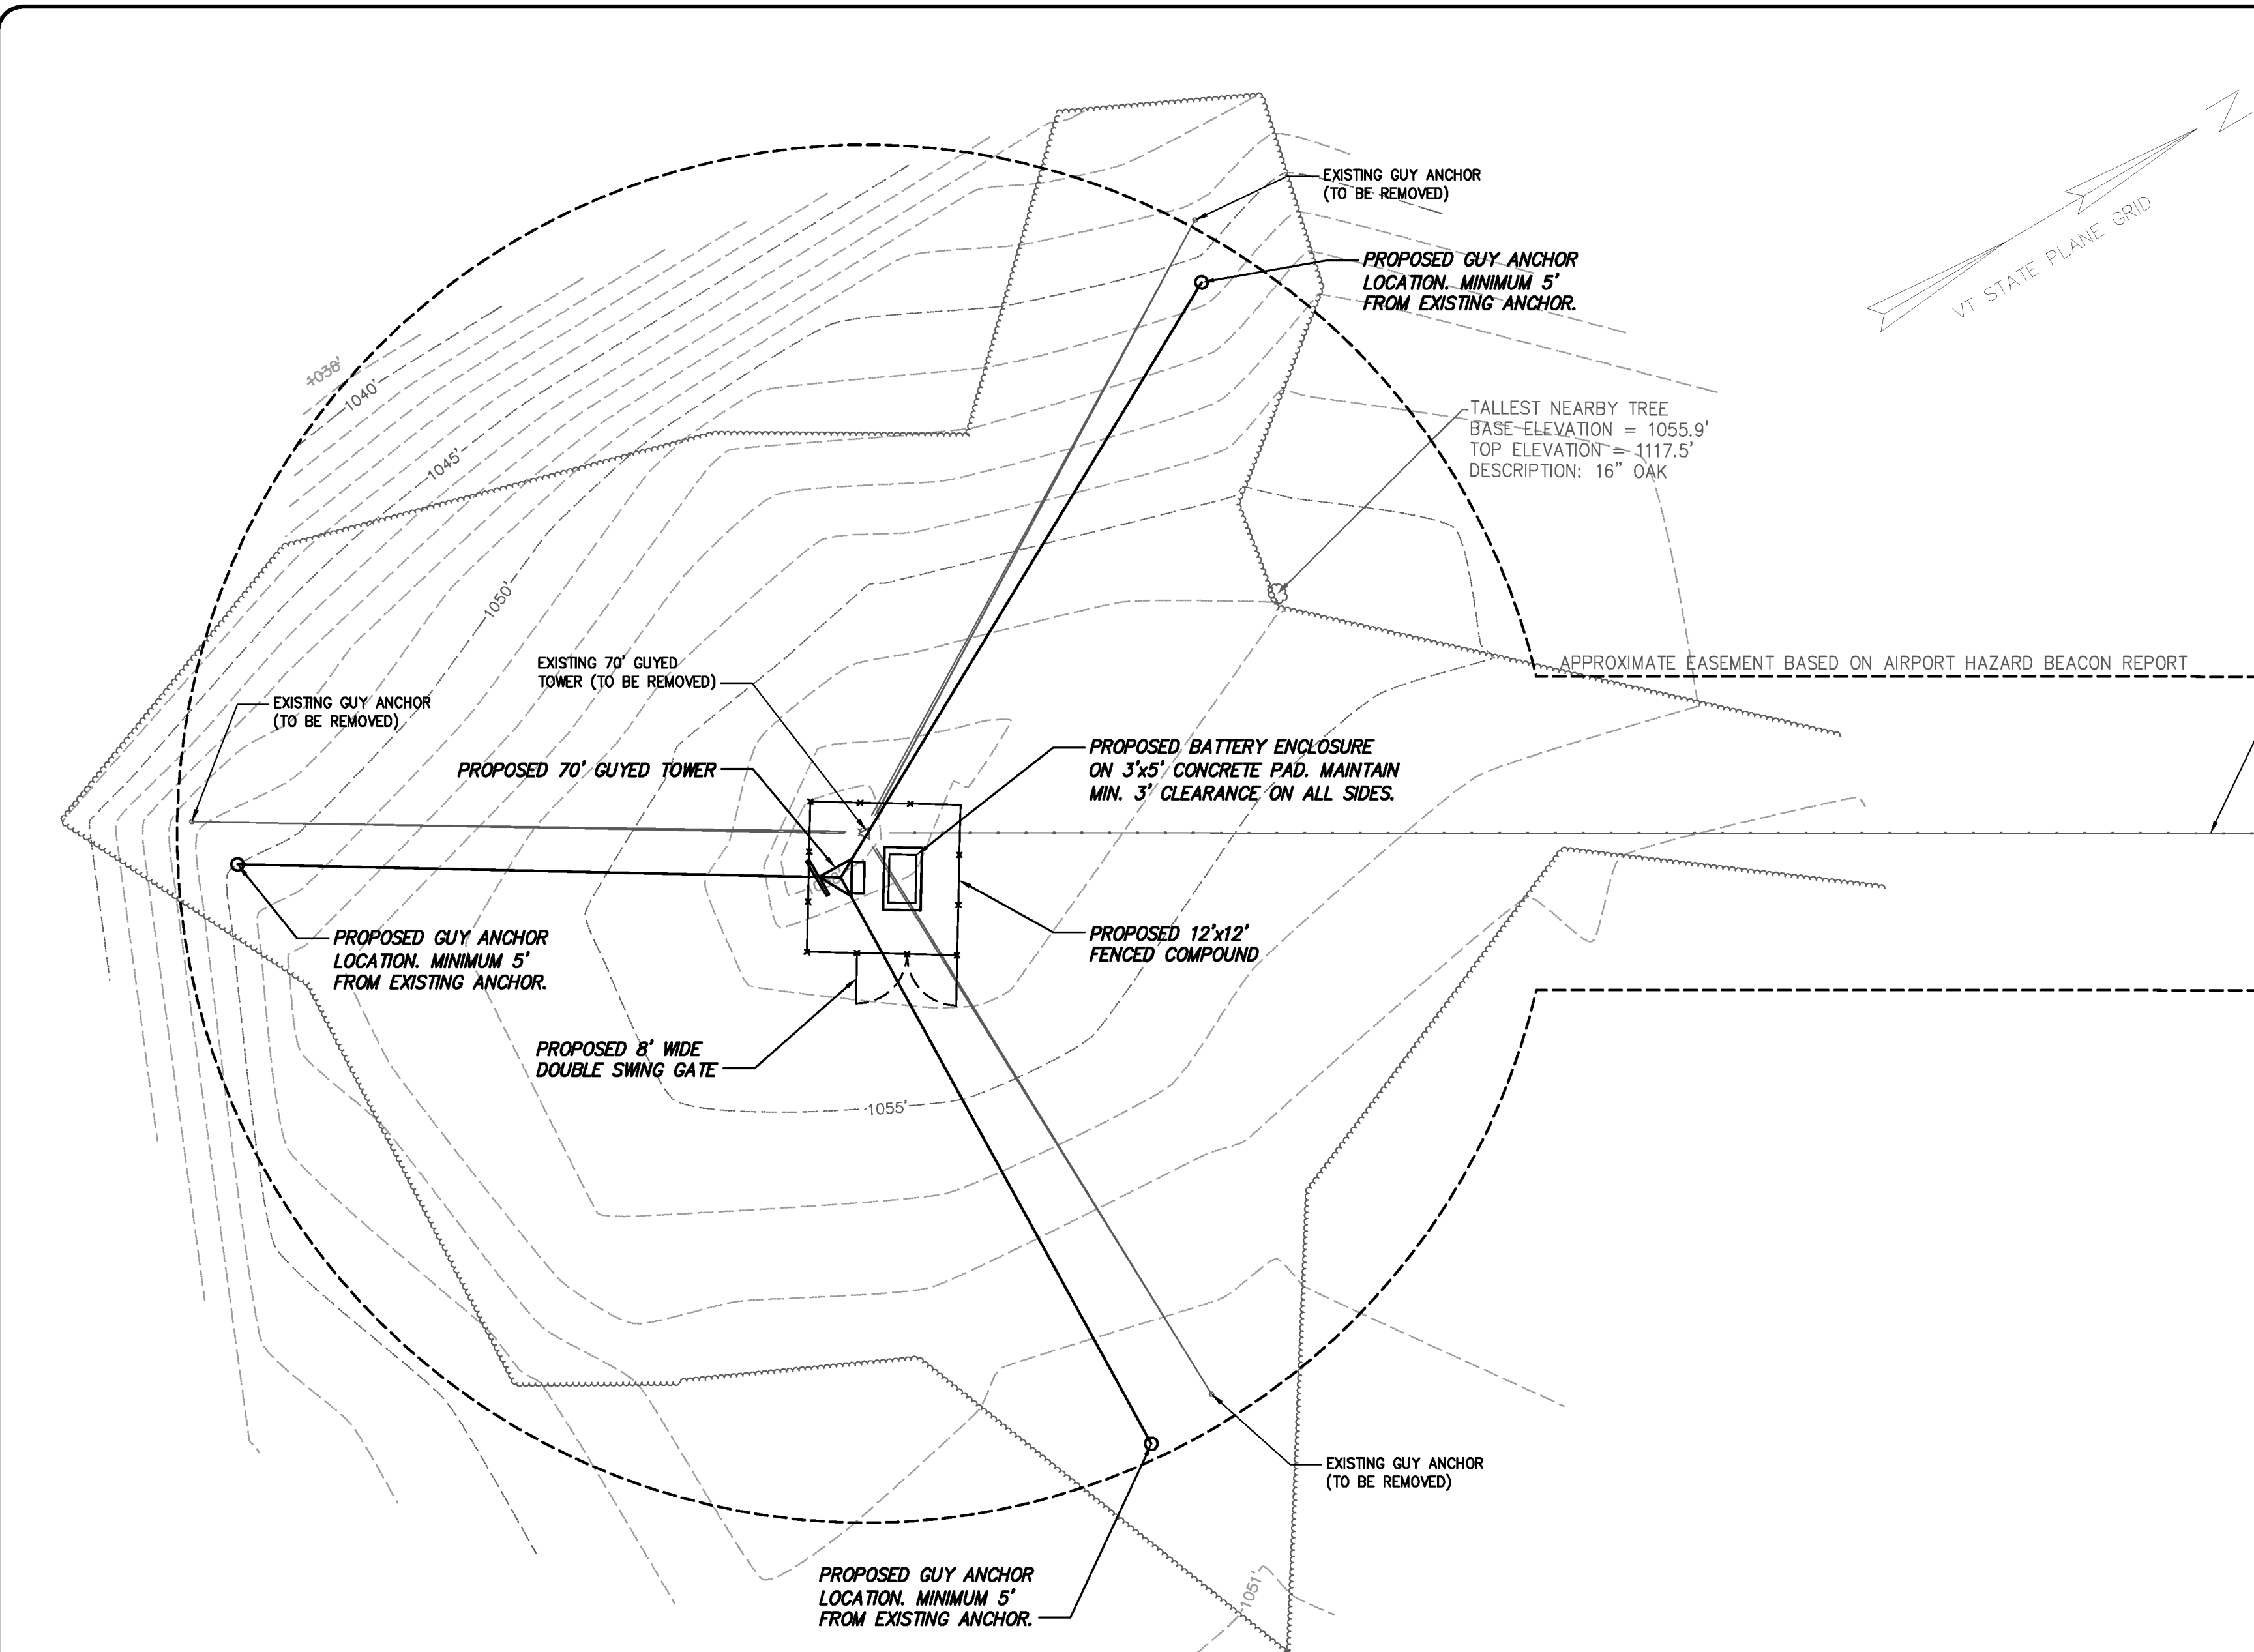

EXISTING SITE STATISTICS	
BEACON #	18
LOCATION	FRENCH MEADOW ROAD
PROPERTY OWNERS NAME	HOWARD E. & JEAN S. OBERG & HARRY K. SHEPARD
TOWN RECORDS BOOK & PAGE	74-363
ELEVATION AT TOP OF TOWER	1129.5'
ELEVATION AT TOP OF LIGHT	1126.3'
ELEVATION AT BASE OF TOWER	1058.2'
GUY 1A ATTACHMENT ELEVATION	1124.0'
GUY 1B ATTACHMENT ELEVATION	1104.7'
GUY 1C ATTACHMENT ELEVATION	1081.6'
GUY 2A ATTACHMENT ELEVATION	1104.7'
GUY 2B ATTACHMENT ELEVATION	1081.7'
GUY 2C ATTACHMENT ELEVATION	1124.0'
GUY 3A ATTACHMENT ELEVATION	1081.6'
GUY 3B ATTACHMENT ELEVATION	1124.0'
GUY 3C ATTACHMENT ELEVATION	1104.7'
COMMENTS	TREES AT THIS SITE ARE ABOUT THE SAME HEIGHT AS THE 16" OAK

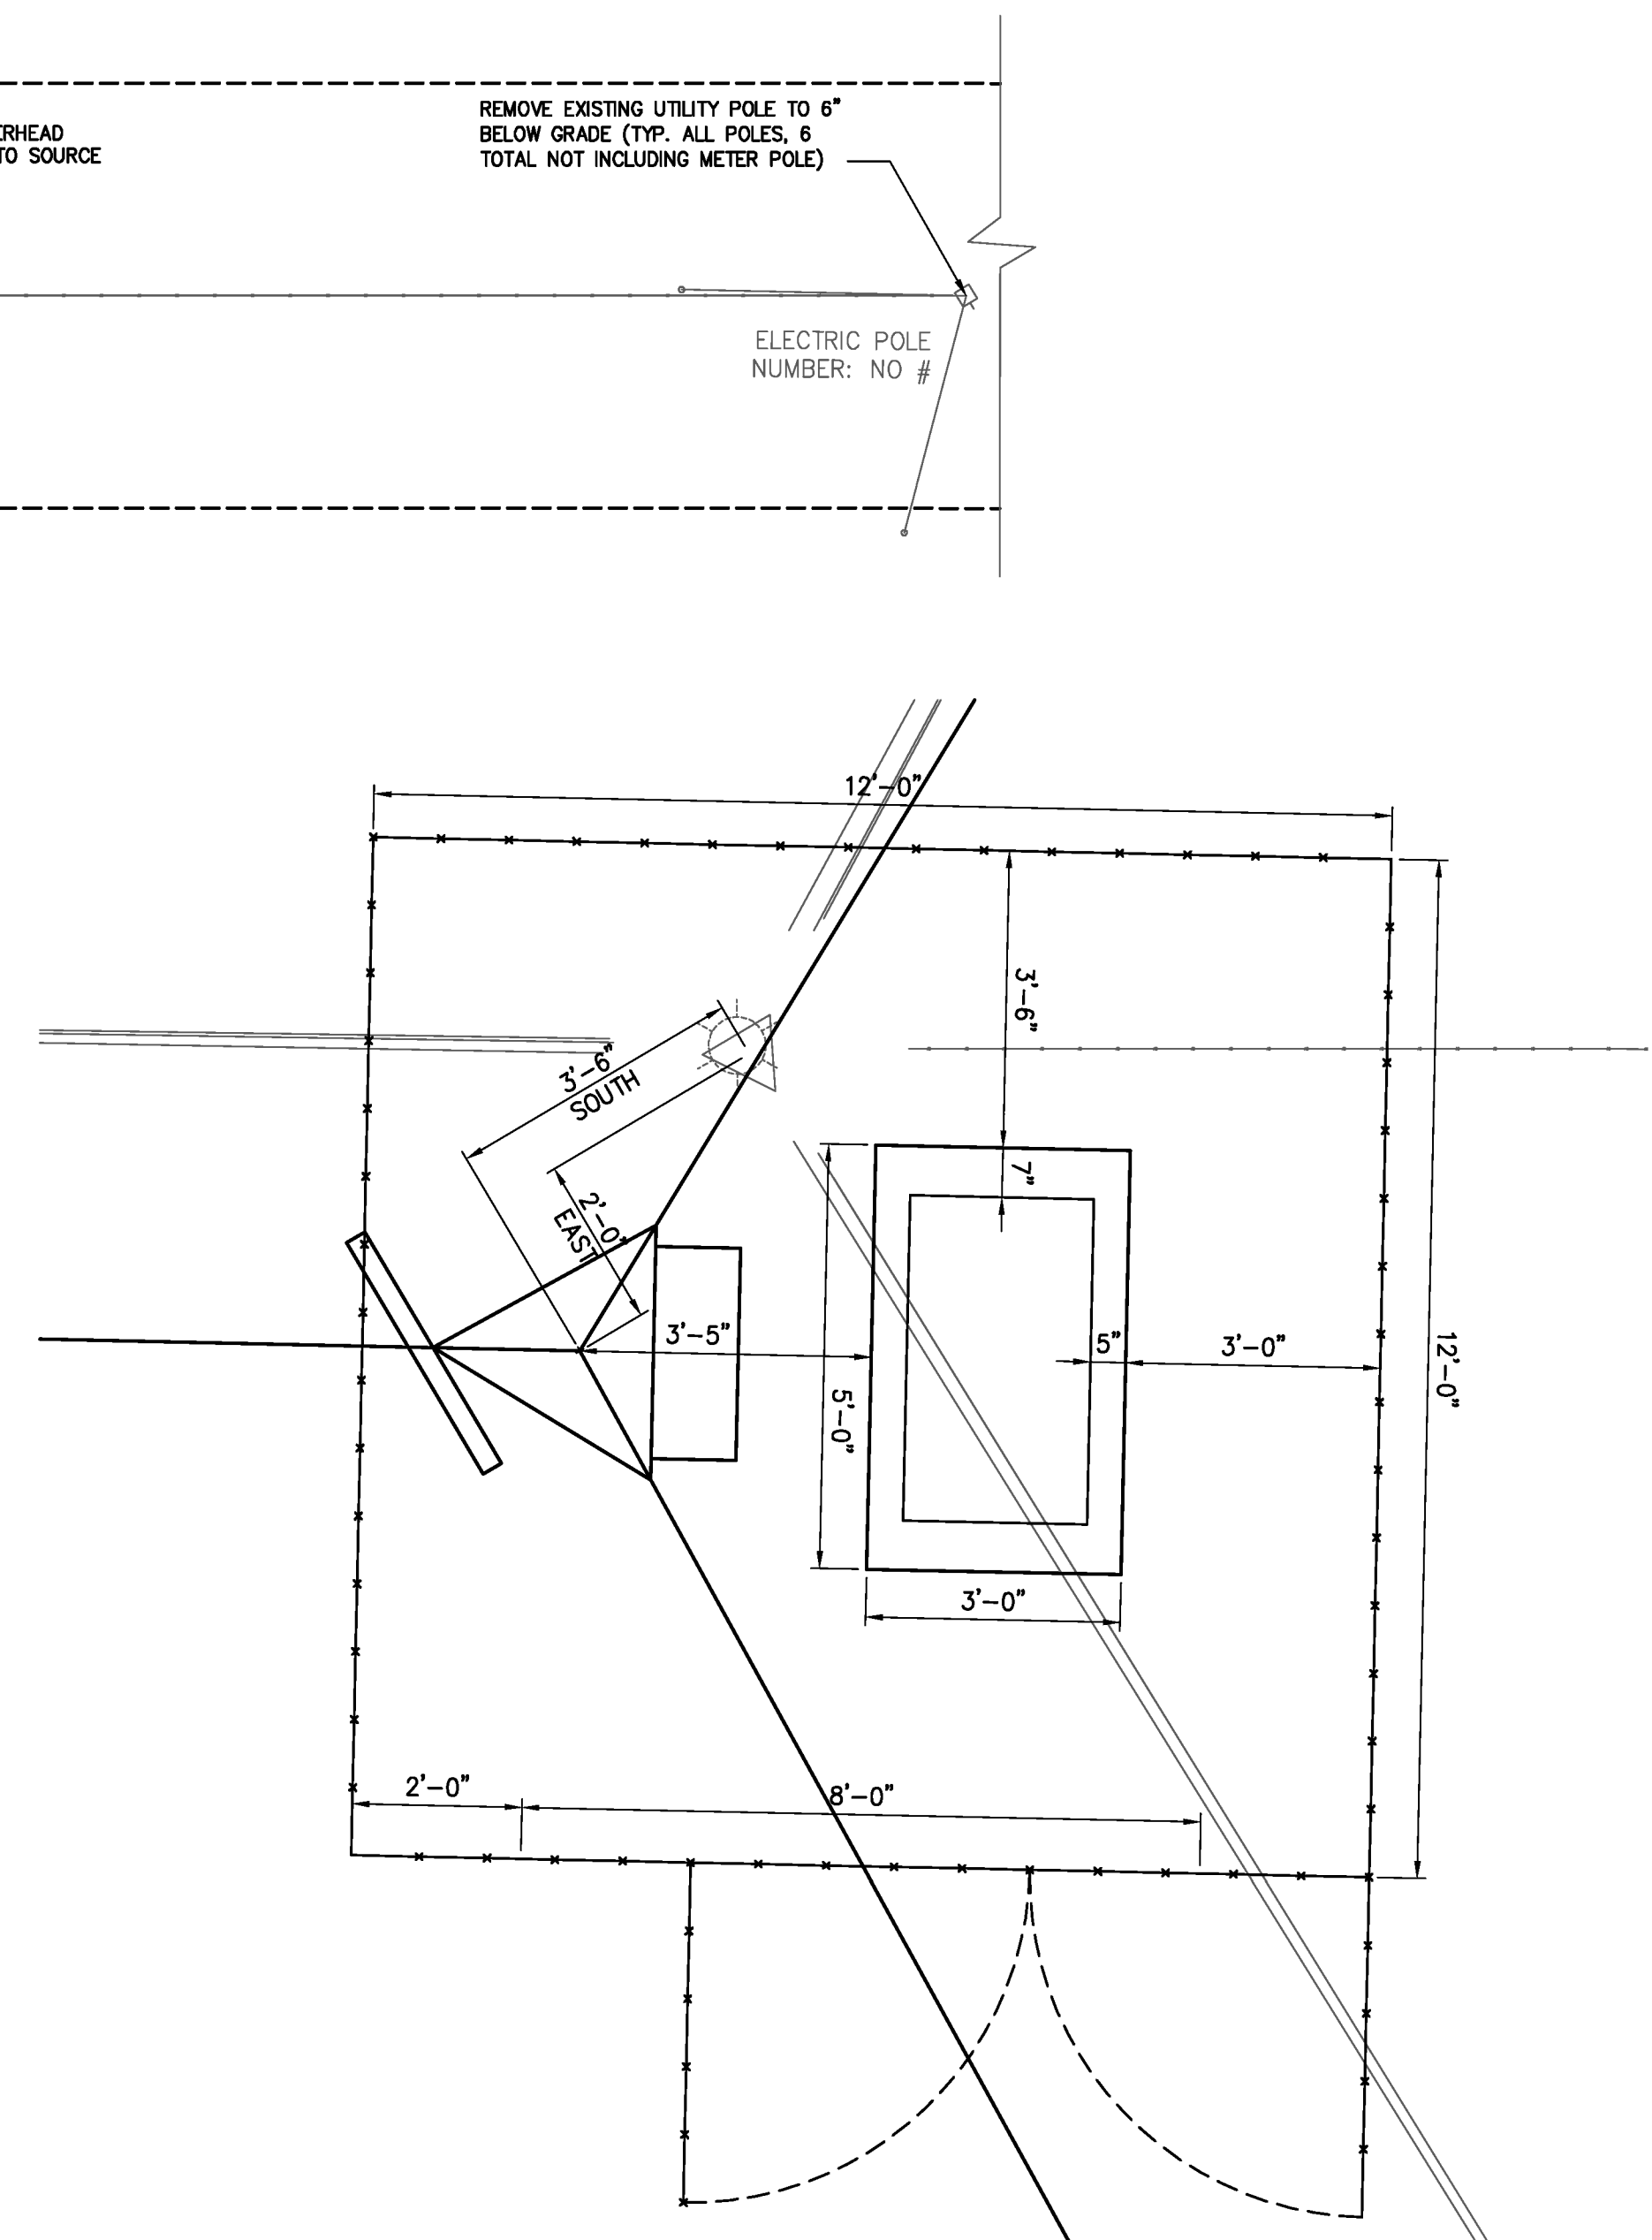

TREE REMOVAL GUIDELINES:
 ALL TREES WITHIN THE EASEMENT LIMITS THAT EXCEED A HEIGHT OF 42 FEET SHALL BE REMOVED. REFER TO PROJECT SPECIFICATIONS SECTION 311000 SITE CLEARING FOR TREE REMOVAL AND DISPOSAL PROCEDURES.

UTILITY REMOVAL GUIDELINES:
 EXISTING OVERHEAD UTILITY LINES SHALL BE REMOVED BACK TO THE SOURCE AND SHALL BE COORDINATED WITH THE UTILITY COMPANY. IF THE METER AND POLE IT IS ATTACHED TO ARE STAND-ALONE AND IT DOES NOT SERVICE ANY RESIDENTIAL CUSTOMERS IN ADDITION TO THE BEACON, THEN THE CONTRACTOR SHALL COORDINATE REMOVAL OF THE POLE WITH THE UTILITY COMPANY, PROVIDED ITS REMOVAL WOULD NOT HINDER ANY OTHER UTILITY LINES.

NOTE:
 PROPOSED GUY ANCHOR RADIUS TO BE DETERMINED BY TOWER MANUFACTURER. ANCHORS SHALL REMAIN WITHIN EXISTING EASEMENT, WHICH IS APPROXIMATELY 50 FEET FROM CENTERLINE OF PROPOSED TOWER.

- CONSTRUCTION SEQUENCE**
- CONSTRUCTION NOTES:**
1. ASSEMBLE AND INSTALL TOWER, GUY WIRES AND GUY ANCHORS PER THE MANUFACTURER'S WRITTEN INSTRUCTIONS.
 2. LOCATE TOWER BASE AND GUY ANCHOR LOCATIONS PER THIS DRAWING BY CHA.
 3. TOWER BASE SHALL BE INSTALLED ON AS FLAT A SURFACE AS POSSIBLE, IF LOCATION VARIES GREATLY FROM WHAT IS SHOWN, NOTIFY ENGINEER.
 4. CONTRACTOR IS RESPONSIBLE FOR LOAD TESTING ROCK ANCHORS.
 5. CONSTRUCTION OF THE NEW TOWER MUST BE COMPLETE AND THE NEW BEACON MUST BE OPERATIONAL BEFORE COMMENCING DEMOLITION ACTIVITIES.
- DEMOLITION NOTES:**
1. CONTRACTOR TO REMOVE TOP-MOST SECTION OF TOWER PRIOR TO REMOVING ANY GUY WIRES, IF APPLICABLE.
 2. REMOVE GUY WIRES AT HIGHEST ELEVATION PRIOR TO REMOVING ANY OTHER SETS OF GUYS.
 3. DEMOLITION OF THE TOWER SHALL CONSIST OF REMOVING ALL TOWER SECTIONS AT THE HIGHEST ELEVATIONS FIRST, UNTIL GUY WIRE LOCATIONS ARE ENCOUNTERED.
 4. CONTRACTOR IS RESPONSIBLE FOR TEMPORARY SUPPORTING THE STRUCTURE WHILE GUY WIRES ARE REMOVED.
 5. REMOVE GUY ONCE TOWER SECTIONS ABOVE THEM ARE REMOVED.
 6. REMOVE TOWER STRUCTURE IN ITS ENTIRETY, INCLUDING BUT NOT LIMITED TO, ITS BASE, BASE PLATE AND ANCHORS.
 7. COMPLETELY REMOVE ALL GUY ANCHORS FROM THEIR EXISTING LOCATIONS ONCE THE TOWER IS REMOVED. GUY ANCHORS ARE TO BE CUT AT ROCK SURFACE.
 8. CONTRACTOR IS RESPONSIBLE FOR THE COMPLETE REMOVAL AND DISPOSAL OF ALL TOWER ELEMENTS PROPERLY, INCLUDING PROPER LEAD PAINT REMOVAL IF APPLICABLE.

RECORD DRAWING 01/07/13

No.	Submitted / Revision	App'd. By	Date
1	RECORD DRAWINGS	HAW HAW	01/07/13

STATE OF VERMONT
 AGENCY OF TRANSPORTATION

DESIGNED: HAW | DRAWN: HAW | CHECKED: TYL



III Winners Circle, PO Box 5089 - Albany, NY 12205-0289
 Main: (518) 453-4500 • www.chacompanies.com

HARTNESS STATE AIRPORT
 HAZARD BEACON REPLACEMENT
 BEACON 18 SITE PLAN

Issue Date: 03/18/11 | Project No.: 21674 | Scale: As Shown

C-103

File: V:\PROJECTS\HAWAII\21674\CADD\CADD_SHEET_FILES\C104-21674.DWG
 Saved: 1/4/2013 4:13:33 PM Plotted: 1/4/2013 4:30:04 PM User: Wjvd, Heather LastSavedBy: 2789

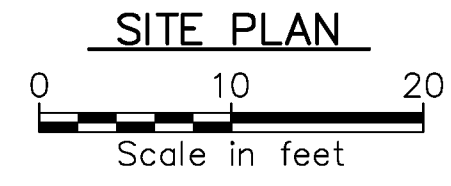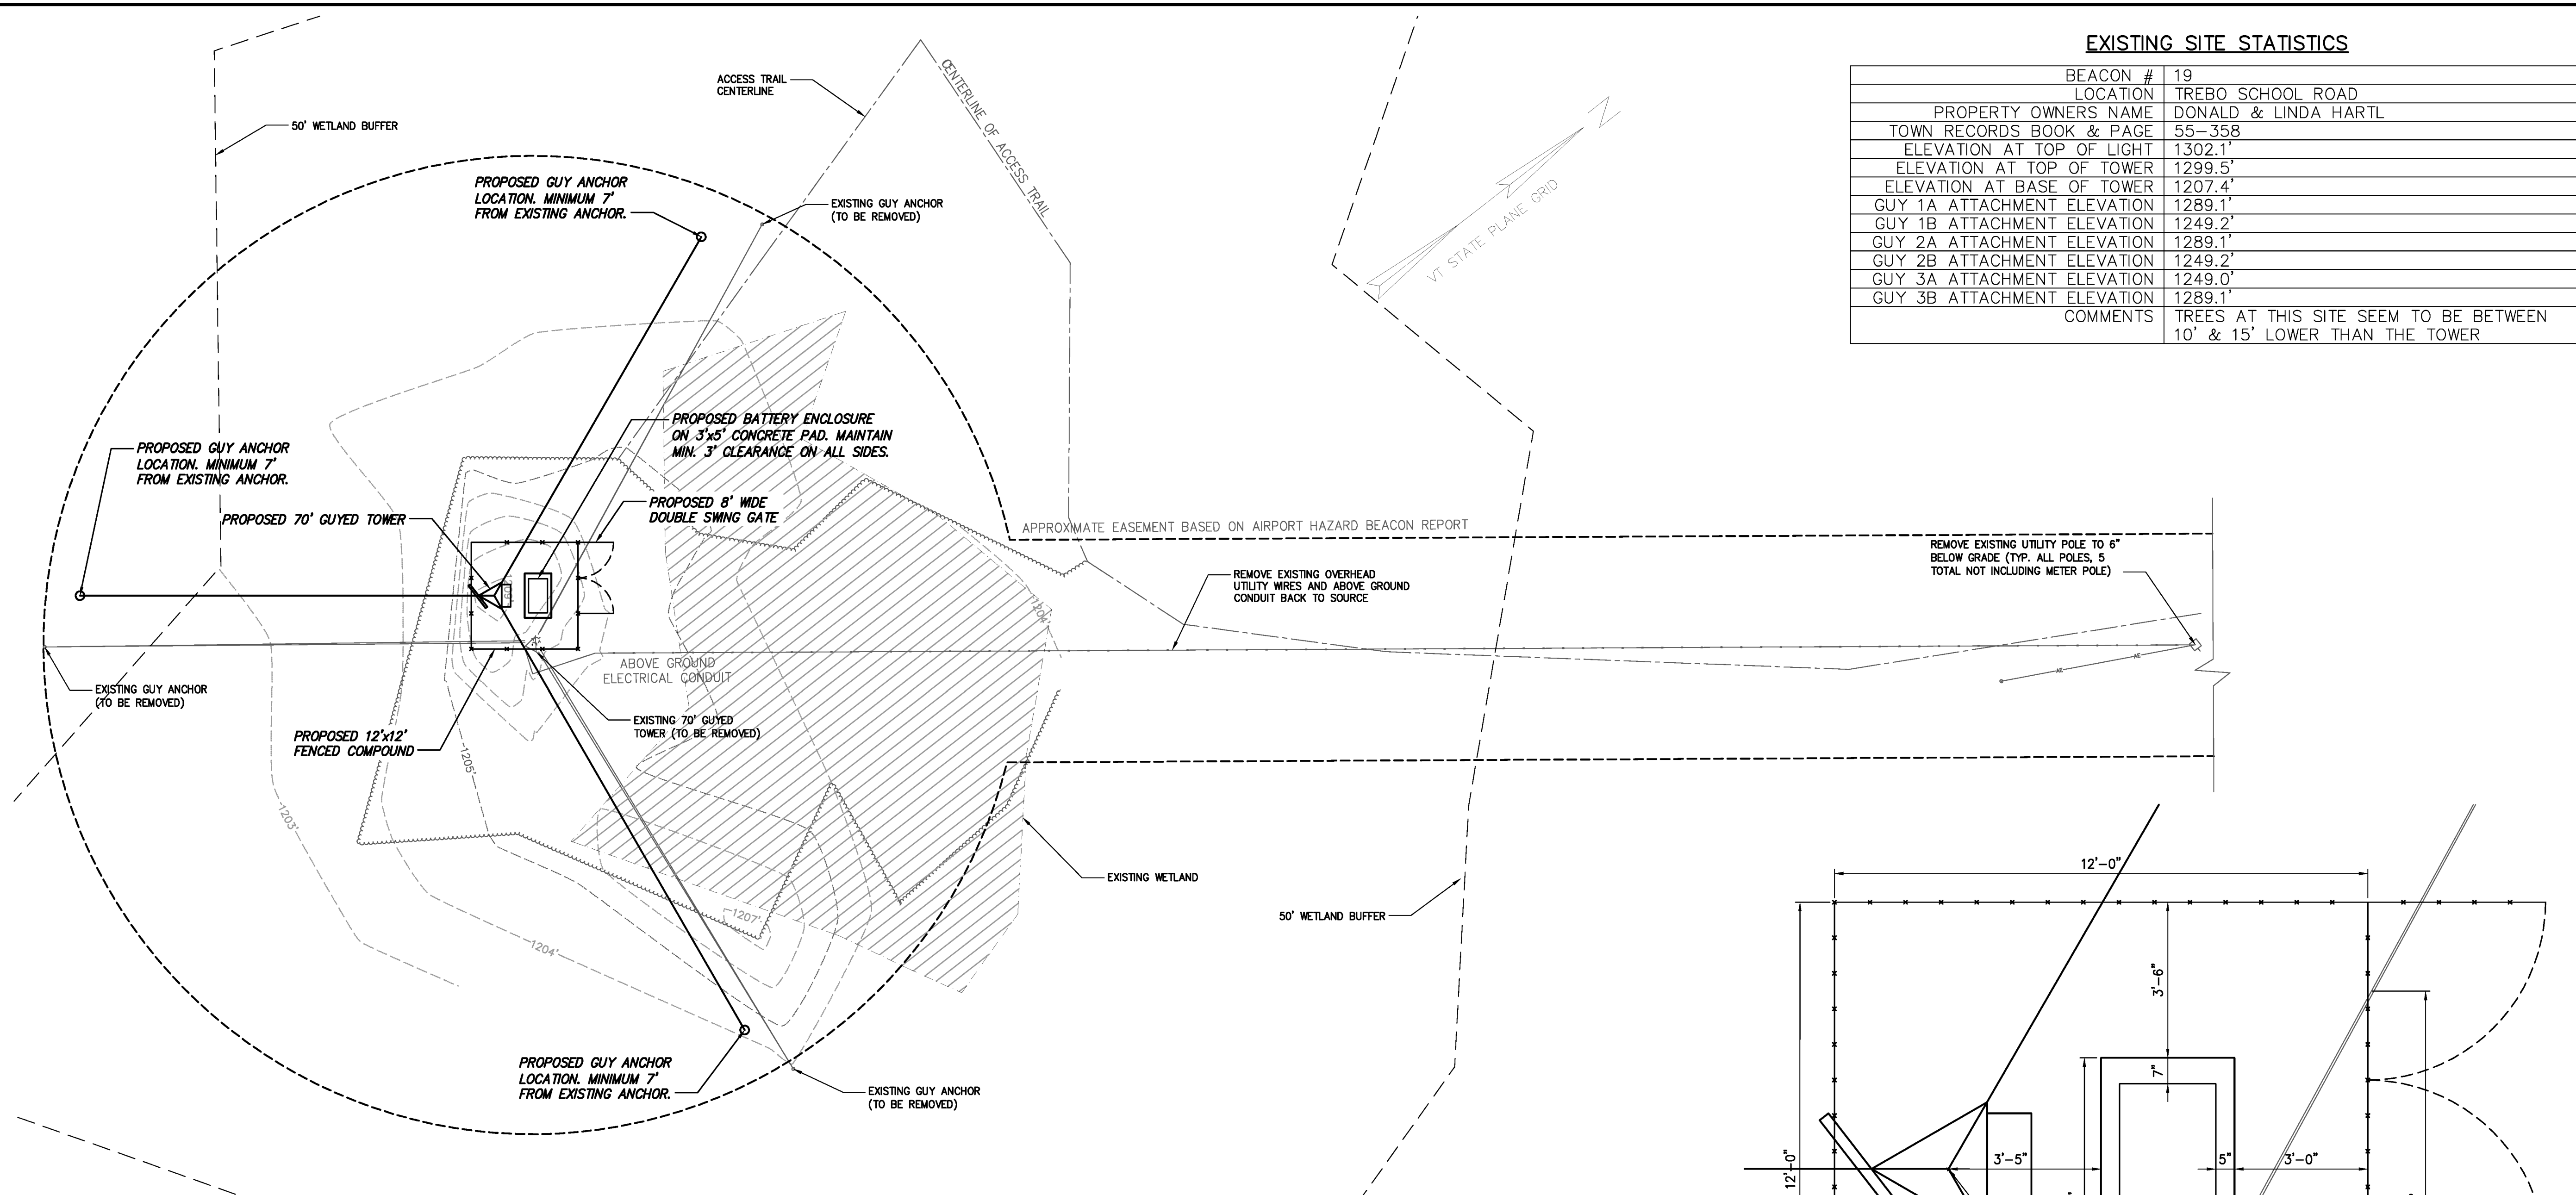

CONSTRUCTION SEQUENCE


- CONSTRUCTION NOTES:**
1. ASSEMBLE AND INSTALL TOWER, GUY WIRES AND GUY ANCHORS PER THE MANUFACTURER'S WRITTEN INSTRUCTIONS.
 2. LOCATE TOWER BASE AND GUY ANCHOR LOCATIONS PER THIS DRAWING BY CHA.
 3. TOWER BASE SHALL BE INSTALLED ON AS FLAT A SURFACE AS POSSIBLE, IF LOCATION VARIES GREATLY FROM WHAT IS SHOWN, NOTIFY ENGINEER.
 4. CONTRACTOR IS RESPONSIBLE FOR LOAD TESTING ROCK ANCHORS.
 5. CONSTRUCTION OF THE NEW TOWER MUST BE COMPLETE AND THE NEW BEACON MUST BE OPERATIONAL BEFORE COMMENCING DEMOLITION ACTIVITIES.

- DEMOLITION NOTES:**
1. CONTRACTOR TO REMOVE TOP-MOST SECTION OF TOWER PRIOR TO REMOVING ANY GUY WIRES, IF APPLICABLE.
 2. REMOVE GUY WIRES AT HIGHEST ELEVATION PRIOR TO REMOVING ANY OTHER SETS OF GUYS.
 3. DEMOLITION OF THE TOWER SHALL CONSIST OF REMOVING ALL TOWER SECTIONS AT THE HIGHEST ELEVATIONS FIRST, UNTIL GUY WIRE LOCATIONS ARE ENCOUNTERED.
 4. CONTRACTOR IS RESPONSIBLE FOR TEMPORARY SUPPORTING THE STRUCTURE WHILE GUY WIRES ARE REMOVED.
 5. REMOVE GUY ONCE TOWER SECTIONS ABOVE THEM ARE REMOVED.
 6. REMOVE TOWER STRUCTURE IN ITS ENTIRETY, INCLUDING BUT NOT LIMITED TO, ITS BASE, BASE PLATE AND ANCHORS.
 7. COMPLETELY REMOVE ALL GUY ANCHORS FROM THEIR EXISTING LOCATIONS ONCE THE TOWER IS REMOVED. GUY ANCHORS ARE TO BE CUT AT ROCK SURFACE.
 8. CONTRACTOR IS RESPONSIBLE FOR THE COMPLETE REMOVAL AND DISPOSAL OF ALL TOWER ELEMENTS PROPERLY, INCLUDING PROPER LEAD PAINT REMOVAL IF APPLICABLE.

NOTE:
 PROPOSED GUY ANCHOR RADIUS TO BE DETERMINED BY TOWER MANUFACTURER. ANCHORS SHALL REMAIN WITHIN EXISTING EASEMENT, WHICH IS APPROXIMATELY 45 FEET FROM CENTERLINE OF PROPOSED TOWER.

EXISTING SITE STATISTICS

BEACON #	19
LOCATION	TREBO SCHOOL ROAD
PROPERTY OWNERS NAME	DONALD & LINDA HARTL
TOWN RECORDS BOOK & PAGE	55-358
ELEVATION AT TOP OF LIGHT	1302.1'
ELEVATION AT TOP OF TOWER	1299.5'
ELEVATION AT BASE OF TOWER	1207.4'
GUY 1A ATTACHMENT ELEVATION	1289.1'
GUY 1B ATTACHMENT ELEVATION	1249.2'
GUY 2A ATTACHMENT ELEVATION	1289.1'
GUY 2B ATTACHMENT ELEVATION	1249.2'
GUY 3A ATTACHMENT ELEVATION	1249.0'
GUY 3B ATTACHMENT ELEVATION	1289.1'
COMMENTS	TREES AT THIS SITE SEEM TO BE BETWEEN 10' & 15' LOWER THAN THE TOWER

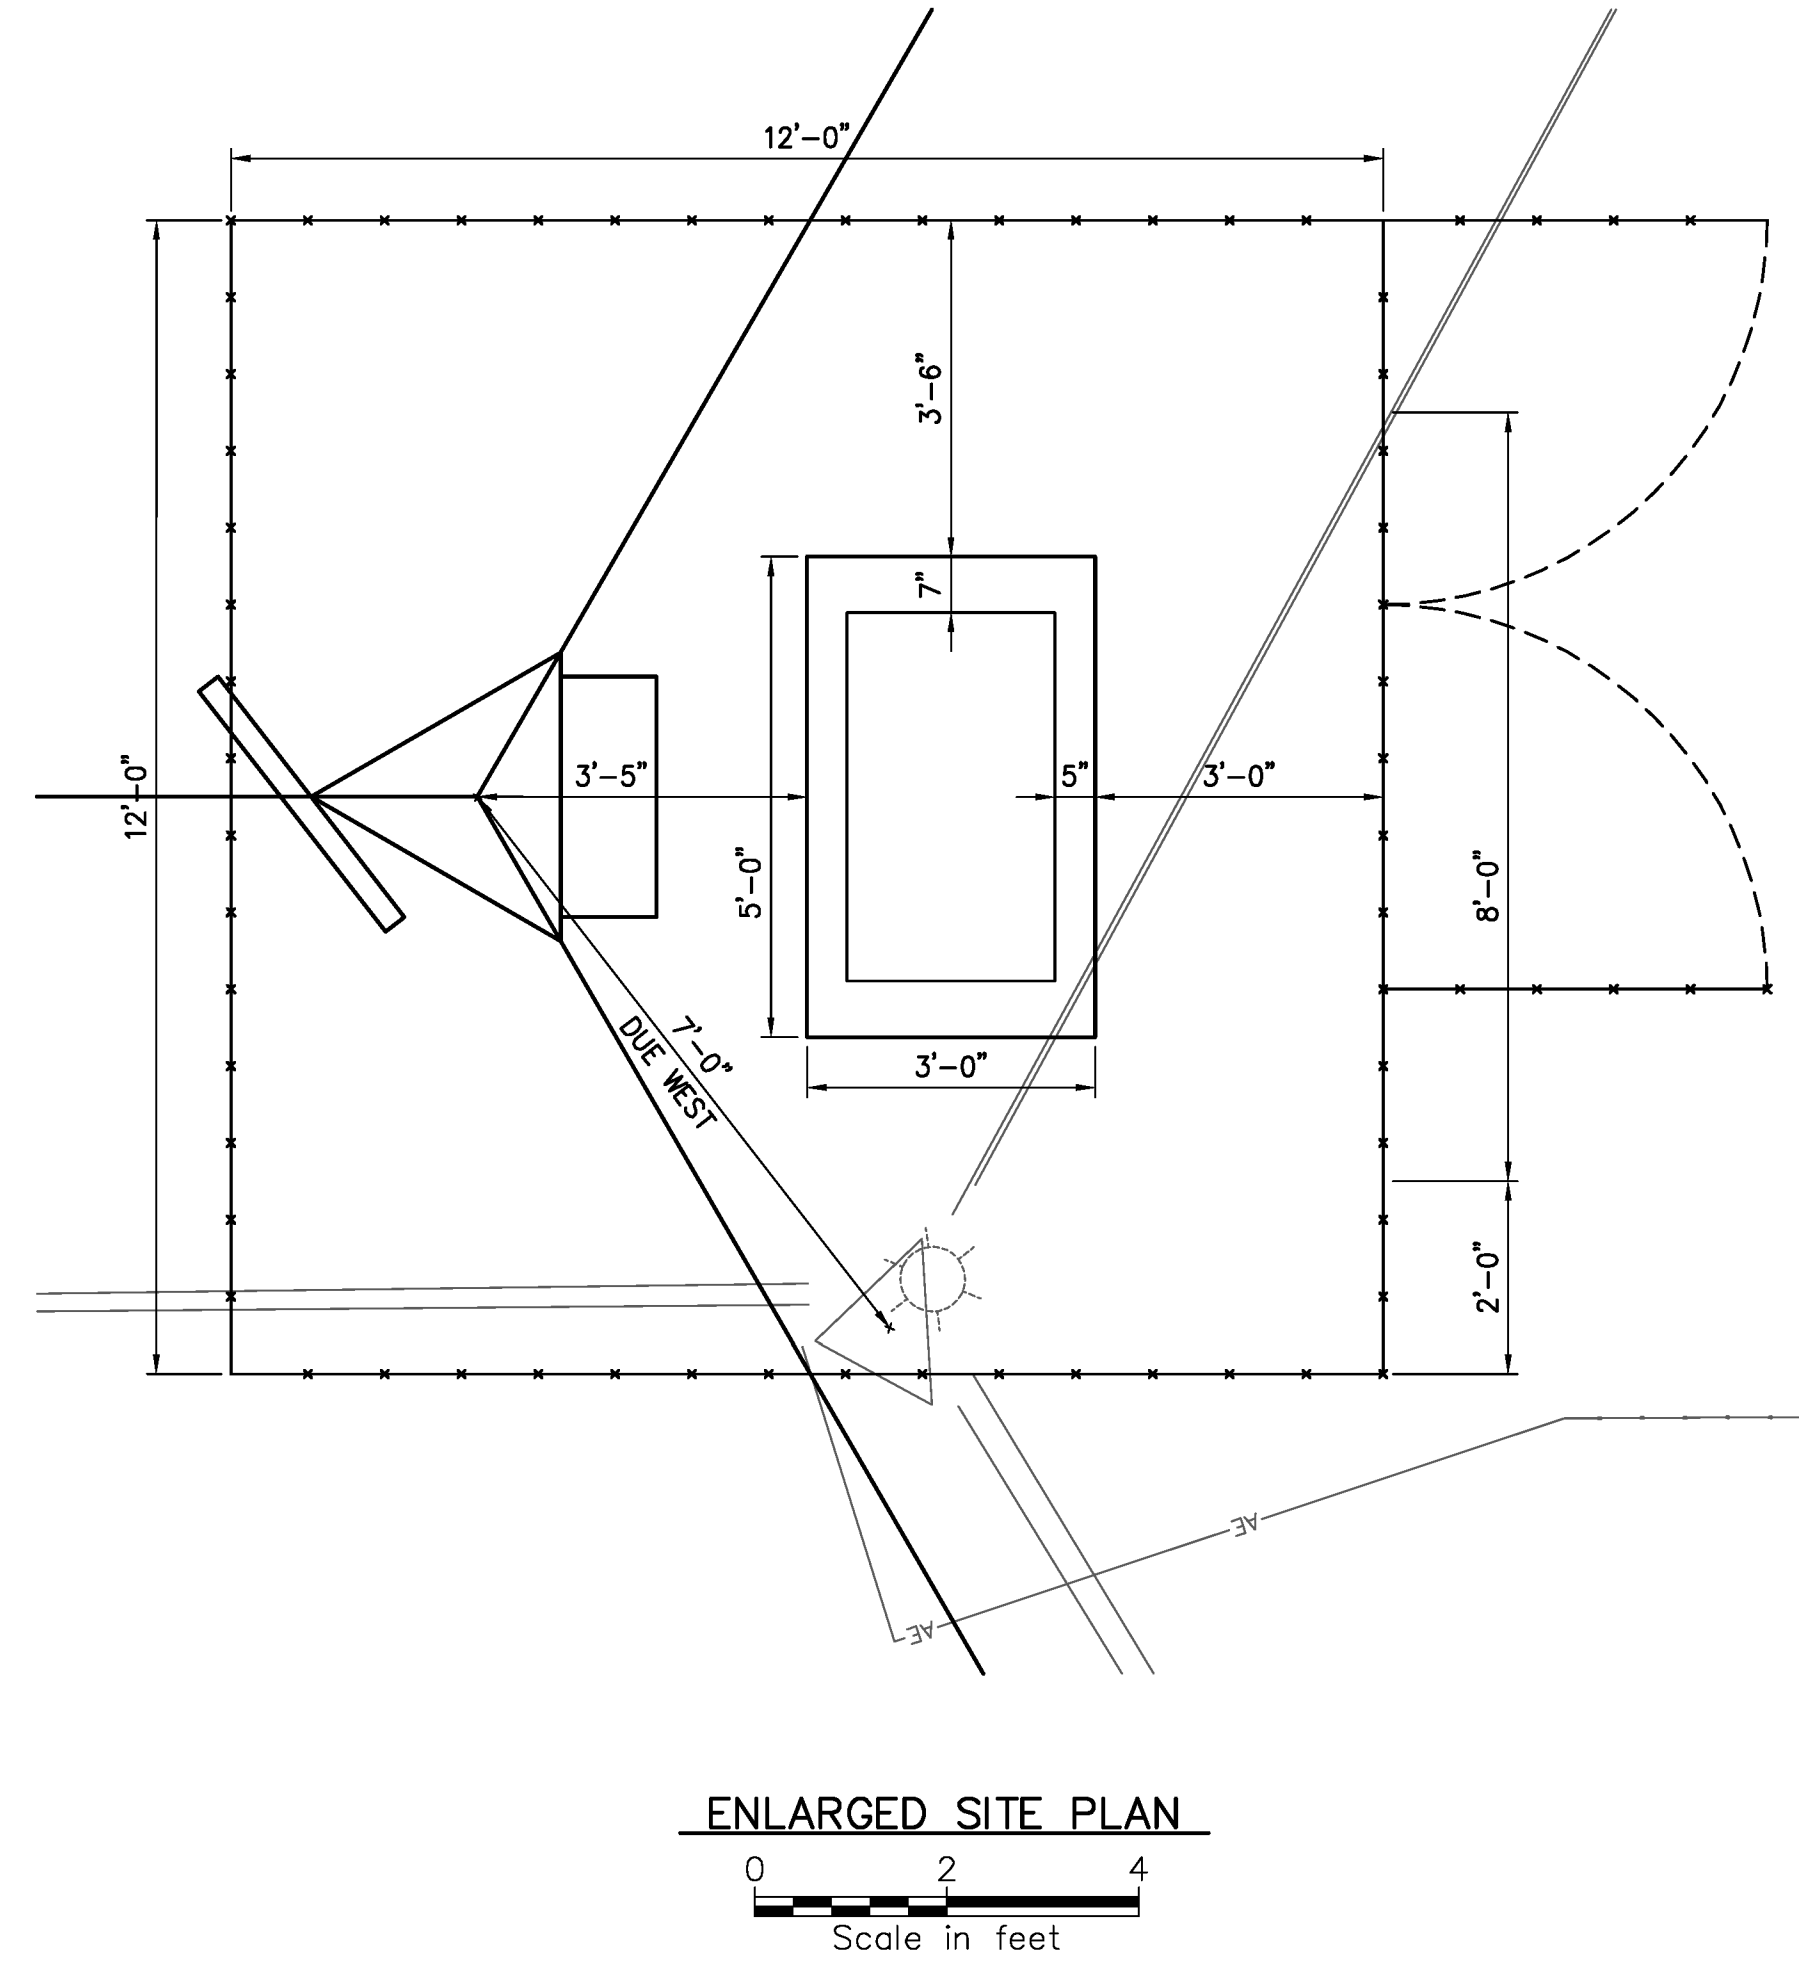

RECORD DRAWING 01/07/13

App'd By	Date
HAW HAW 04/11/11	
HAW HAW 05/19/11	
HAW HAW 06/10/11	
HAW HAW 07/07/13	
Submitted / Revision	
ADDED WETLAND BUFFER	
ADJUSTED WETLAND LIMITS	
REVISED PROPERTY OWNER	
RECORD DRAWINGS	

STATE OF VERMONT
 AGENCY OF TRANSPORTATION

Design Copyright © 2011
CHA
 III Winners Circle, PO Box 5089 - Albany, NY 12205-0289
 Main: (518) 453-4500 • www.chacompanies.com
 Design: HAW Drawn: HAW Checked: TYL
 AUTHORIZED ALTERATION OR ADDITION OF THIS DRAWING IS PROHIBITED UNLESS APPLICABLE STATE AND/OR LOCAL LAWS

HARTNESS STATE AIRPORT
 HAZARD BEACON REPLACEMENT
 BEACON 19 SITE PLAN
 Issue Date: 03/18/11 Project No.: 21674 Scale: As Shown

C-104

ABBREVIATIONS

A	AMPERE
AC	ALTERNATING CURRENT
AF	AMPERE FRAME
AFF/G	ABOVE FINISHED FLOOR/GRADE
AIC	AMPERE INTERRUPTING CAPACITY
AT	AMPERE TRIP
AUX	AUXILIARY
A/V	AUDIBLE/VISUAL
AWG	AMERICAN WIRE GAUGE
BB	BACKBOARD
BCW	BARE COPPER WIRE
BATT	BATTERY
BTM	BOTTOM
BKR	BREAKER
BLDG	BUILDING
C	CONDUIT
CAB	CABINET
CATV	COMMUNICATION ACCESS TELEVISION (CABLE TELEVISION)
CB	CIRCUIT BREAKER
CIR	CIRCUIT
CKT	CIRCUIT
CL	CENTER LINE
CO	COMPANY
COMM	COMMUNICATIONS
CONN	CONNECTION, CONNECT
CUH	CABINET UNIT HEATER
CT	CURRENT TRANSFORMER
CU	COPPER
CWA	CONSTANT WATTAGE AUTOTRANSFORMER
△	DELTA CONNECTION
D	DEEP
DB	DECIBEL
DET	DETECTOR
DIA	DIAMETER
DISC	DISCONNECT
DIST	DISTRIBUTION
DIV	DIVISION
DN	DOWN
DWG	DRAWING
EA	EACH
EBH	ELECTRIC BASEBOARD HEATER
EF	EXHAUST FAN
EL	ELEVATION
ELEC	ELECTRIC(AL)
EMER	EMERGENCY
ENCL	ENCLOSURE
EQUIP	EQUIPMENT
EWC	ELECTRIC WATER COOLER
EXT	EXTERIOR
F	FUSE(D)
FA	FIRE ALARM
FACP	FIRE ALARM CONTROL PANEL
FC	FOOTCANDLES
FIXT	FIXTURE
FLR	FLOOR
FLUOR	FLUORESCENT
FT	FOOT (FEET)
FUT	FUTURE

ABBREVIATIONS CON'T

G, GND	GROUND
GALV	GALVANIZE(D)
GC	GENERAL CONTRACTOR
GFI	GROUND FAULT CIRCUIT INTERRUPTER
GFP	GROUND FAULT PROTECTION
HD	HEAVY DUTY
HGT	HEIGHT
HID	HIGH INTENSITY DISCHARGE
HO	HIGH OUTPUT
HOA	HAND-OFF-AUTOMATIC
HP	HORSEPOWER
HPF	HIGH POWER FACTOR
HPS	HIGH PRESSURE SODIUM
HTR	HEATER
HV	HIGH VOLTAGE
HW	HOT WATER
ID	IDENTIFY, IDENTIFICATION
INCAND	INCANDESCENT
J-BOX	JUNCTION BOX
J.C.	JANITOR CLOSET
JCT	JUNCTION
KCM/Kcmil	THOUSAND CIRCULAR MILS
KVA	KILO VOLT AMPERE
KW	KILOWATT
LGT	LIGHTING
LT(S)	LIGHT(S)
LED	LIGHT EMITTING DIODE
L	LOUVER
MAX	MAXIMUM
MCB	MAIN CIRCUIT BREAKER
MFR	MANUFACTURER
MH	METAL HALIDE
MECH	MECHANICAL
MIN	MINIMUM
ML	MOTORIZED LOUVER
MLO	MAIN LUGS ONLY
MT	MOUNT
MTD	MOUNTED
MTR	MOTOR
N	NORTH
NEC	NATIONAL ELECTRICAL CODE
NF	NON-FUSED
NL	NIGHT LIGHT
No/#	NUMBER
NYSEG	NEW YORK STATE ELECTRIC & GAS COMPANY
OC	OVER COUNTER
OL	OVERLOAD
P	POLE(S)
PA	PUBLIC ADDRESS
PNL	PANEL
PR	PAIR
PRI	PRIMARY
PWR	POWER
∅	PHASE

ABBREVIATIONS CON'T

PT	PRESSURE TREATED
RECEPT	RECEPTACLE
RGS	RIGID GALVANIZED STEEL
RM	ROOM
SEC	SECONDARY
SH	SHIELDED
SPKR	SPEAKER
SW	SWITCH
TEMP	TEMPORARY/TEMPERATURE
T-STAT	THERMOSTAT
TB	TERMINAL BOARD
TYP	TYPICAL
UH	UNIT HEATER
UON	UNLESS OTHERWISE NOTED
V	VOLT, VOLTS
VA	VOLT-AMPERES
W	WATT, WIRE
W/	WITH
WP	WEATHERPROOF
XFMR/T	TRANSFORMER
Y	WYE CONNECTION

GENERAL

- ⊕ NUMBER IN CIRCLE, WITH OR WITHOUT ARROW OR LEADER, REFER TO MATCHING NUMBERED CODED NOTE
- ◇ NUMBER IN DIAMOND, WITH OR WITHOUT ARROW OR LEADER; REFER TO THE DEMOLITION CODED NOTE WITH THE MATCHING NUMBER
- ⊠ XXXX DETAIL CALLOUT

GENERAL NOTES

1. REFER TO CIVIL, STRUCTURAL, ARCHITECTURAL DRAWINGS FOR SYMBOLS ASSOCIATED WITH WORK, EQUIPMENT, ETC. BY OTHER(S).
2. ALL WORK SHOWN ON THE ELECTRICAL DRAWINGS SHALL BE BY THE ELECTRICAL CONTRACT UNLESS OTHERWISE INDICATED.
3. COORDINATE WORK WITH ALL TRADES.
4. CONDUIT RUNS SHOWN ARE DIAGRAMMATIC UNLESS OTHERWISE NOTED. EXACT LOCATION OF ALL CONDUIT RUNS SHALL BE DETERMINED IN THE FIELD. COORDINATE INSTALLATIONS AND AVOID CONFLICT WITH WORK BY OTHER TRADES.
5. GENERAL NOTES APPLY TO ALL CONTRACT DRAWINGS.

DEVICES AND APPURTENANCES

- ⊕ GROUND ROD 5/8" X 8'-0" COPPER CLAD OR GROUNDING PLATE SEE DETAIL ON CIVIL DWG CONTRACT
 - BONDING [USE HIGH COMPRESSION FITTINGS (BURNDY, MAC PRODUCTS) FOR "T" TAP, "C" TAP AND BUTT SPLICE]. PROVIDE EXOTHERMIC WELD WHERE POSSIBLE.
 - ☐ PHOTOCELL
- ONE LINE DIAGRAMS**
- ⊕ CONNECTED CONDUCTORS
 - ⊕ CROSSING OF CONDUCTORS NOT CONNECTED
 - ⊕ FUSE
 - ⊕ GROUNDING CONNECTION
 - ⊕ FUSED DISCONNECT SWITCH AND/OR BOLT PRESSURE SWITCH
 - ⊕ INDICATES EQUIPMENT ENCLOSURE
 - ⊕ FUSED DISCONNECT SWITCH

App'd By	Date
HAW HAW	01/07/13
Submitter / Revision	
RECORD DRAWINGS	
No.	

STATE OF VERMONT
AGENCY OF TRANSPORTATION


HARTNESS STATE AIRPORT
 HAZARD BEACON REPLACEMENT
 ELECTRICAL LEGEND & NOTES
 Issue Date: 03/18/11 | Project No.: 21674 | Scale: As Shown

CHA
 111 Winners Circle, PO Box 5089 - Albany, NY 12205-0289
 Main: (518) 453-4500 • www.chacompanies.com


Design: NUB | Drawn: CJE | Checked: NUB
 AUTHORIZED ALTERATION OR ADDITION
 WITHOUT THE SIGNATURE OF THE ORIGINAL DESIGNER IS PROHIBITED
 APPLICABLE STATE AND/OR LOCAL LAWS

RECORD DRAWING 01/07/13


E-001

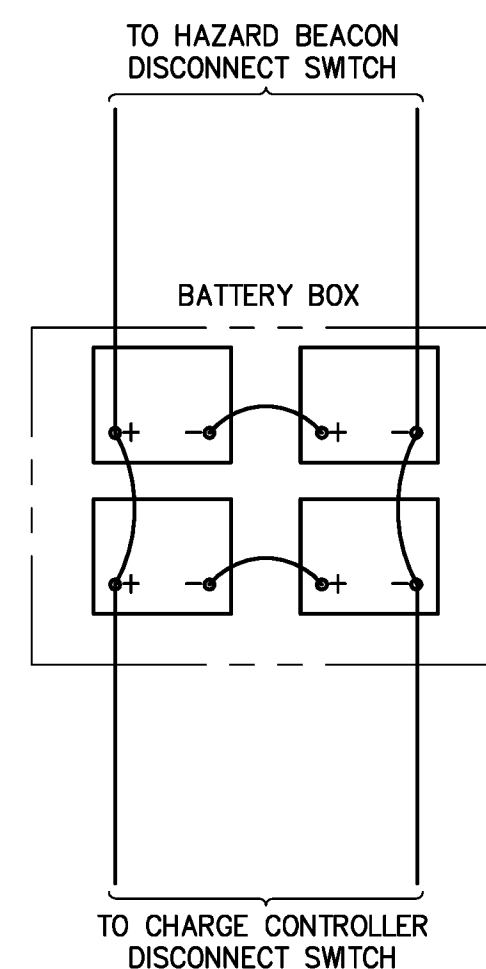

1 BATTERY WIRING DIAGRAM
- NOT TO SCALE

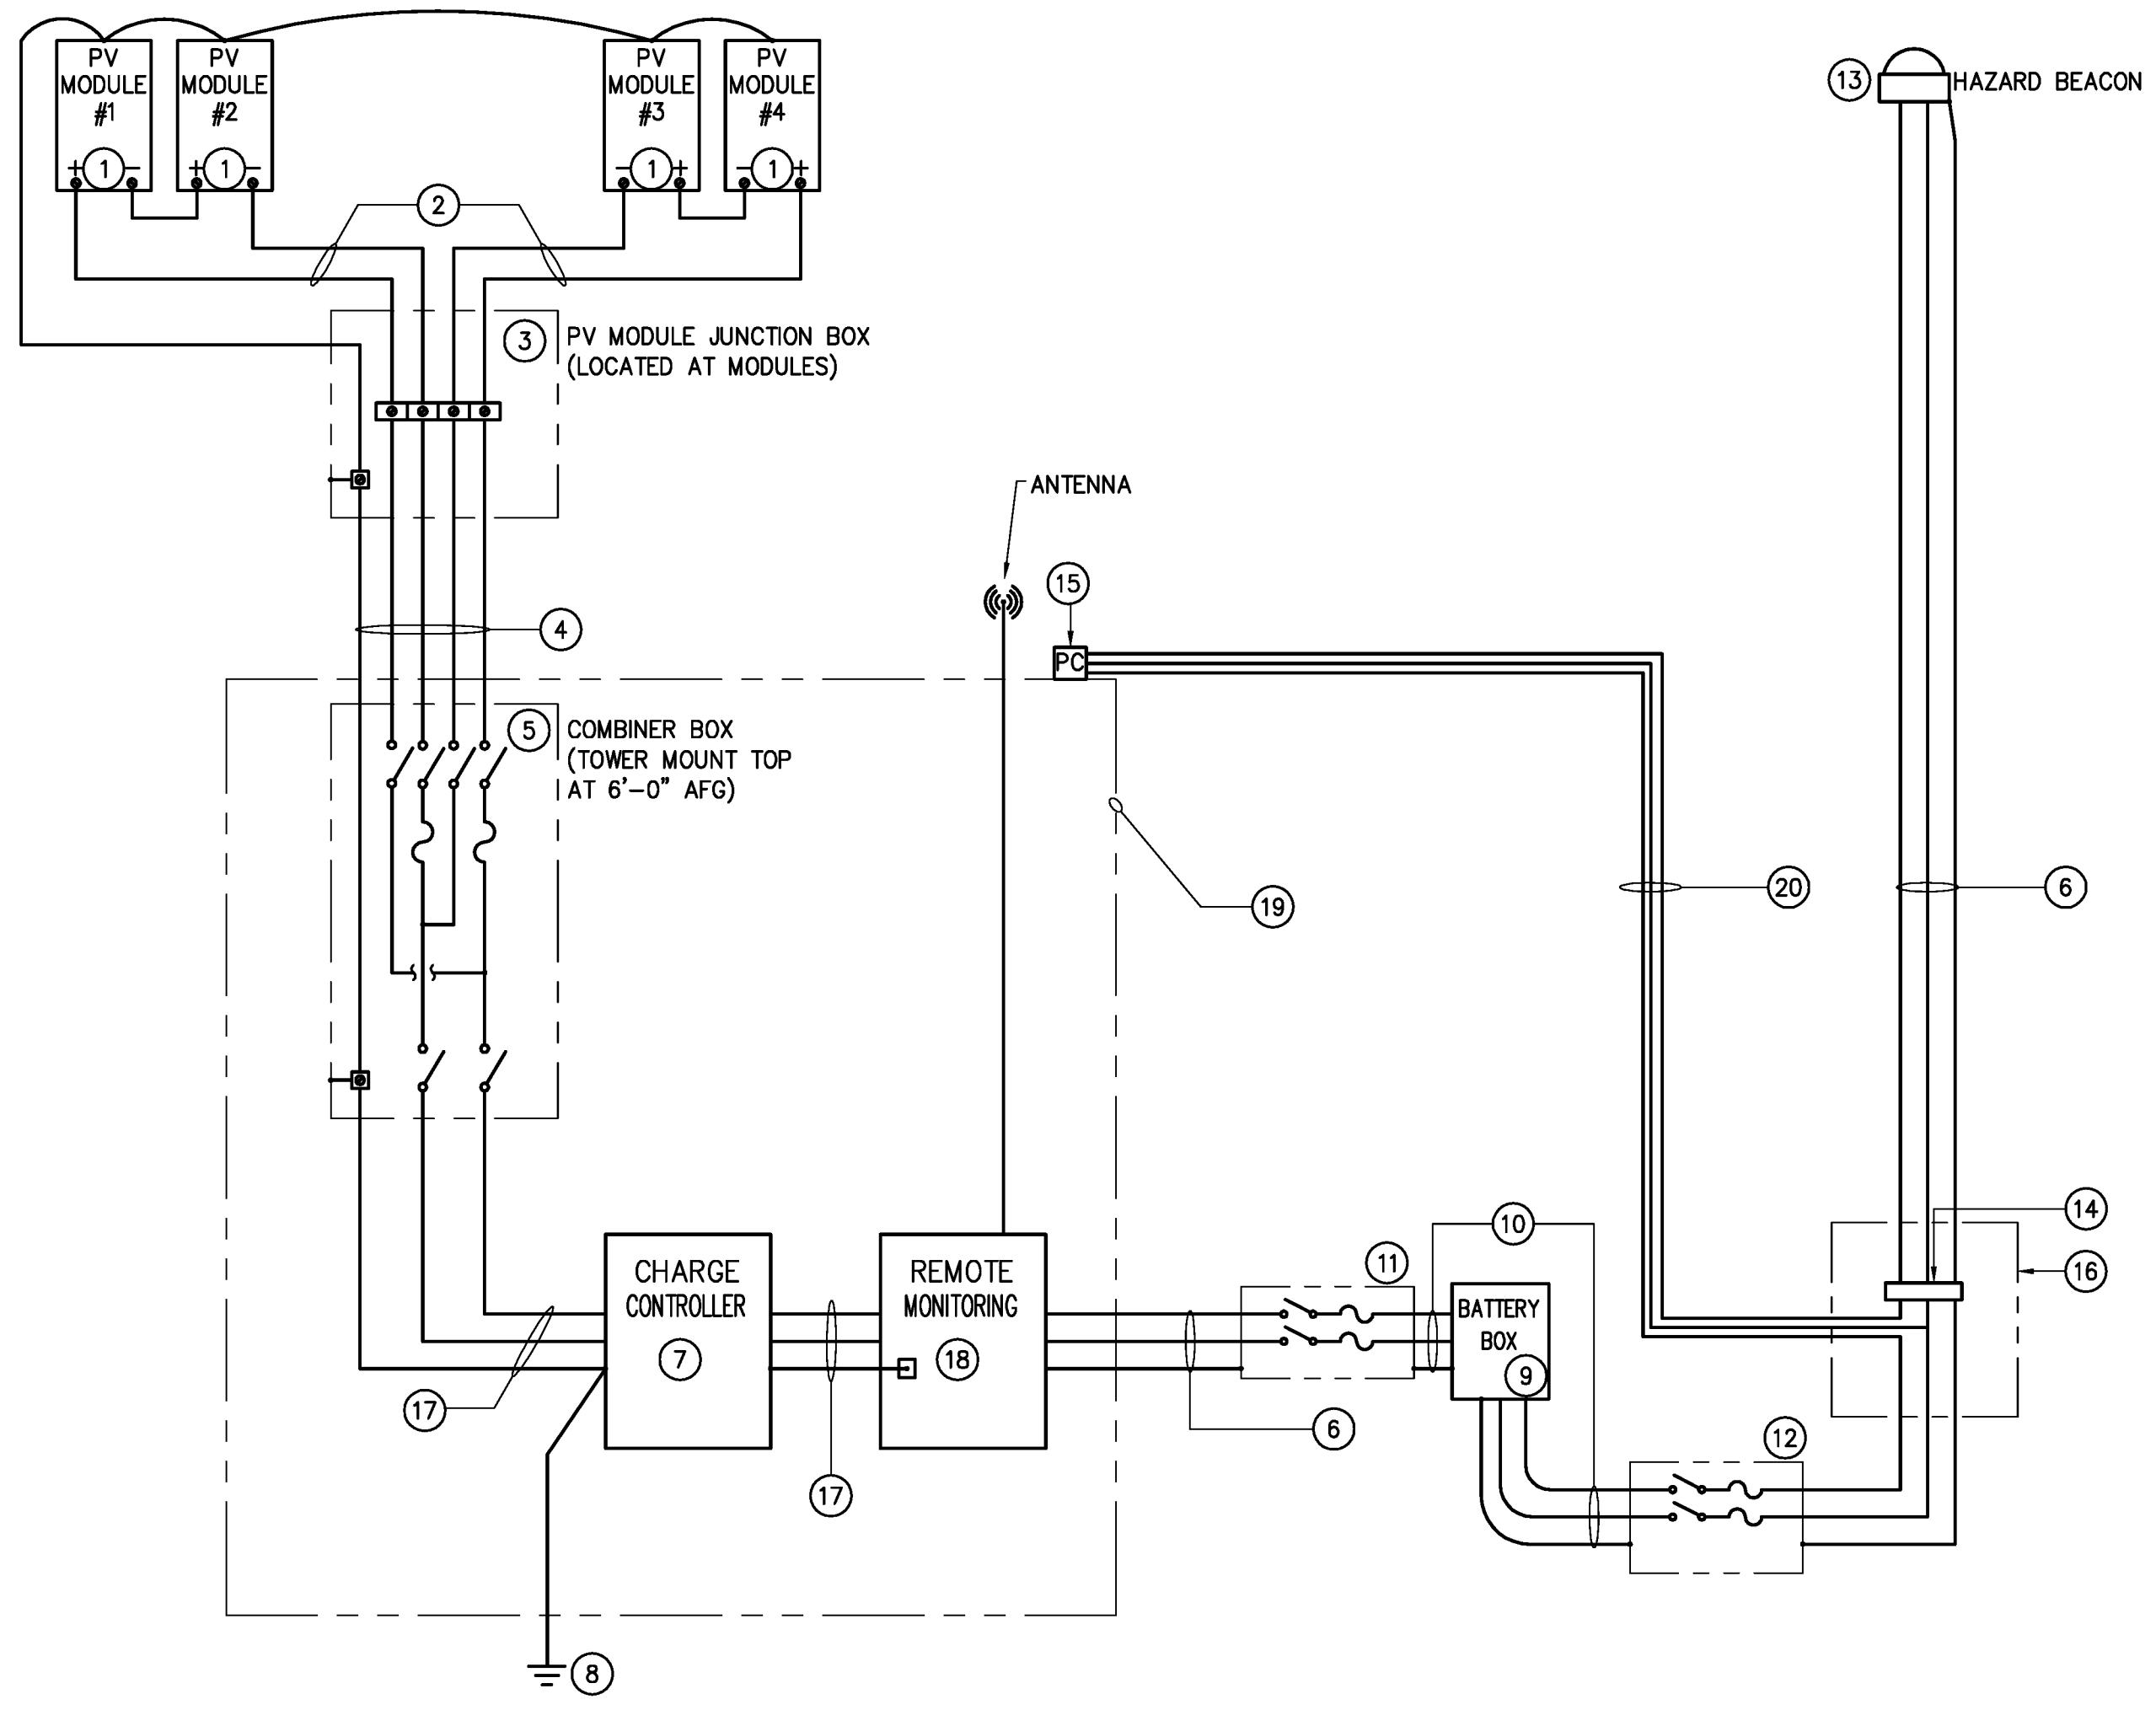

2 PHOTOVOLTAIC SYSTEM - 4 PANEL SCHEMATIC TOWERS 17, 18, 19
- NOT TO SCALE

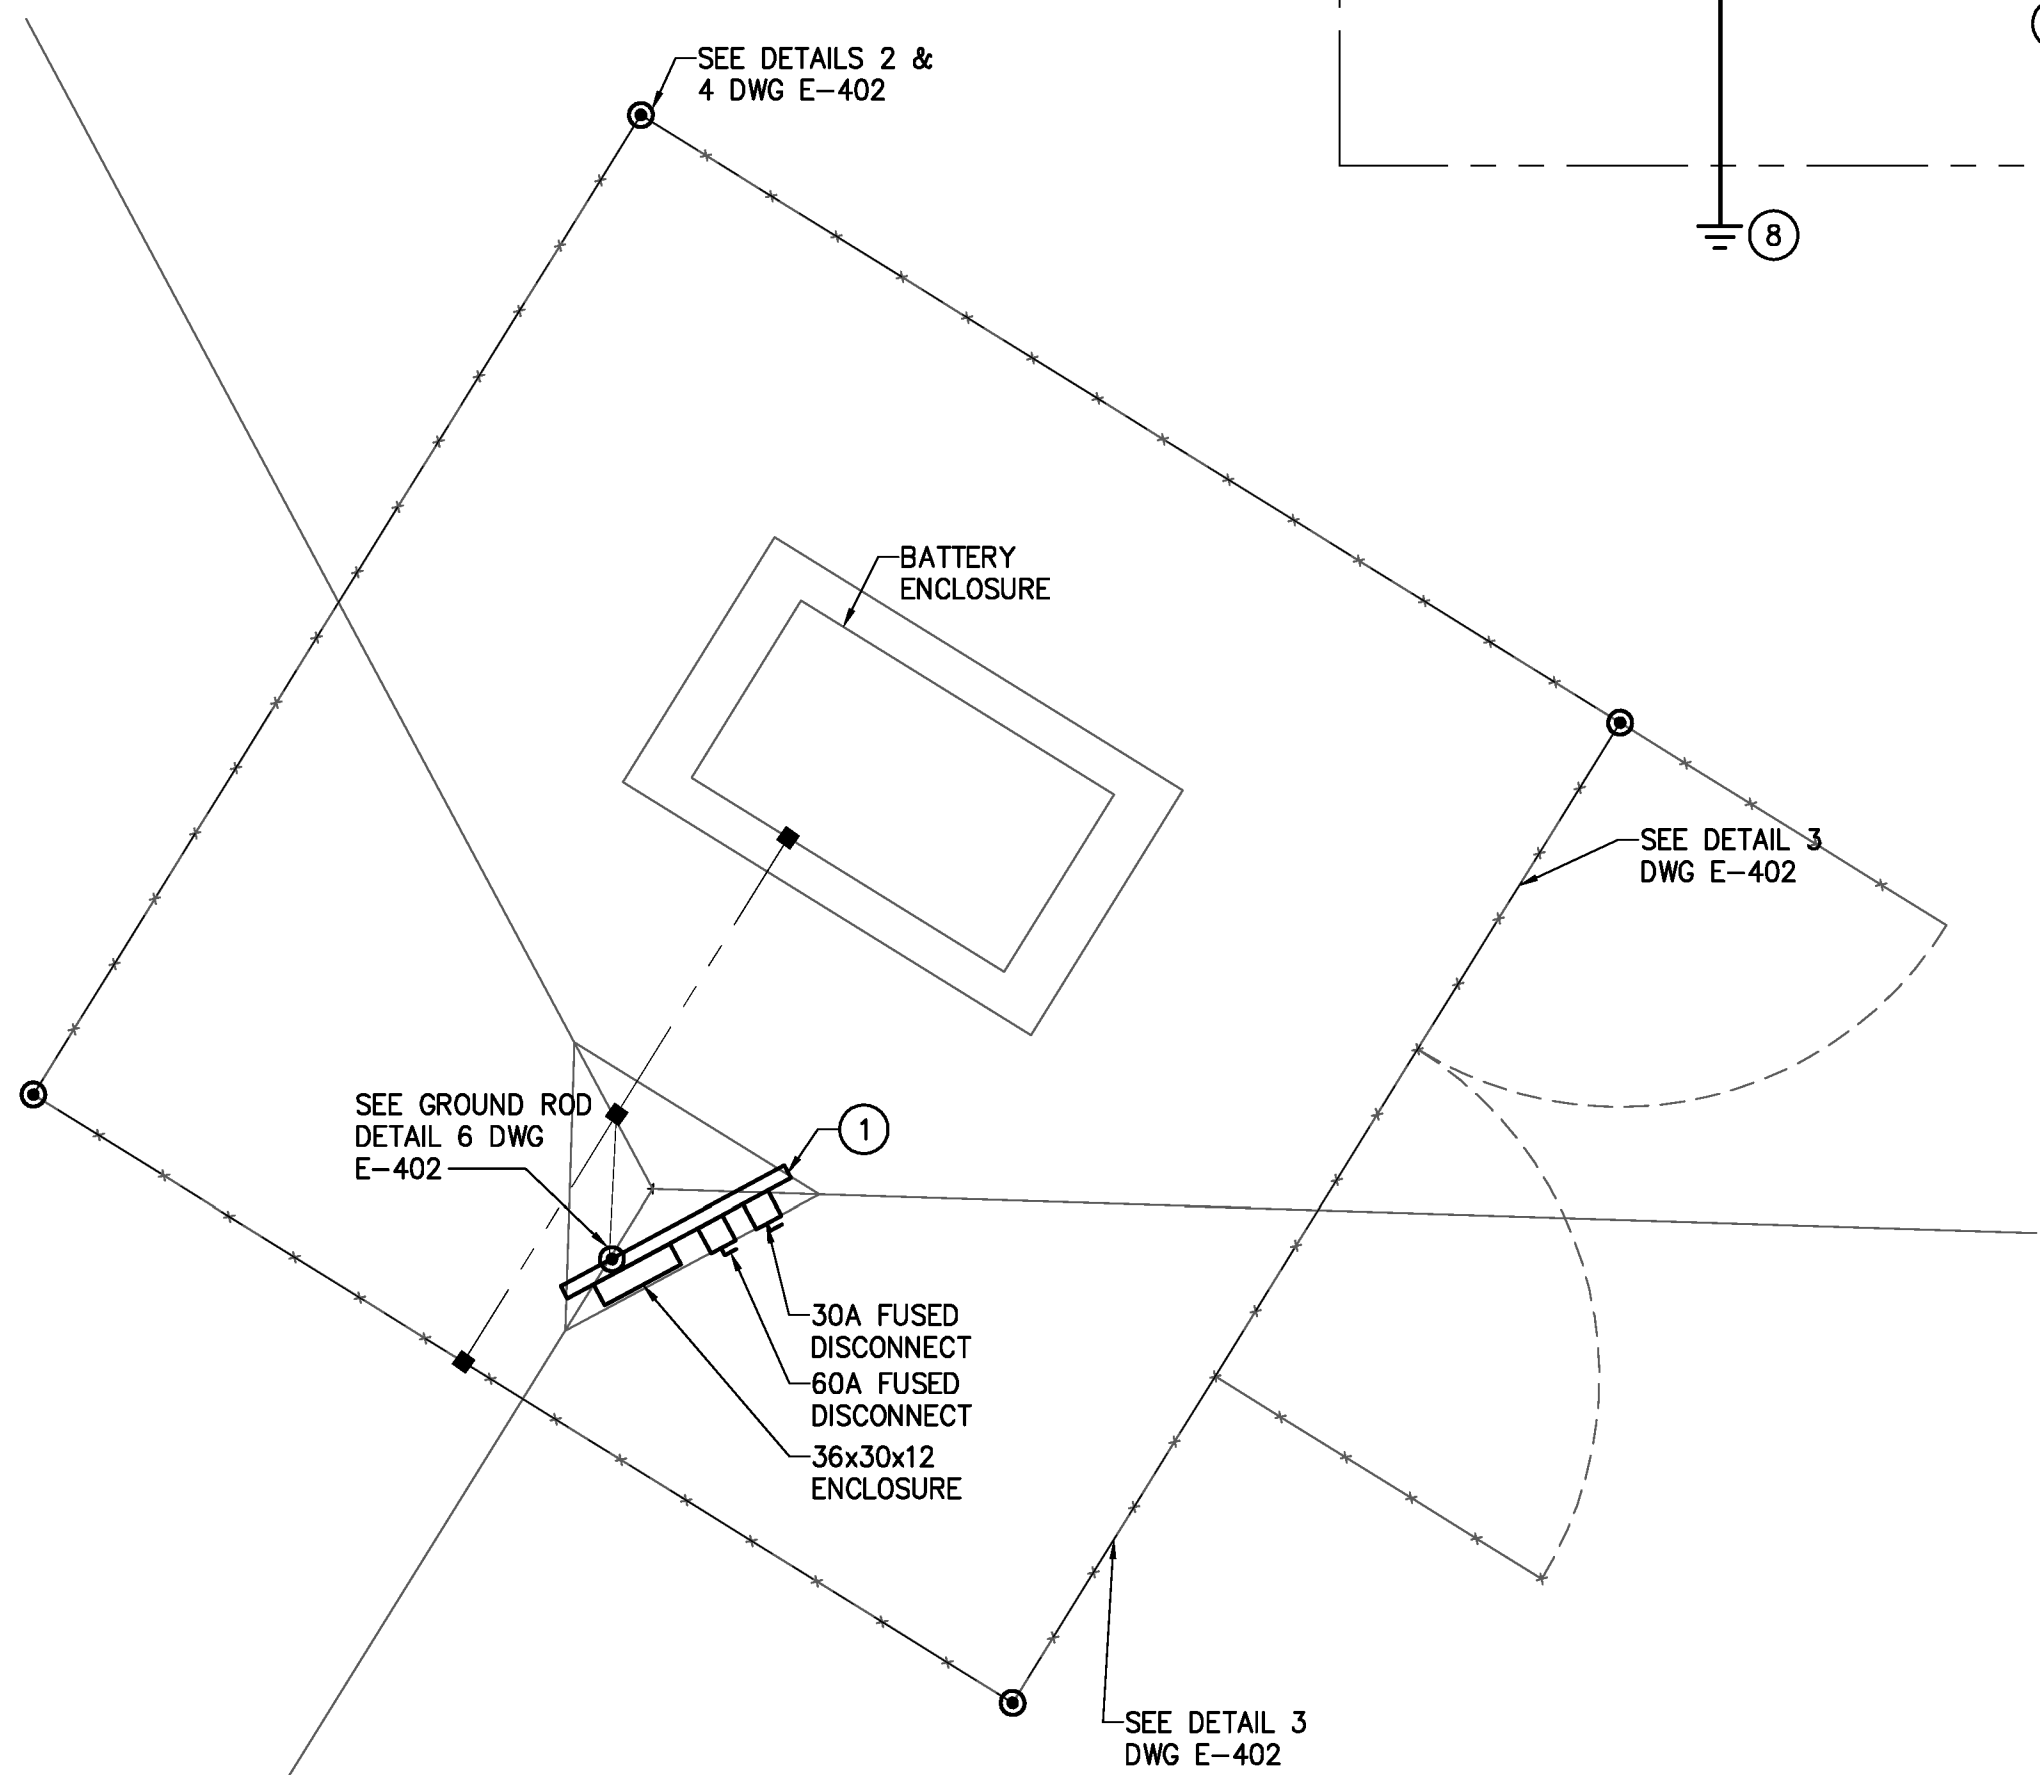

3 TYPICAL ELECTRICAL PLAN VIEW
- SCALE 1/2" = 1'-0"

GENERAL NOTES
A. SEE DETAIL 5 ON DWG E-402 FOR GUYED ANCHOR AND TOWER GROUNDING.
B. WHERE ROCK IS ENCOUNTERED PROVIDE GROUNDING PLATE IN LIEU OF GROUNDING ROD.

CODED NOTES
① PROVIDE STEEL CHANNEL AND METAL FABRICATION BACKBOARD MOUNTING AT TOWER 6'-0" AFG TO TOP. CUTTING DRILLING AND WELDING TOWER IS PROHIBITED.

GENERAL NOTES
A. ALL EQUIPMENT SUCH AS BUT NOT LIMITED TO DISCONNECT, ALL ENCLOSURE SHALL HAVE A LOCK-OUT/TAG-OUT OPTION.
B. USE RGS CONDUIT UNLESS OTHERWISE NOTED.
C. CUTTING, DRILLING AND WELDING TOWER IS PROHIBITED.
D. REMOTE MONITORING SHALL INCLUDE BUT NOT LIMITED TO CELLULAR MODEM, DATA ACQUISITION, DIN RAIL MOUNT AND WIRELESS ANTENNA.

CODED NOTES
① PROVIDE PV MODULES (KYOCERA#KD205GX-LPU OR APPROVED EQUAL) AND ALUMINUM SIDE OF POLE MOUNTING SYSTEM. MODULES SHALL BE ARRANGED IN A 2x2 PATTERN. TILT ANGLE SET TO 90° VERTICAL. MOUNTING SYSTEM SHALL BE PROVIDED WITH A 140 MPH WIND LOADING CAPACITY WITH MODULES INSTALLED.
② PROVIDE #8 USE-2 CONDUCTORS NOT EXCEEDING 10'-0" IN TOTAL LENGTH. SECURE CONDUCTORS TO AVOID WIND AND WEATHER DAMAGE.
③ PROVIDE 8"x8"x4" NEMA 4X JUNCTION BOX WITH INTERNAL MOUNTING PLATE, POWER DISTRIBUTION BLOCKS (SQ.D.#BC 162101 OR APPROVED EQUAL) WITH INSULATING COVER, AND GROUNDING LUG. MOUNT ADJACENT TO PV MODULES.
④ PROVIDE (4)#6 THWN-2, (1)#6G THWN-2 IN 1-1/2" RGS CONDUIT WITH HANGERS, SUPPORTS, CLAMPS, ETC. AS REQUIRED.
⑤ PROVIDE DISCONNECT COMBINER BOX (SOLARBOS #CS28-04-15-4XF OR APPROVED EQUAL) WITH 15 AMP DCV RATED FUSES AND GROUNDING LUG. MOUNT COMBINER BOX INSIDE ENCLOSURE.
⑥ PROVIDE (2)#6 THWN-2, (1)#6G THWN-2 IN 1-1/2" RGS CONDUIT WITH HANGERS, SUPPORTS, CLAMPS, ETC. AS REQUIRED.
⑦ PROVIDE CHARGE CONTROLLER (TRISTAR MPPT-60 CONTROLLER OR APPROVED EQUAL). MOUNT CONTROLLER INSIDE ENCLOSURE.
⑧ PROVIDE PV SYSTEM NEGATIVE GROUNDING WITH #8 THWN-2 AND (1) 3/4"x10' COPPER CLAD GROUND ROD. GROUND ROD SHALL BE DRIVEN TO A DEPTH OF 2'-0" BELOW FINISH GRADE AND CONNECTION SHALL BE MADE BY EXOTHERMIC METHODS. WHEN ENCOUNTERED WITH BEDROCK USE GROUND PLATE. SEE DETAIL 4 ON DWG E-402.
⑨ PROVIDE (1) 26"x46"x16" NON-INSULATED, VENTILATED CHEST STYLE BATTERY ENCLOSURES (POWER FAB# BB4-BG8D OR APPROVED EQUAL) SET ON APPROPRIATELY SIZED PRECAST CONCRETE PAVERS, AND (4) 12VDC, 258 AHR BATTERIES (SUN XTENDER # PVX-25BOL OR APPROVED EQUAL). INSTALL (4) BATTERIES IN BOX. CONNECT BATTERIES IN (2) SERIES/PARALLEL STRINGS. SEE BATTERY WIRING DIAGRAM ON THIS DRAWING.
⑩ PROVIDE (2)#6 THWN-2, (1)#6G THWN-2 IN 1-1/2" LFMC NOT EXCEEDING 6'-0".
⑪ PROVIDE 2 POLE, 60 AMP, 250 VOLT, HEAVY DUTY, FUSIBLE, NEMA 4X, DC RATED DISCONNECT SWITCH WITH 60 AMP DCV RATED FUSES AND PERMANENT LABEL WHICH READS: "WARNING ELECTRIC SHOCK HAZARD. DO NOT TOUCH TERMINALS. TERMINALS ON BOTH THE LINE AND LOAD SIDES MAY BE ENERGIZED IN THE OPEN POSITION." MOUNT ON TOWER AT 6'-0" AFG.
⑫ PROVIDE 2 POLE, 30 AMP, 250 VOLT, HEAVY DUTY, FUSIBLE, NEMA 4X, DC RATED DISCONNECT SWITCH WITH 6 AMP DCV RATED FUSES. MOUNT ON TOWER AT 6'-0" AFG.
⑬ PROVIDE EXISTING HAZARD BEACON AND PROVIDE FAA APPROVED LED HAZARD BEACON (FARLIGHT NY-1864LED-DM-24D-GPS-AK OR APPROVED EQUAL). POWER CONSUMPTION EQUAL LESS THAN 10W (AVERAGE) SET HAZARD BEACON TO OPERATE IN THE FLASHING MODE.
⑭ PROVIDE SURGE PROTECTION DEVICE MANUFACTURED BY PHOENIX CONTACT [MODEL NO. PT2+1-S-48DC] FOR 24-48 VDC SYSTEM.
⑮ PROVIDE LOW VOLTAGE OUTDOOR [UL LISTED WET LOCATION] RATED FAA APPROVED [6390/6587C/6589C RATED FOR 24VDC NOMINAL] PHOTOCELL ON HOFFMAN ENCLOSURE FOR EASE OF REPAIR AND PER OWNERS DIRECTION. COORDINATE EXACT LOCATION AT FIELD. PROVIDE 3/4" RGS CONDUIT FOR WIRING. REFER TO WIRING DIAGRAM IN FARLIGHT'S LED BEACON MANUAL.
⑯ PROVIDE NEMA ENCLOSURE, 4"x4"x2" FOR "DIN" RAIL MOUNT OF SURGE PROTECTION DEVICE MANUFACTURED BY PHOENIX CONTACT.
⑰ PROVIDE (2)#6 THWN-2, (1)#6G THWN-2 WITH APPROPRIATE MOUNTING CLAMPS INSIDE THE NEMA 4X ENCLOSURE. MAINTAIN TURN RADIUS PER LATEST NEC AND WIRE MANUFACTURER'S REQUIREMENTS.
⑱ PROVIDE CAT6 (PLENUM RATED) WITH RJ-45 TERMINATIONS ON EACH END BETWEEN CHARGE CONTROLLER AND MODEM FOR ETHERNET CONNECTION. MOUNT INSIDE ENCLOSURE. CONTACT NORTHMARK COMMUNICATIONS, DAVE COLTER, TELEPHONE: (603)763-4982 OR (603)763-4976, EMAIL: NORTHMARK@MYFAIRPOINT.NET.
⑳ PROVIDE (2)#6 THWN-2, (1)#6G THWN-2 IN 1-1/2" RGS CONDUIT WITH HANGERS, SUPPORTS, CLAMPS, ETC AS REQUIRED.

File: V:\PROJECTS\NYA\21674\CADD\CADD\SHEET_FILES\E401-21674.DWG
Saved: 1/4/2013 4:22:12 PM Plotted: 1/4/2013 4:30:44 PM User: Wjyd, Heather LostSvedBy: 2789

Submitted / Revision	Date
RECORD DRAWINGS	01/07/13

STATE OF VERMONT
AGENCY OF TRANSPORTATION

UNAUTHORIZED ALTERATION OR ADDITION OF ANY INFORMATION IS PROHIBITED AND IS A VIOLATION OF APPLICABLE STATE AND/OR LOCAL LAWS

III Winners Circle, PO Box 5089 - Albany, NY 12205-0289
Main: (518) 453-4500 • www.chacompanies.com

Designed: NUB | Drawn: CJE | Checked: NUB


HARTNESS STATE AIRPORT
HAZARD BEACON REPLACEMENT

ELECTRICAL DETAILS

Issue Date: 03/18/11 | Project No.: 21674 | Scale: As Shown

RECORD DRAWING 01/07/13

E-401

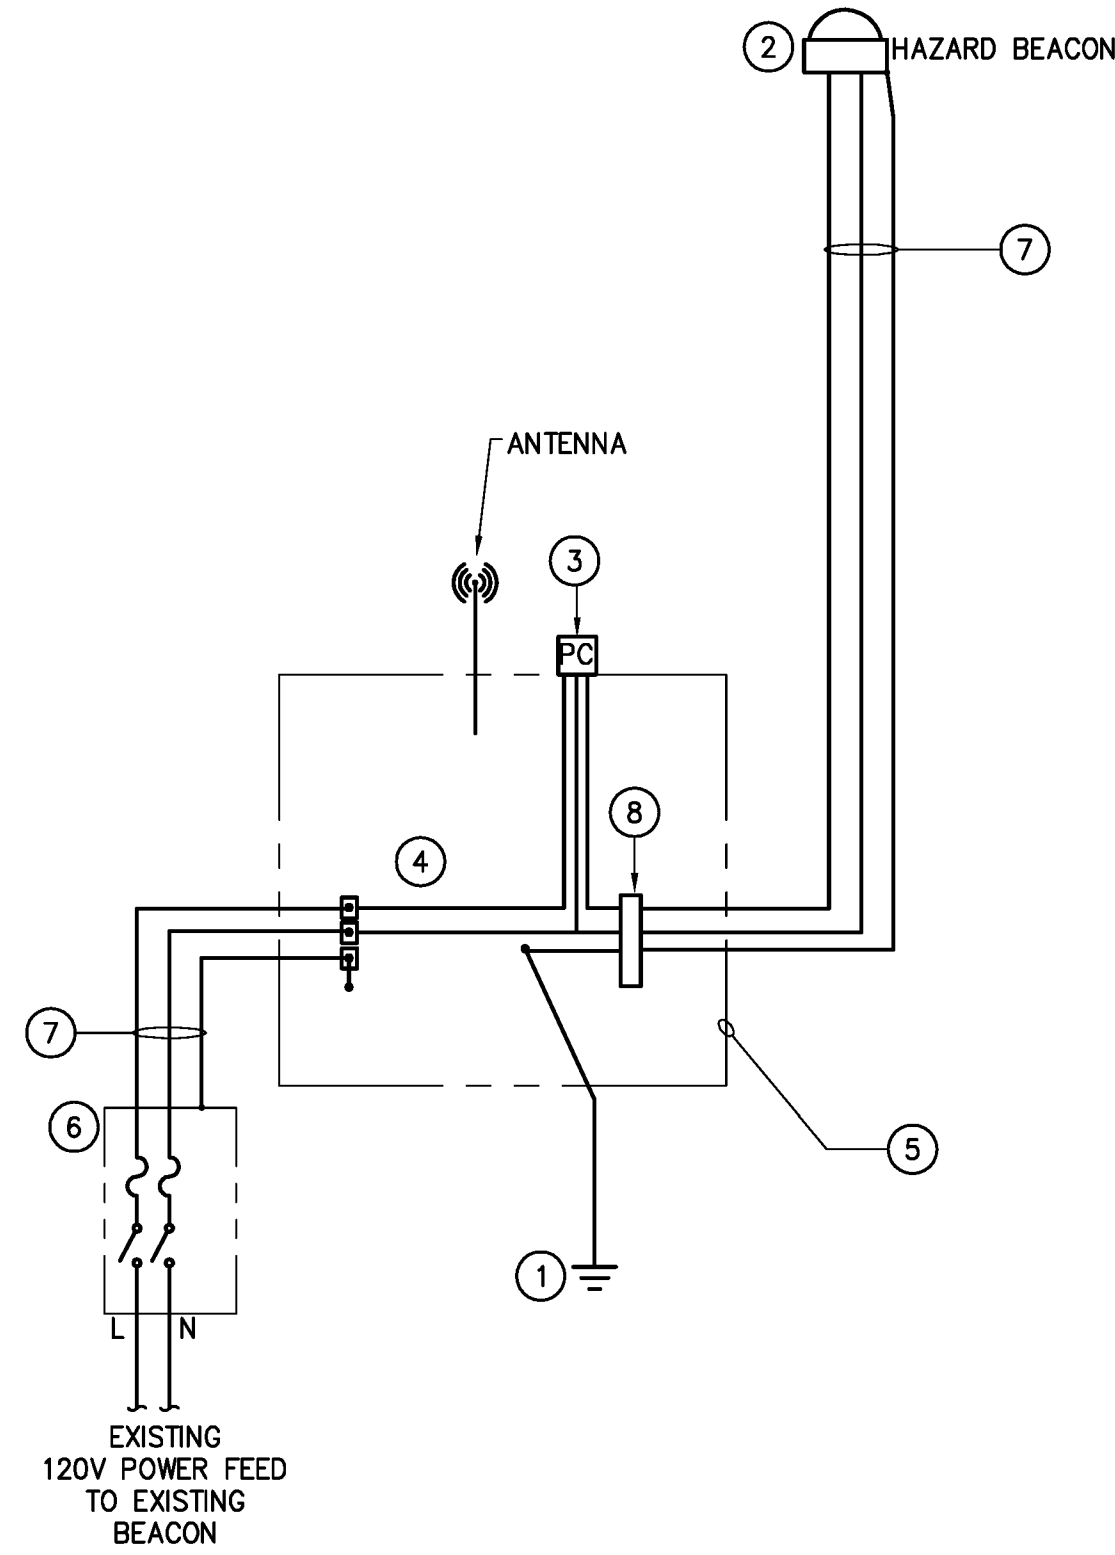


1 LED BEACON WITH REMOTE MONITORING-TOWER 1
- NOT TO SCALE

GENERAL NOTES


- A. ALL EQUIPMENT SUCH AS BUT NOT LIMITED TO DISCONNECT, ENCLOSURE SHALL HAVE A LOCK-OUT/TAG-OUT OPTION.
- B. USE RGS CONDUIT UNLESS OTHERWISE NOTED.
- C. CUTTING, DRILLING AND WELDING TOWER IS PROHIBITED.

CODED NOTES

- ① PROVIDE GROUNDING WITH #8 THWN-2 AND (1) 5/8"x10' COPPER CLAD GROUND ROD. GROUND ROD SHALL BE DRIVEN TO A DEPTH OF 2'-0" BELOW FINISH GRADE AND CONNECTION SHALL BE MADE BY EXOTHERMIC METHODS WHEN ENCOUNTERED WITH BEDROCK USE GROUND PLATE. SEE DETAIL 4 ON THIS DRAWING.
- ② REMOVE EXISTING HAZARD BEACON AND PROVIDE FAA APPROVED LED HAZARD BEACON (FARLIGHT NY-L864LED-DM-120A-GPS-AK OR APPROVED EQUAL). POWER CONSUMPTION EQUAL LESS THAN 10W (AVERAGE). SET HAZARD BEACON TO OPERATE IN THE FLASHING MODE.
- ③ PROVIDE LOW VOLTAGE OUTDOOR [UL LISTED WET LOCATION] RATED FAA APPROVED 6390 PHOTOCELL ON ENCLOSURE FOR EASE OF REPAIR AND PER OWNERS DIRECTION. COORDINATE EXACT LOCATION AT FIELD. REFER TO WIRING DIAGRAM IN FARLIGHT'S LED BEACON MANUAL.
- ④ PROVIDE REMOTE MONITORING SYSTEM. COMPLETE SYSTEM SHALL INCLUDE BUT NOT LIMITED TO POWER SUPPLY (24VDC), CELLULAR MODEM, DAQ, LIGHT TEST SWITCH AND COMMISSIONING OF SYSTEM TO OWNER. CONTACT NORTHMARK COMMUNICATIONS, DAVE COLTER, TELEPHONE: (603)763-4962 OR (603)763-4976, EMAIL: NORTHMARK@MYFAIRPOINT.NET.
- ⑤ PROVIDE NEMA 4X ENCLOSURE (HOFFMAN A24H2412SS6LP OR APPROVED EQUAL) WITH INTEGRAL MOUNTING PLATE (HOFFMAN A24P24SS6) AND (2) FILTERED VENTILATION LOUVERS. LOCATE LOUVERS ON BOTTOM OF ENCLOSURE ONE ON EACH SIDE (HOFFMAN AVK44 OR APPROVED EQUAL) AND (2) RAIN SHROUD (HOFFMAN SH090005H OR APPROVED EQUAL). MOUNT ASSEMBLY ON TOWER AT 6'-0" AFG.
- ⑥ PROVIDE 2 POLE, 30A RATED, 250V RATED, HEAVY DUTY, FUSIBLE NEMA 4X SAFETY SWITCH WITH 2A FUSE.
- ⑦ PROVIDE (2) #8 THWN-2, (1) #8G THWN-2 IN 1" RGS CONDUIT WITH HANGERS, SUPPORTS, CLAMPS, ETC. AS REQUIRED.
- ⑧ PROVIDE SURGE PROTECTION DEVICE MANUFACTURED BY PHOENIX CONTACT (MODEL NO. PT-2-PE/S-120AC) FOR 120V AC SYSTEM.

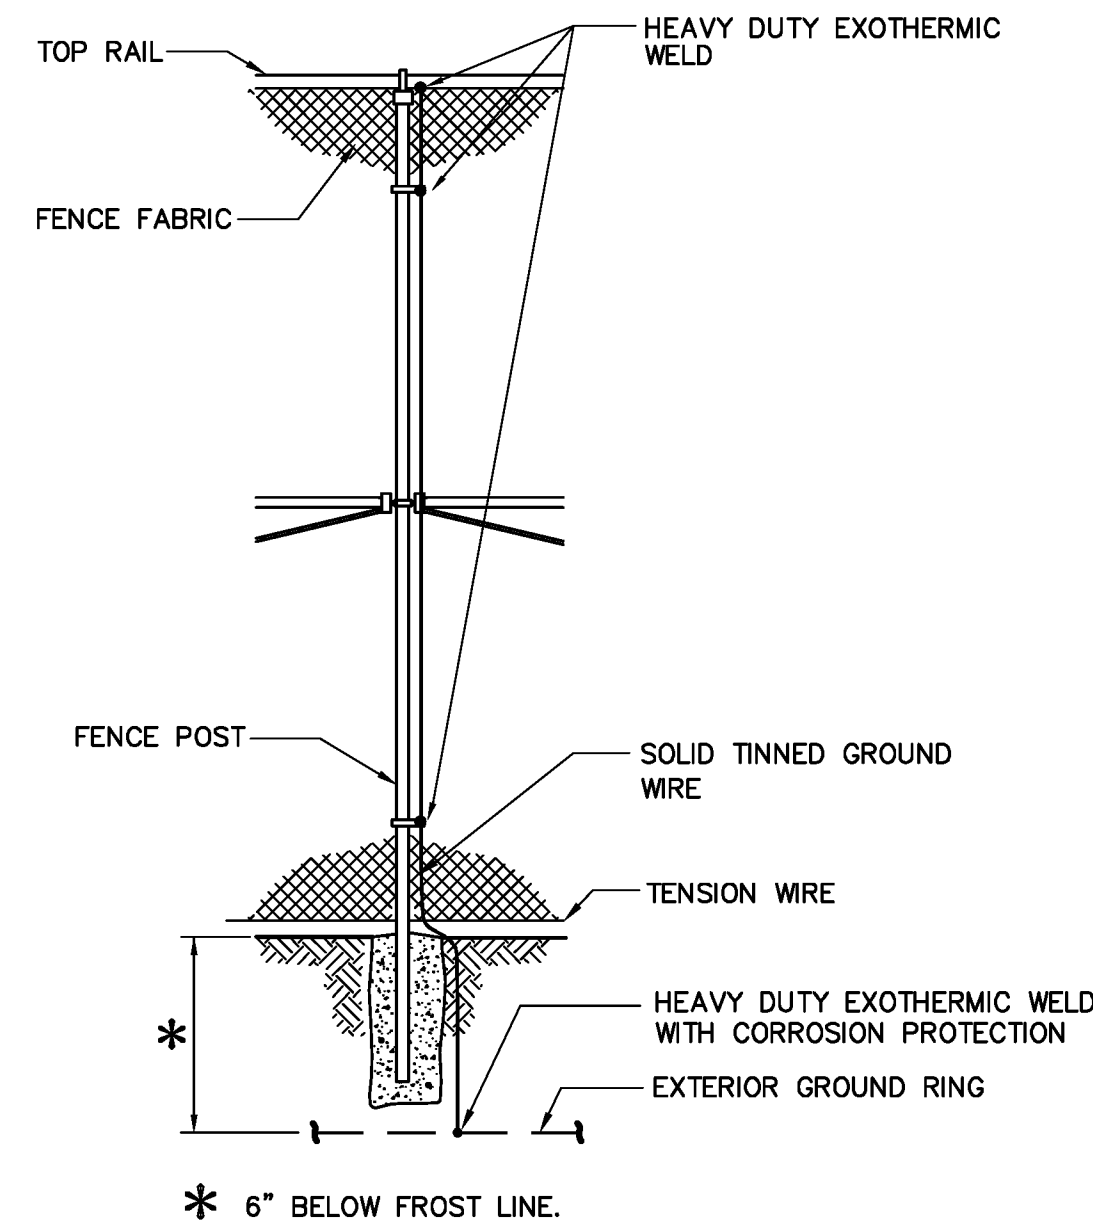


2 FENCE GROUNDING
- NOT TO SCALE

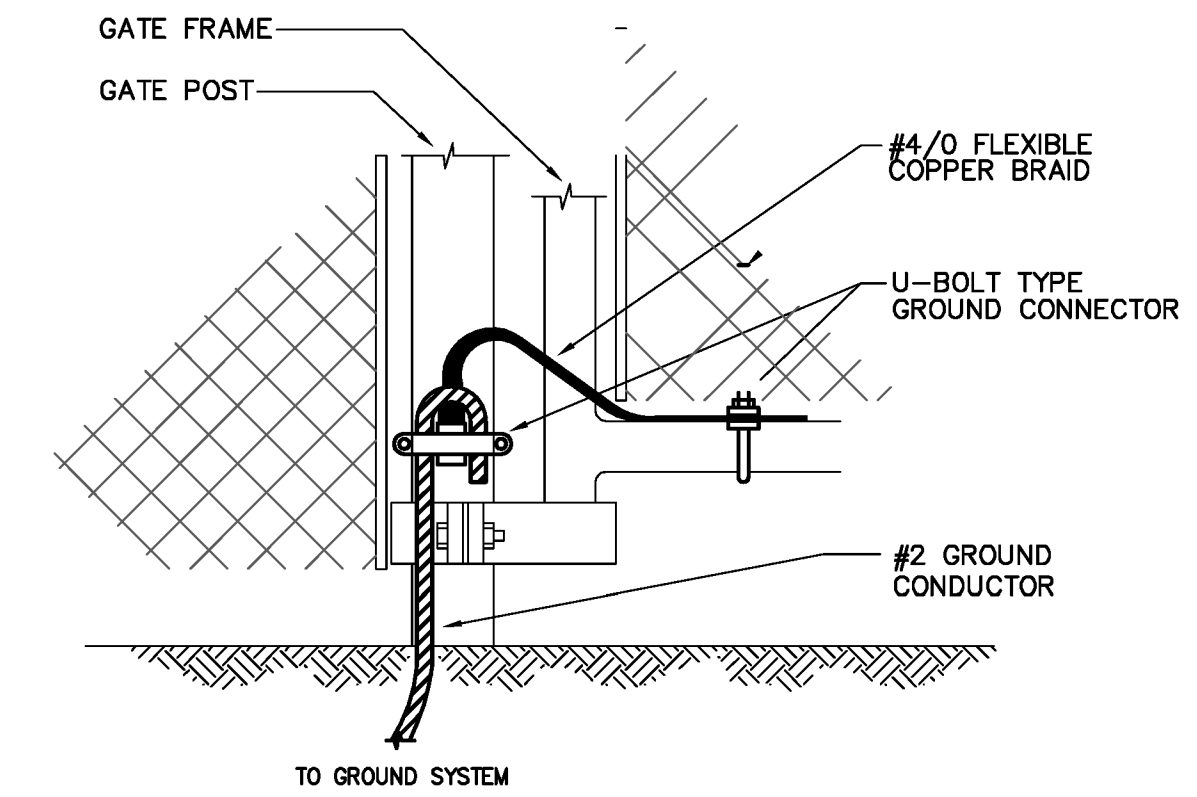


NOTE:
FENCE GROUND CONNECTIONS SHALL BE AT EACH CORNER. GATE JUMPER SHALL BE #4/0 FLEXIBLE COPPER BRAID WITH SLEEVES ON EACH DESIGNED FOR EXOTHERMIC WELDING AND INSTALLED SO THAT JUMPER WILL NOT BE SUBJECTED TO DAMAGING STRAIN WHEN GATE IS FULLY OPENED IN EITHER DIRECTION.


3 TYPICAL GATE - GROUNDING
- NOT TO SCALE

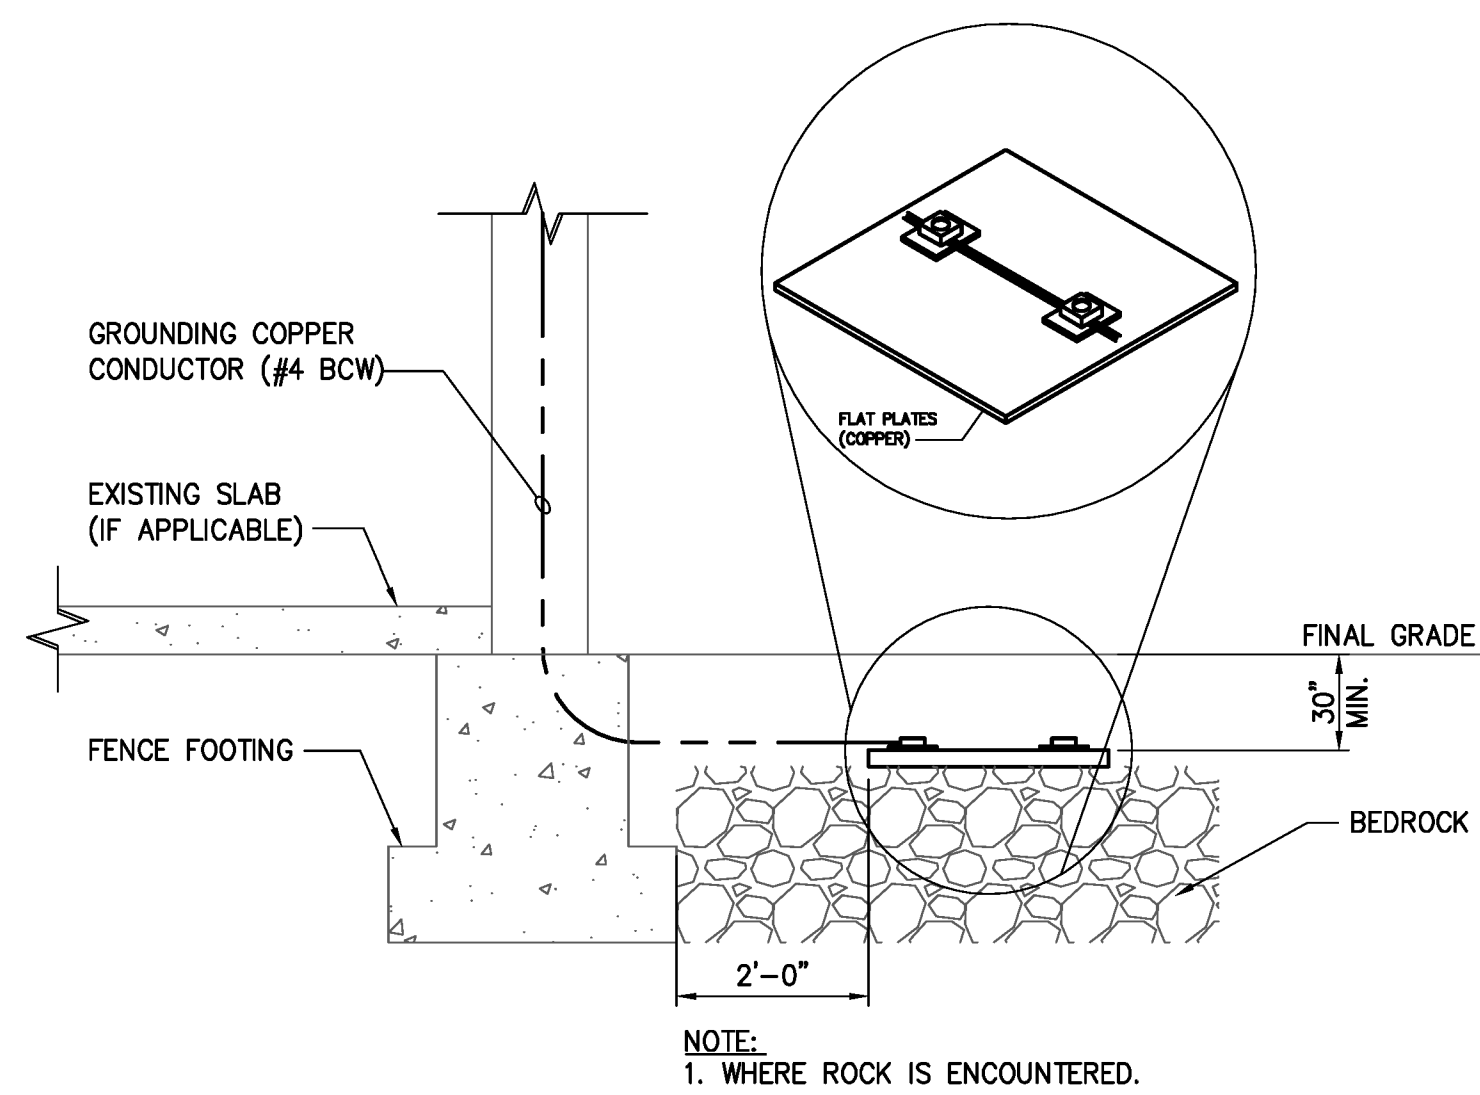

4 GROUNDING PLATE DETAIL
- NOT TO SCALE

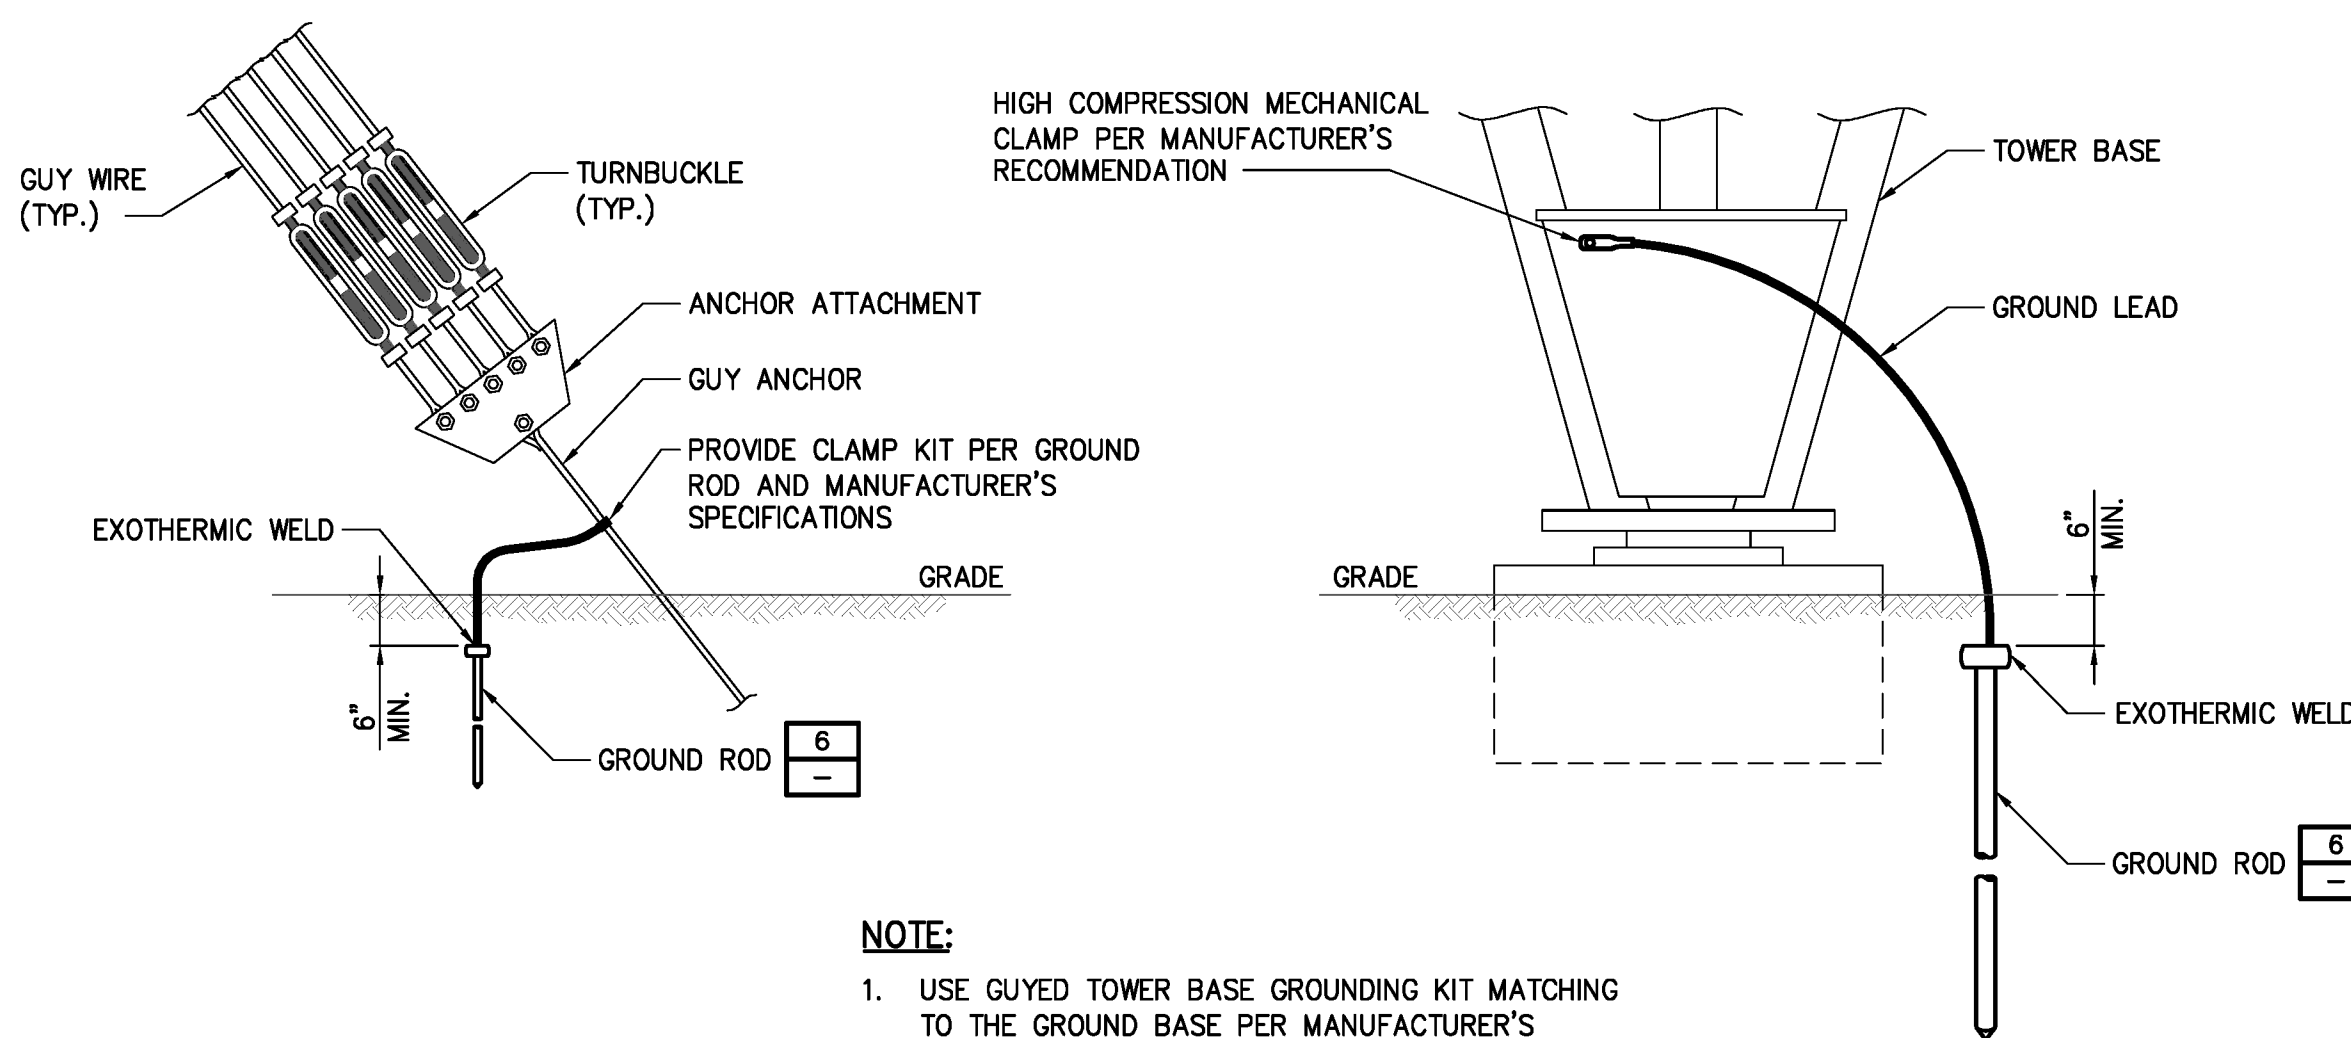

5 GUYED ANCHOR AND TOWER GROUNDING DETAIL
- NOT TO SCALE

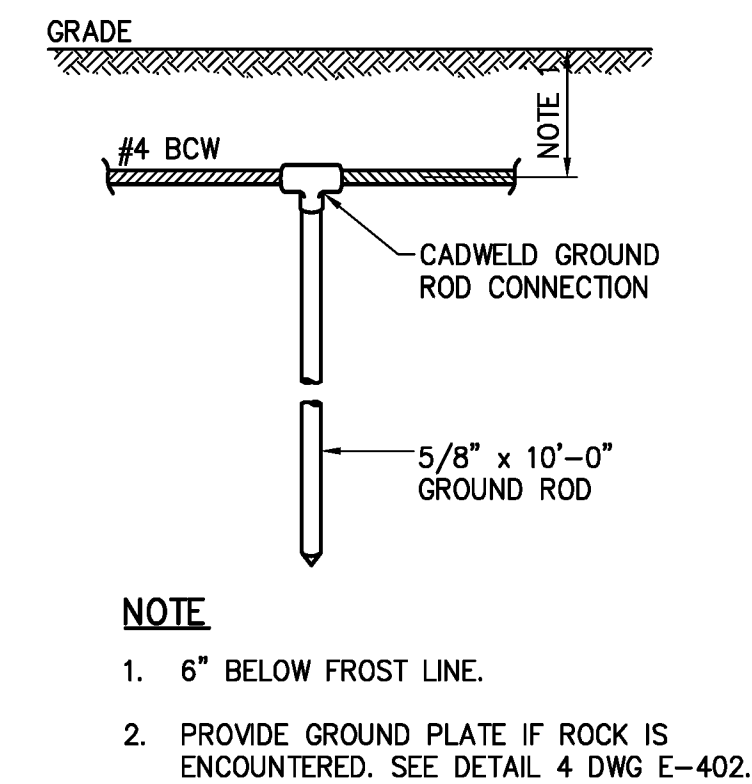

6 GROUND ROD DETAIL
- NOT TO SCALE

RECORD DRAWING 01/07/13

App'd By	Date
HAW HAW	01/07/13
Submitter / Revision	
RECORD DRAWINGS	

STATE OF VERMONT
AGENCY OF TRANSPORTATION

CHA
III Winners Circle, PO Box 5089 - Albany, NY 12205-0289
Main: (518) 453-4500 · www.chacompanies.com

Designed: NUB Drawn: CJE Checked: NUB

HARTNESS STATE AIRPORT
HAZARD BEACON REPLACEMENT



ELECTRICAL DETAILS

Issue Date: 03/18/11 Project No.: 21674 Scale: As Shown


E-402

File: V:\PROJECTS\NY\21674\CADD\ACAD\SHEET_FILES\E402-21674.DWG
Saved: 1/4/2013 4:18:24 PM Plotted: 1/4/2013 4:31:03 PM User: Wylol, Heather LastSavedBy: 2789

File: V:\PROJECTS\NYA\21674\CADD\CADD\SHR\FILES\S101-21674.DWG
 Saved: 1/4/2013 4:18:49 PM Plotted: 1/4/2013 4:31:23 PM User: Wyo, Heather Last Saved By: 2789

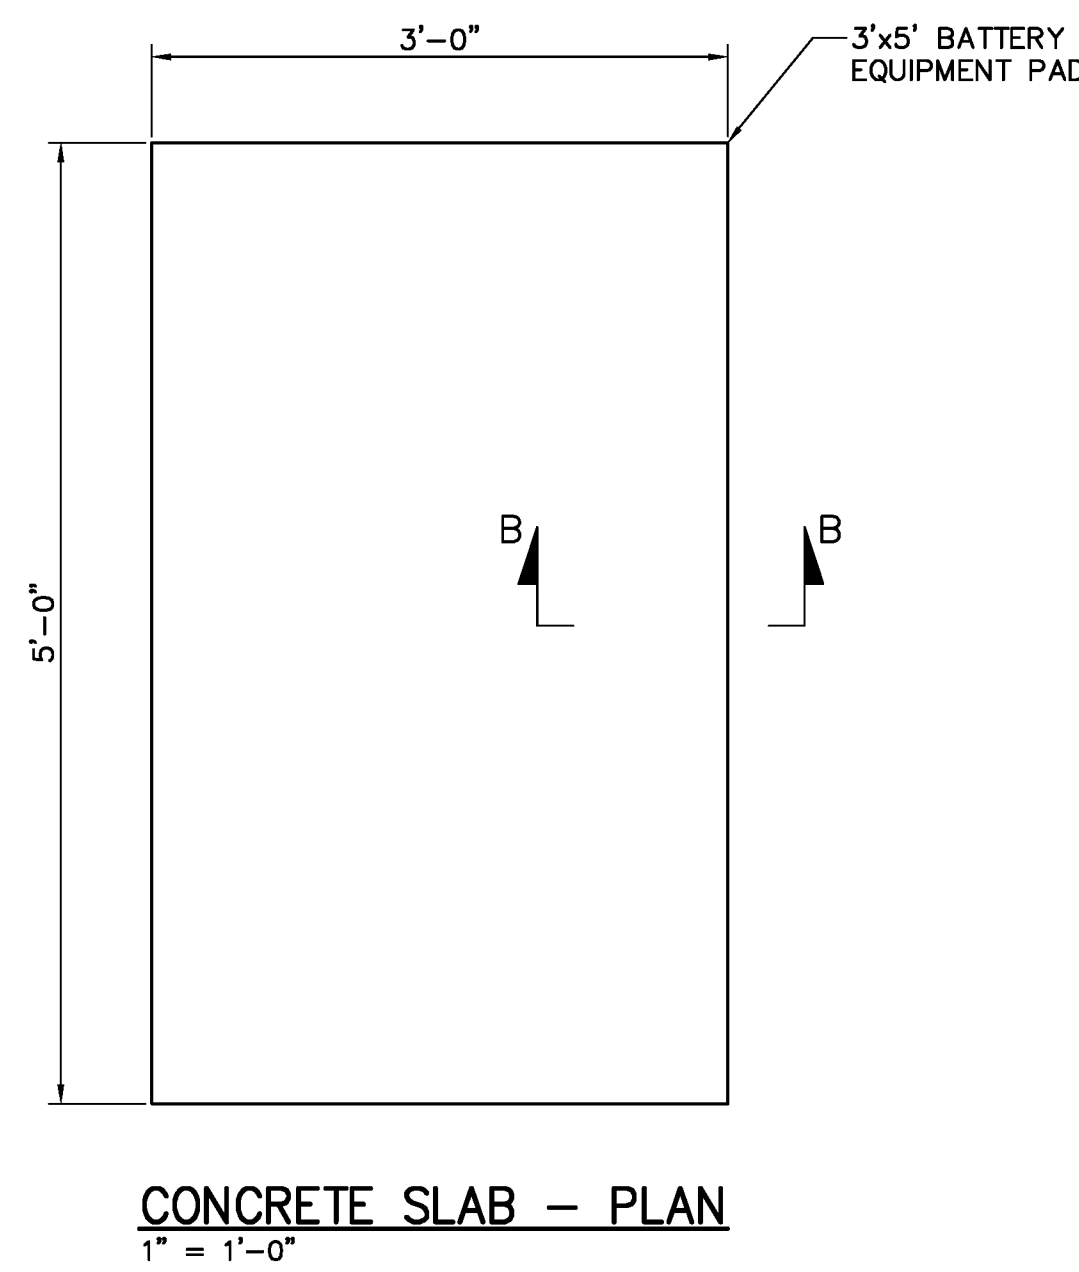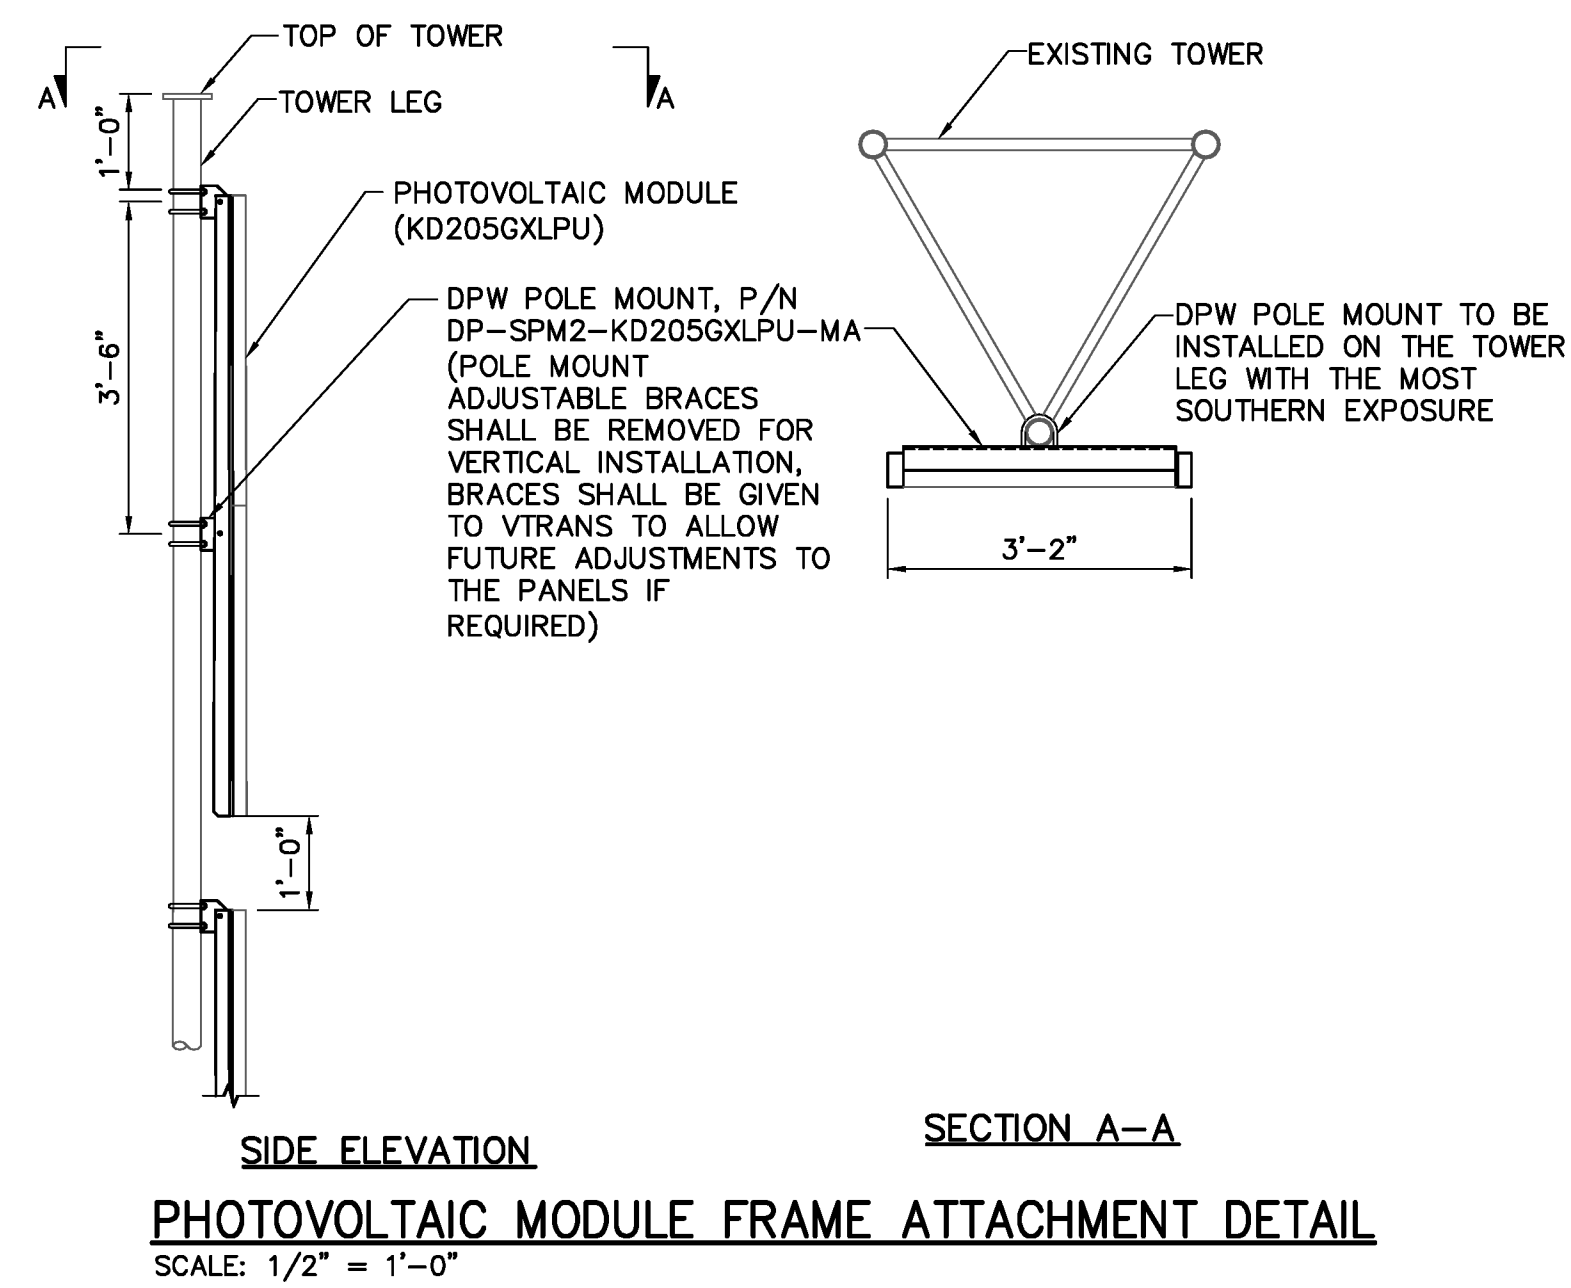

- NOTE:**
- TOP OF FOUNDATION ELEVATION TOLERANCE 1/4" IN 10'-0" & 1/2" MAX OVERALL.
 - CONCRETE SHALL BE AIR-ENTRAINED AND HAVE A MINIMUM COMPRESSIVE STRENGTH OF 4000 PSI.

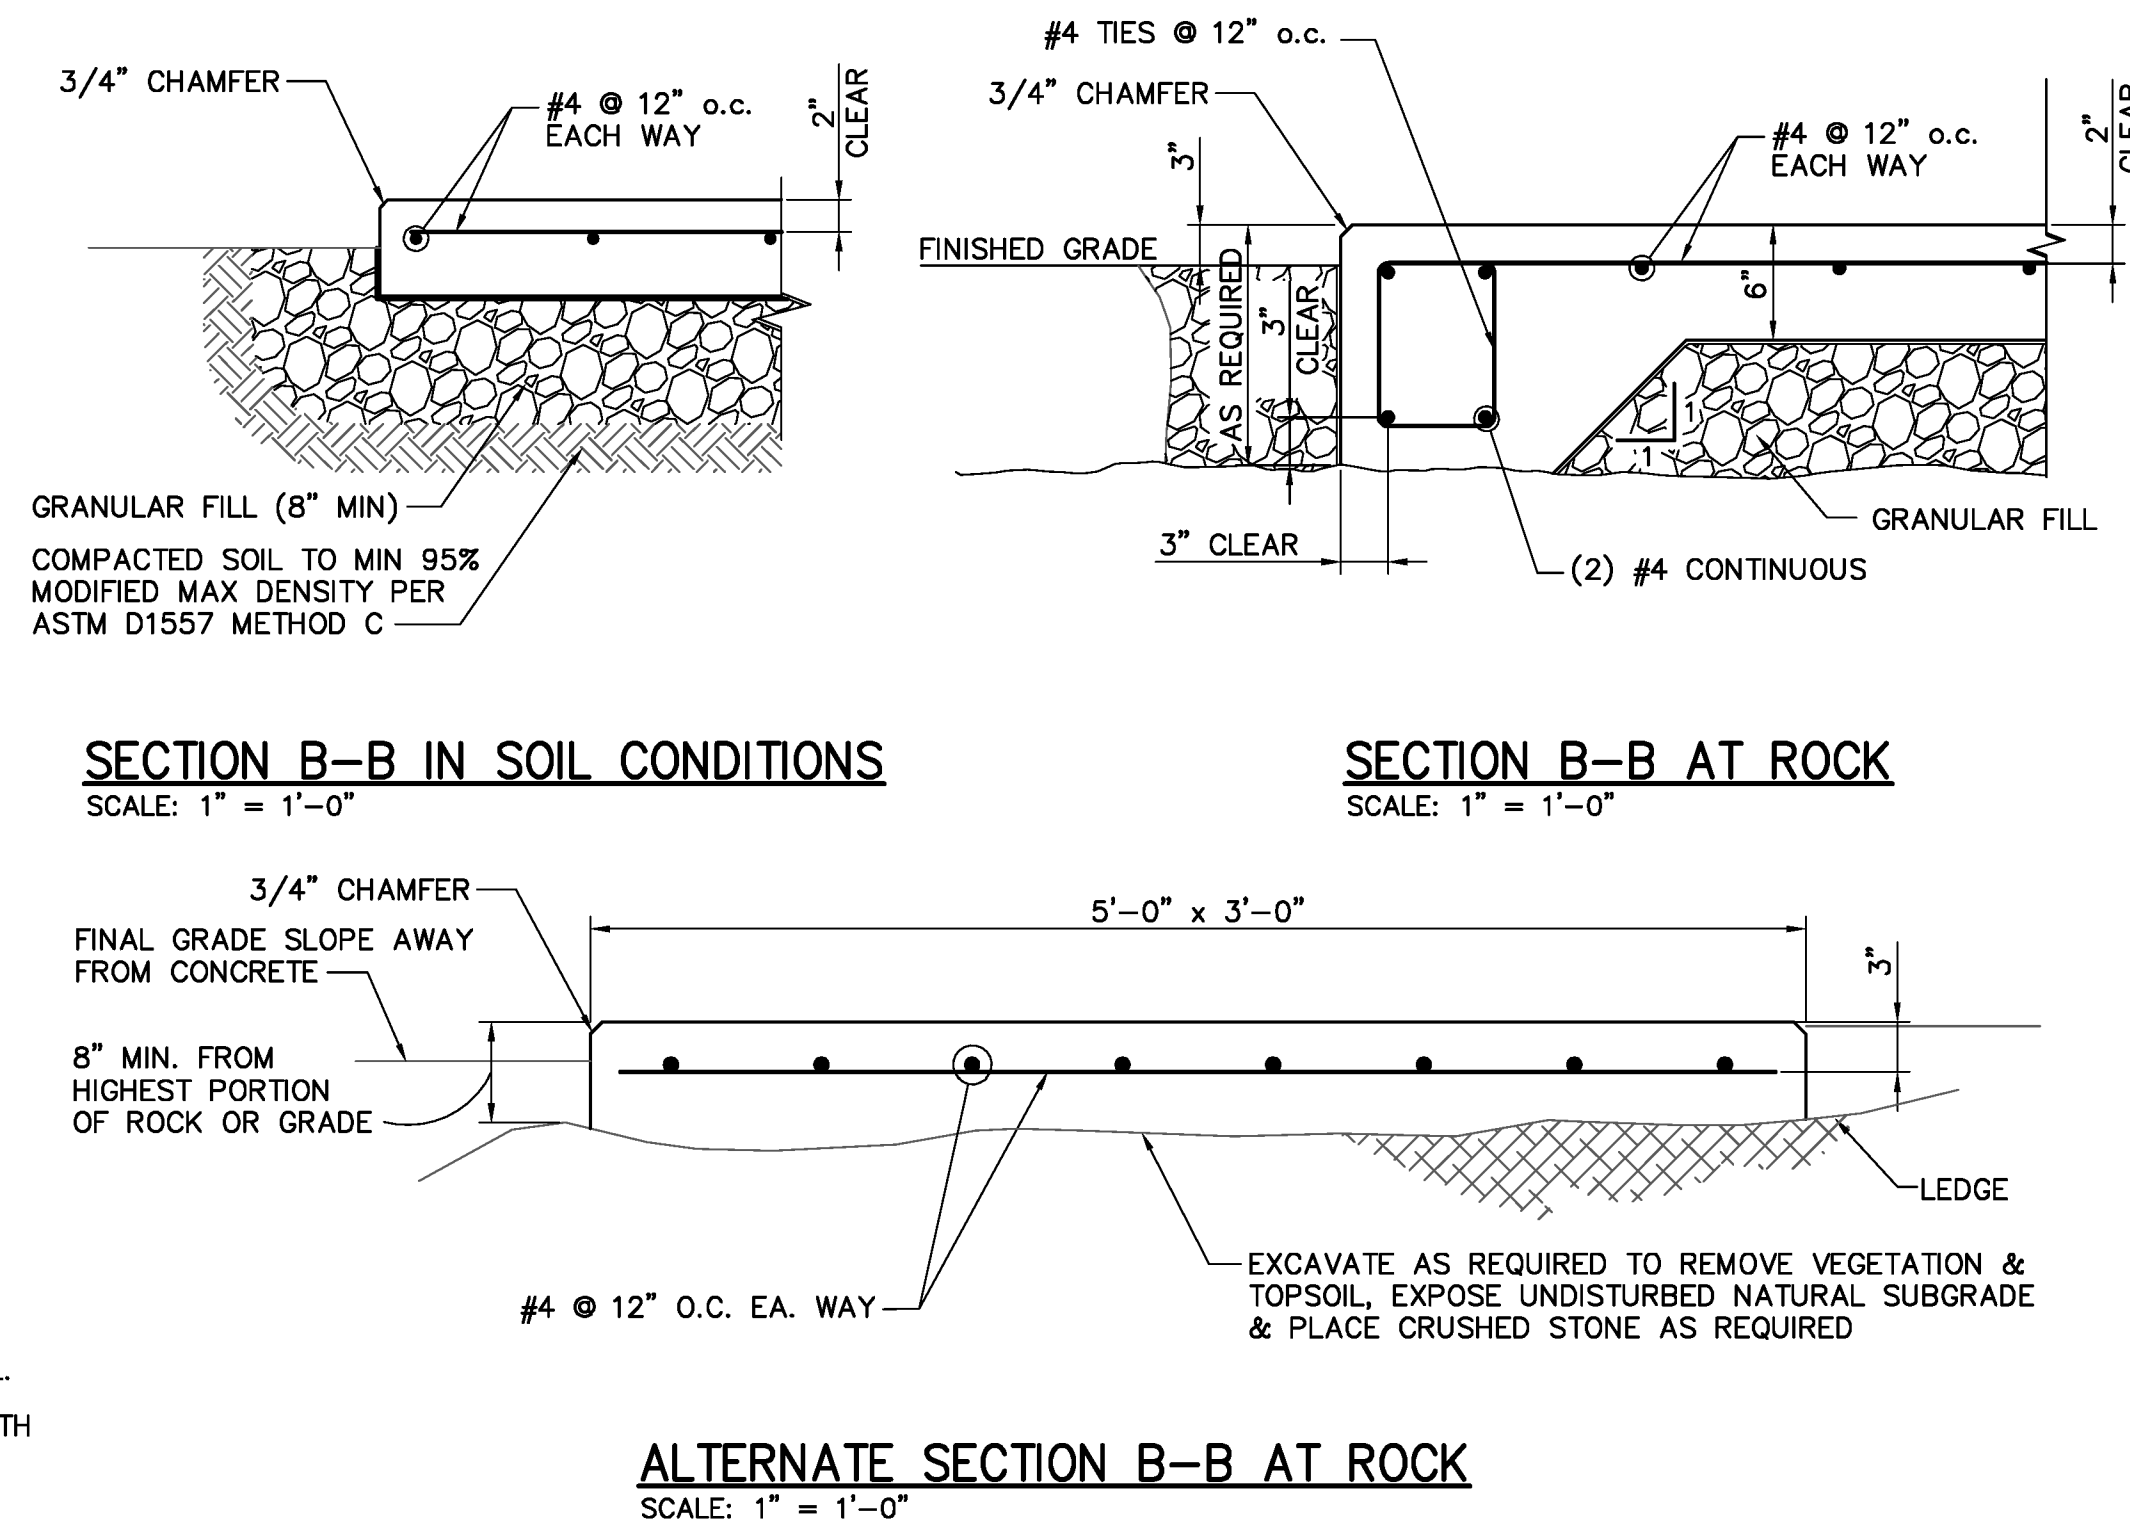

RECORD DRAWING 01/07/13

No.	Submit / Revision	App'd By	Date
1	RECORD DRAWINGS	HAW HAW	01/07/13

STATE OF VERMONT
 AGENCY OF TRANSPORTATION

UNAUTHORIZED ALTERATION OR ADDITION
 OF ANY PART OF THIS DRAWING IS PROHIBITED
 APPLICABLE STATE AND/OR LOCAL LAWS

III Winners Circle, PO Box 5589 - Albany, NY 12205-0289
 Main: (518) 453-4500 · www.chiacompanies.com

Designed: JUS Drawn: BAS Checked: DD


HARTNESS STATE AIRPORT
 HAZARD BEACON REPLACEMENT

STRUCTURAL DETAILS


Issue Date: 03/18/11 Project No.: 21674 Scale: As Shown

S-101


File: V:\PROJECTS\NYA\21674\CADD\ACAD\...SHEET_FILES\S102-21674.DWG
 Saved: 1/4/2013 4:19:14 PM Printed: 1/4/2013 4:31:44 PM User: Wj4 - Heather LastSavedBy: 2789

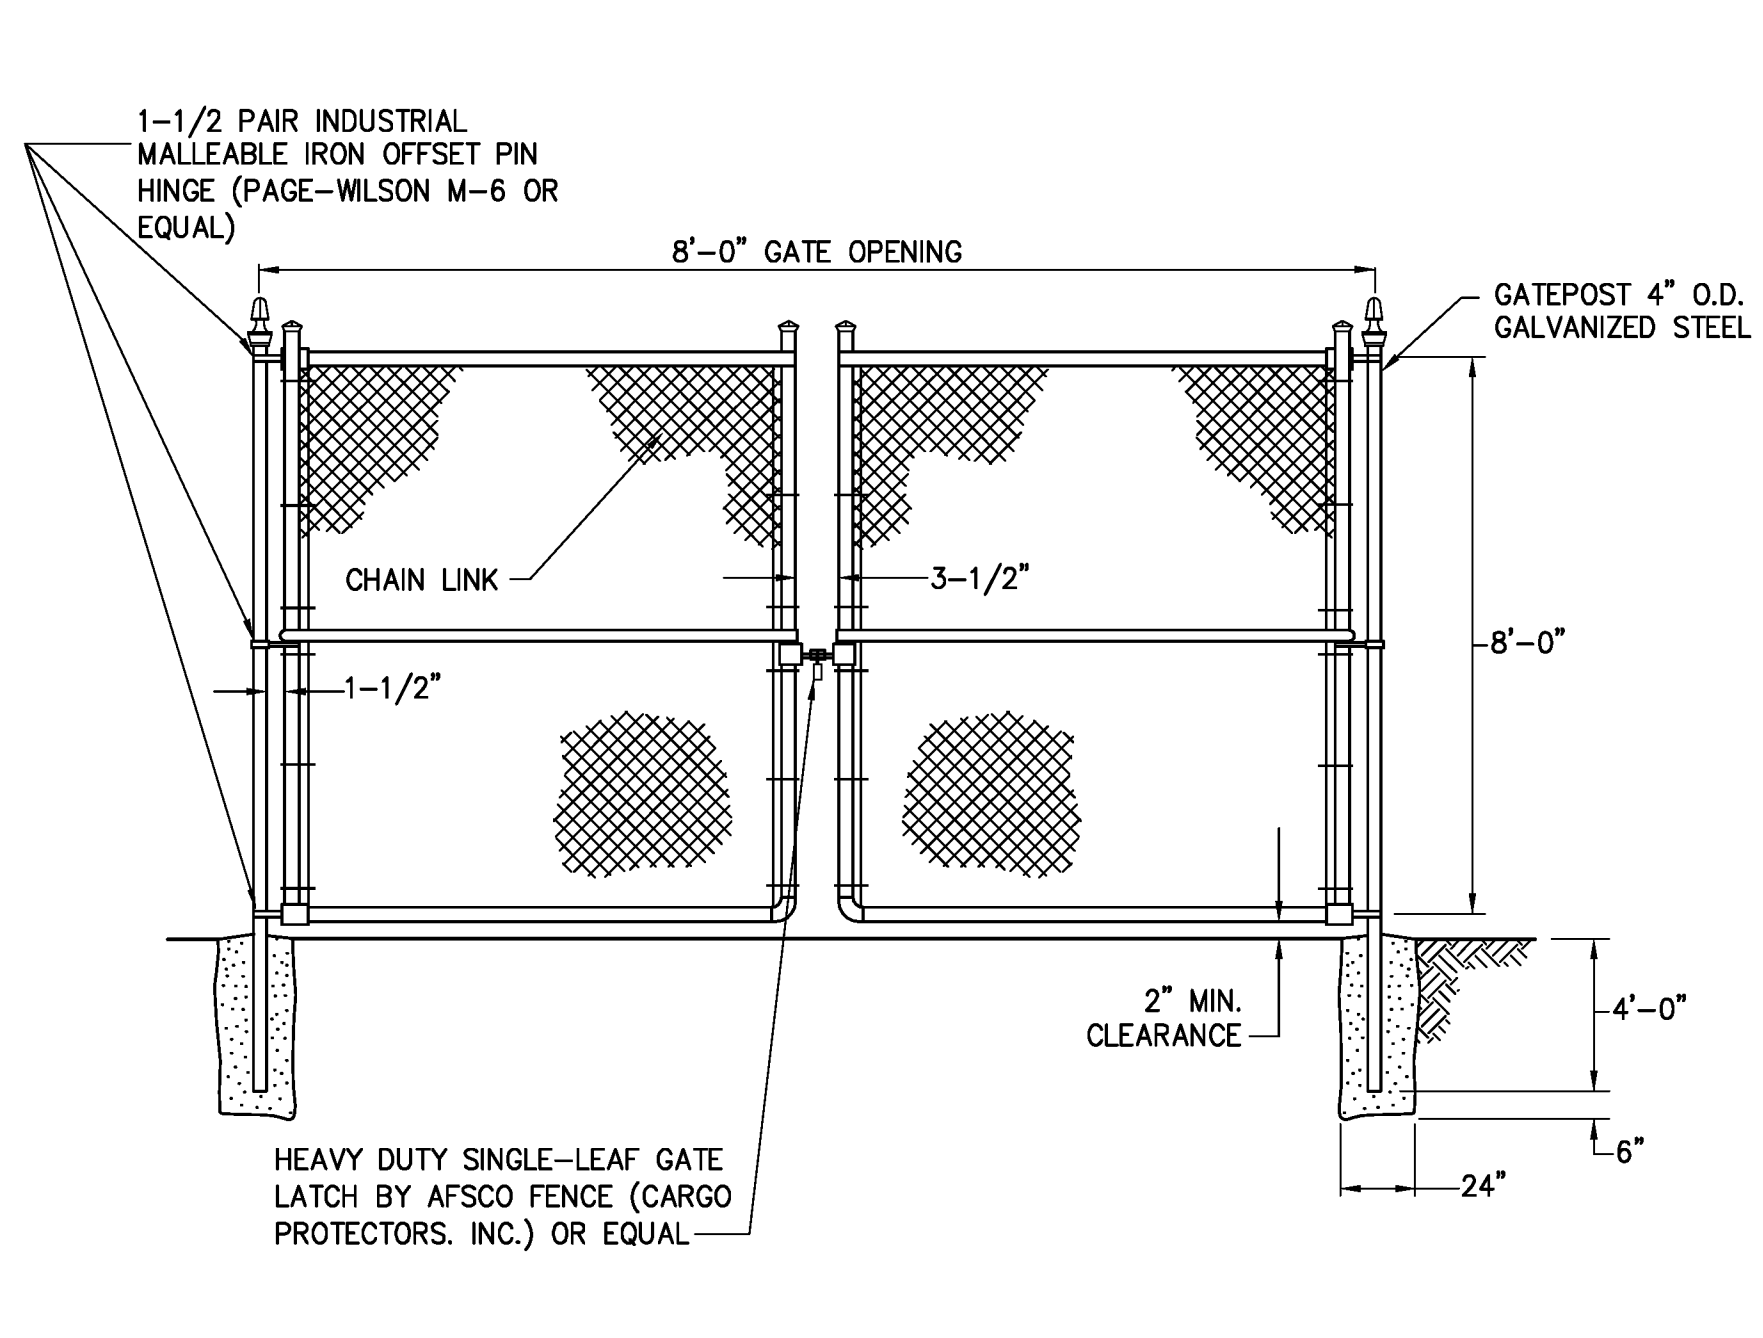


FENCE SWING GATE DETAIL (SOIL CONDITION)
 SCALE: NTS

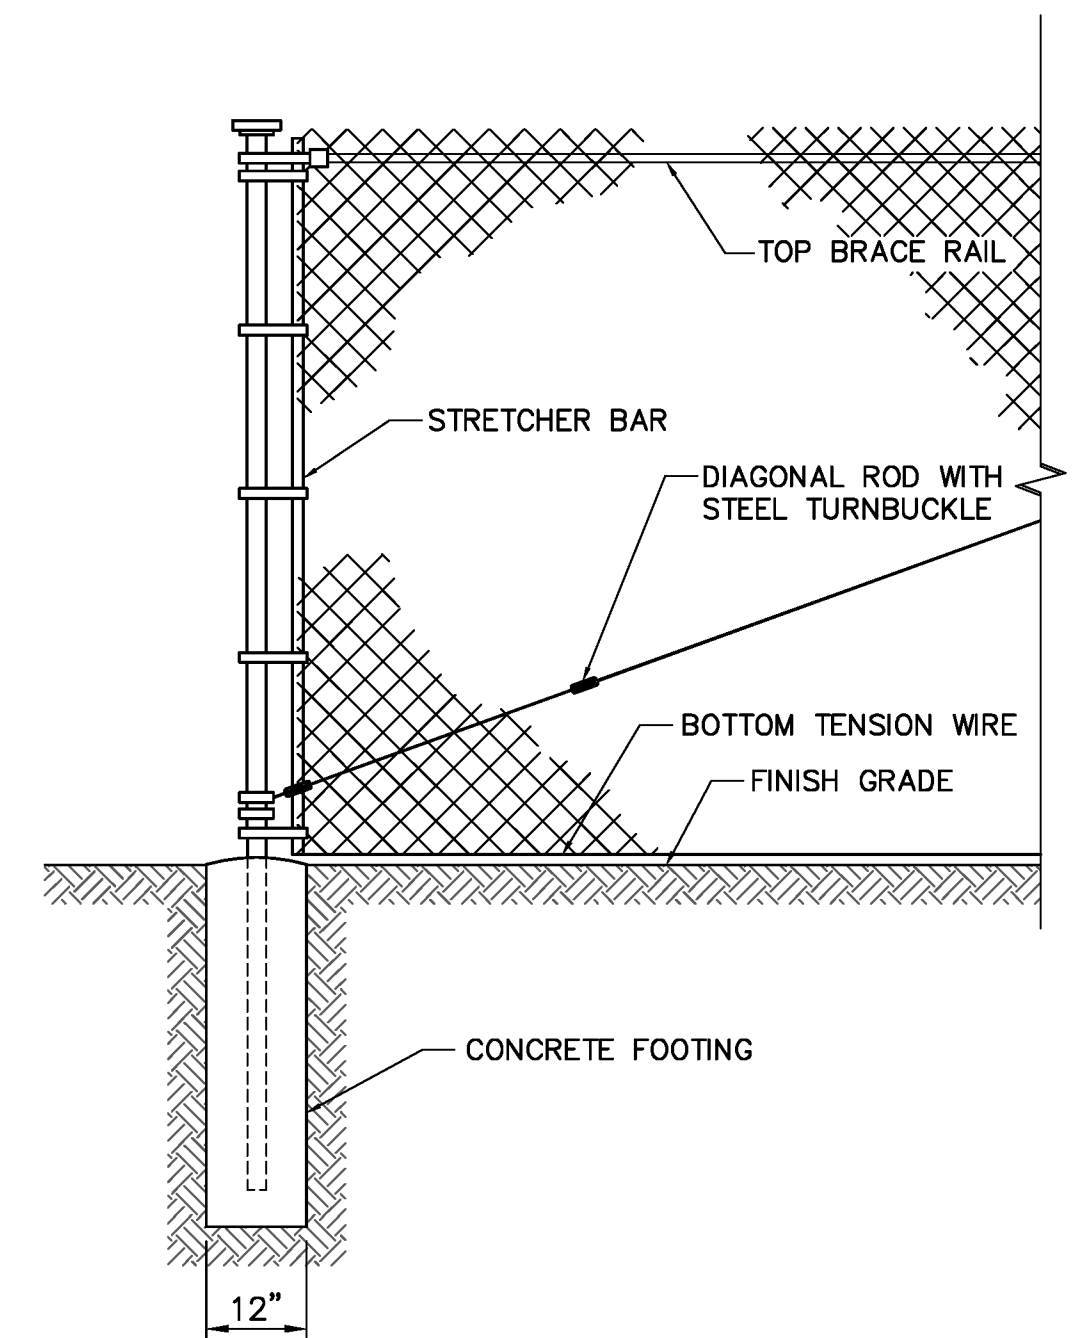


FENCE CORNER, GATE, END OR PULL POST (SOIL CONDITION)
 SCALE: NTS

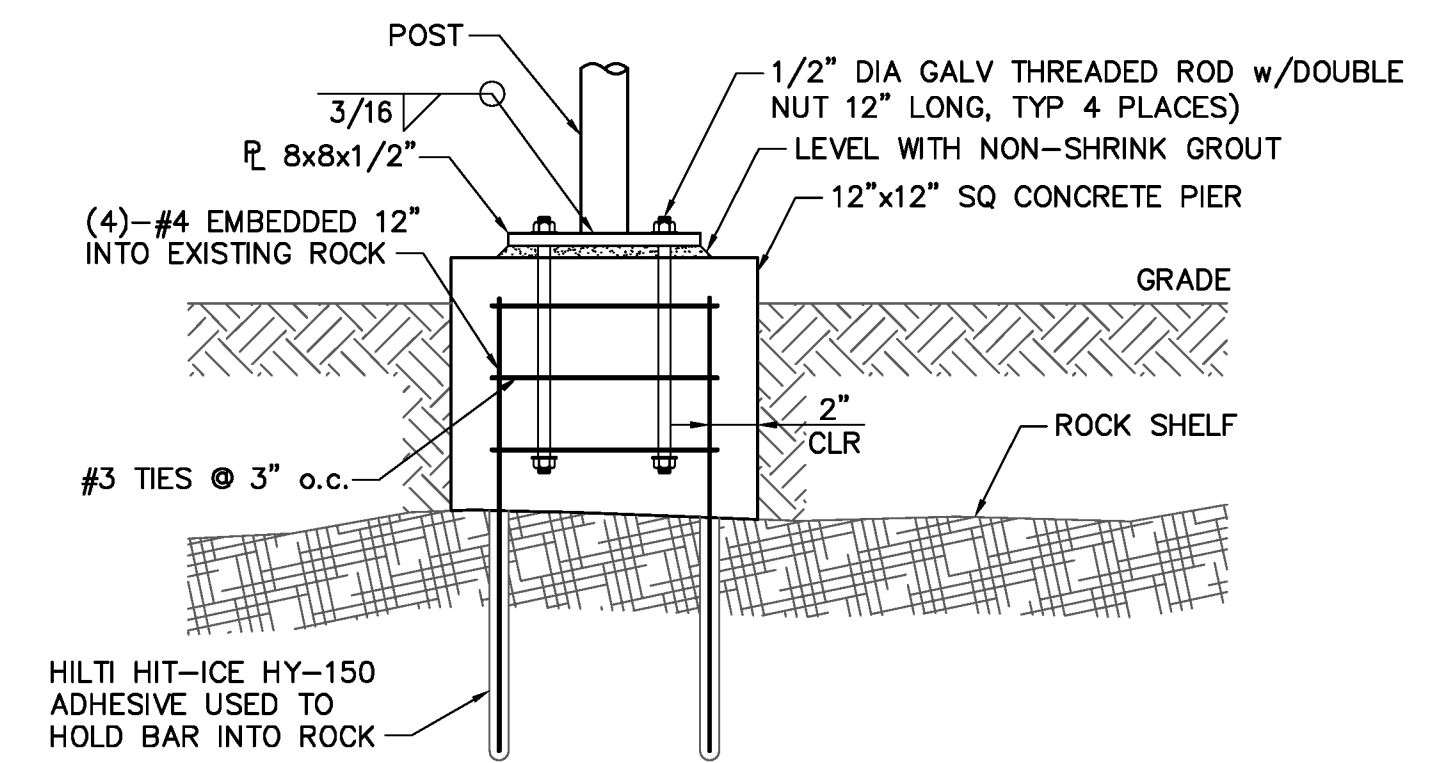


FENCE BASEPLATE ELEVATION TO SUBGRADE ROCK
 NOT TO SCALE

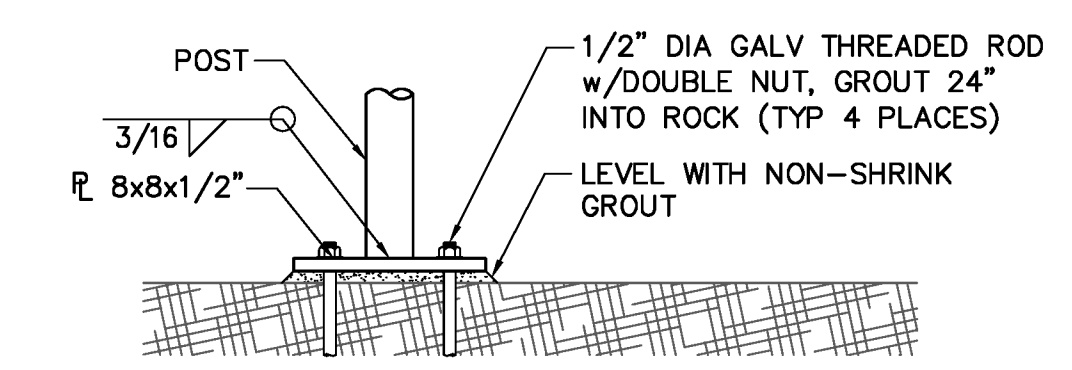

FENCE BASEPLATE ELEVATION AT ROCK
 NOT TO SCALE

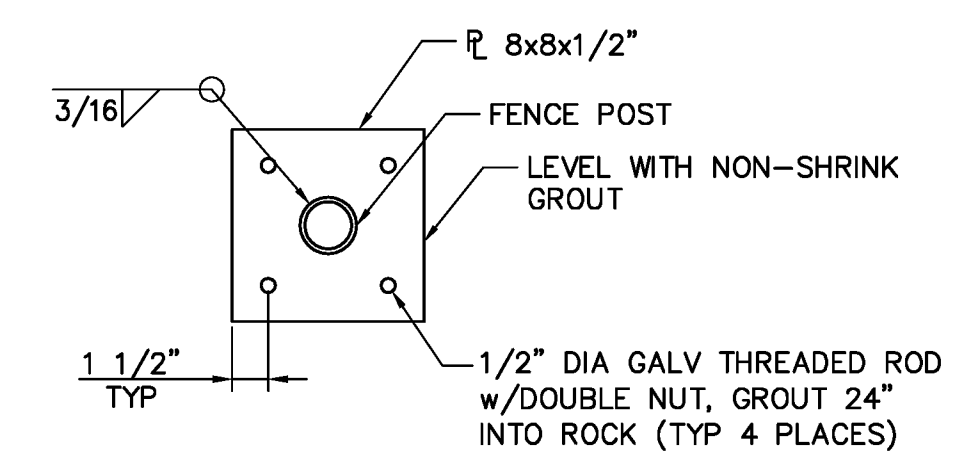

FENCE BASEPLATE DETAIL AT ROCK
 NOT TO SCALE

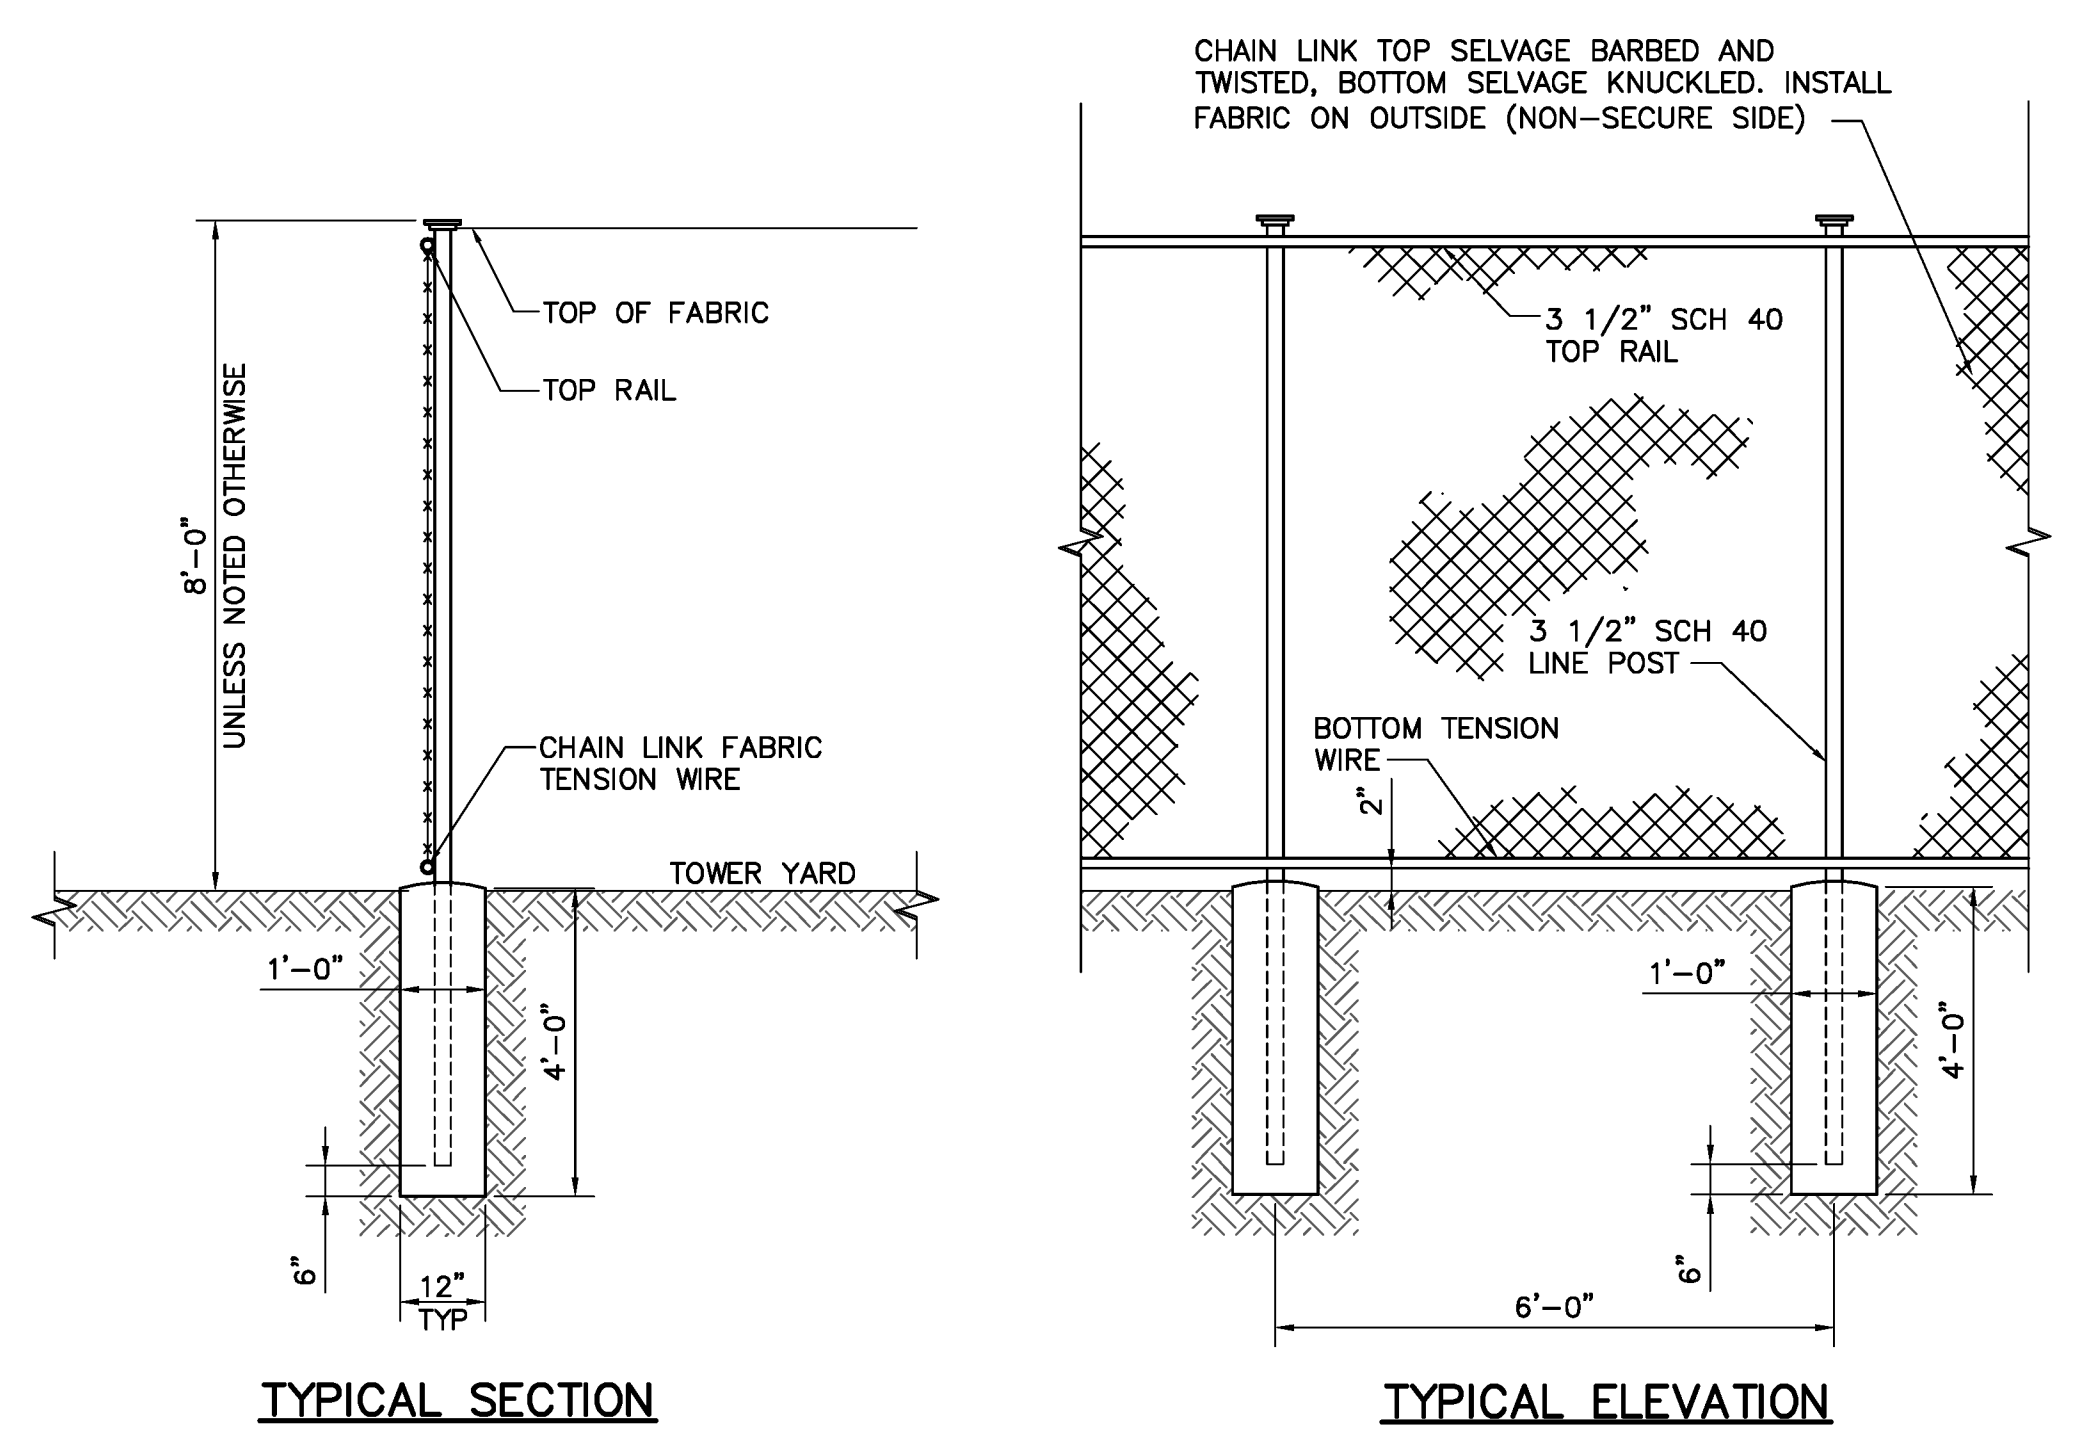

WOVEN WIRE FENCE DETAIL (SOIL CONDITION)
 SCALE: NTS

App'd By	DATE
HAW	01/07/13
Submit / Revision	
RECORD DRAWINGS	

STATE OF VERMONT
 AGENCY OF TRANSPORTATION

UNAUTHORIZED ALTERATION OR ADDITION OF ANY INFORMATION TO THIS DRAWING IS PROHIBITED AND IS SUBJECT TO APPLICABLE STATE AND/OR LOCAL LAWS

Designed: JUS Drawn: BAS Checked: DD

CHIA

111 Winners Circle, PO Box 5089 - Albany, NY 12205-0289
 Main: (518) 453-4500 • www.chiacompanies.com

HARTNESS STATE AIRPORT
 HAZARD BEACON REPLACEMENT

STRUCTURAL DETAILS

Issue Date: 03/18/11 Project No.: 21674 Scale: As Shown

RECORD DRAWING 01/07/13

S-102