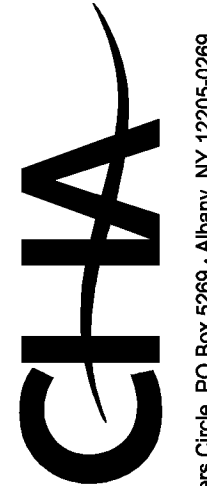


File: V:\PROJECTS\ANY\21674\CADD\CADD_SHEET_FILES\C003-4-21674.DWG
 Sheet: 1/4/2013 4:15:31 PM Printed: 1/4/2013 4:27:08 PM User: Wyo, Heather Last Saved By: 2789

Submitter / Revision	By	Date
RECORD DRAWINGS	HAW	07/07/13

STATE OF VERMONT
 AGENCY OF TRANSPORTATION

DESIGNED: HAW | DRAWN: HAW | CHECKED: TYL

 III Winners Circle, PO Box 5089 - Albany, NY 12205-0289
 Main: (518) 483-4500 • www.chacompanies.com

HARTNESS STATE AIRPORT
 HAZARD BEACON REPLACEMENT
 SUBSURFACE LOGS
 Issue Date: 03/18/11 | Project No.: 21674 | Scale: As Shown

RECORD DRAWING 07/07/13

C-004