




SUBSURFACE LOG LOCATION MAP
SCALE: AS NOTED

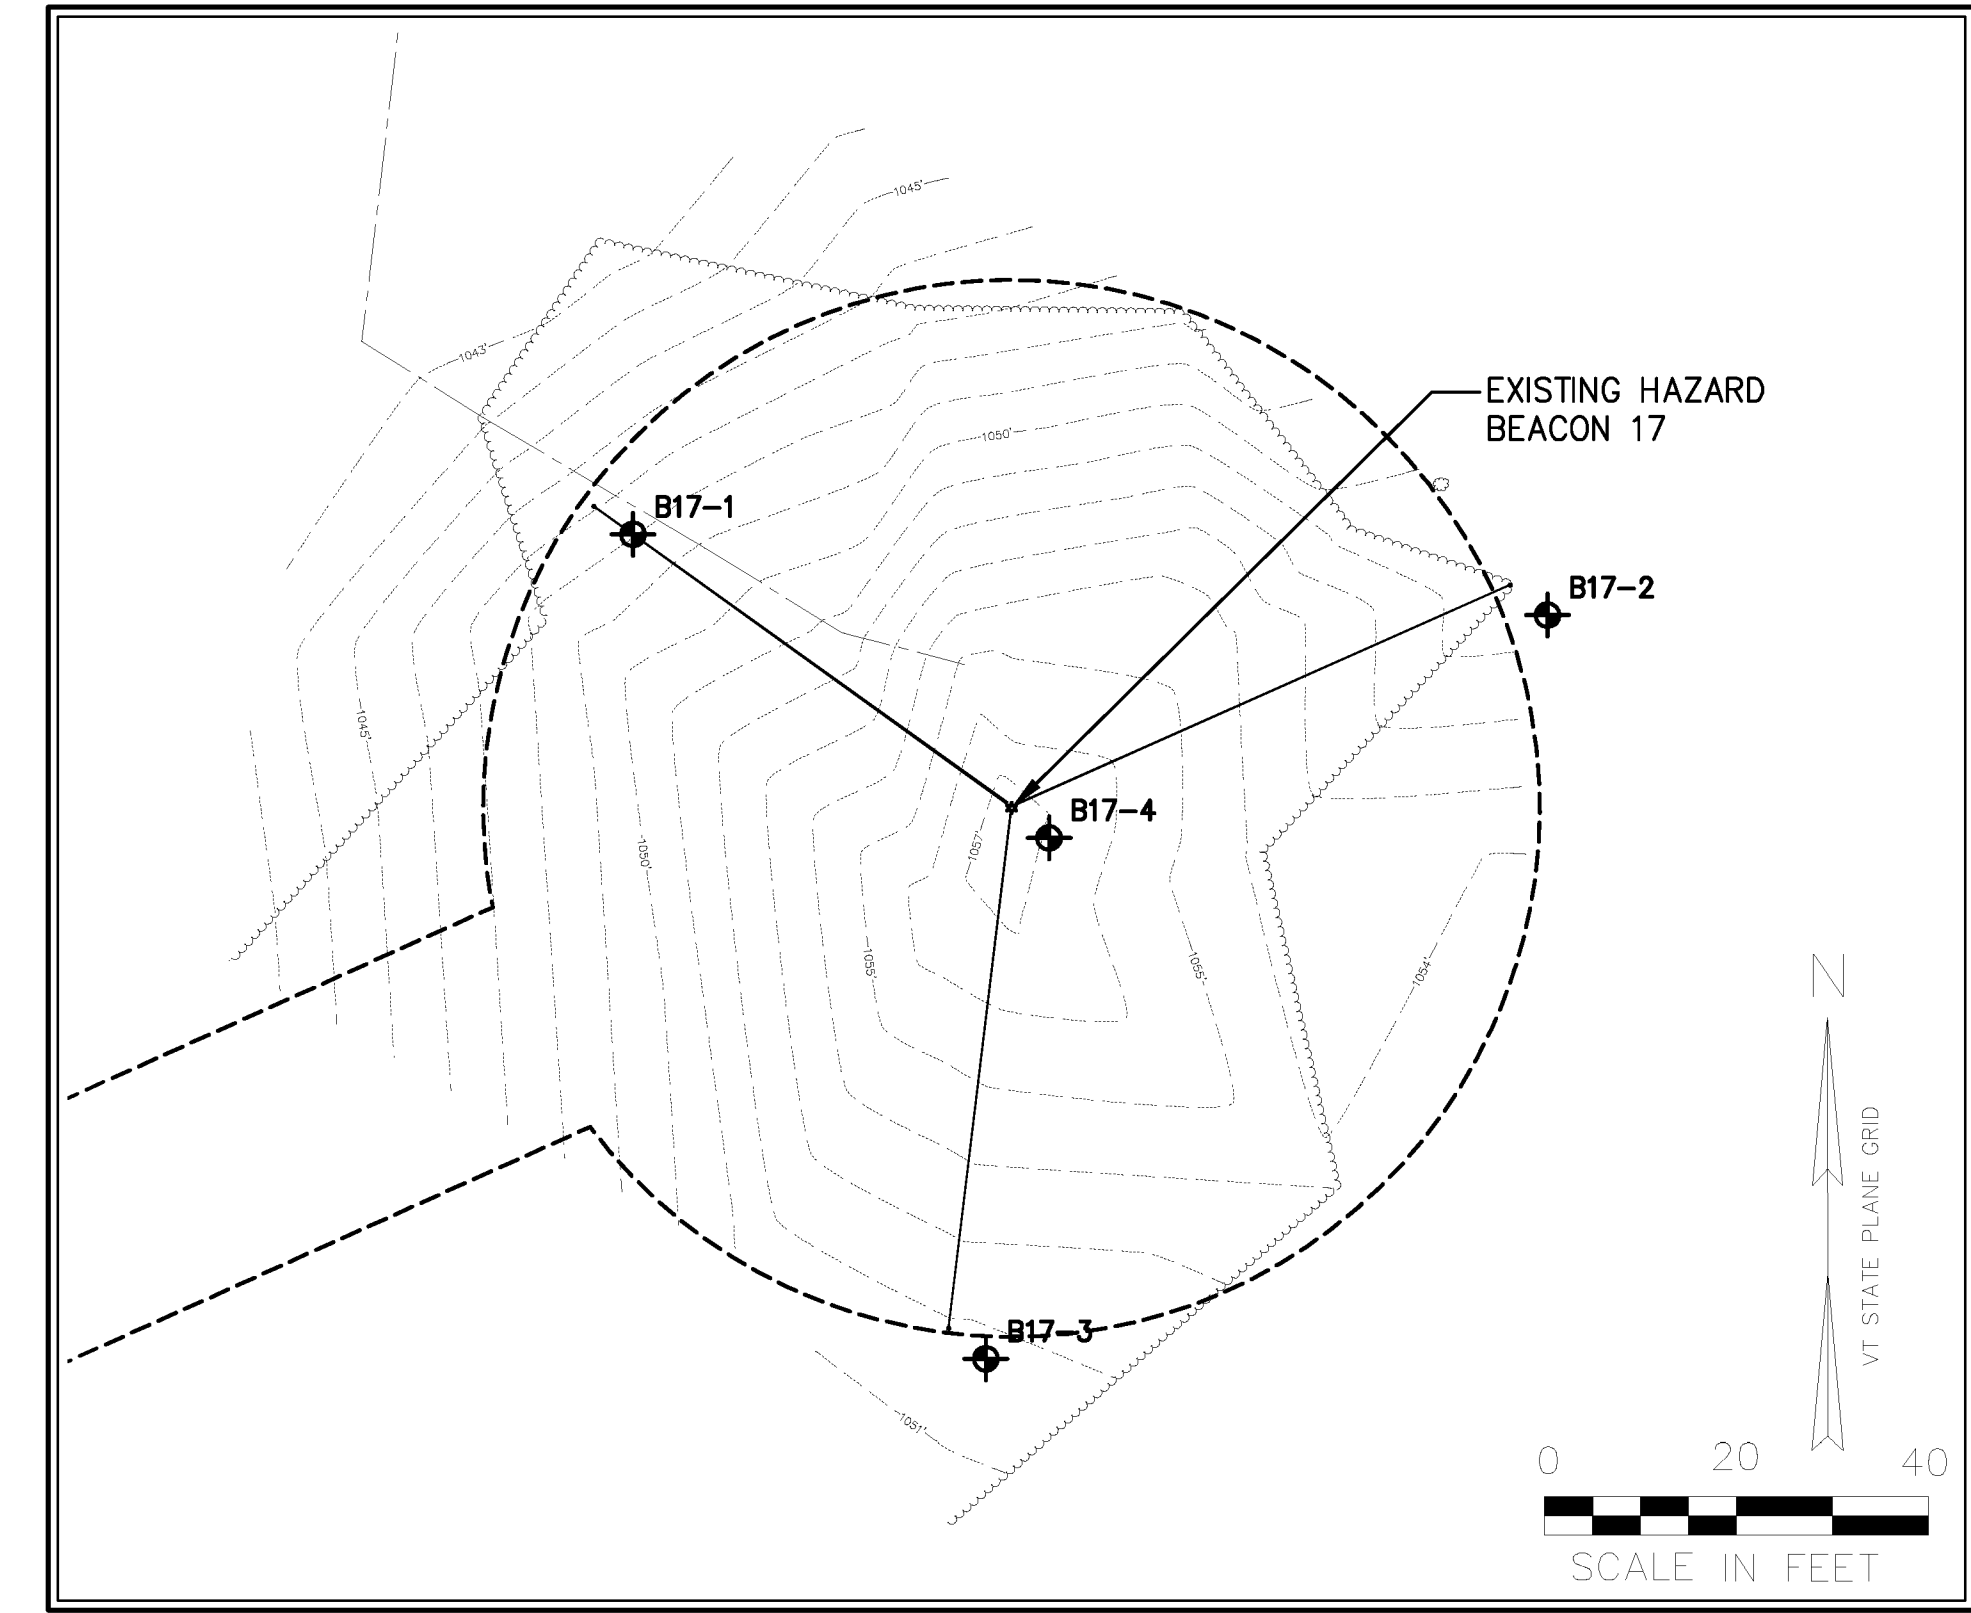

HAZARD BEACON #17 SUBSURFACE LOGS
SCALE: AS NOTED

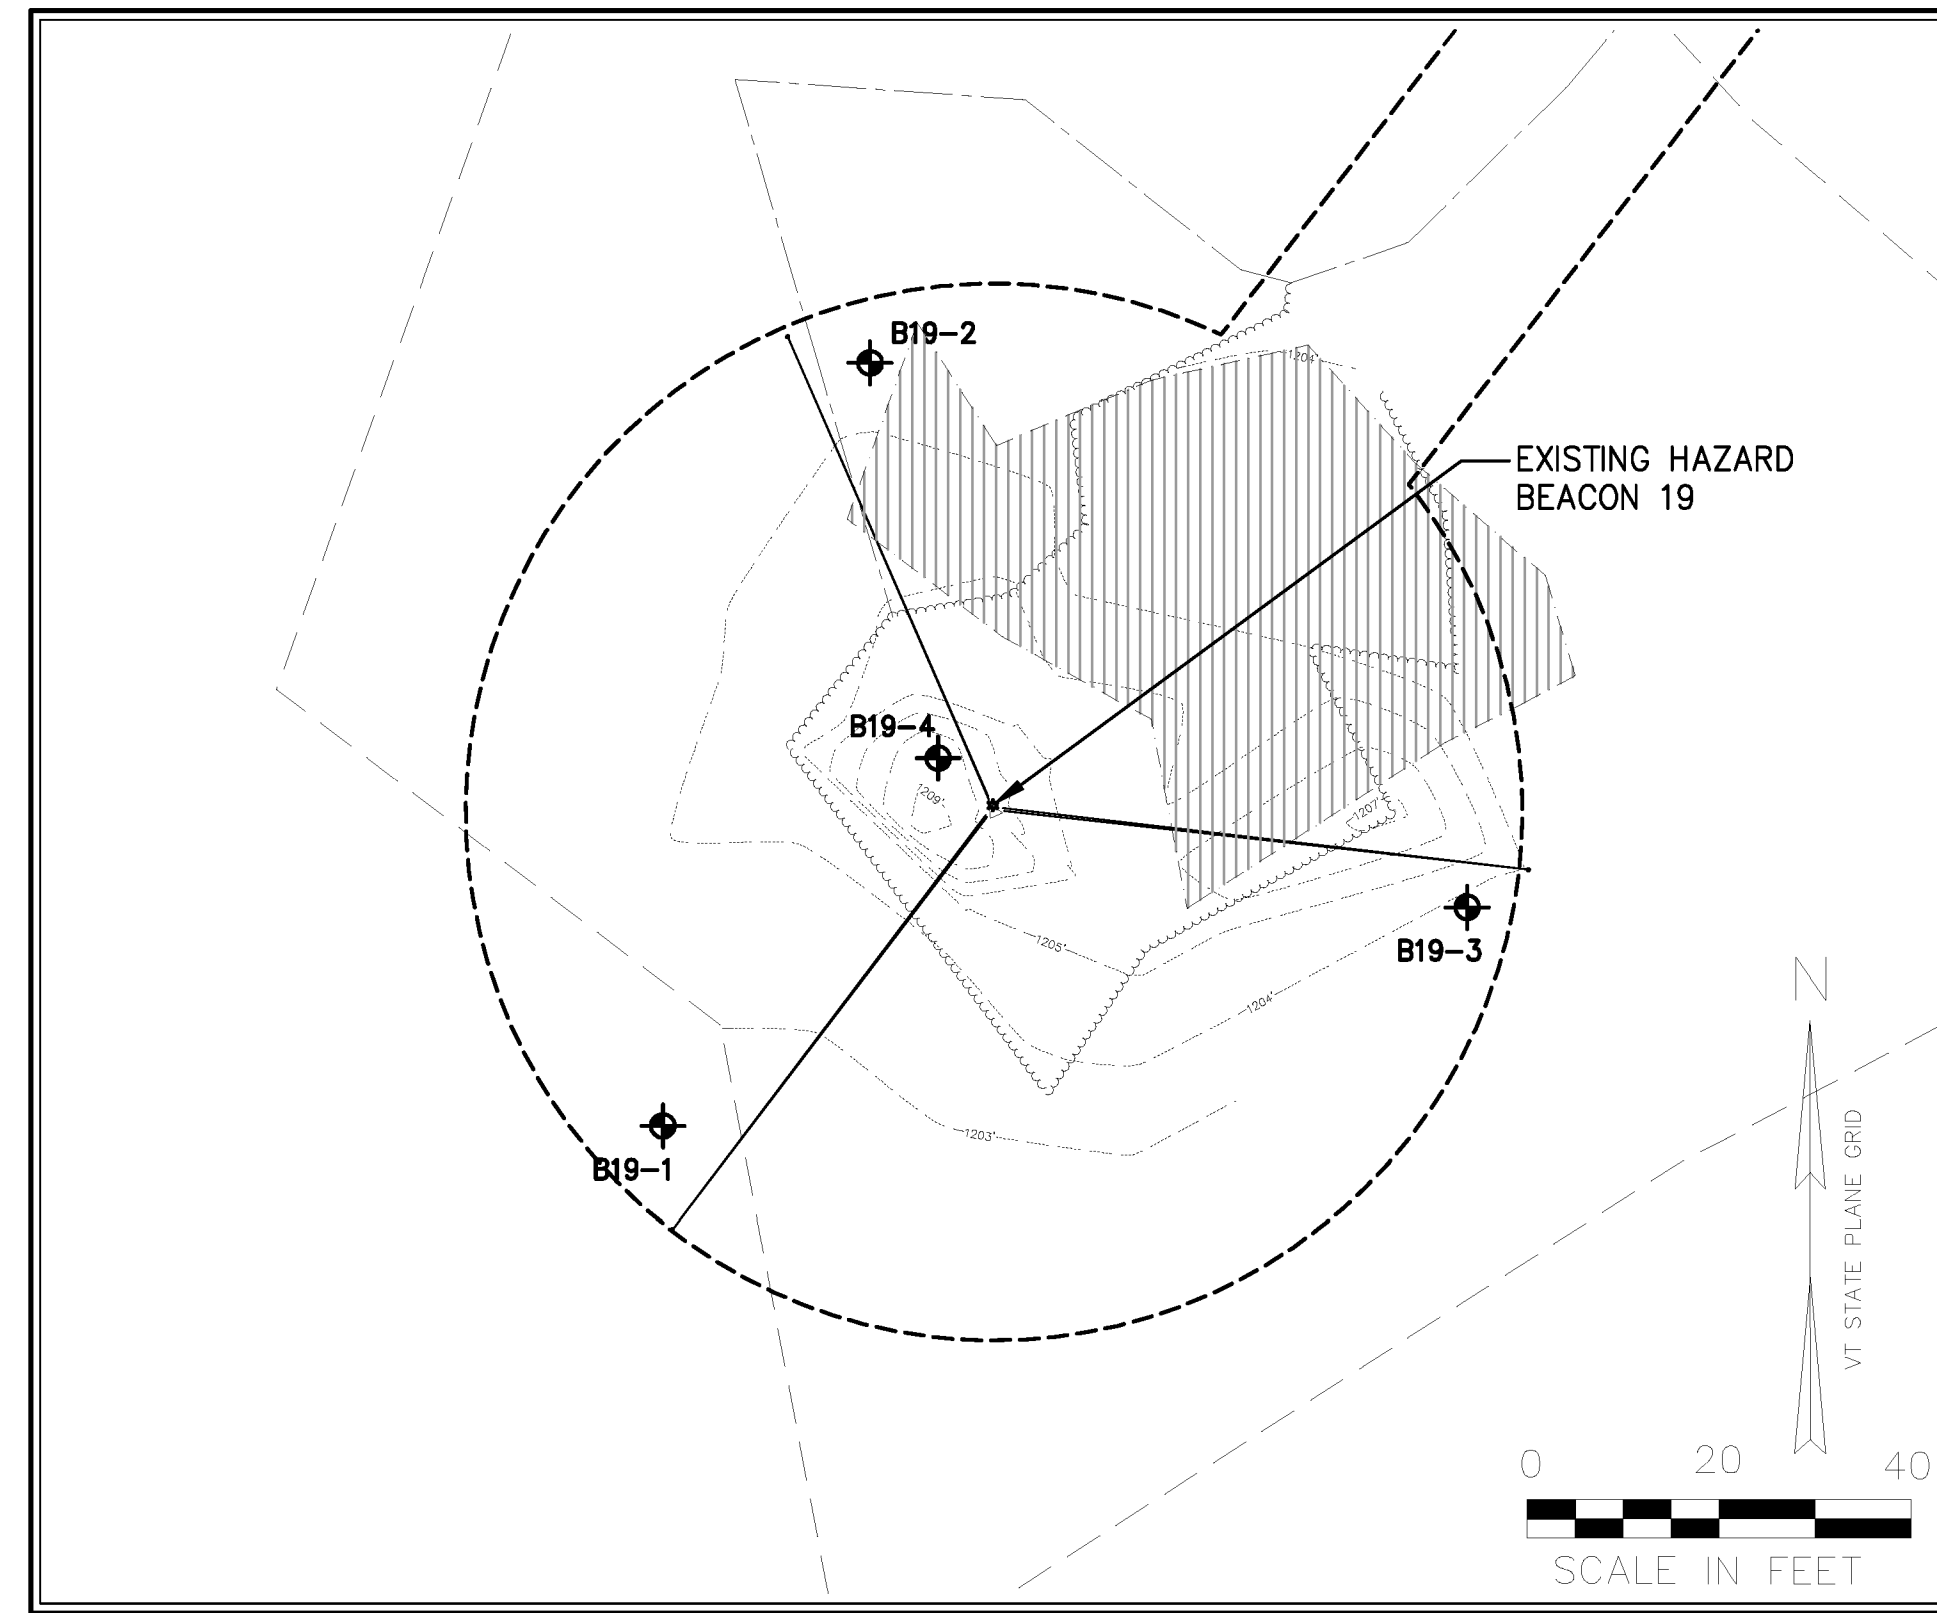

HAZARD BEACON #19 SUBSURFACE LOGS
SCALE: AS NOTED

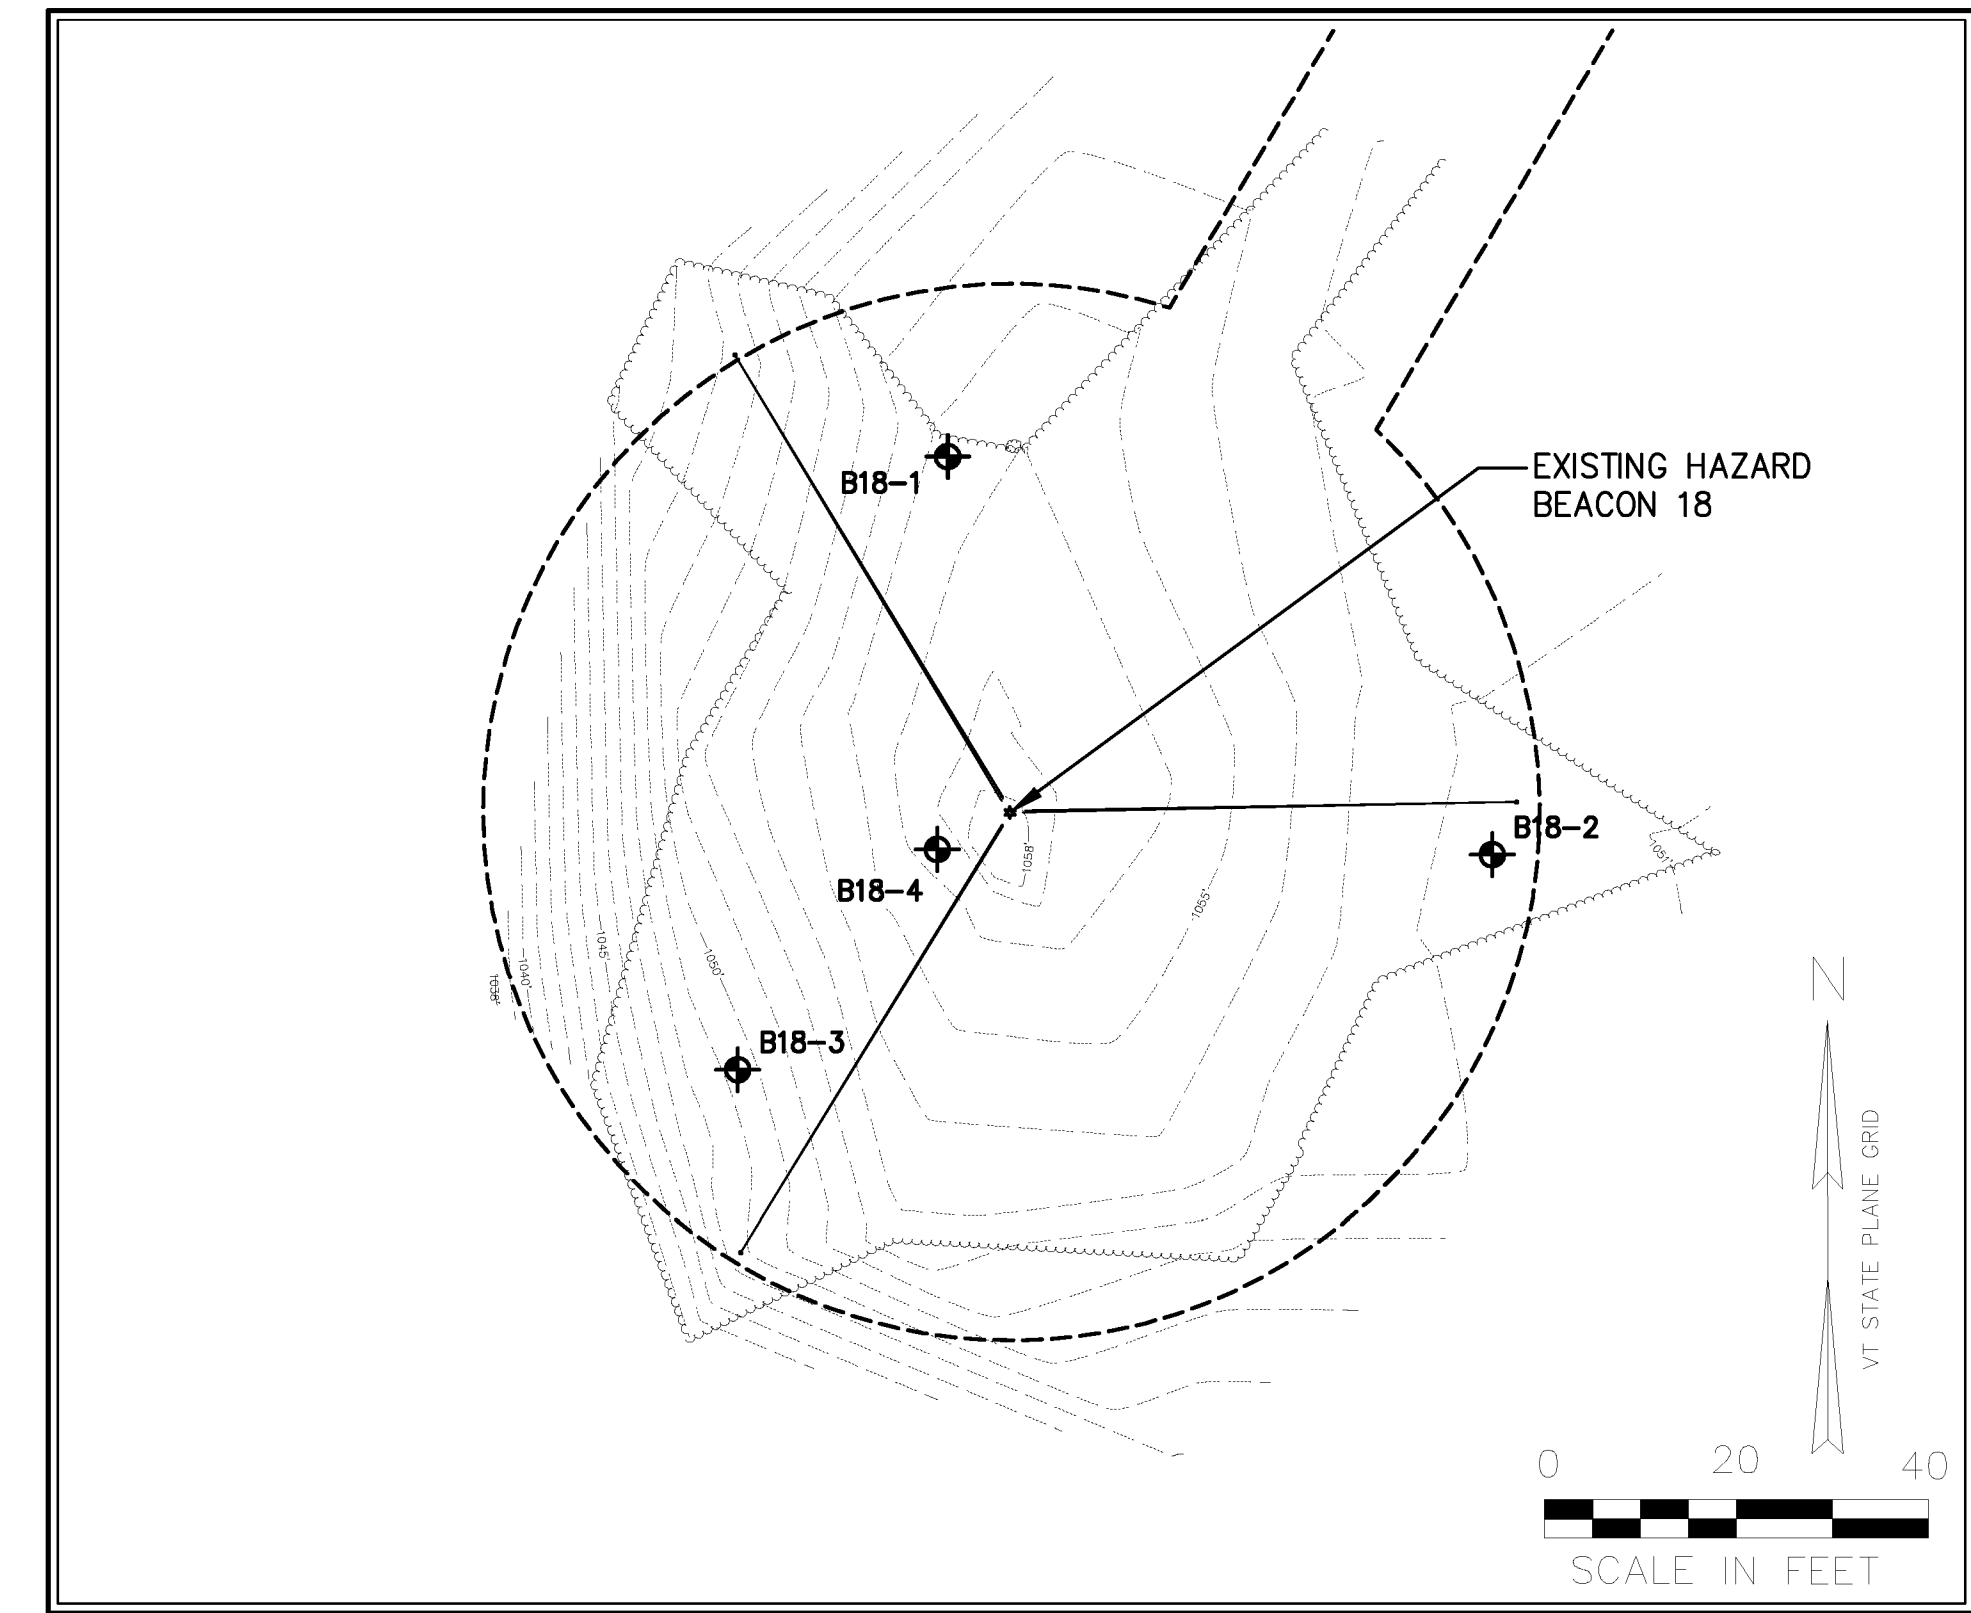


HAZARD BEACON #18 SUBSURFACE LOGS
SCALE: AS NOTED

LEGEND	
B17-1	APPROXIMATE BORING LOCATION

No.	Submittal / Revision	App'd By	Date
1	RECORD DRAWINGS	HAW HAW	07/07/13

STATE OF VERMONT
AGENCY OF TRANSPORTATION

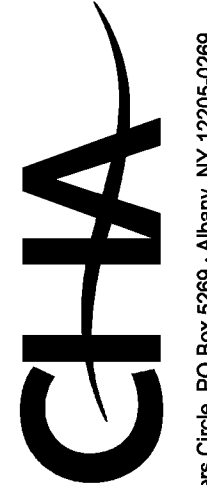
 III Winners Circle, PO Box 5089 - Albany, NY 12205-0289
 Main: (616) 433-4500 • www.chiacompanies.com
 Designed: HAW | Drawn: HAW | Checked: TYL

HARTNESS STATE AIRPORT
 HAZARD BEACON REPLACEMENT
 SUBSURFACE LOG PLANS
 Issue Date: 03/18/11 | Project No.: 21674 | Scale: As Shown

RECORD DRAWING 07/07/13

C-005

File: V:\PROJECTS\NYA\21674\CADD\ACAD\...SHEET_FILES\C005-21674.DWG
 Saved: 1/4/2013 4:15:56 PM Plotted: 1/4/2013 4:27:32 PM User: Wjrd, Heather LostSvedBy: 2789