



File: V:\PROJECTS\NYA\21674\CADD\CADD\...SHEET_FILES\C101-21674.DWG
 Saved: 1/4/2013 4:16:20 PM Printed: 1/4/2013 4:28:54 PM User: Wjvd, Heather LastSavedBy: 2789

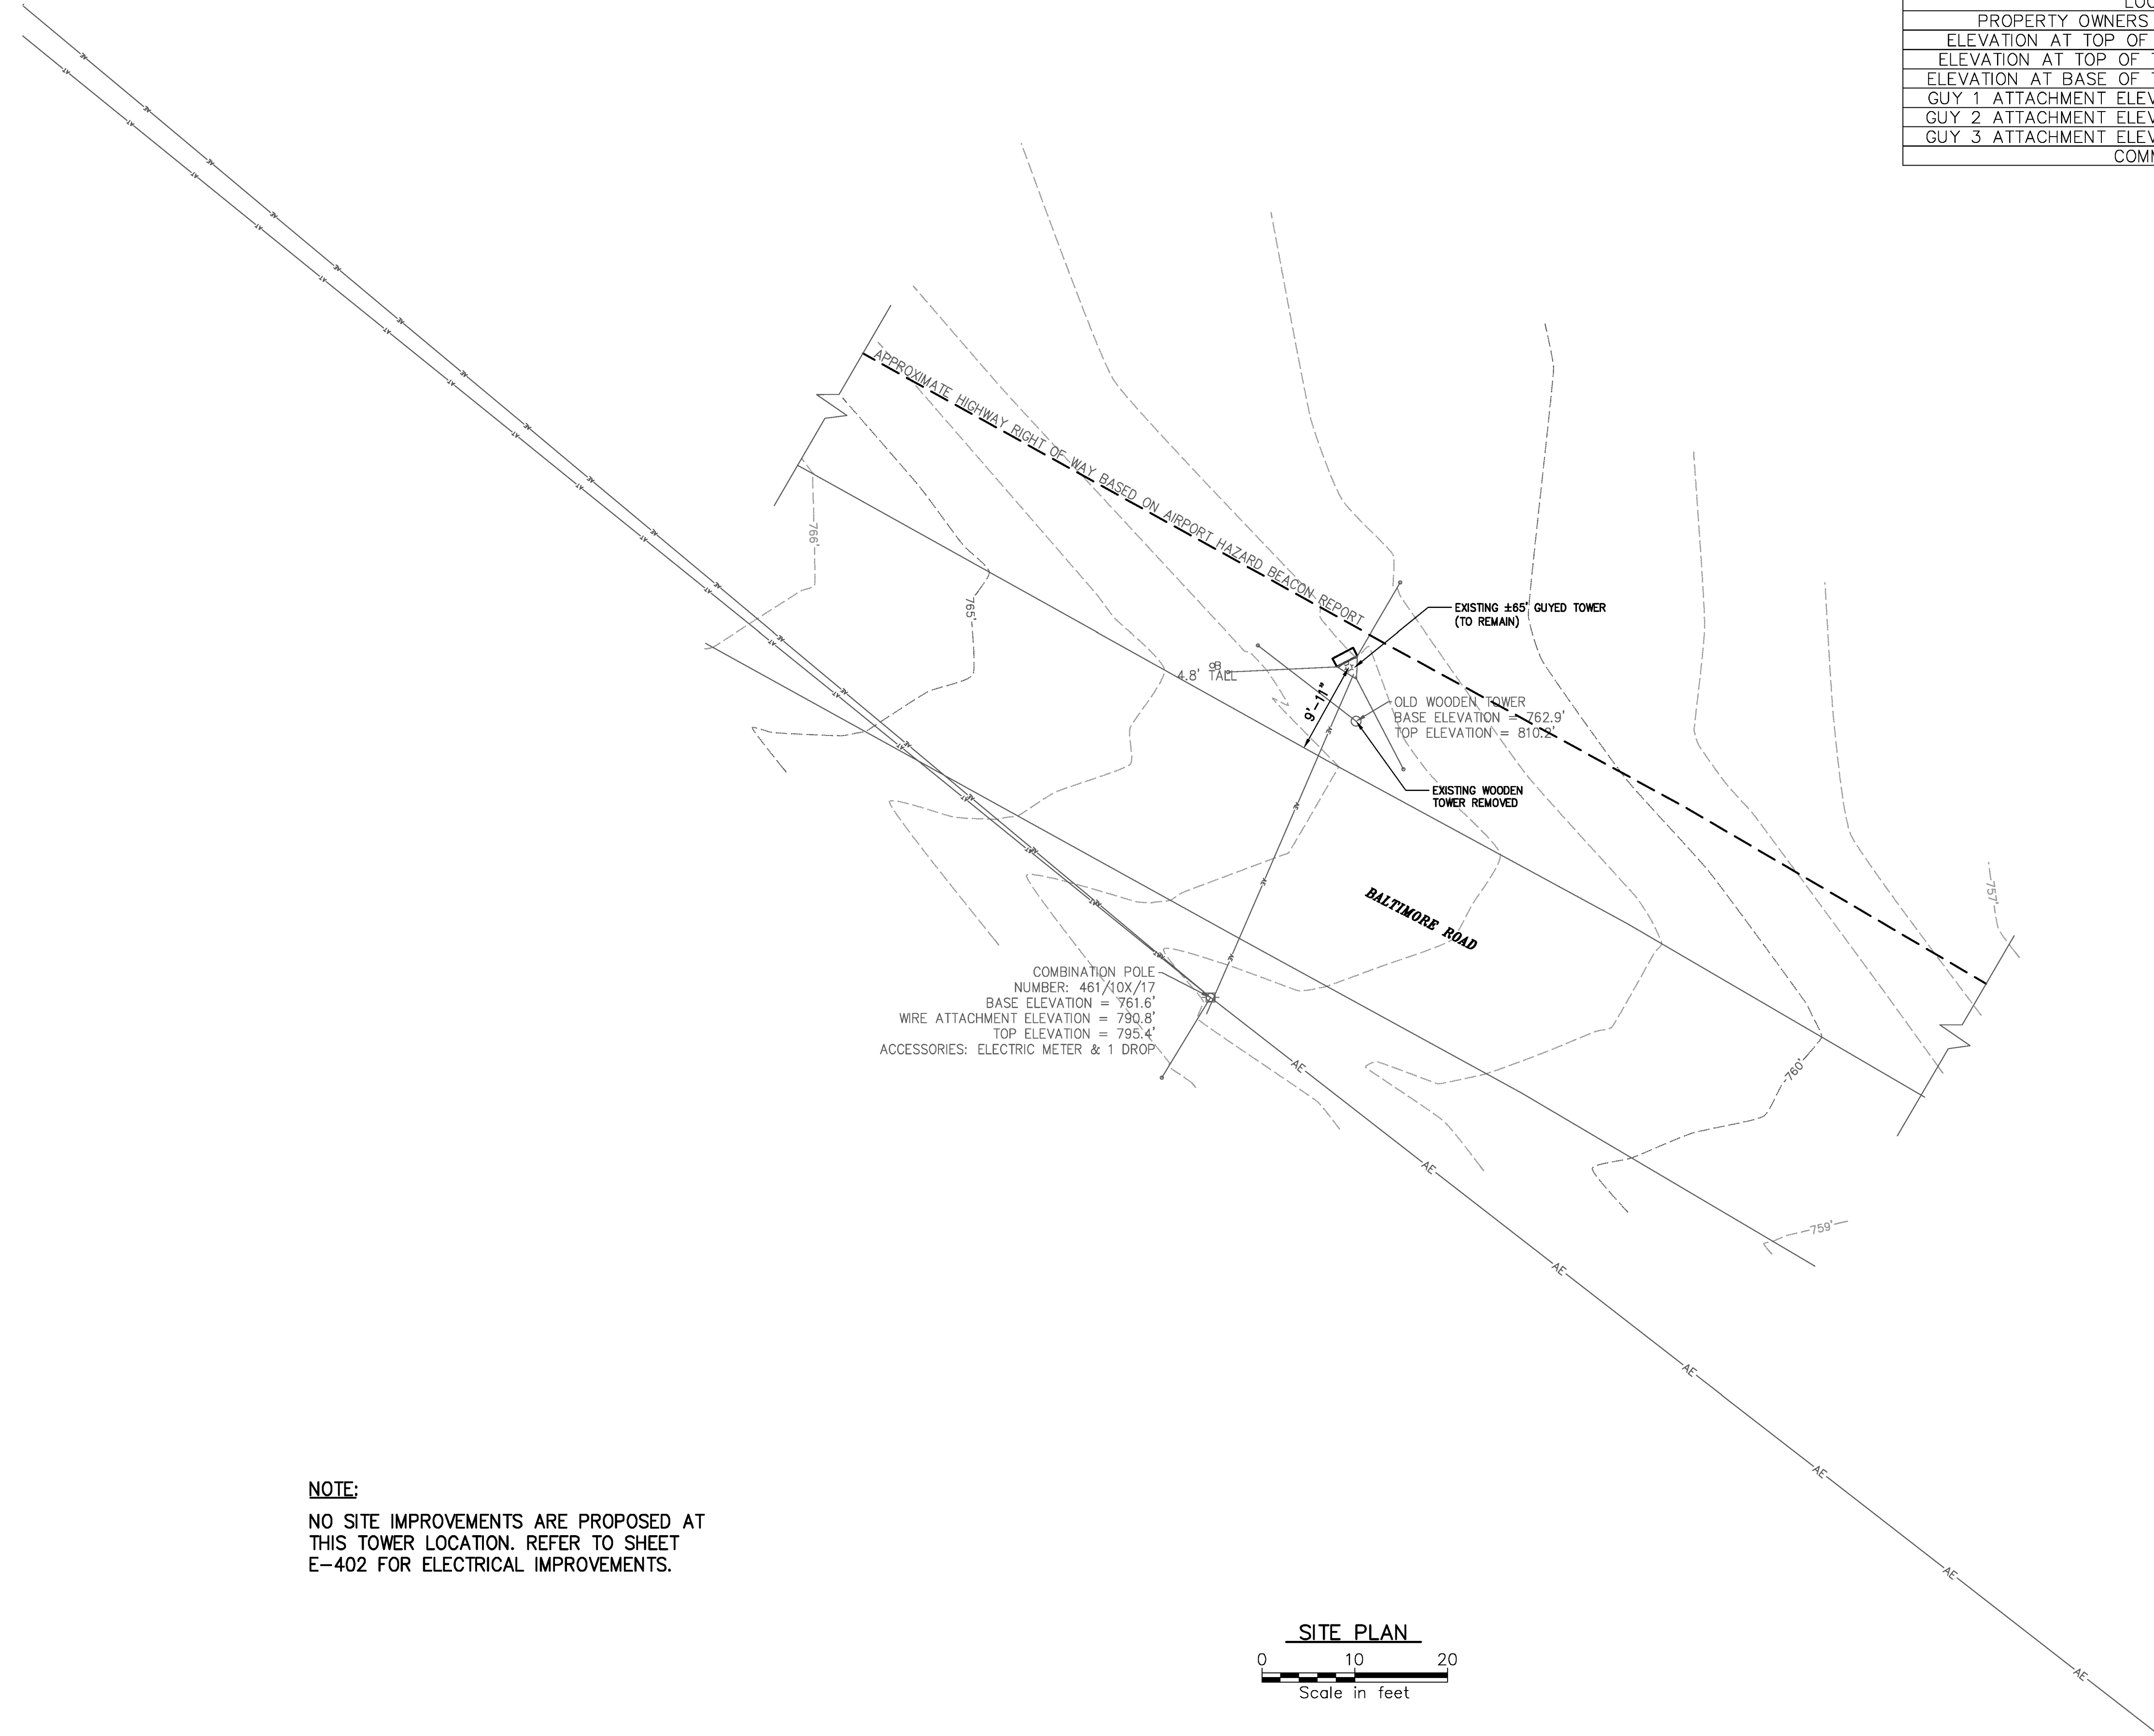

NOTE:
 NO SITE IMPROVEMENTS ARE PROPOSED AT THIS TOWER LOCATION. REFER TO SHEET E-402 FOR ELECTRICAL IMPROVEMENTS.

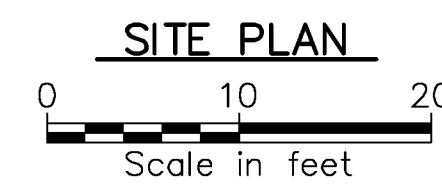

EXISTING SITE STATISTICS

BEACON #	1
LOCATION	BIBBENS
PROPERTY OWNERS NAME	TOWN HIGHWAY # 8 R.O.W.
ELEVATION AT TOP OF LIGHT	830.5'
ELEVATION AT TOP OF TOWER	827.8'
ELEVATION AT BASE OF TOWER	762.3'
GUY 1 ATTACHMENT ELEVATION	797.8'
GUY 2 ATTACHMENT ELEVATION	797.8'
GUY 3 ATTACHMENT ELEVATION	797.8'
COMMENTS	THERE ARE NO TREES NEAR THIS TOWER

App'd By	Date
HAW HAW	01/07/13
Submitter / Revision	
RECORD DRAWINGS	

STATE OF VERMONT
 AGENCY OF TRANSPORTATION

UNAUTHORIZED ALTERATION OR ADDITION OF ANY INFORMATION IS PROHIBITED AND WILL BE PUNISHED BY APPLICABLE STATE AND/OR LOCAL LAWS

III Winners Circle, PO Box 5589 - Albany, NY 12205-0289
 Main: (518) 453-4500 • www.chiacompanies.com

Designed: HAW Drawn: HAW Checked: TYL

HARTNESS STATE AIRPORT
 HAZARD BEACON REPLACEMENT

BEACON 1 SITE PLAN

Issue Date: 03/18/11 Project No.: 21674 Scale: As Shown

RECORD DRAWING 01/07/13

C-101