

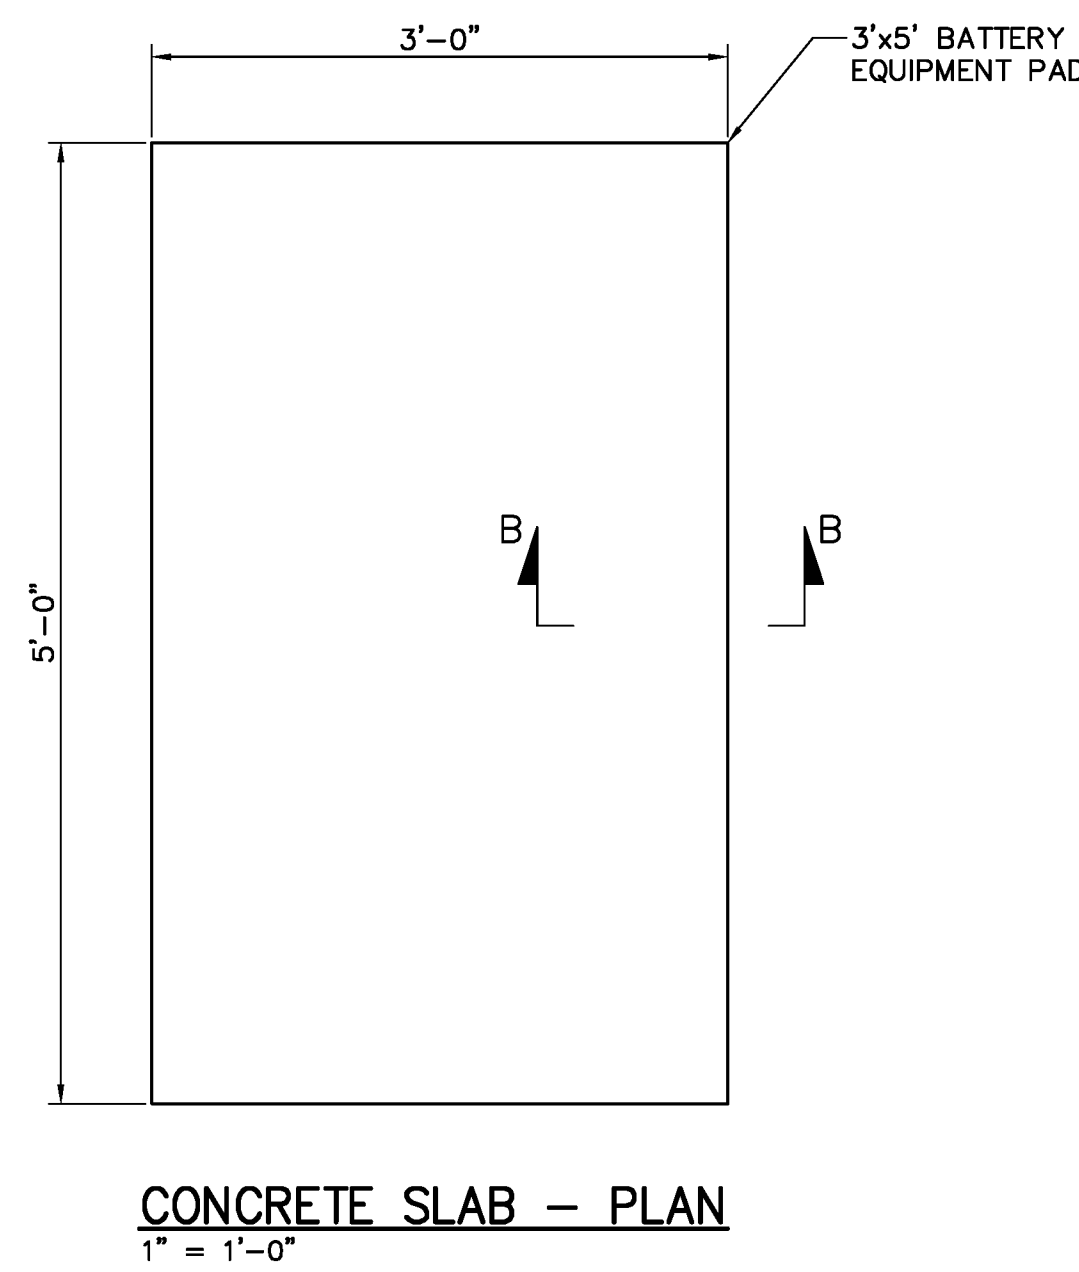


File: V:\PROJECTS\NYA\21674\CADD\CADD\SHR\FILES\S101-21674.DWG  
 Saved: 1/4/2013 4:18:49 PM Plotted: 1/4/2013 4:31:23 PM User: Wyo, Heather Last Saved By: 2789

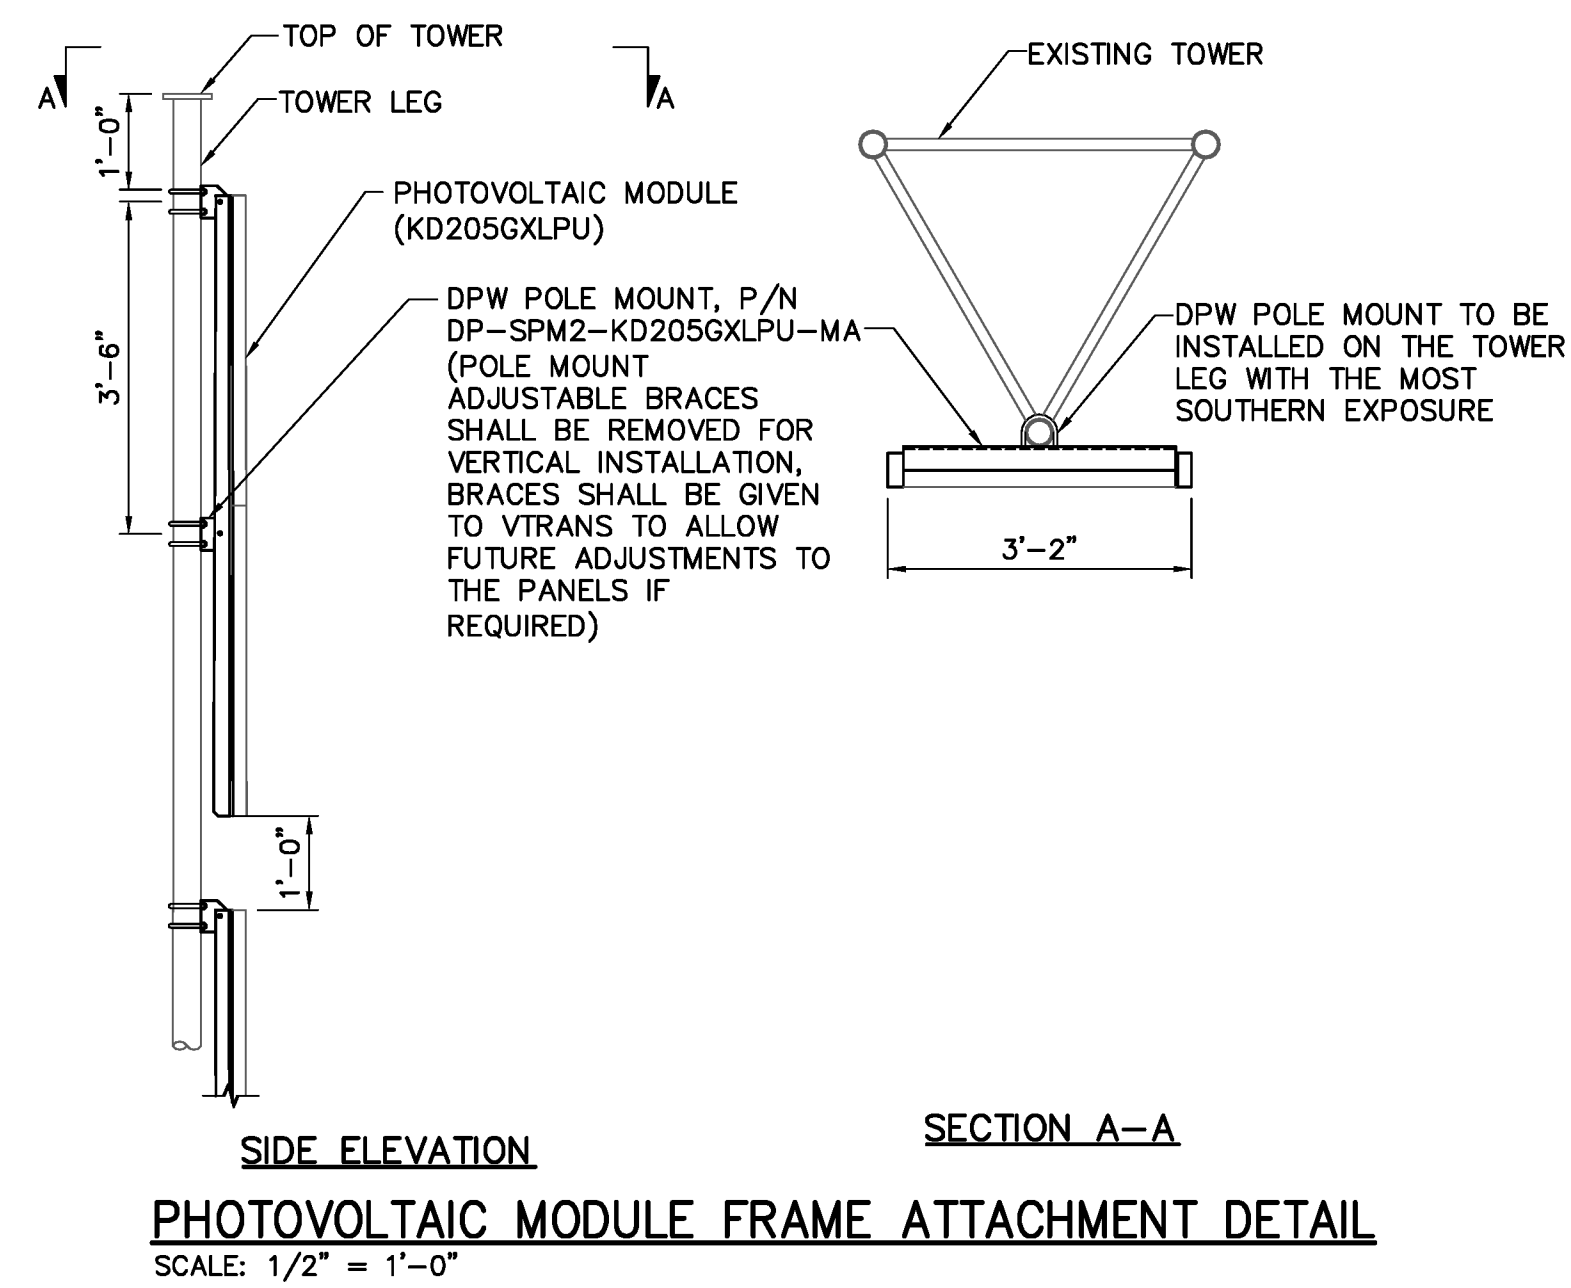

- NOTE:**
- TOP OF FOUNDATION ELEVATION TOLERANCE 1/4" IN 10'-0" & 1/2" MAX OVERALL.
  - CONCRETE SHALL BE AIR-ENTRAINED AND HAVE A MINIMUM COMPRESSIVE STRENGTH OF 4000 PSI.

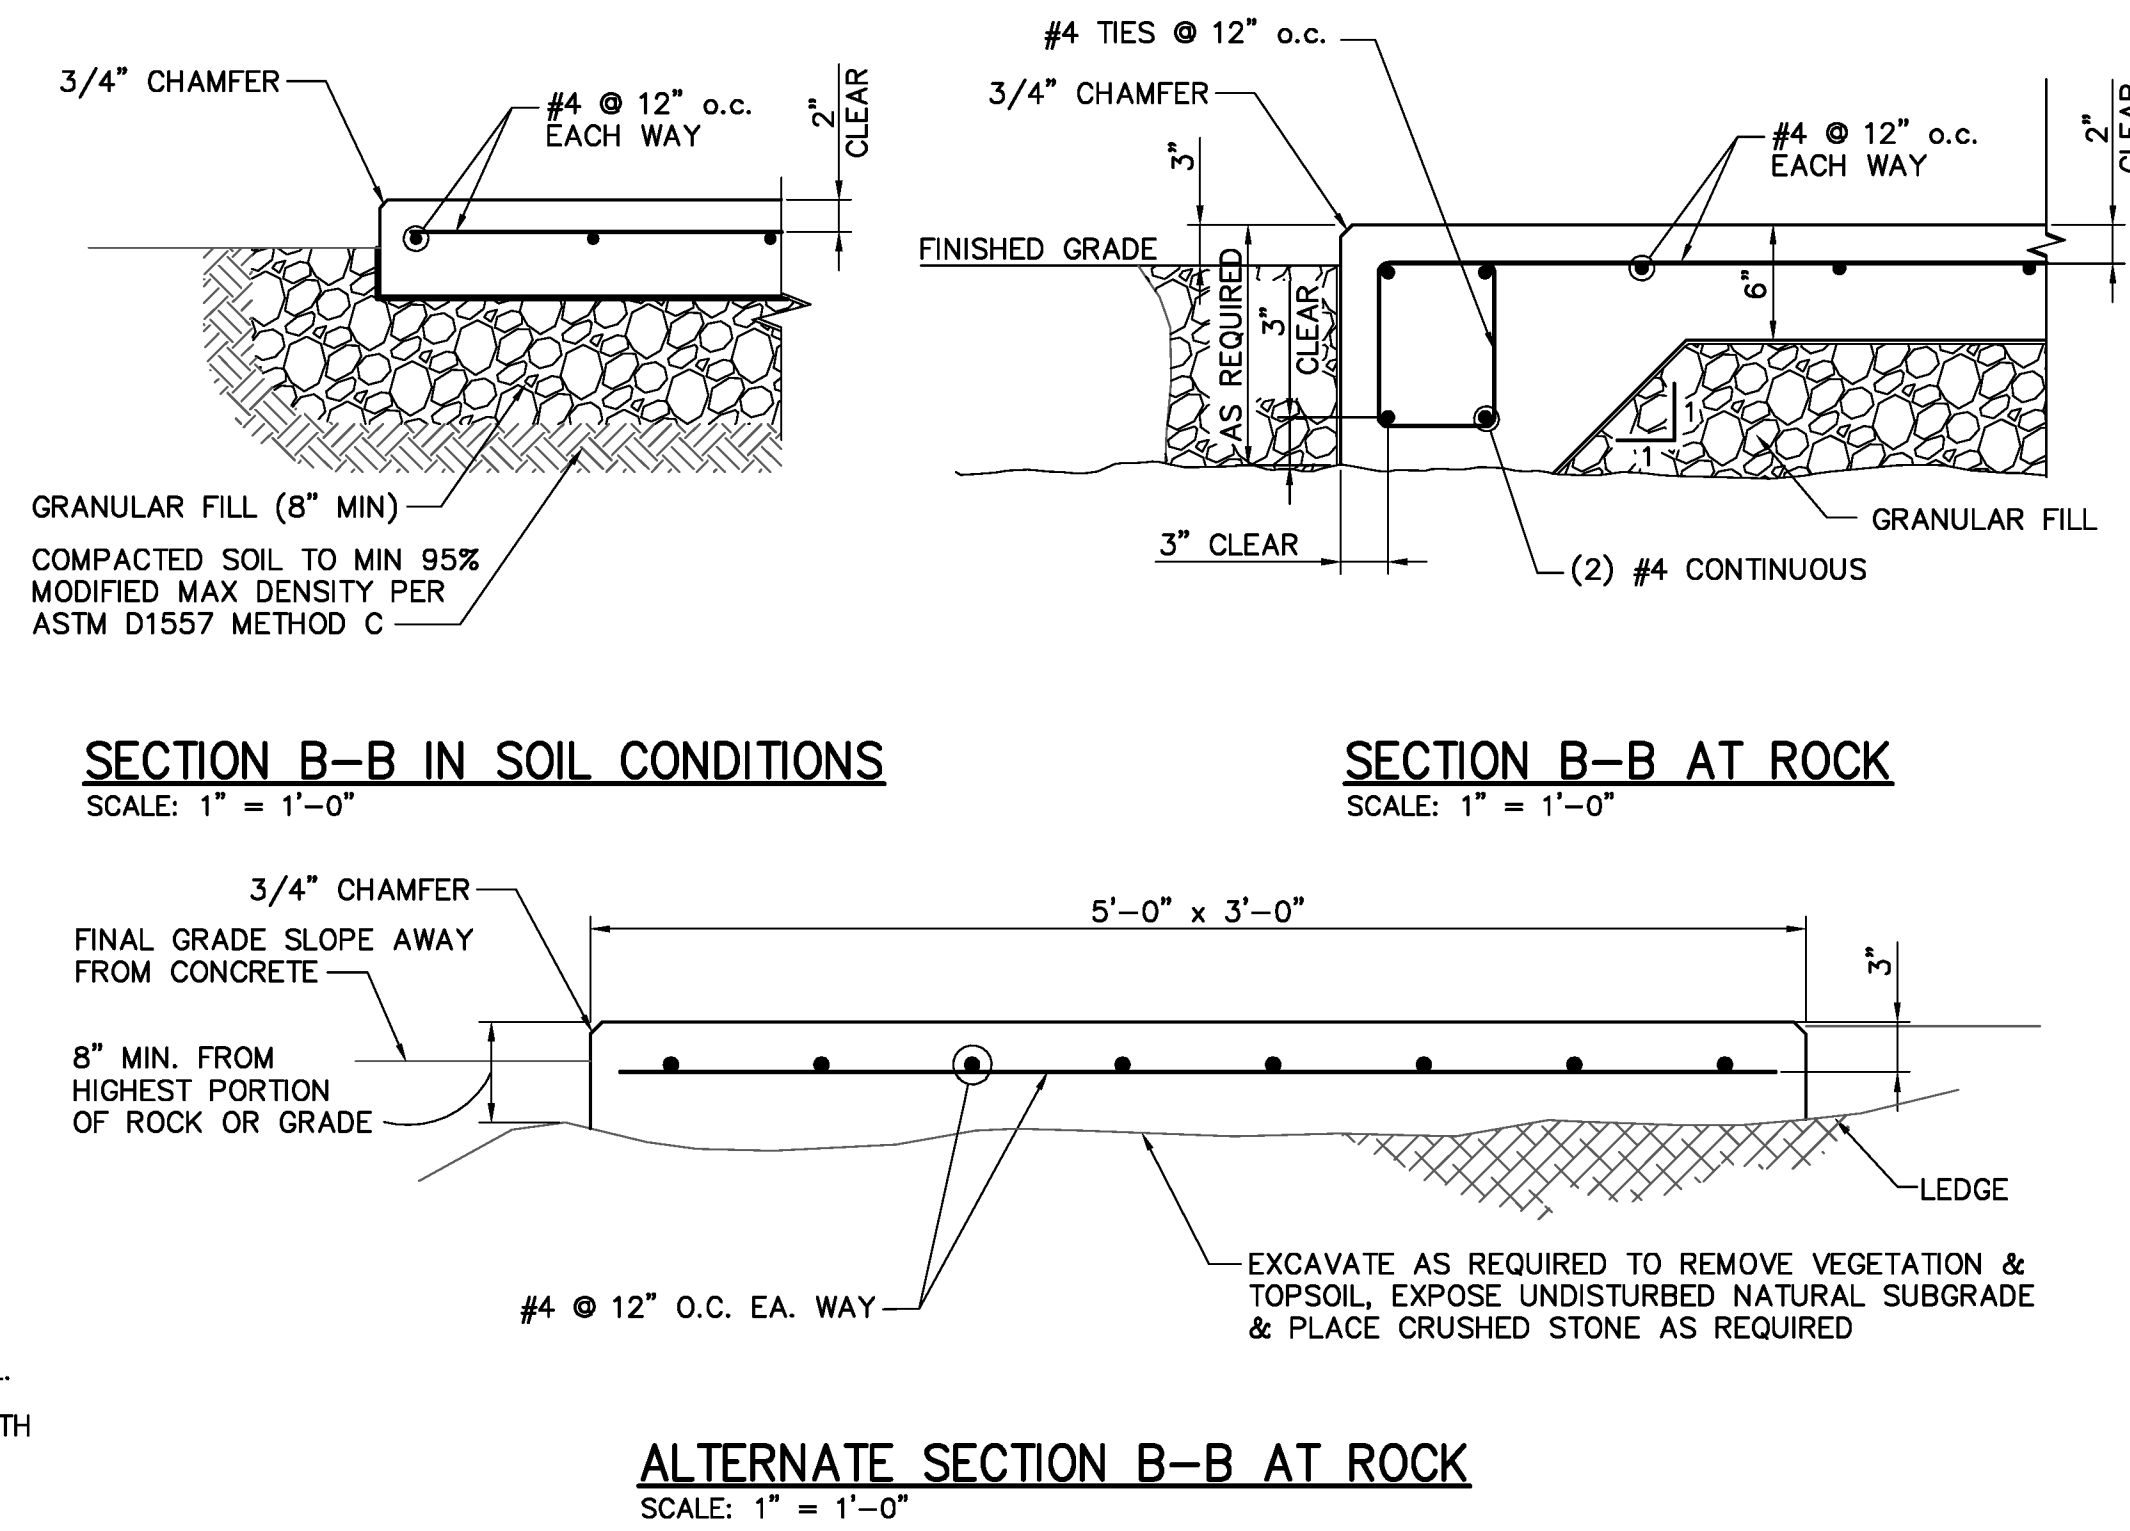

**RECORD DRAWING** 01/07/13

No.	Submit / Revision	App'd By	Date
1	RECORD DRAWINGS	HAW	01/07/13

STATE OF VERMONT  
 AGENCY OF TRANSPORTATION

UNAUTHORIZED ALTERATION OR ADDITION  
 OF ANY PART OF THIS DRAWING IS PROHIBITED  
 APPLICABLE STATE AND/OR LOCAL LAWS

III Winners Circle, PO Box 5589 - Albany, NY 12205-0289  
 Main: (518) 453-4500 · www.chiacompanies.com

Designed: JUS Drawn: BAS Checked: DD

HARTNESS STATE AIRPORT  
 HAZARD BEACON REPLACEMENT

STRUCTURAL DETAILS

Issue Date: 03/18/11 Project No.: 21674 Scale: As Shown

**S-101**