

VICINITY MAP


# STATE OF VERMONT AGENCY OF TRANSPORTATION




## PROPOSED IMPROVEMENT TOWN OF CLARENDON COUNTY OF RUTLAND

### RUTLAND SOUTHERN VERMONT REGIONAL AIRPORT

RUNWAY 19 SAFETY AREA IMPROVEMENTS, PHASE II  
TO INCLUDE WIDEN AND EXTEND  
RUNWAY 19 SAFETY AREA (400' X 600')

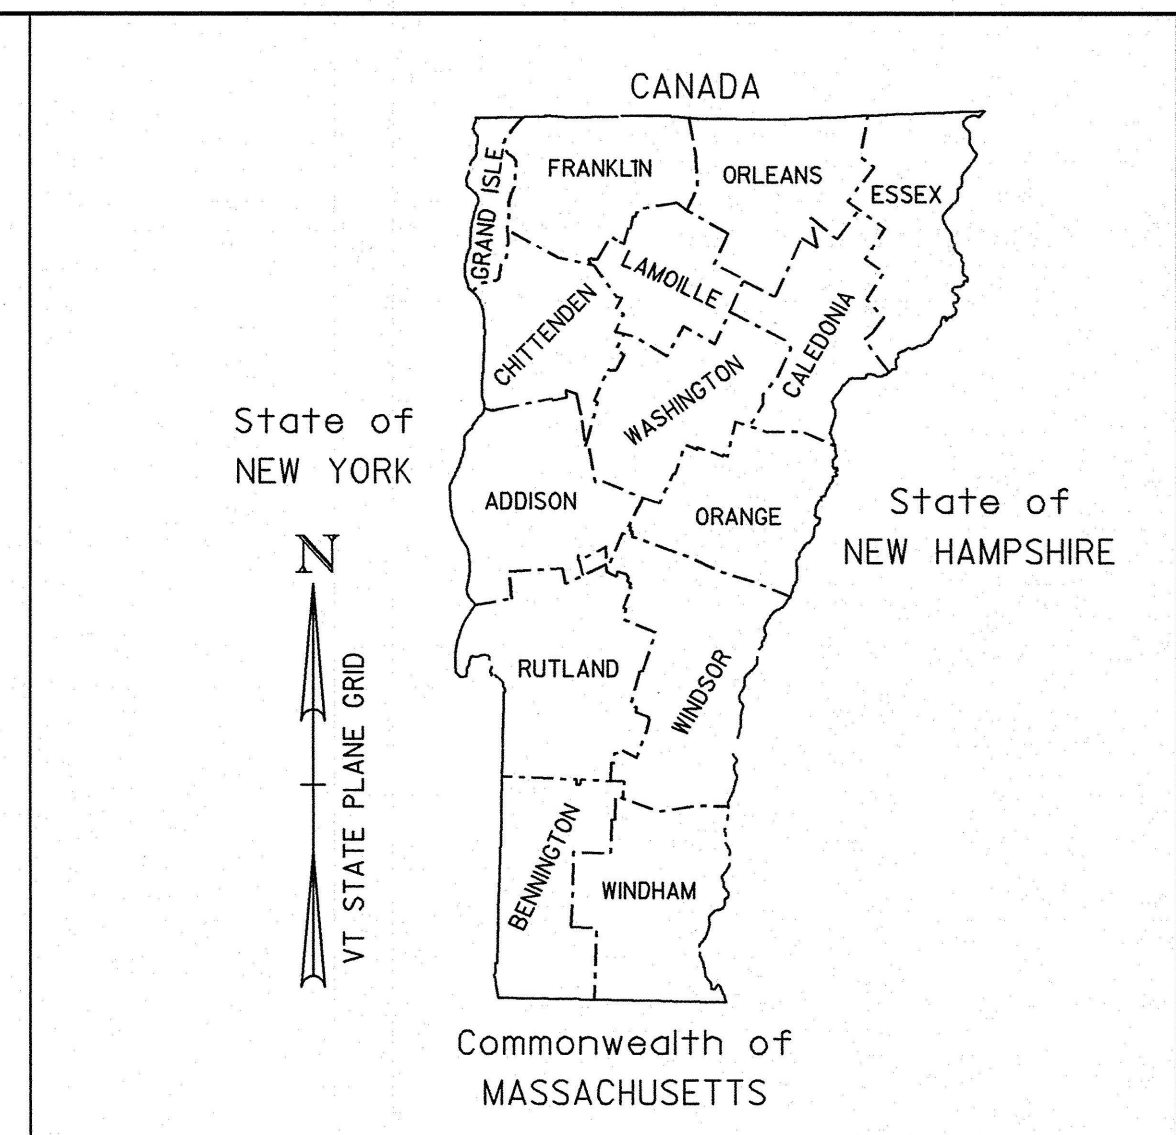

**Record Drawings**  
Prepared by DuBois & King as VTTrans project resident engineer. Contract drawings have been noted to identify general project modifications and/or the completion of work in general conformance with contract plans.

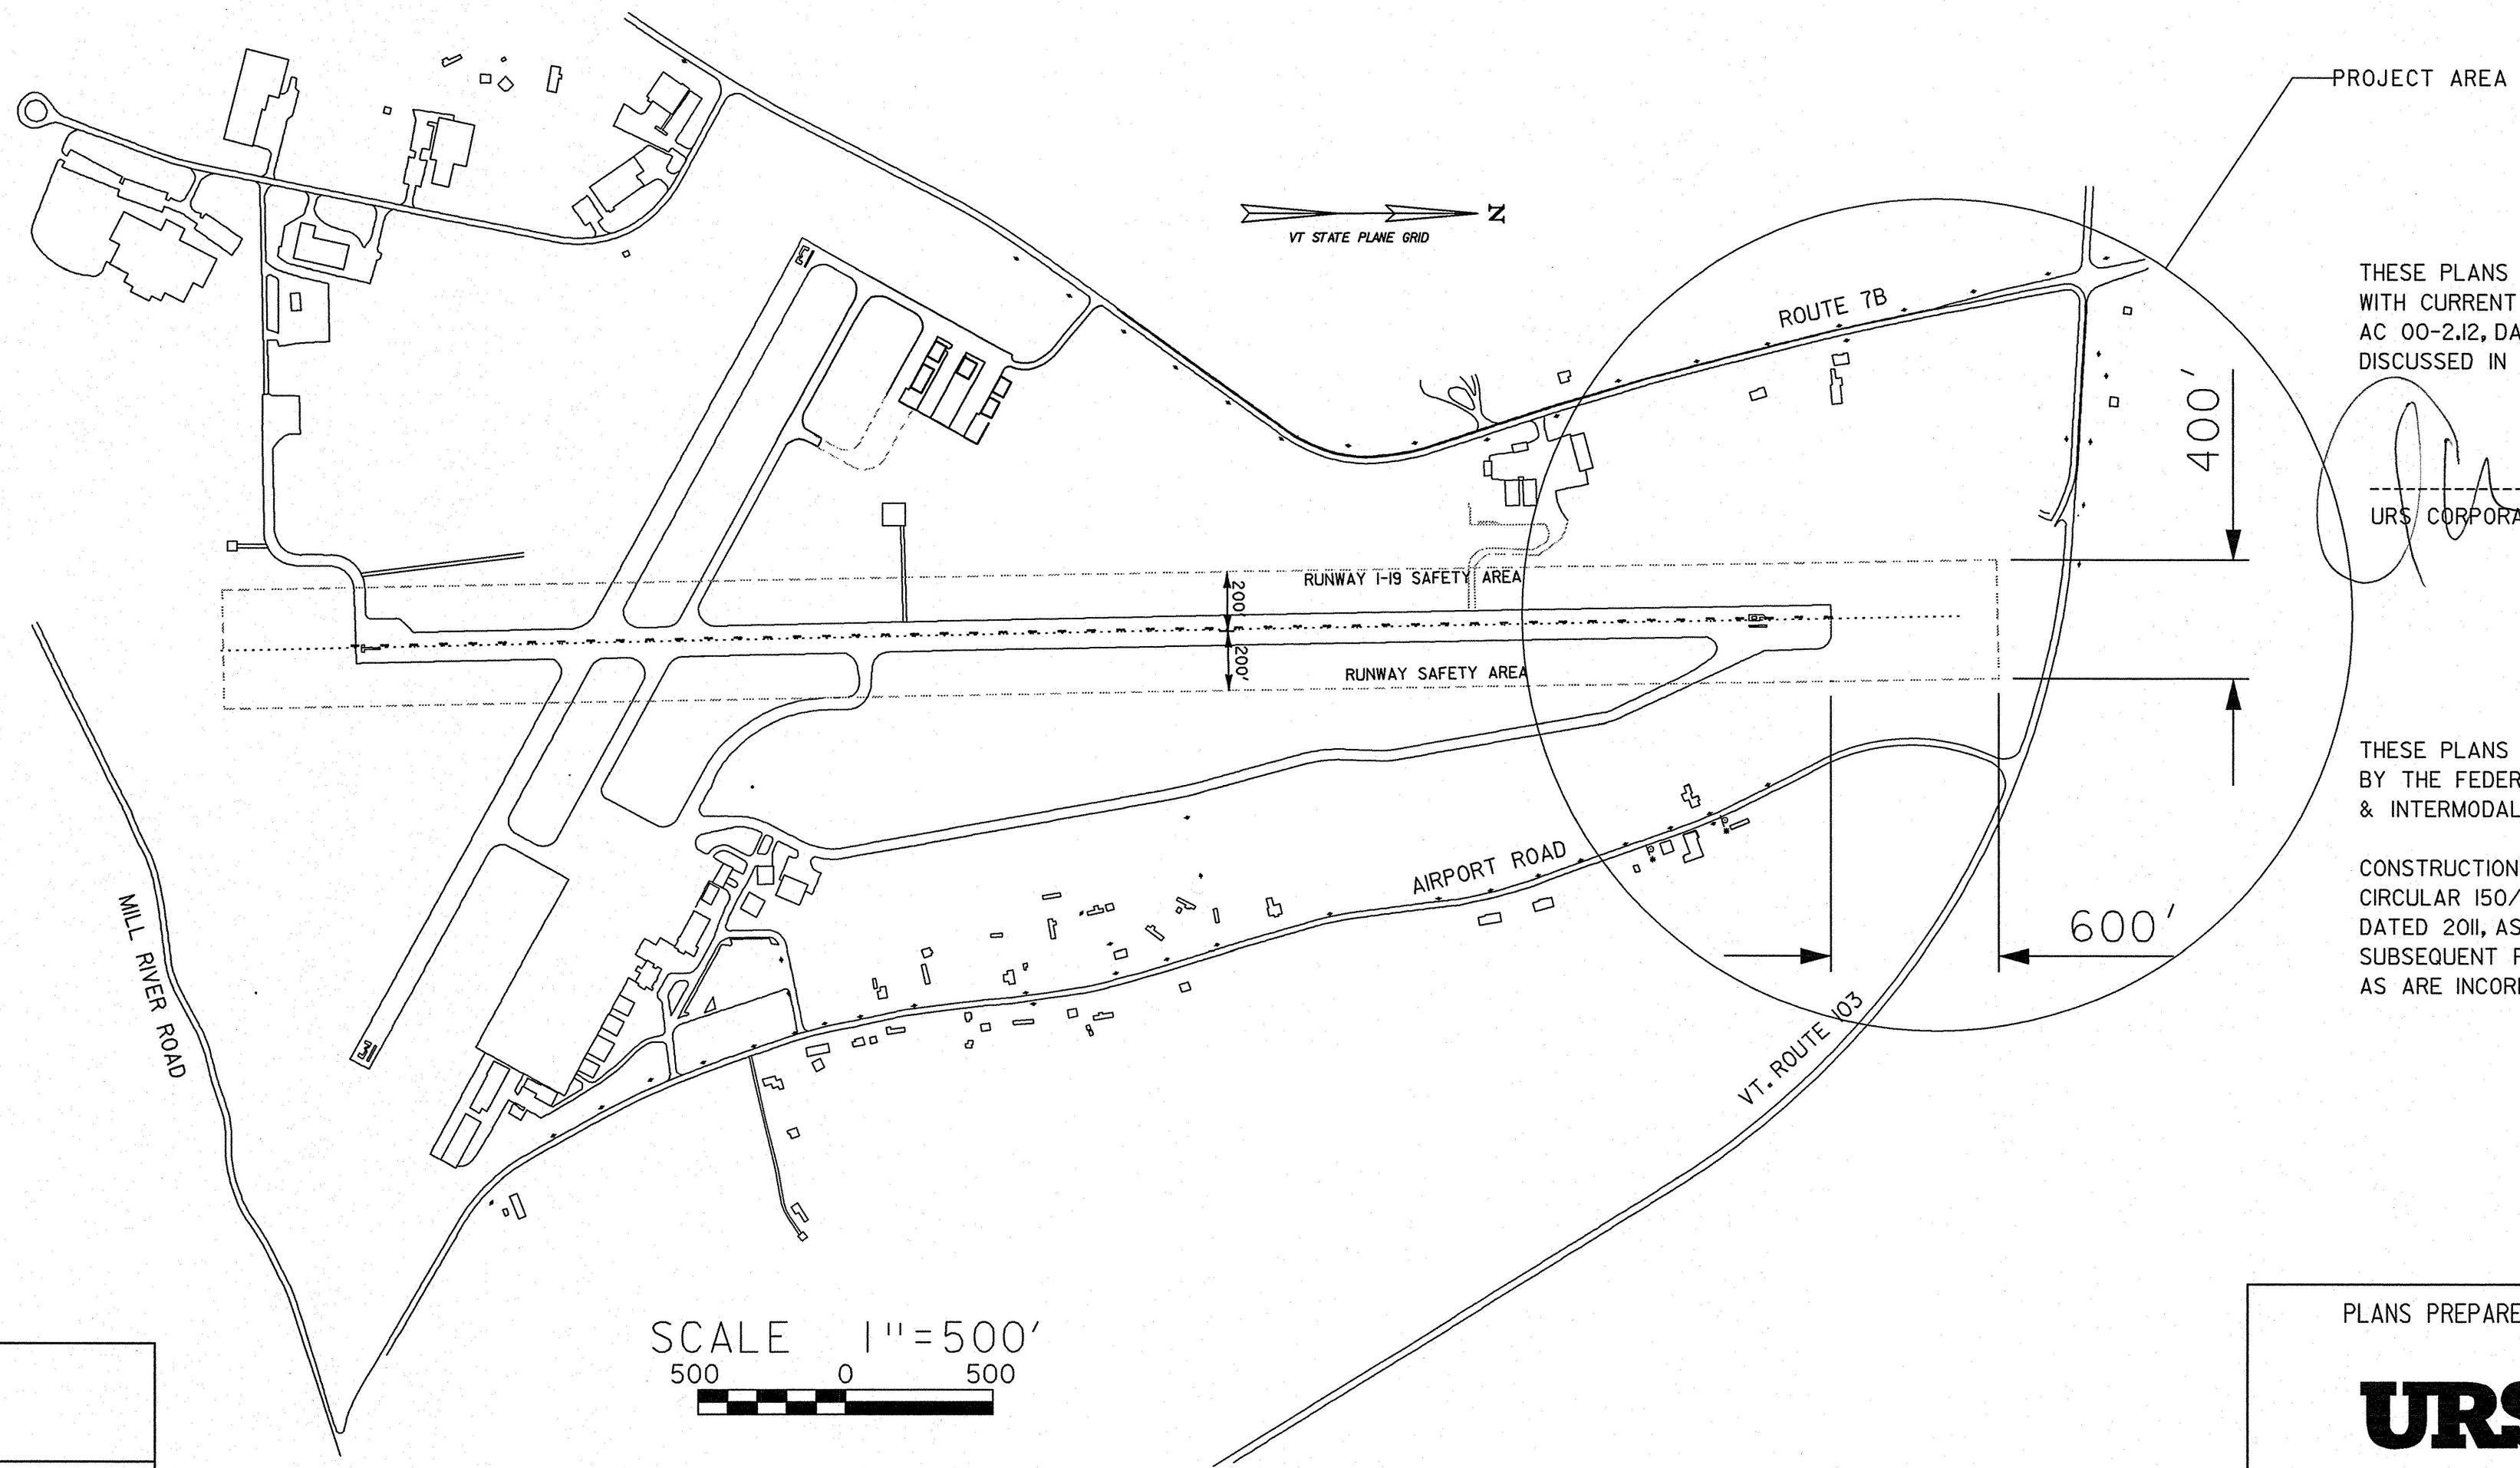

**DESIGN CERTIFICATION**

THESE PLANS AND SPECIFICATIONS HAVE BEEN PREPARED IN ACCORDANCE WITH CURRENT FAA STANDARDS IDENTIFIED IN ADVISORY CIRCULAR CHECKLIST, AC 00-2.12, DATED JANUARY 25, 2012. DEVIATIONS FROM FAA STANDARDS ARE DISCUSSED IN THE ENGINEER'S REPORT, DATED FEBRUARY, 2013.


URS CORPORATION 5-31-13  
DATE

**STANDARD NOTE**

THESE PLANS ARE SUBJECT TO SUCH ENGINEERING CHANGES AS MAY BE REQUIRED BY THE FEDERAL AVIATION ADMINISTRATION OR THE DIRECTOR OF POLICY, PLANNING & INTERMODAL DEVELOPMENT.

CONSTRUCTION IS TO CARRIED ON IN ACCORDANCE WITH THESE PLANS, FAA ADVISORY CIRCULAR 150/5370-10F, AND THE STANDARD SPECIFICATIONS FOR CONSTRUCTION, DATED 2011, AS APPROVED BY THE FEDERAL HIGHWAY ADMINISTRATION INCLUDING ALL SUBSEQUENT REVISIONS AND SUCH REVISED SPECIFICATIONS AND SPECIAL PROVISIONS AS ARE INCORPORATED IN THESE PLANS.

CONVENTIONAL SYMBOLS	
COUNTY LINE	
TOWN LINE	
LIMITS OF ACCESS	
POINT OF ACCESS	
FENCE LINE	
STONE WALL	
TRAVELED WAY	
GUARD RAIL	
RAILROAD	
SURVEY LINE	
CULVERT	
POWER POLE	
TELEPHONE POLE	
TREES	
CONTROL OF ACCESS	
PROPERTY LINE	
R.O.W. TAKING LINE	
SLOPE RIGHTS	
TOP OF CUT	
TOE OF SLOPE	

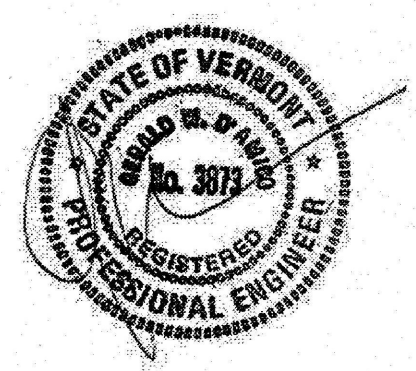

SURVEYED BY :  
SURVEYED DATE :  
DATUM  
VERTICAL NGVD 88  
HORIZONTAL NAD 83

SCALE 1" = 500'  
500 0 500

URS PROJECT NO.  
38397234

PLANS PREPARED BY:  
**URS**  
URS CORPORATION  
3 CORPORATE DRIVE, SUITE 203  
CLIFTON PARK, NY 12065  
PH# (518) 688-0015

DEPARTMENT OF TRANSPORTATION FEDERAL AVIATION ADMINISTRATOR	APPROVED _____ DATE _____
DIRECTOR, POLICY PLANNING, AND INTERMODAL DEVELOPMENT	APPROVED _____ DATE _____
PROJECT MANAGER : SCOTT FORTNEY	
PROJECT NAME : RUTLAND SOUTHERN VERMONT REGIONAL AIRPORT-CLARENDON, VERMONT	
PROJECT NUMBER : AV114-8018-300	
SHEET 1 OF 36	