

# INDEX OF SHEETS

## INDEX OF SHEETS

1	TITLE SHEET
2	INDEX OF SHEETS
3	QUANTITY SHEET
4	DRAINAGE SHEET
5	GENERAL PROJECT LAYOUT
6	TYPICAL SECTIONS - RUNWAY SAFETY AREA
7	RUNWAY SAFETY AREA PROFILE
8	CONSTRUCTION SAFETY & PHASING PLAN - PHASE 2A
9	CONSTRUCTION SAFETY & PHASING PLAN - PHASE 2B
10	CONSTRUCTION SAFETY & PHASING PLAN - PHASE 2C
11	SAFETY PHASING PLAN, NOTES & DETAILS (1)
12	SAFETY PHASING PLAN, NOTES & DETAILS (2)
13	GEOMETRY PLAN
14	RUNWAY SAFETY AREA - GRADING PLAN
15	DRAINAGE PLAN
16	RUNWAY SAFETY AREA-DRAINAGE PROFILES
17	RUNWAY MARKING PLAN
18	RUNWAY MARKING PLAN DETAILS
19	REINFORCED SOIL SLOPE (RSS) PLAN, TYPICAL SECTIONS & DETAILS
20	REINFORCED SOIL SLOPE (RSS) NOTES
21	SEGMENTAL RETAINING WALL AND REINFORCED PAD NOTES
22	SEGMENTAL RETAINING WALL AND REINFORCED PAD PLAN
23	SEGMENTAL RETAINING WALL DEVELOPED ELEVATION 1
24	SEGMENTAL RETAINING WALL DEVELOPED ELEVATION 2
25	SEGMENTAL RETAINING WALL AND CONCRETE BUTTRESS DETAILS
26	BORING AND TEST PIT LOGS
27	TEMPORARY PAPI INSTALLATION DETAILS
28	TEMPORARY PAPI PLAN
29	RETAINING WALL DETAILS
30-36	RSA CROSS SECTIONS

## INDEX OF EROSION CONTROL SHEETS


EC-1	EXISTING CONDITIONS PLAN-RUNWAY SAFETY AREA
<del>EC-2</del>	<del>EXISTING CONDITIONS PLAN-BORROW AREA</del> NIC
EC-3	SOIL CLASSIFICATIONS-RUNWAY SAFETY AREA
<del>EC-4</del>	<del>SOIL CLASSIFICATIONS-BORROW AREA</del> NIC
EC-5	EROSION PROTECTION & SEDIMENT CONTROL-PHASE 1
EC-6	EROSION PROTECTION & SEDIMENT CONTROL-PHASE 2A
EC-7	EROSION PROTECTION & SEDIMENT CONTROL-PHASE 2B
EC-8	EROSION PROTECTION & SEDIMENT CONTROL-PHASE 2C
<del>EC-9</del>	<del>EROSION PROTECTION &amp; SEDIMENT CONTROL-BORROW AREA</del> NIC
EC-10	SOIL EROSION & SEDIMENT CONTROL PLAN-DETAIL
EC-11	EROSION PROTECTION & SEDIMENT CONTROL DETAILS (2)
EC-12	EROSION PROTECTION & SEDIMENT CONTROL DETAILS (3)
EC-13	EROSION CONTROL NARRATIVE-RUNWAY SAFETY AREA
<del>EC-14</del>	<del>EROSION CONTROL NARRATIVE-BORROW AREA</del> NIC
WM-1	AIRPORT WETLAND MAP
WM-2	PROJECT WETLAND IMPACT

## FAA PROVIDED DRAWINGS

RUT-NEZ120015-G001	MALSR RWY 19	COVER SHEET
RUT-NEZ120015-G002	MALSR RWY 19	INDEX SHEET
RUT-NEZ120015-G003	MALSR RWY 19	GENERAL NOTES
RUT-NEZ120015-C001	MALSR RWY 19	FACILITY SITE PLAN
RUT-NEZ120015-C002	MALSR RWY 19	MISC. DETAILS
RUT-NEZ120015-C003	MALSR RWY 19	GRAVEL ACCESS ROAD
RUT-NEZ120015-S001	MALSR RWY 19	FOUNDATION DESIGN LIR STRUCTURE STA. 2+00 AND 3+80
RUT-NEZ120015-S002	MALSR RWY 19	FOUNDATION DESIGN LIR STRUCTURE STA. 5+70
RUT-NEZ120015-Q001	MALSR RWY 19	EQUIPMENT INSTALLATION STA. 2+00 AND 3+80
RUT-NEZ120015-Q002	MALSR RWY 19	EQUIPMENT INSTALLATION STA. 5+70
RUT-NEZ120015-Q003	MALSR RWY 19	LOW IMPACT RESISTANT (LIR) STRUCTURE ASSEMBLY AND MOUNTING DETAILS
RUT-NEZ120015-E001	MALSR RWY 19	ELECTRICAL DETAILS
RUT-NEZ120016-C001	VASI RUNWAY 19	SERVICE ENTRANCE REPLACEMENT
RUT-NEZ120016-C002	VASI RUNWAY 19	MISCELLANEOUS DETAILS SHEET 1 OF 2
RUT-NEZ120016-C003	VASI RUNWAY 19	MISCELLANEOUS DETAILS SHEET 2 OF 2

## VAOT STANDARD DRAWINGS

A-61	STANDARD TYPICAL FOR SLOPES IN SOLID ROCK EXCAVATION DRILLING AND BLASTING OF SOLID ROCK SUBGRADE
B-5	EMBANKMENT ON EARTH SLOPE
B-11	METHODS OF SLOPE STABILIZATION
D-3	TREATED GUTTERS
D-4	CORRUGATED PIPE END SECTION
D-6	REINFORCED CONCRETE DROP INLET WITH GRATE FOR USE IN DITCHES
D-15	PRECAST REINFORCED CONCRETE MANHOLE W/CAST IRON COVER
E-100	CONSTRUCTION APPROACH SIGNS
E-107A	DELINEATION, BARRICADES AND DETOURS FOR CONSTRUCTION AREAS
E-164	SQUARE STEEL SIGN POST
F-2	CHAIN LINK FENCE, DRIVE GATE, WALK GATE (TYPE 1)

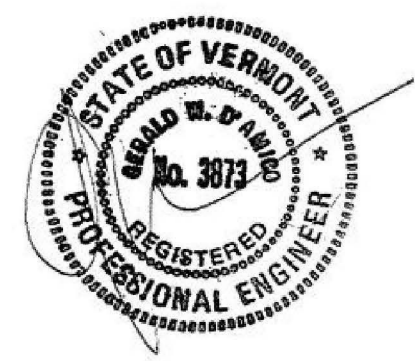

AIP 3-50-0015-34

## VERMONT AGENCY OF TRANSPORTATION



PROJECT NAME:	RUTLAND SOUTHERN VERMONT REGIONAL AIRPORT CLARENDON, VERMONT
PROJECT NUMBER:	AV14-8018-300
FILE NAME:	z07h124 index.dgn
DESIGNED BY:	M. WASSON
CHECKED BY:	
INDEX SHEET	
PLOT DATE:	6/2/2013
DRAWN BY:	M. WASSON
CHECKED BY:	
SHEET 2 OF 36	

PROJECT RECORD DRAWINGS