




Record Drawing
 Finished grades are shown on
 Attachment A: Construction Survey
 Record Plan

PROPOSED RUNWAY SAFETY AREA EXTENSION

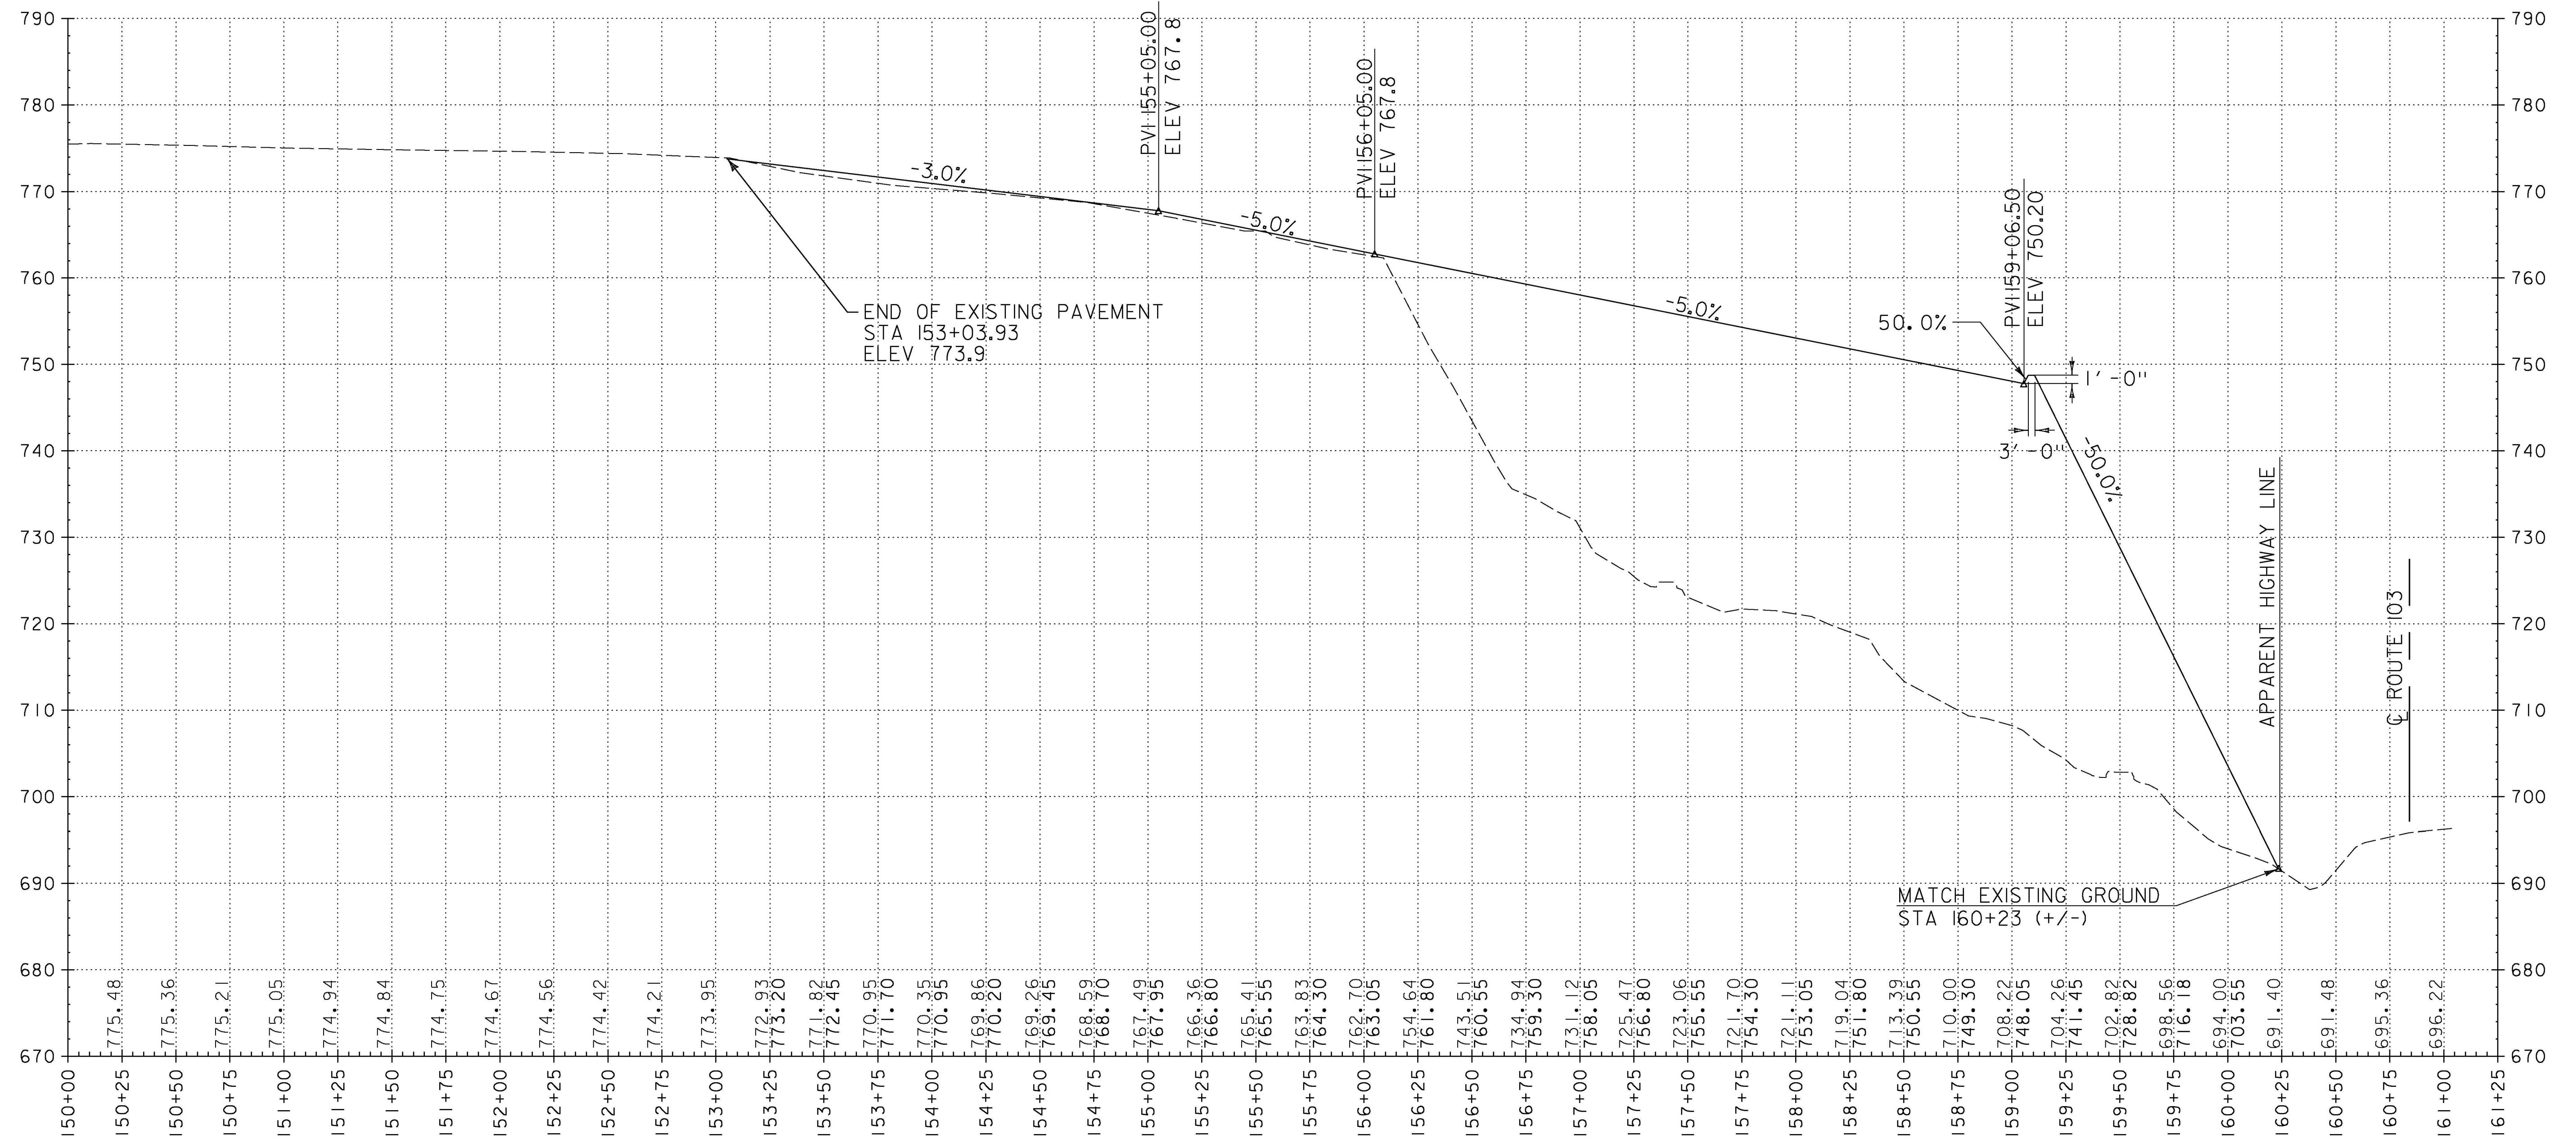

LINE	SURFACE
—	PROPOSED
- - - -	EXISTING

Scaled 4 Times Ver.
 Scaled 1 Times Hor.

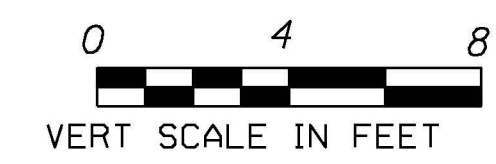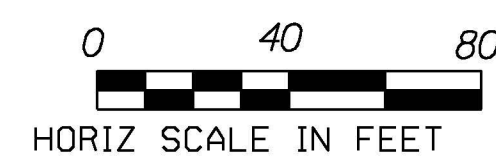

AIP 3-50-0015-34

VERMONT AGENCY OF TRANSPORTATION



URS CORPORATION
 3 CORPORATE DRIVE, SUITE 203
 CLIFTON PARK, NY 12065
 (518) 688-0015

PROJECT NAME: RUTLAND SOUTHERN VERMONT REGIONAL AIRPORT
 CLARENDON, VERMONT
 PROJECT NUMBER: AV14-8018-300

FILE NAME: z07h124pro_rsa.dgn
 PROJECT LEADER: F. WALSH
 DESIGNED BY: G. D'AMICO
 RUNWAY SAFETY AREA PROFILE

PLOT DATE: 6/2/2013
 DRAWN BY: M. KEMP
 CHECKED BY:
 SHEET 7 OF 36

PROJECT RECORD DRAWINGS