


Record Drawings
 Work completed in general conformance
 with contract plans.


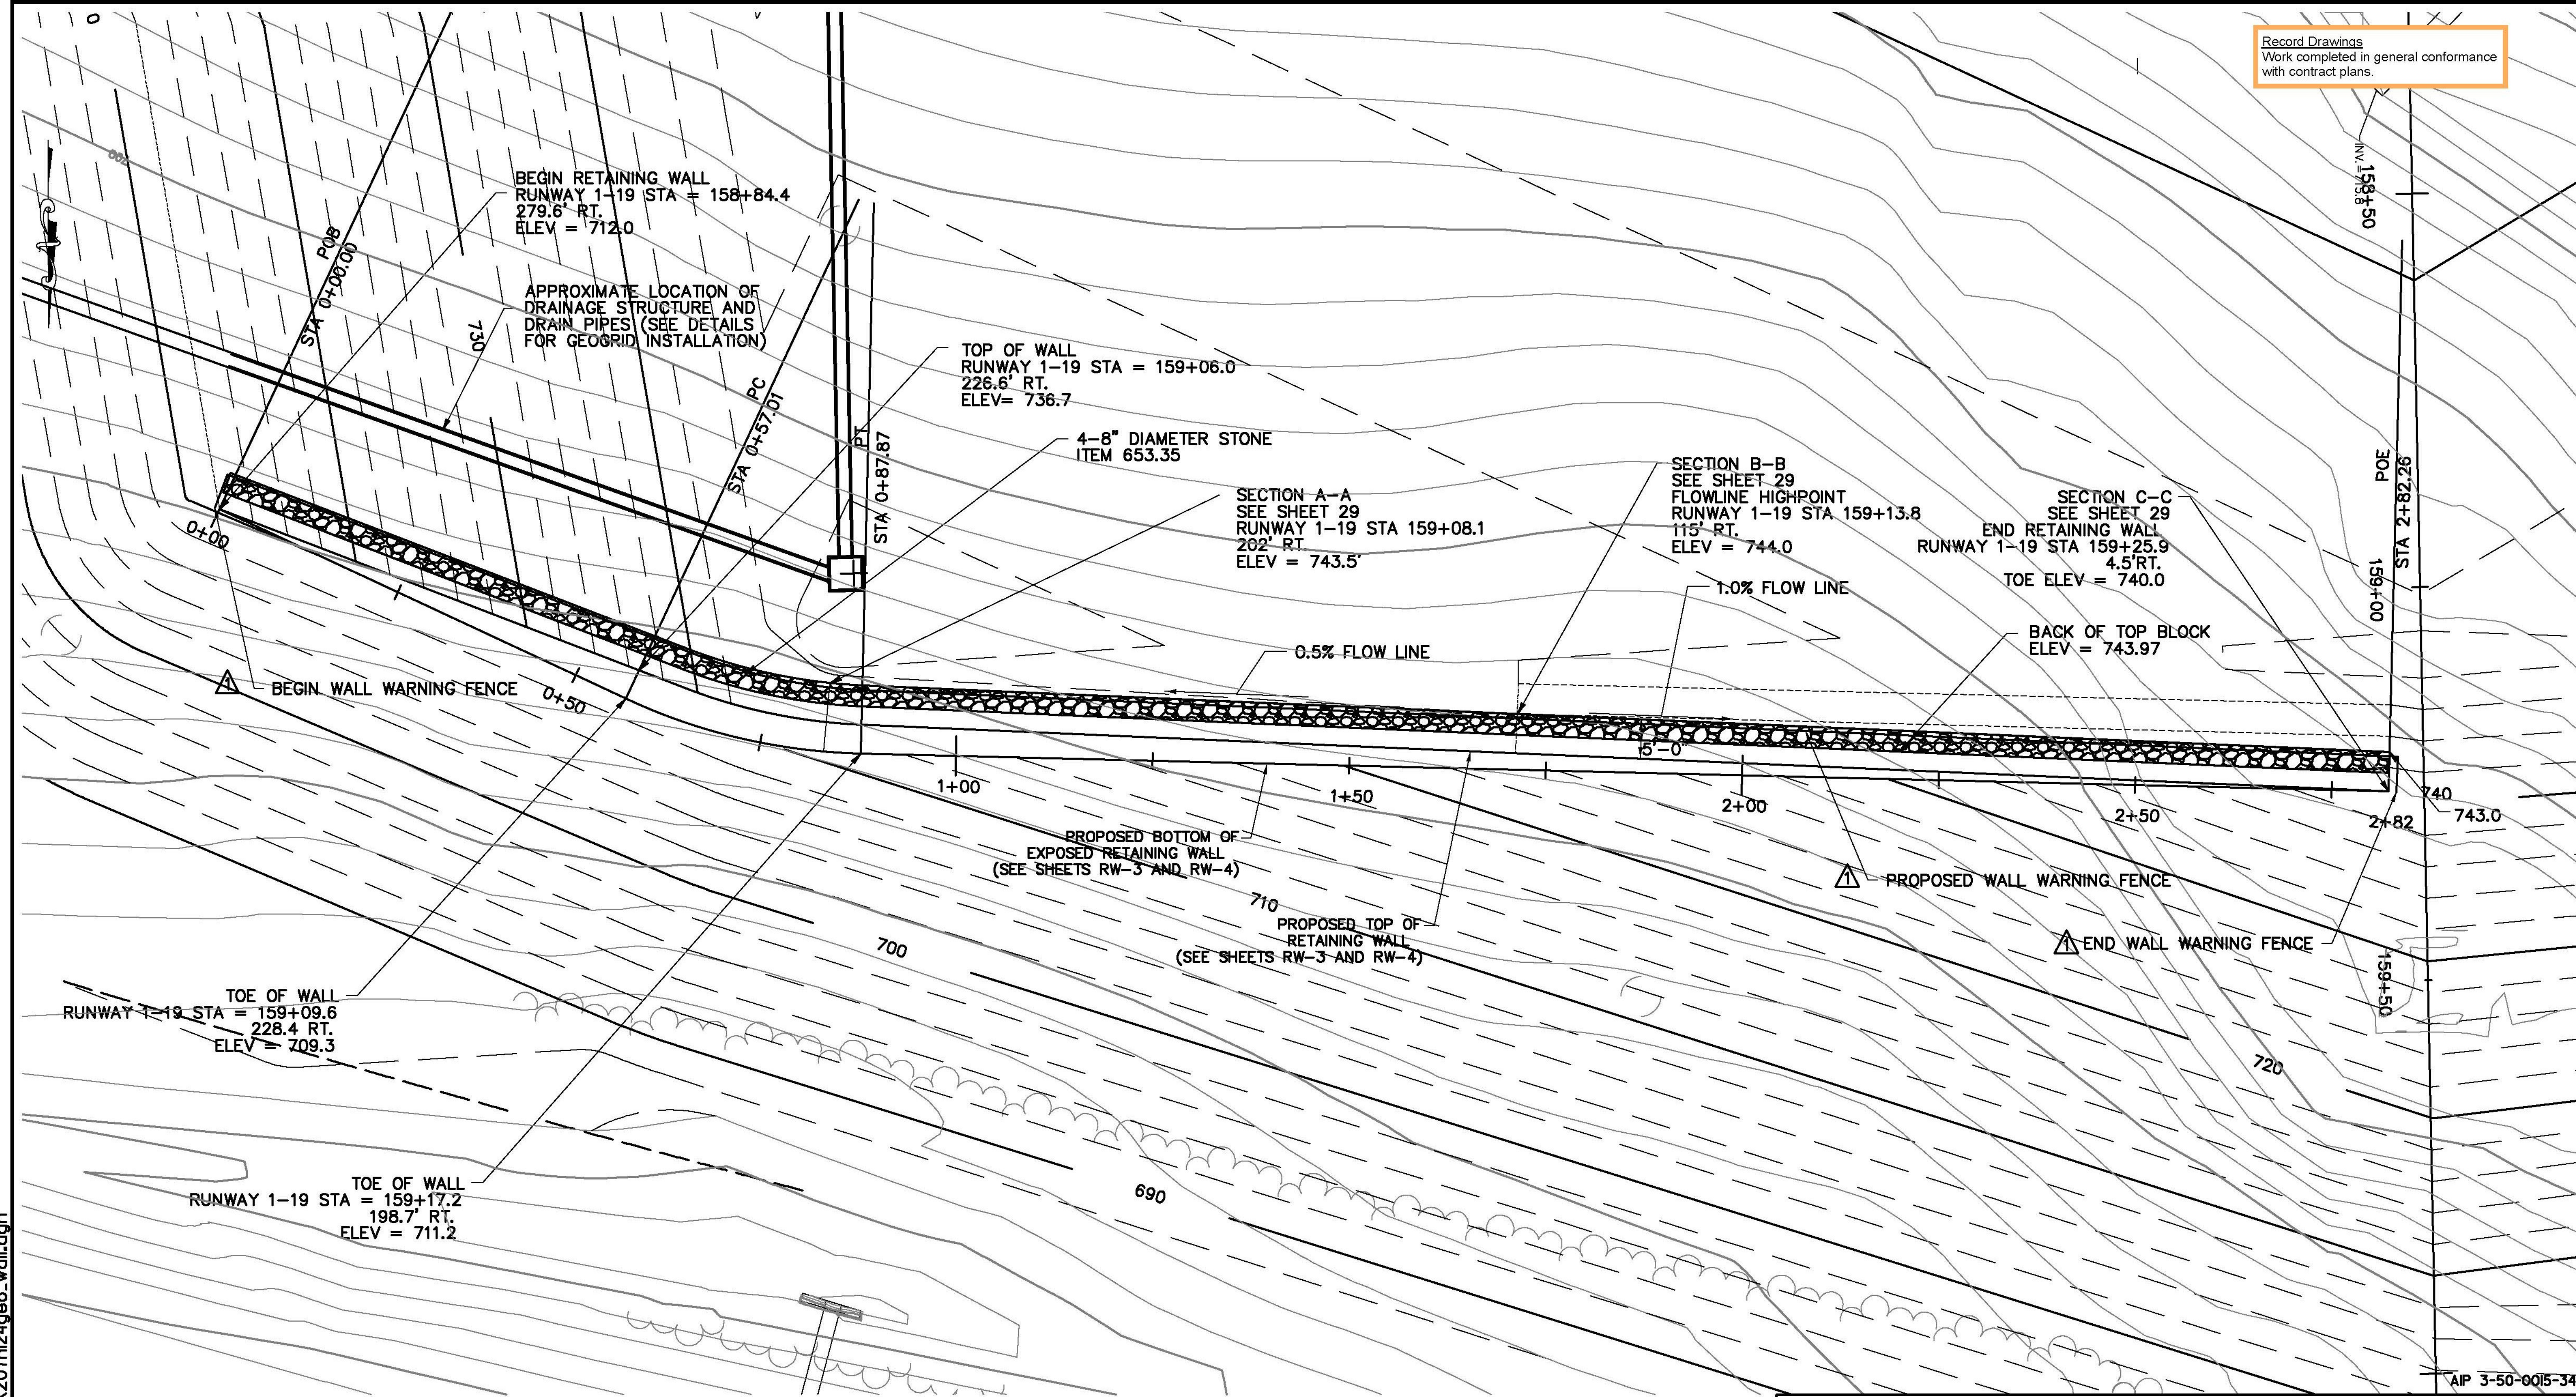


6/12/2013 P:\CADD\consultants\z07h124geo_wall.dgn

LEGEND

- 710 EXISTING CONTOUR W/ELEV.
- EXISTING INT. CONTOUR
- 710 PROPOSED CONTOUR W/ELEV.
- PROPOSED INT. CONTOUR
- EXISTING FENCE
- PROPOSED FENCE
- RSA RUNWAY SAFETY AREA

6/11/13 ADDENDUM 1

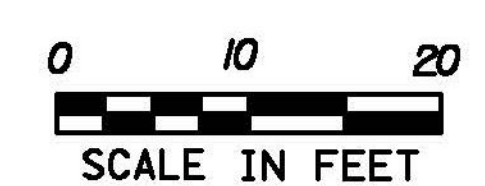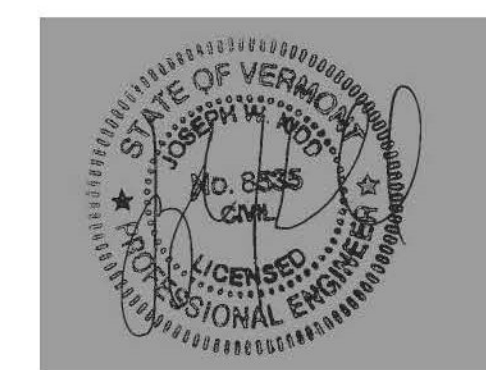

GEODESIGN
 INCORPORATED

Geotechnical | Construction | Environmental
 Engineers and Scientists

54 MAIN STREET WINDSOR, VT 05093
 TELEPHONE: 802.674.2033 - FACSIMILE: 802.674.5943

DRAWING NO.
RW-2

SHEET 2 OF 5

PROJECT NO.
 0880-011.5

VERMONT AGENCY OF TRANSPORTATION

URS

URS CORPORATION
 3 CORPORATE DRIVE, SUITE 203
 CLIFTON PARK, NY 12065
 (518) 688-0015

PROJECT NAME: RUTLAND SOUTHERN VERMONT REGIONAL AIRPORT
 CLARENDON, VERMONT

PROJECT NUMBER: AV14-8018-300

FILE NAME: z07h124geo_wall.dgn
 PROJECT LEADER: JWK
 DESIGNED BY: RPJ
 SEGMENTAL RETAINING WALL AND REINFORCED PAD PLAN

PLOT DATE: 6/11/13
 DRAWN BY: JPG / JPM
 CHECKED BY: JAG
 SHEET 22 OF 36

AIP 3-50-0015-34