




Record Drawings  
Work completed in general conformance with contract plans.

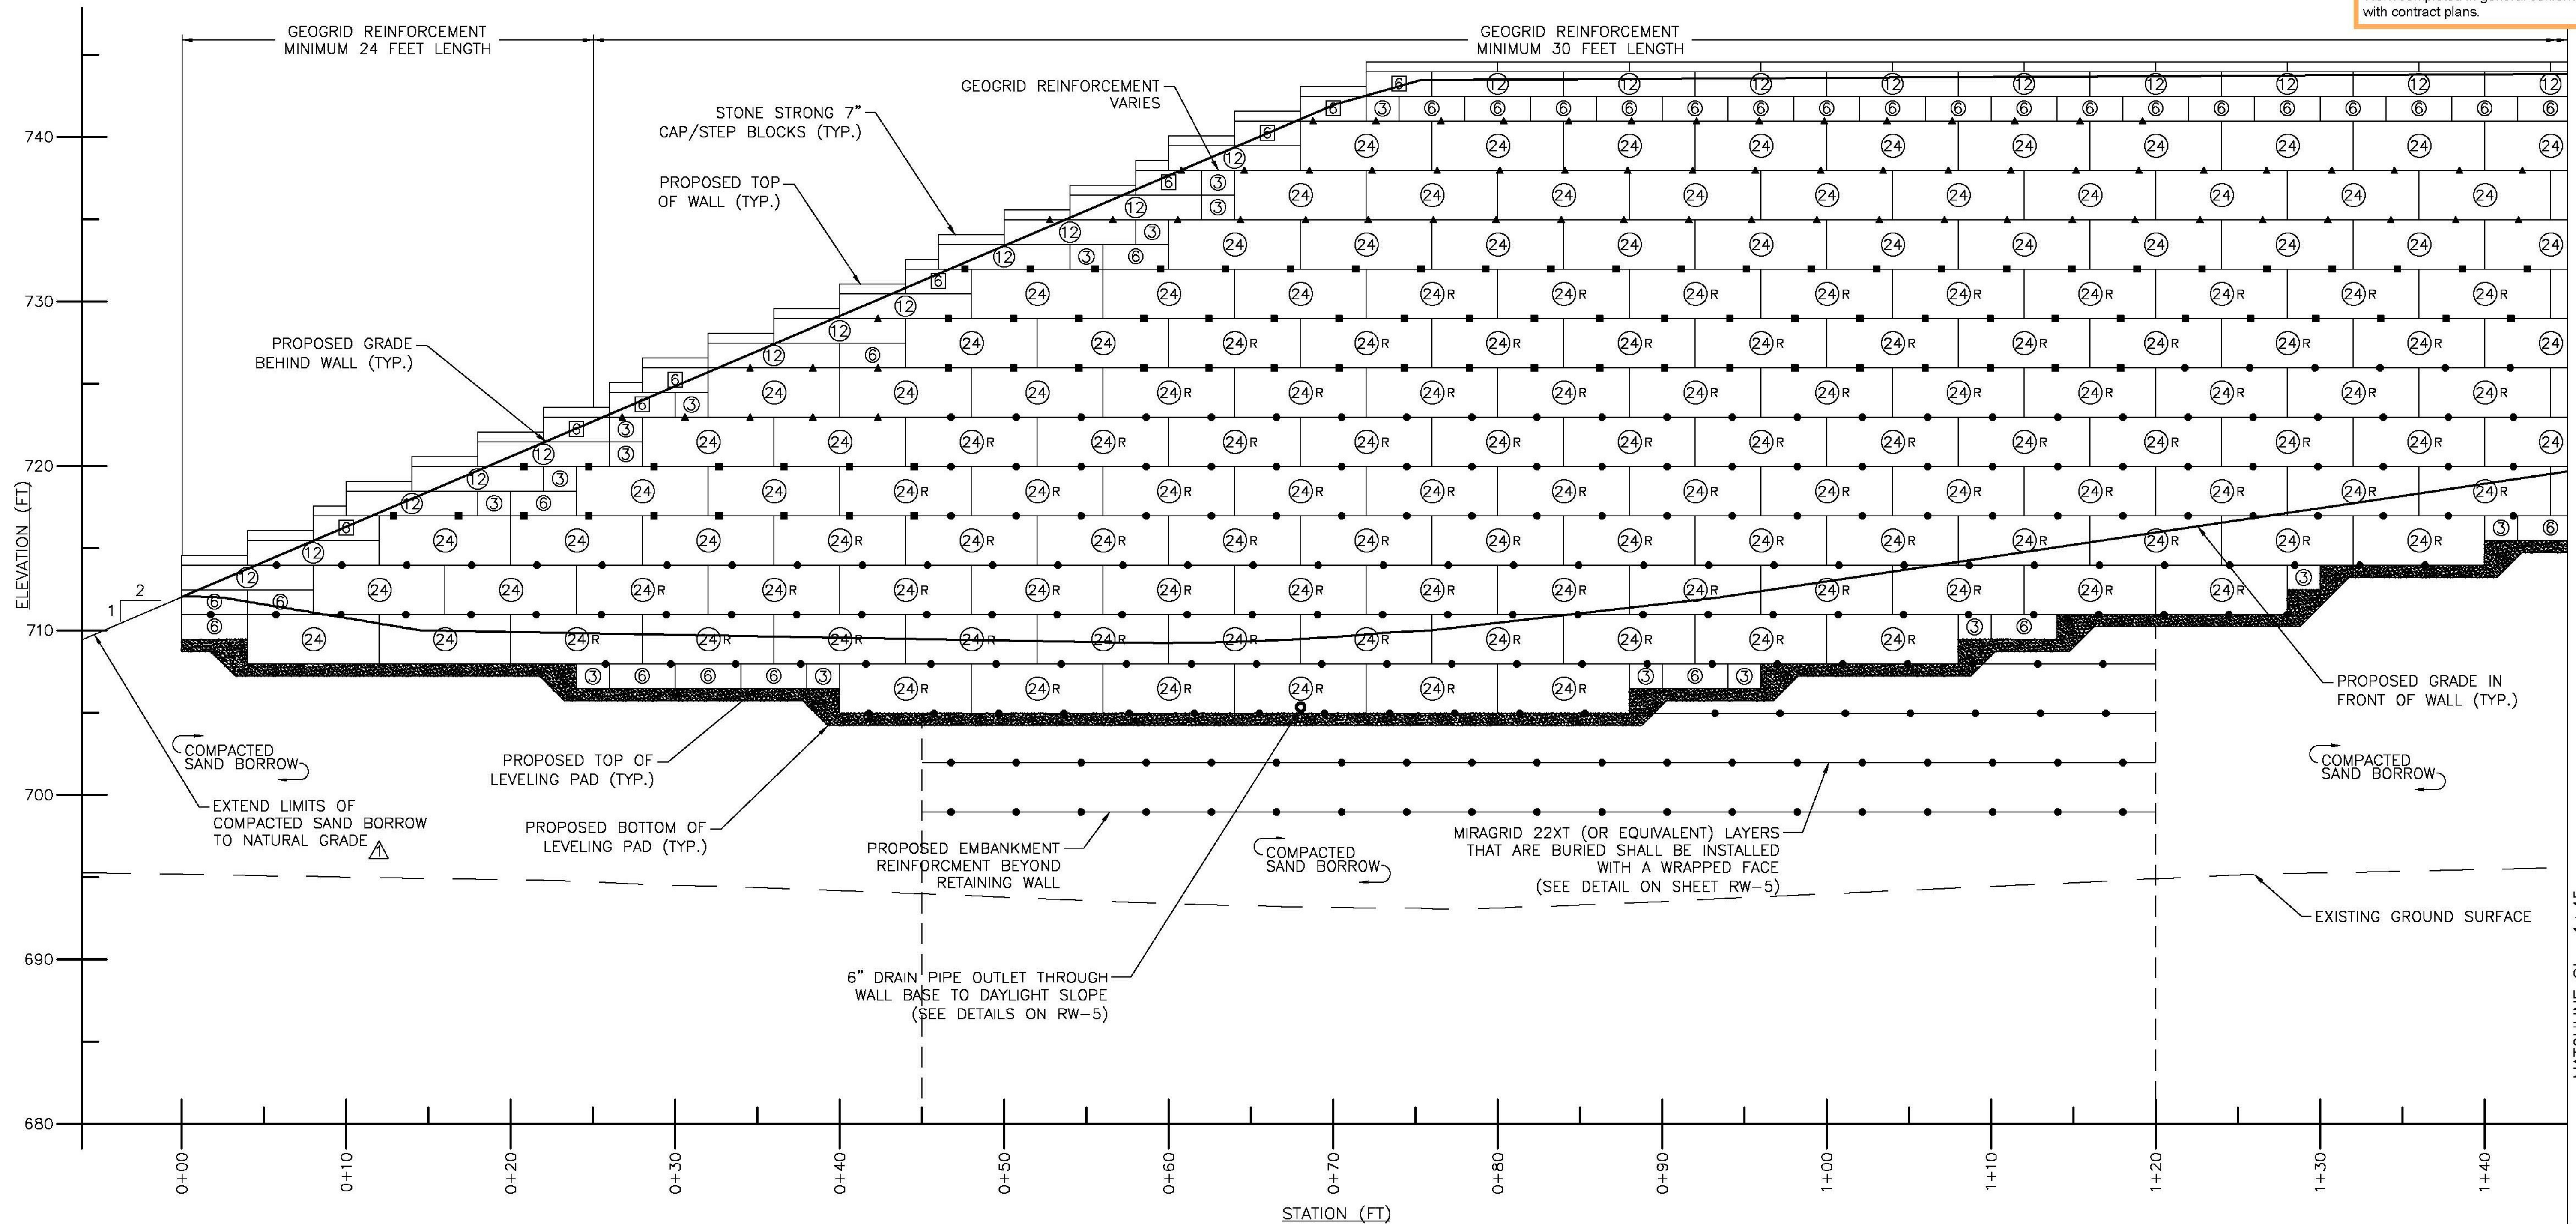

LEGEND:

	MIRAGRID 5XT (OR EQUIVALENT)		STONE STRONG 24 SF UNIT		STONE STRONG 12 SF UNIT DUAL FACE BLOCK
	MIRAGRID 10XT (OR EQUIVALENT)		REINFORCED STONE STRONG 24 SF UNIT		STONE STRONG 6 SF UNIT HALF 12 SF DUAL FACE BLOCK
	MIRAGRID 22XT (OR EQUIVALENT)		STONE STRONG 6 SF UNIT		STONE STRONG 3 SF UNIT

NO.	DATE	DESCRIPTION	DRWN	CHKD	APPVD
1	6/11	DESIGN ADDENDUM 1	RPJ	JAG	JWK
REVISIONS					

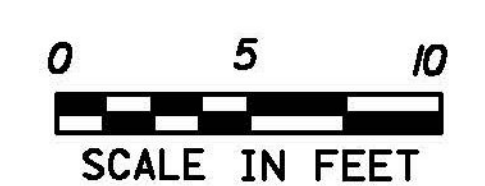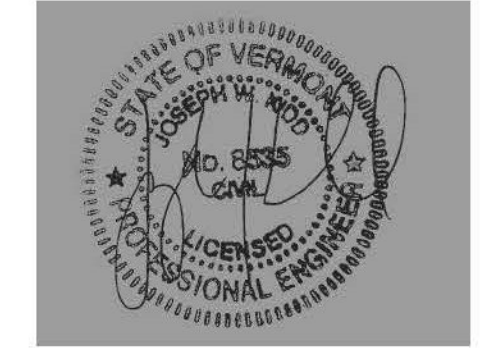

**GEODESIGN**  
INCORPORATED

Geotechnical | Construction | Environmental  
Engineers and Scientists

54 MAIN STREET WINDSOR, VT 05099  
TELEPHONE: 802.674.2033 - FACSIMILE: 802.674.5943

DRAWING NO.  
**RW-3**  
SHEET 3 OF 5

PROJECT NO.  
0880-011.5

**VERMONT AGENCY OF TRANSPORTATION**

**URS**

URS CORPORATION  
3 CORPORATE DRIVE, SUITE 203  
CLIFTON PARK, NY 12065  
(518) 688-0015

PROJECT NAME: RUTLAND SOUTHERN VERMONT REGIONAL AIRPORT  
CLARENDON, VERMONT

PROJECT NUMBER: AV14-8018-300

FILE NAME: z07h124pro-wall.dgn  
PLOT DATE: 6/11/13

PROJECT LEADER: JWK  
DRAWN BY: JPG / JPM

DESIGNED BY: RPJ  
CHECKED BY: JAG

SEGMENTAL RETAINING WALL DEVELOPED ELEVATION 1  
SHEET 23 OF 36