



PLAN
NTS

NOTE:
MATERIALS TO BE SUPPLIED
INCLUDE 4 L-880 LIGHT
UNITS AND POWER ADAPTER.
CONTRACTOR TO PROVIDE ALL
OTHER MATERIALS AND LABOR
TO INSTALL AS COMPLETED
UNIT.

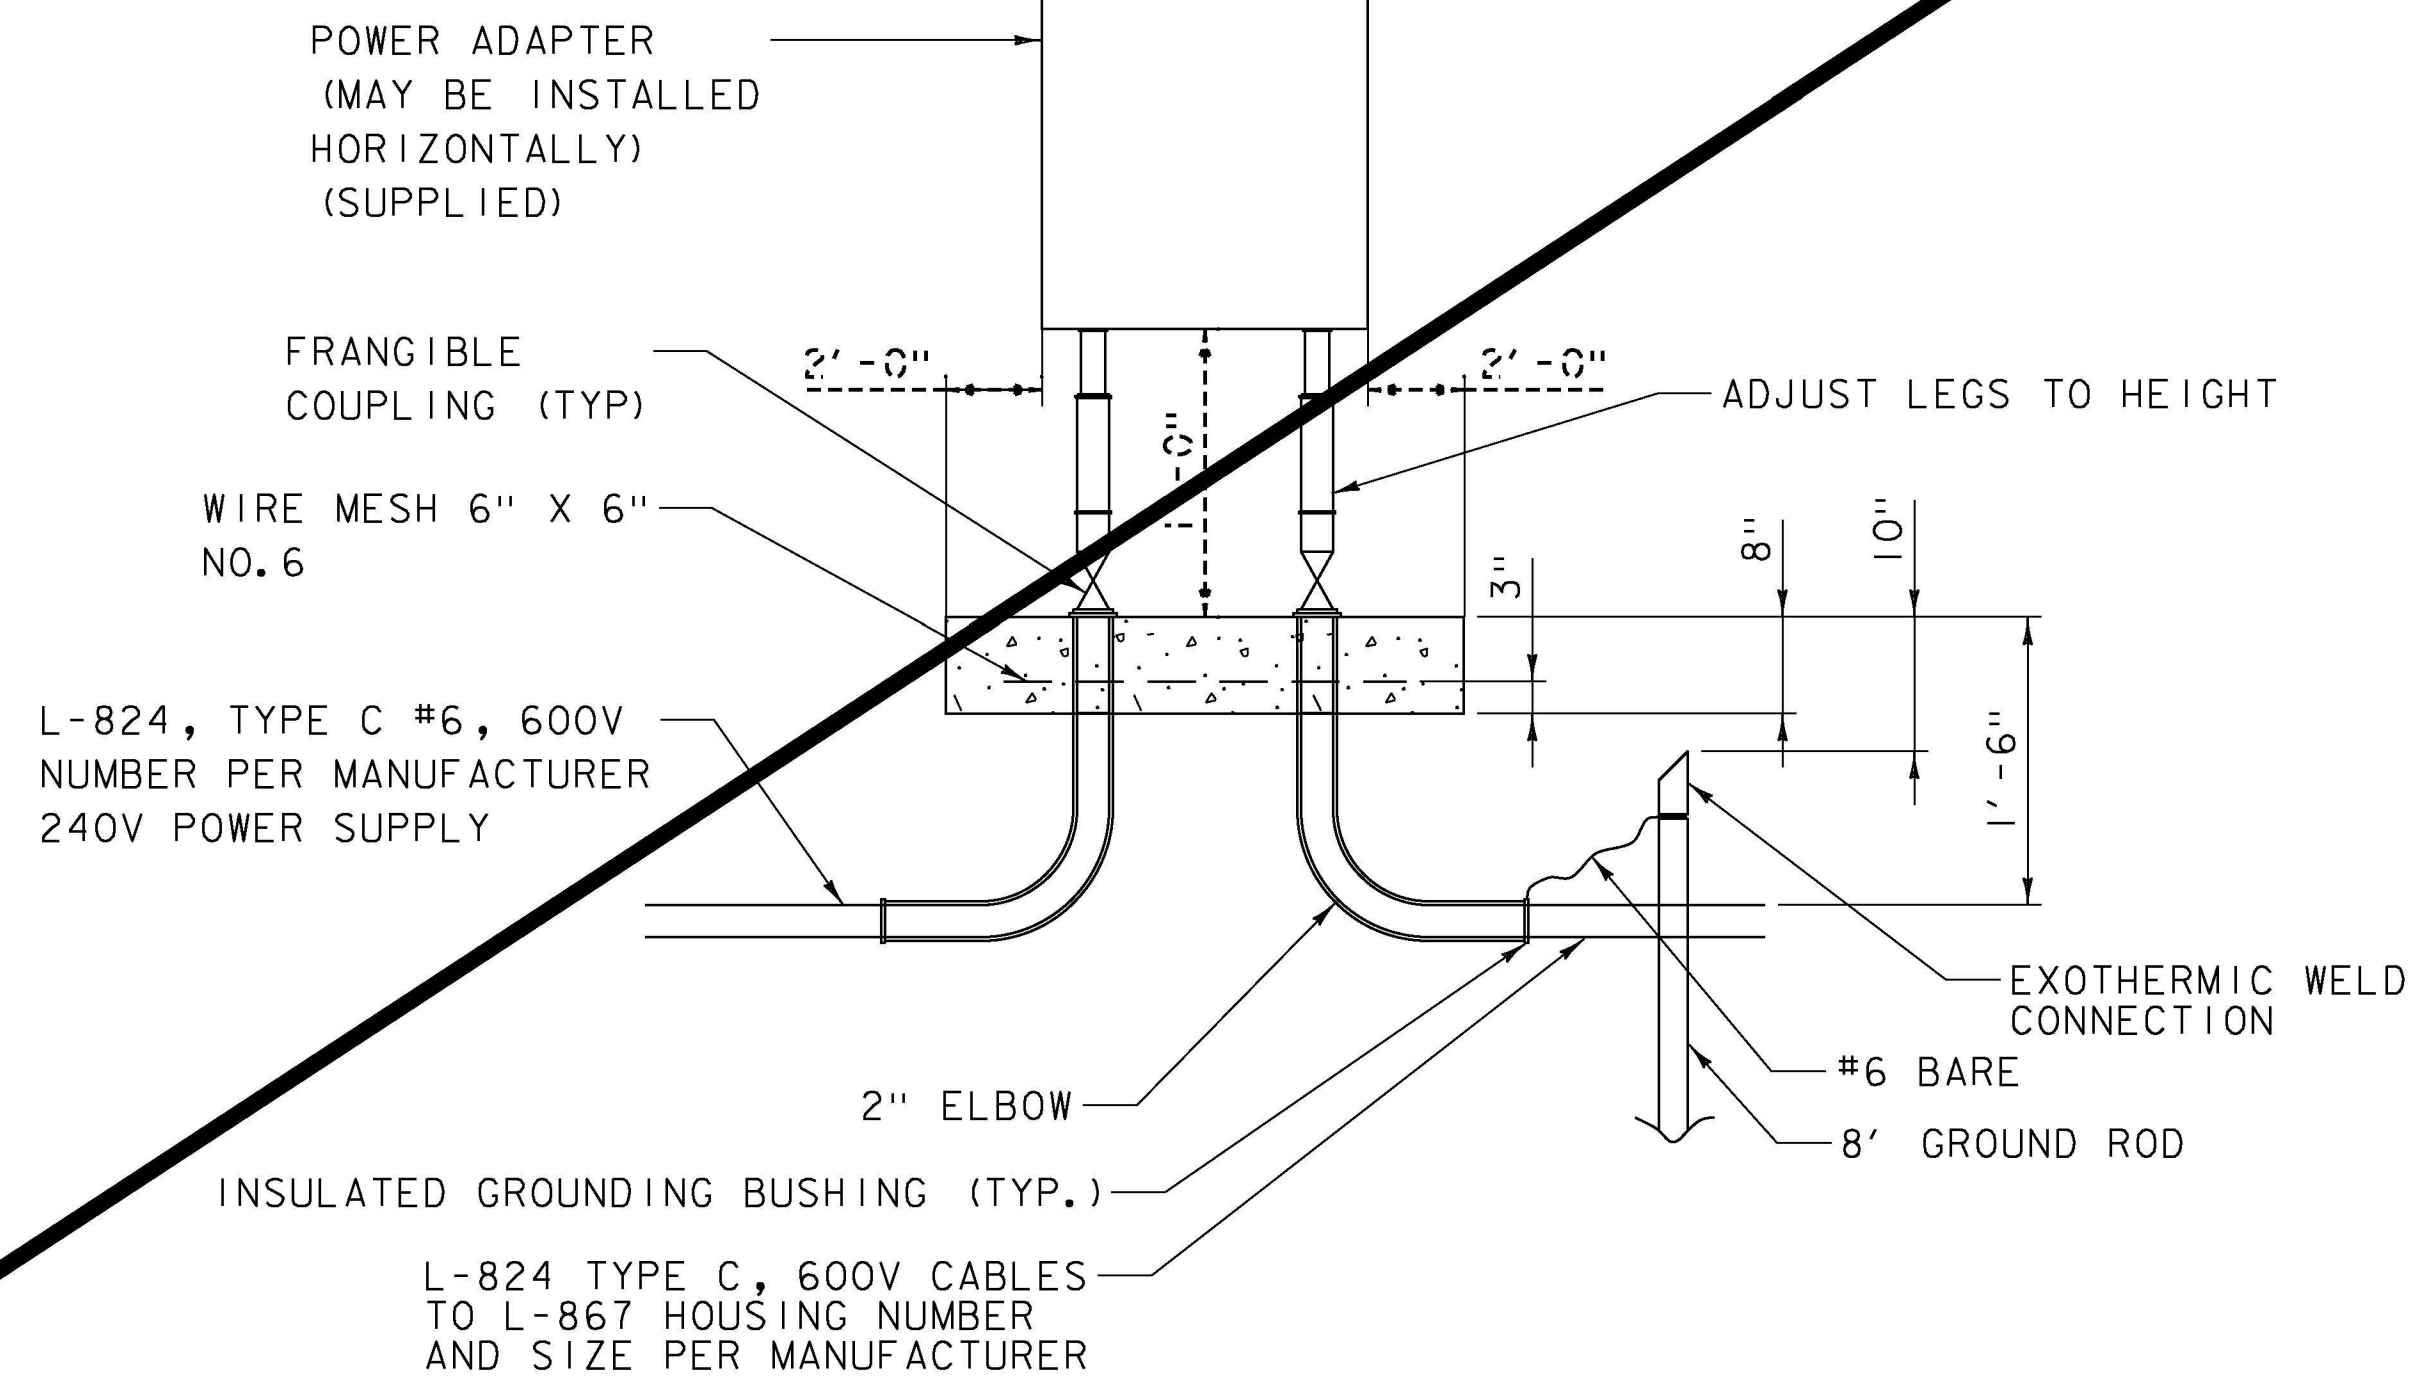


CONTROL PANEL
NTS

Record Drawings
Temporary PAPI removed from contract

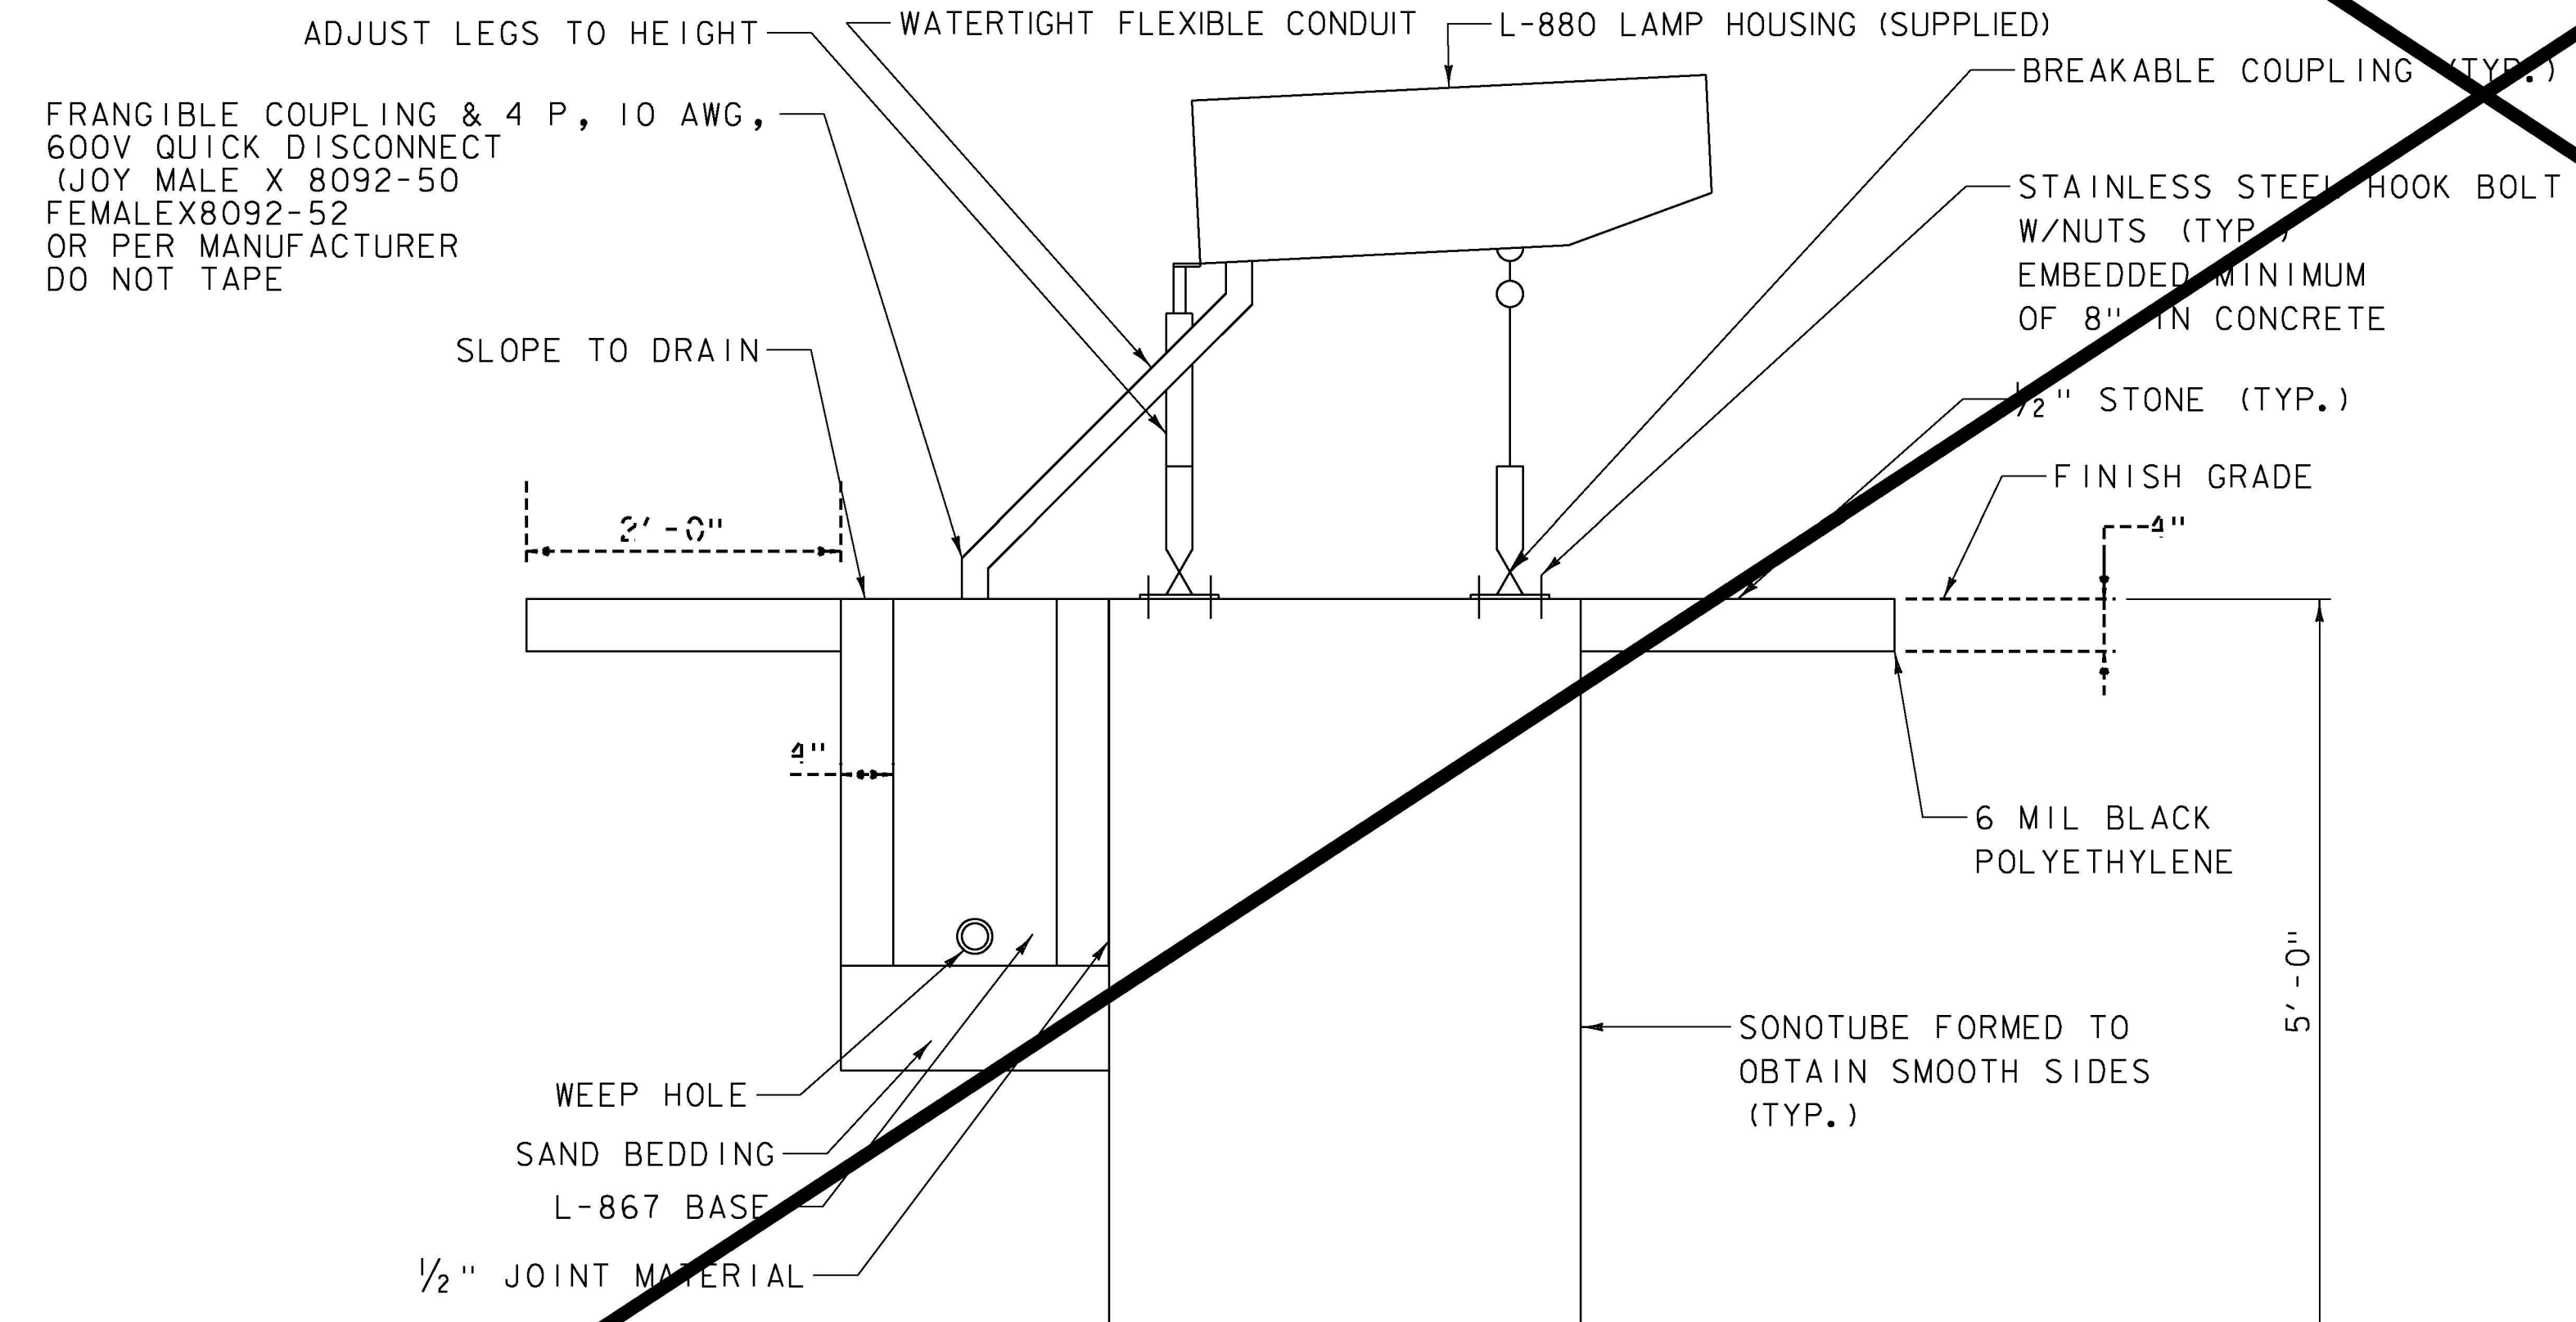

SECTION A-A
NTS

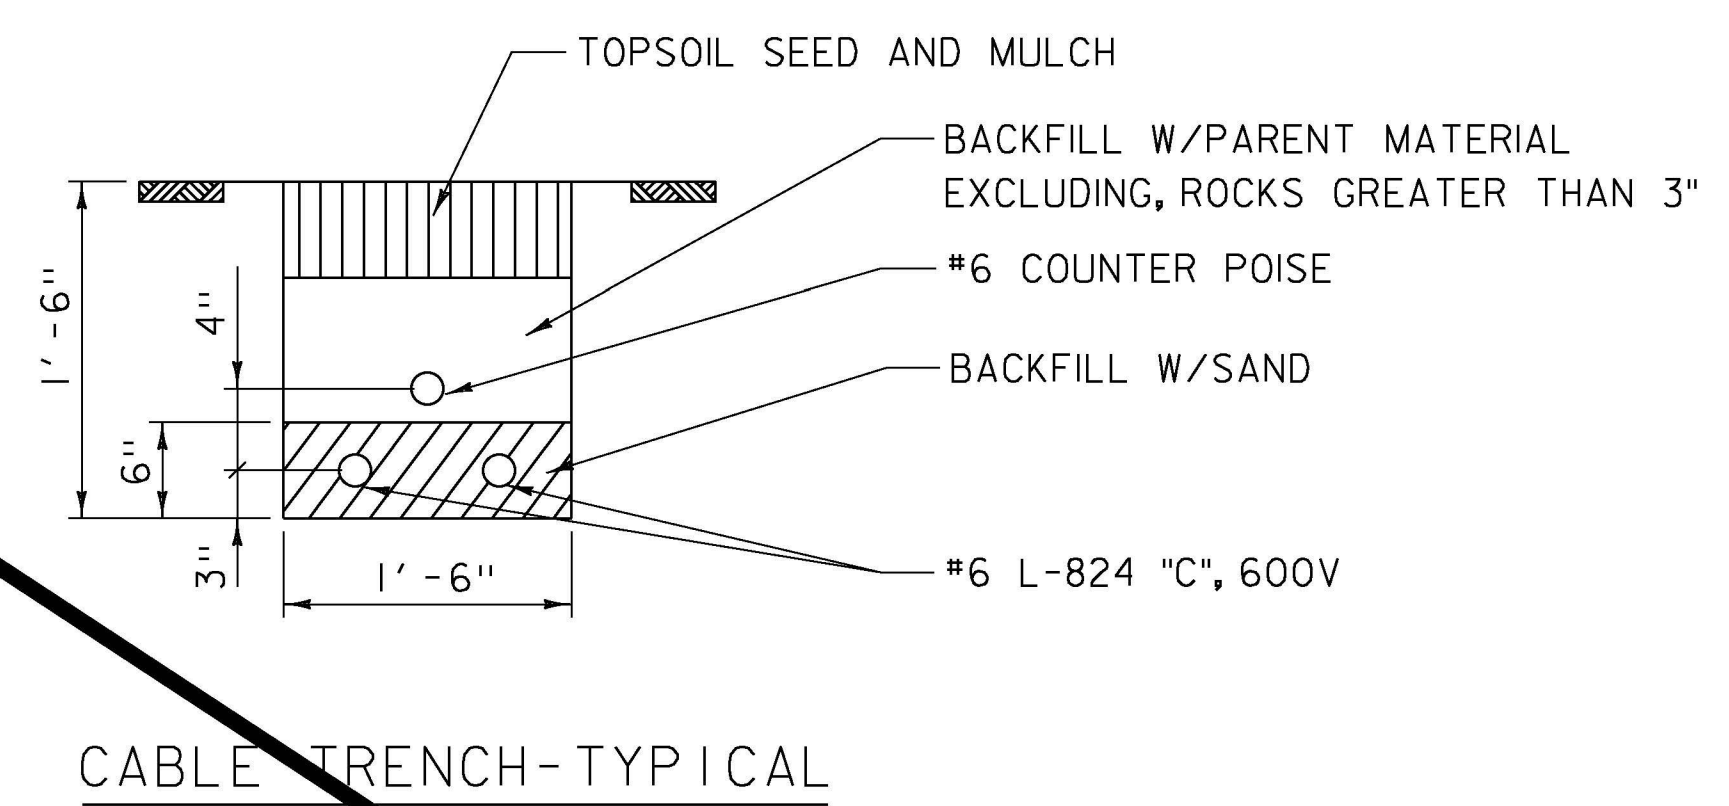

CABLE TRENCH-TYPICAL
NTS



NOTE:
AFTER COMPLETION OF PROJECT CONTRACTOR TO
REMOVE PCC FOUNDATIONS, BACKFILL W/SOIL AND
RESTORE TO PRE-CONSTRUCTION CONDITIONS.
(EXISTING CABLES CAN BE ABANDONED IN PLACE)

VERMONT AGENCY OF TRANSPORTATION	
URS URS CORPORATION 3 CORPORATE DRIVE, SUITE 203 CLIFTON PARK, NY 12065 (518) 688-0015	PROJECT NAME: RUTLAND SOUTHERN VERMONT REGIONAL AIRPORT CLARENDON, VERMONT
	PROJECT NUMBER: AV14-8018-300
FILE NAME: z07124hpap1.dgn	PLOT DATE: 6/2/2013
DESIGNED BY: G. D'AMICO	DRAWN BY: R. ROSE
TEMP. PAPI DETAILS	CHECKED BY:
	SHEET 27 OF 36

6/2/2013 P:\CADD\Consultants\z07124hpap1.dgn