





**PAPI NOTES**

1. THE FOUR BOX PAPI WILL BE SUPPLIED BY THE BURLINGTON INTERNATIONAL AIRPORT. CONTRACTOR TO PICK UP AND DELIVER (AND RETURN) THE PAPI FROM THE BURLINGTON INTERNATIONAL AIRPORT. CONTACT THE AIRPORT ELECTRICIAN (COREY JEWELL) AT 802-863-1289 OR 802-310-8863 TO ARRANGE PICKUP.
2. EXISTING PAPI WAS MANUFACTURED BY DME CORPORATION, FT. LAUDERDALE, FL, IN 2009.
3. CONTRACTOR IS RESPONSIBLE FOR PICK UP AND DELIVERY OF ALL UNITS, INSTALLATION OF ALL FOUNDATIONS, CABLES, CONDUITS, MISCELLANEOUS HARDWARE (LEGS, FITTINGS, CONNECTIONS, ETC.), CLEANUP AND LANDSCAPING OF SITE AND ALL LAYOUT.
4. CONTRACTOR TO COORDINATE INSTALLATION WITH FAA TECHNICIAN EDCYR@BTL (802-657-4456)
5. DISCONNECT EXISTING VASI-4 AND ENERGIZE PAPI FROM VASI POWER SUPPLY (240V, 1 PHASE)
6. PAPI AIMING ANGLES:

UNIT	ANGLE
1	3 DEGREES 30 MINUTES
2	3 DEGREES 10 SECONDS
3	2 DEGREES 10 SECONDS
4	2 DEGREES 30 SECONDS

Record Drawings  
Temporary PAPI removed from contract

NOTE : THRESHOLD CROSSING HEIGHT = 40'

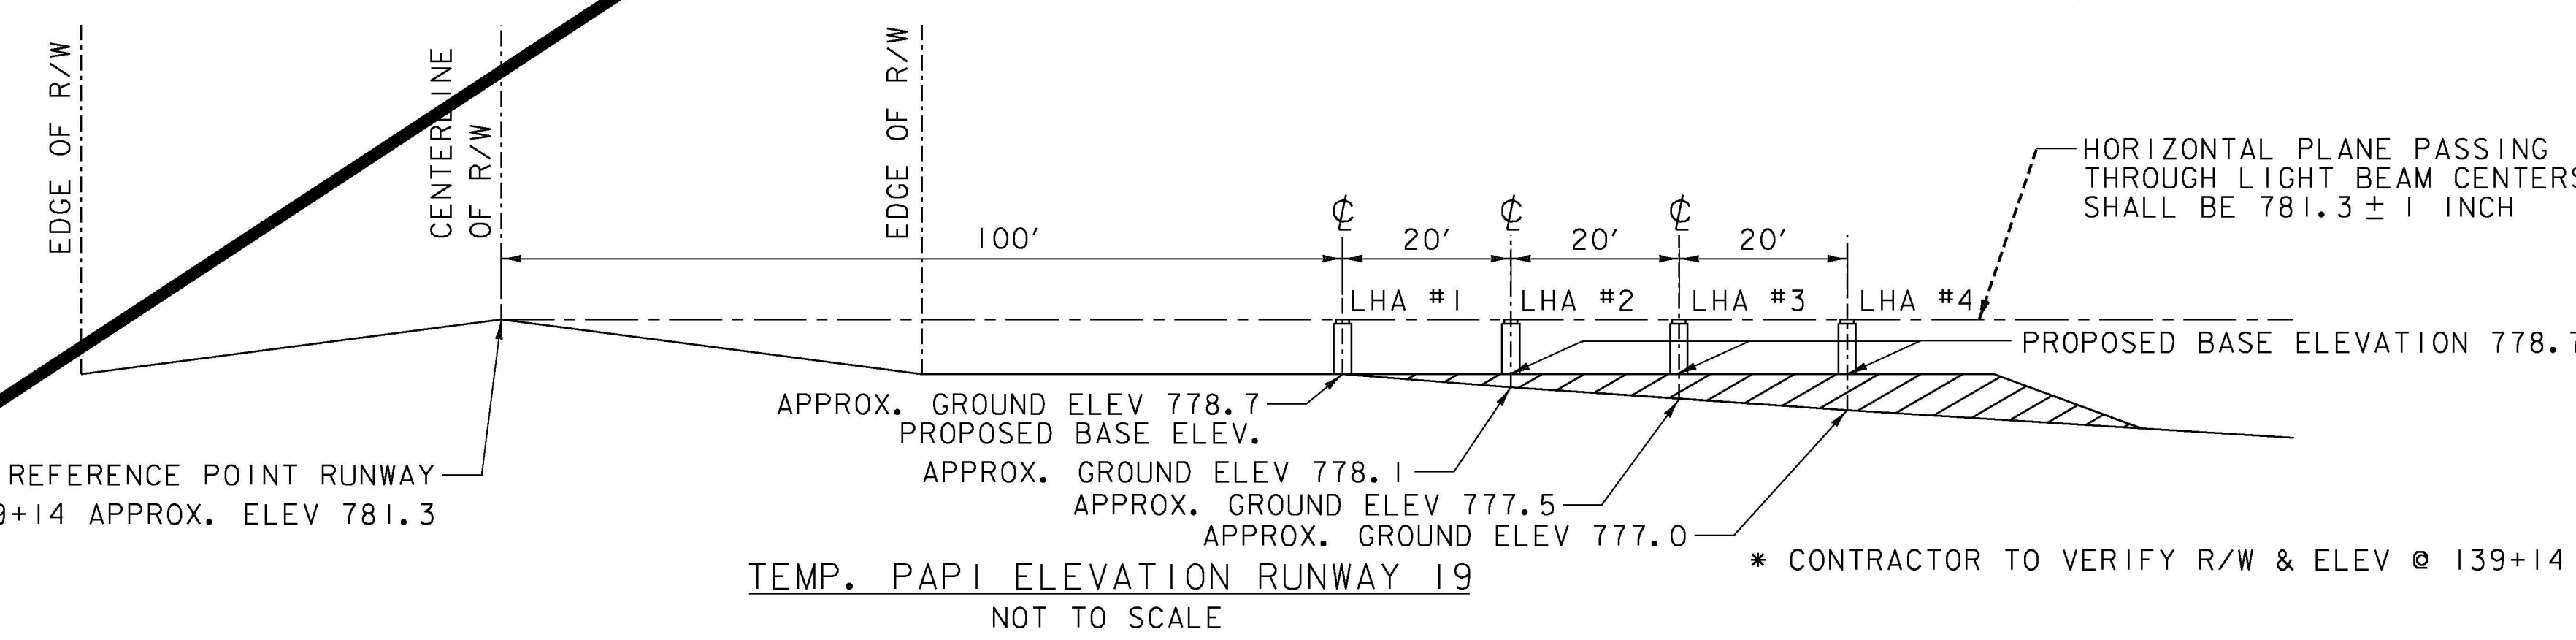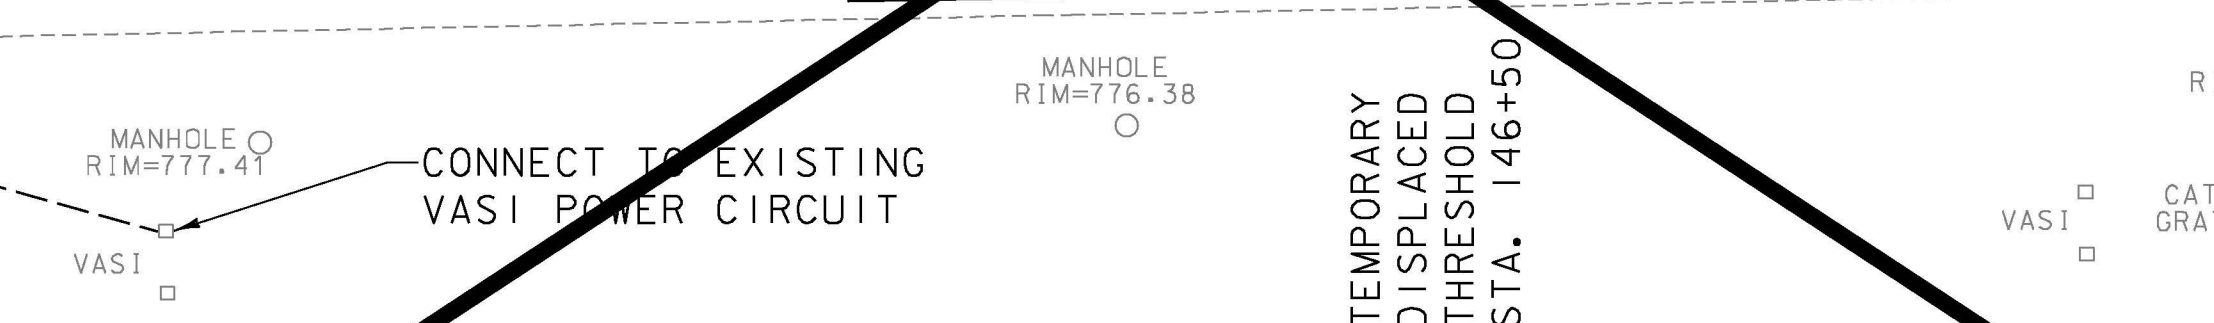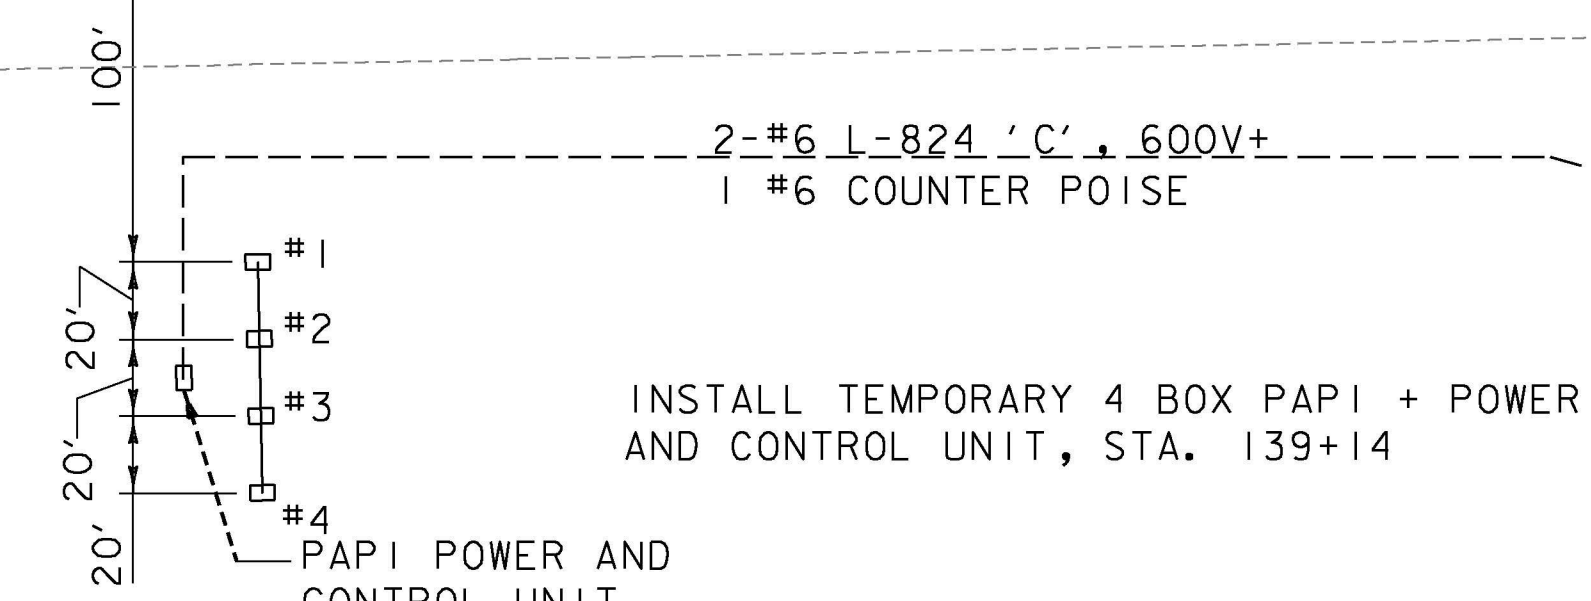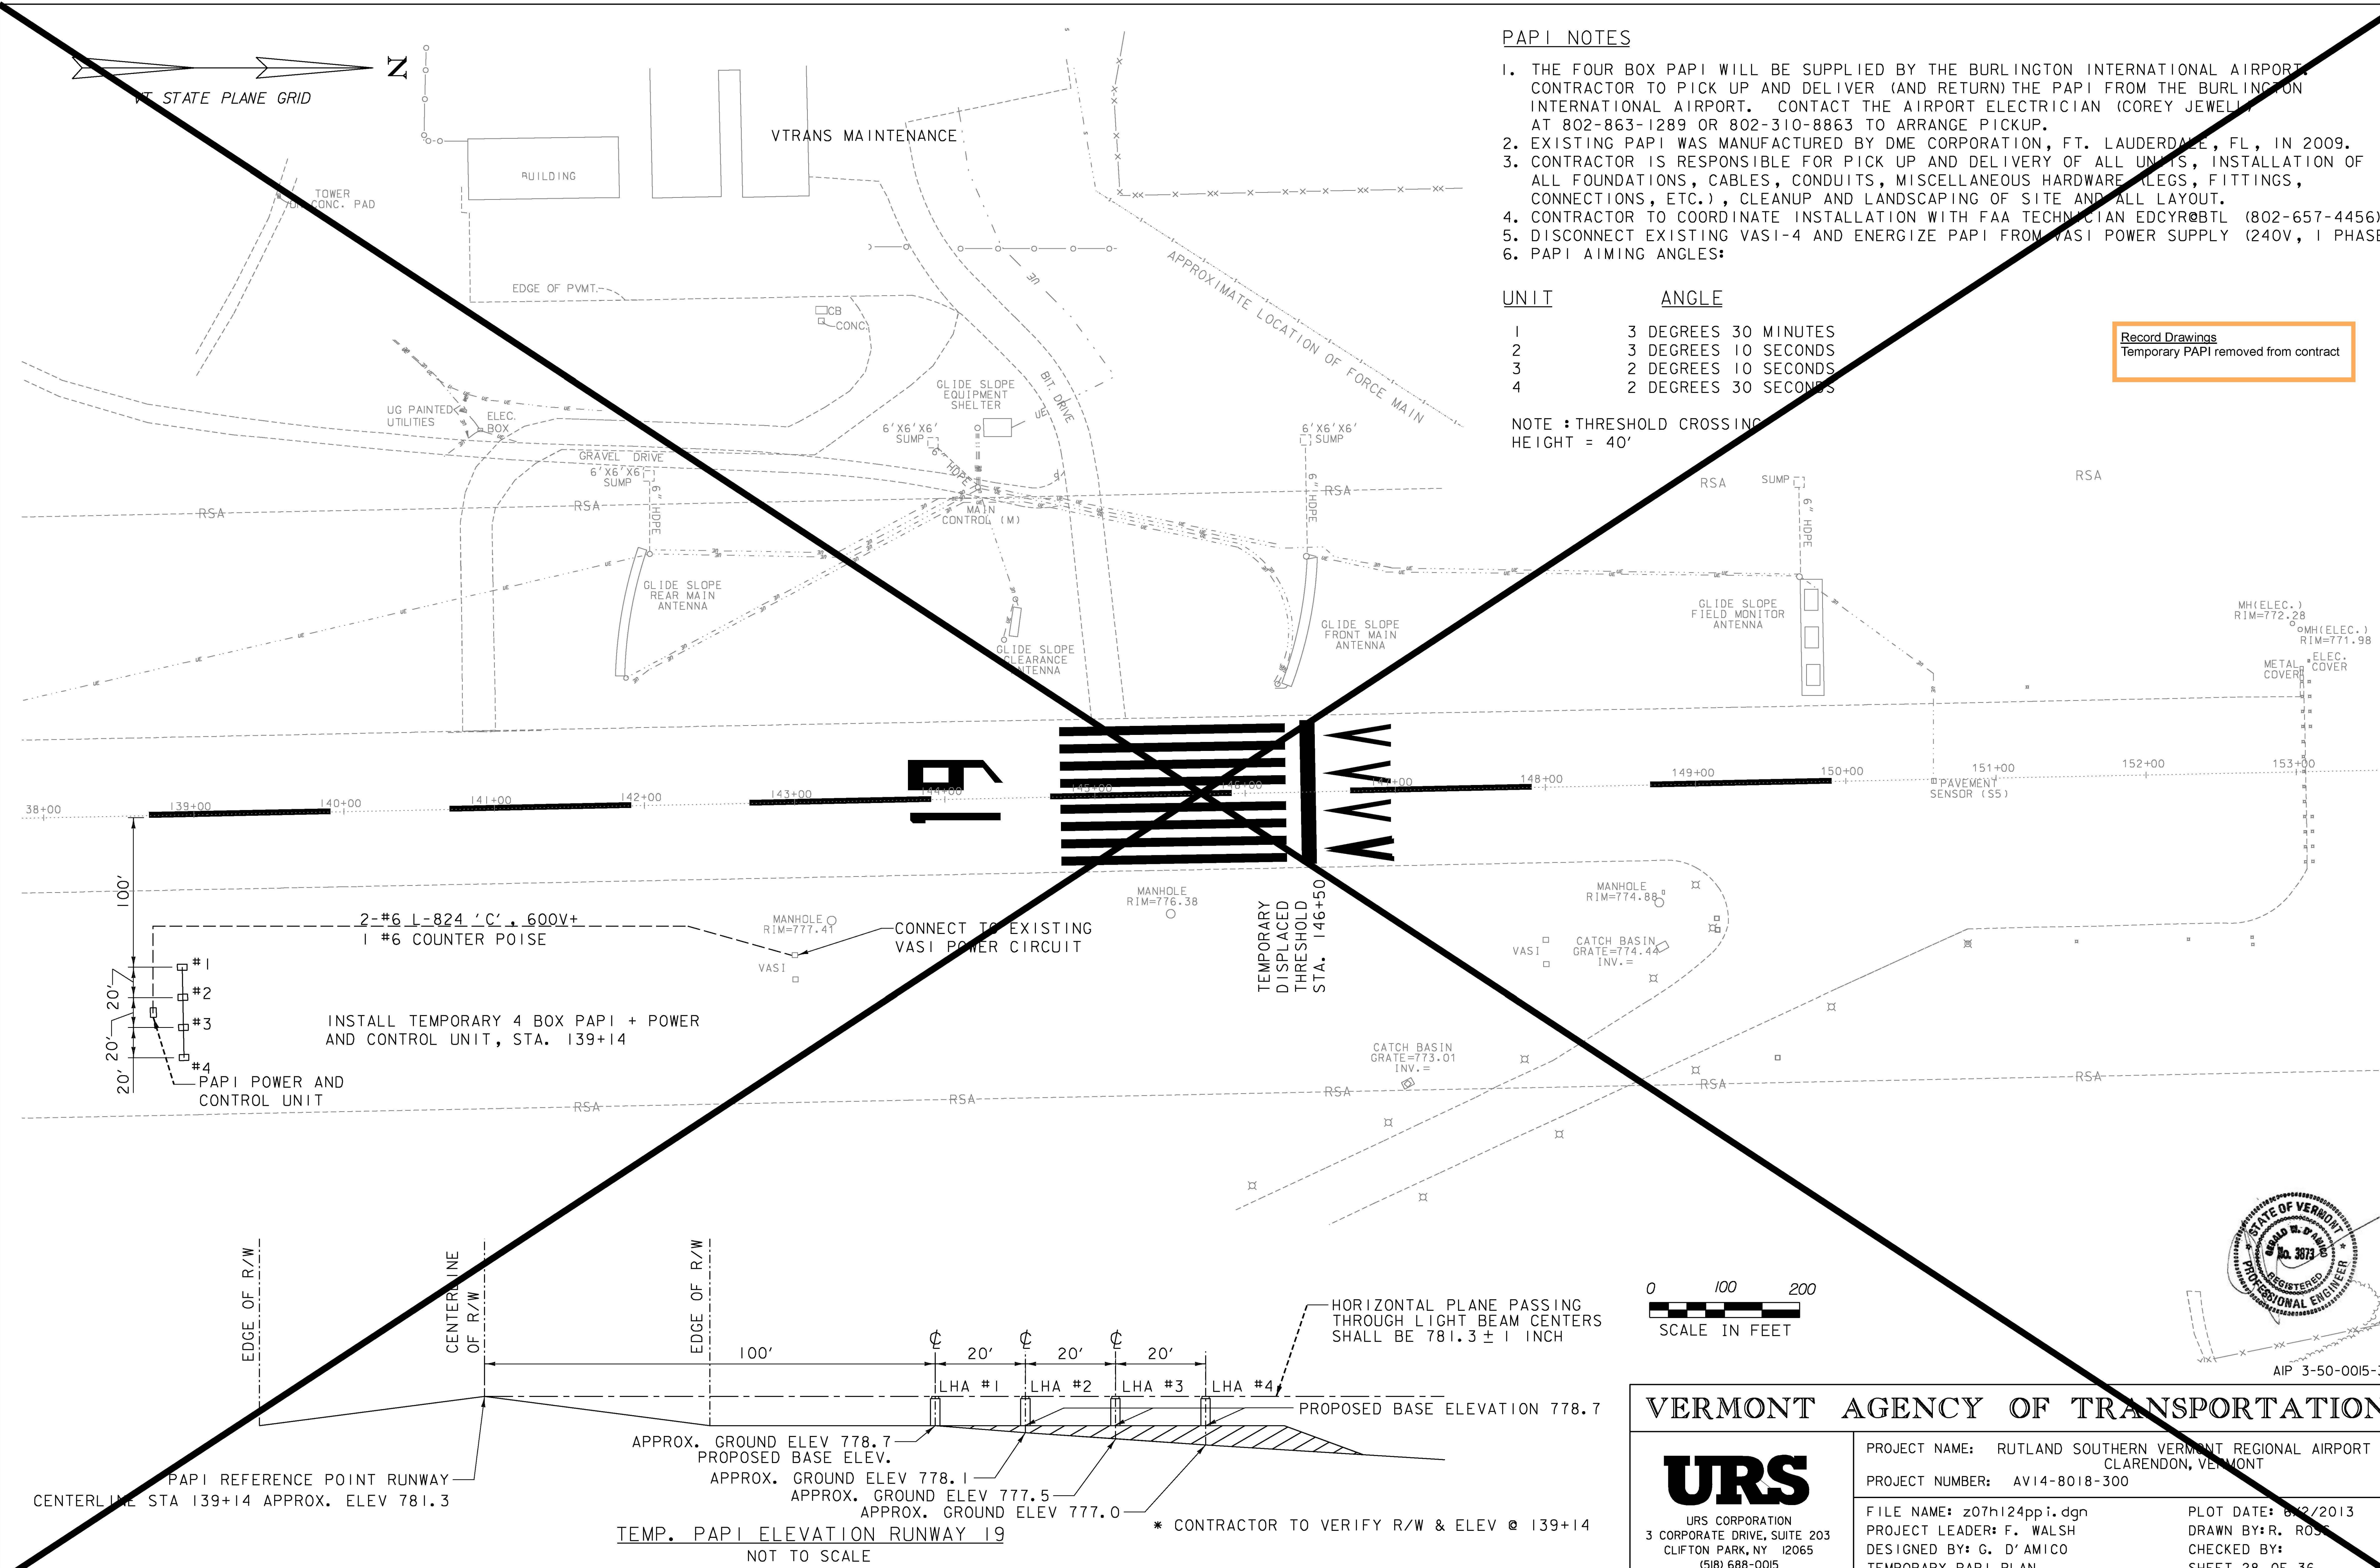

**VERMONT AGENCY OF TRANSPORTATION**

<p>URS CORPORATION 3 CORPORATE DRIVE, SUITE 203 CLIFTON PARK, NY 12065 (518) 688-0015</p>	<p>PROJECT NAME: RUTLAND SOUTHERN VERMONT REGIONAL AIRPORT CLARENDON, VERMONT</p> <p>PROJECT NUMBER: AV14-8018-300</p>
	<p>FILE NAME: z07h124ppi.dgn</p> <p>PROJECT LEADER: F. WALSH</p> <p>DESIGNED BY: G. D'AMICO</p> <p>TEMPORARY PAPI PLAN</p>

6/2/2013 P:\CADD\Consultants\z07h124ppi.dgn