




Record Drawing  
 Finished grades are shown on  
 Attachment A: Construction Survey  
 Record Plan

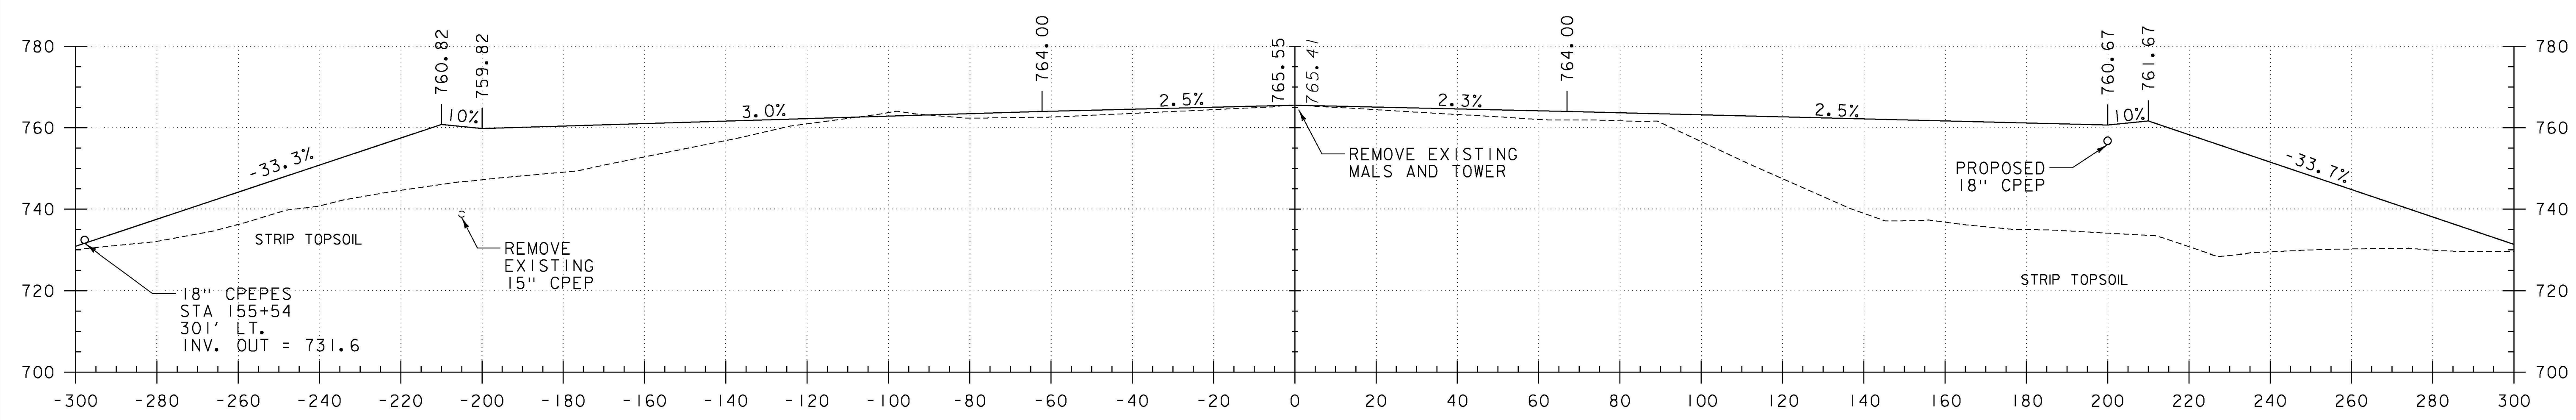

155+50

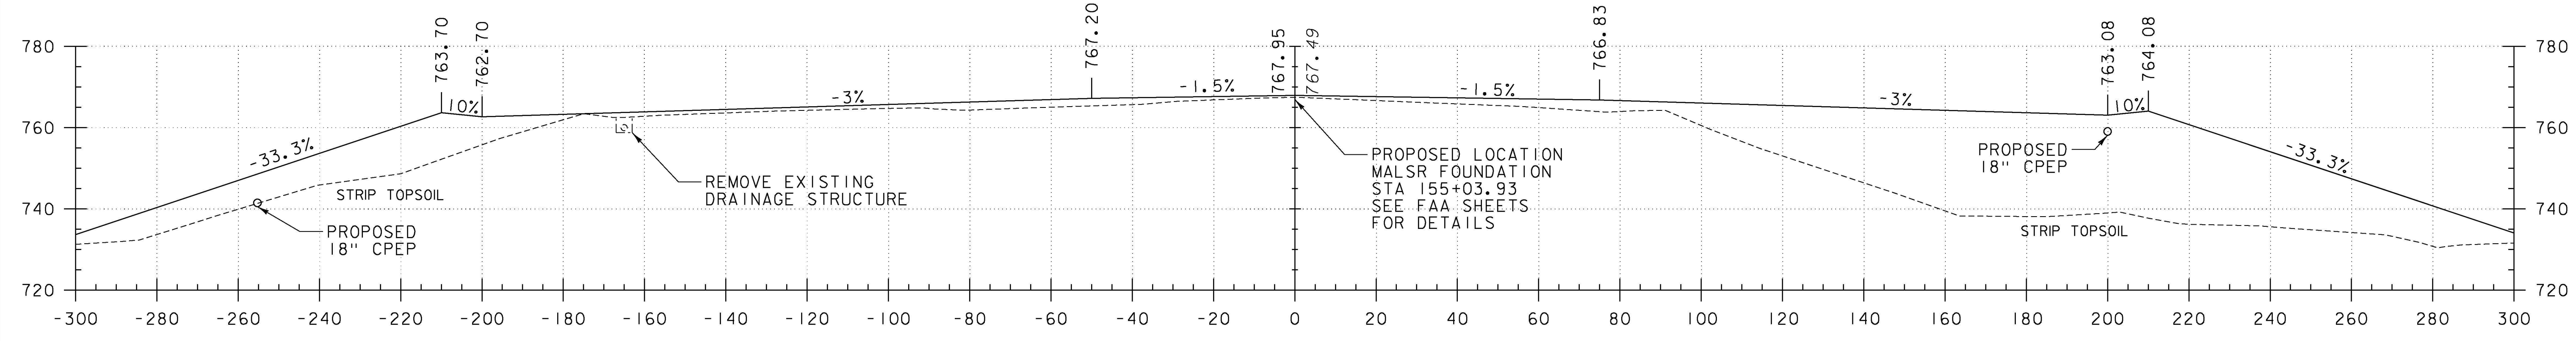

155+00

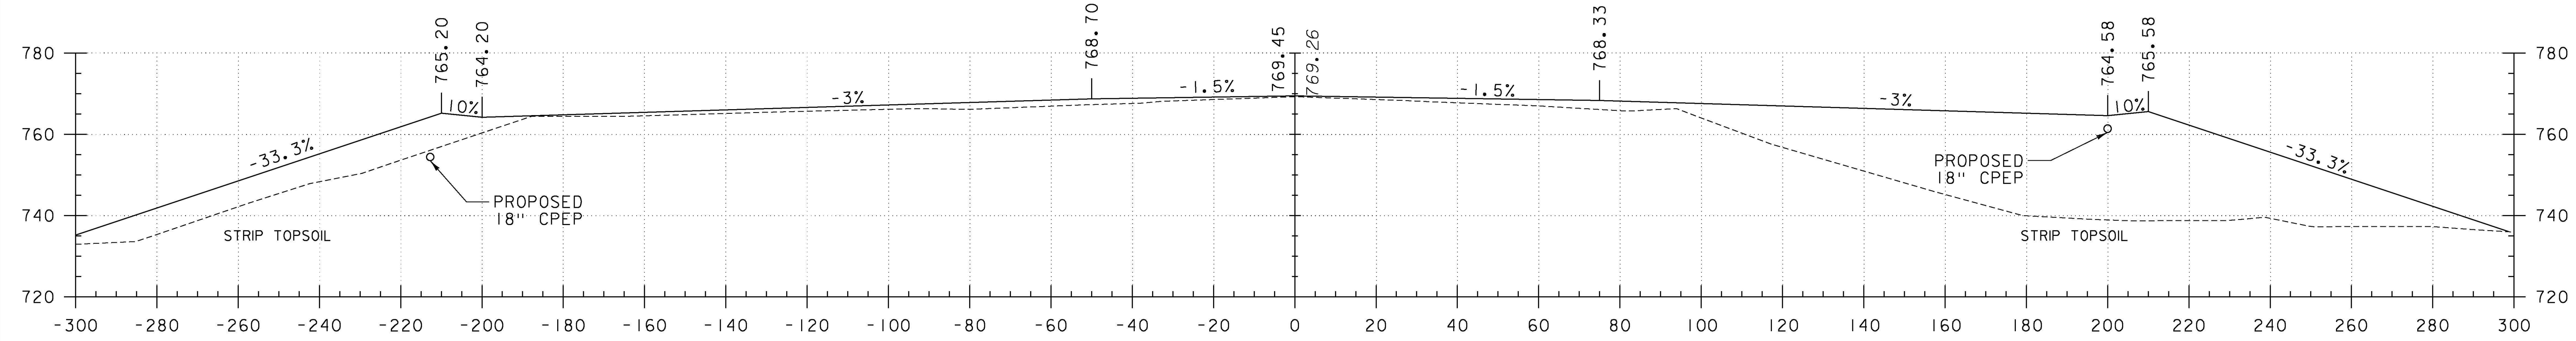

154+50



AIP 3-50-0018-34

VERMONT AGENCY OF TRANSPORTATION



**URS**  
 URS CORPORATION  
 3 CORPORATE DRIVE, SUITE 203  
 CLIFTON PARK, NY 12065  
 (518) 688-0015

PROJECT NAME: RUTLAND SOUTHERN VERMONT REGIONAL AIRPORT  
 CLARENDON, VERMONT  
 PROJECT NUMBER: AV14-8018-300  
 FILE NAME: z07h124xs\_rsa3.dgn  
 PROJECT LEADER: F. WALSH  
 DESIGNED BY: G. D'AMICO  
 RSA CROSS SECTIONS  
 PLOT DATE: 6/2/2013  
 DRAWN BY: M. KEMP  
 CHECKED BY:  
 SHEET 32 OF 36

PROJECT RECORD DRAWINGS

6/2/2013  
 P:\CADD\Consultants\z07h124xs\_rsa3.dgn