



Record Drawing  
 Finished grades are shown on  
 Attachment A: Construction Survey  
 Record Plan

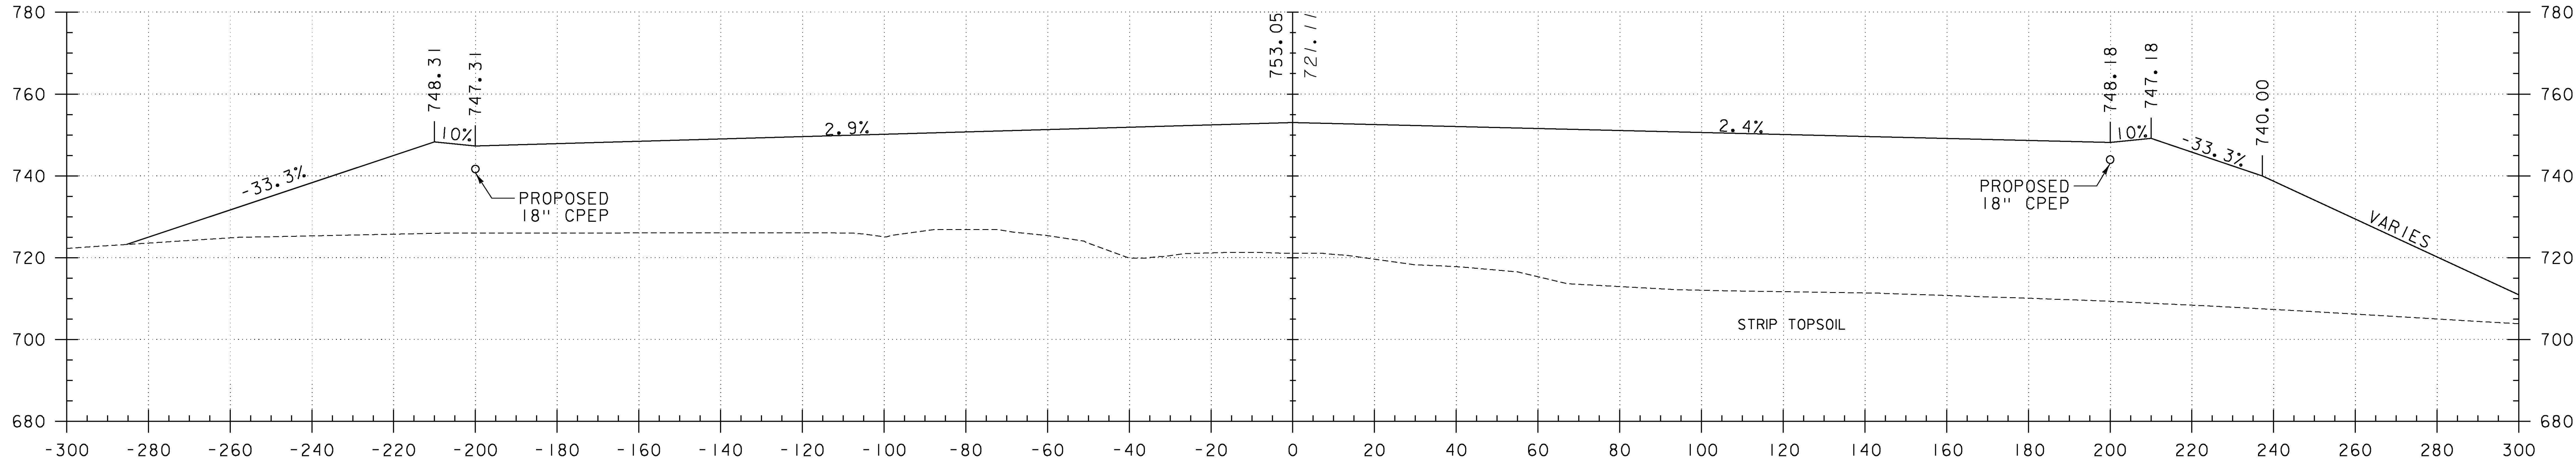

158+00

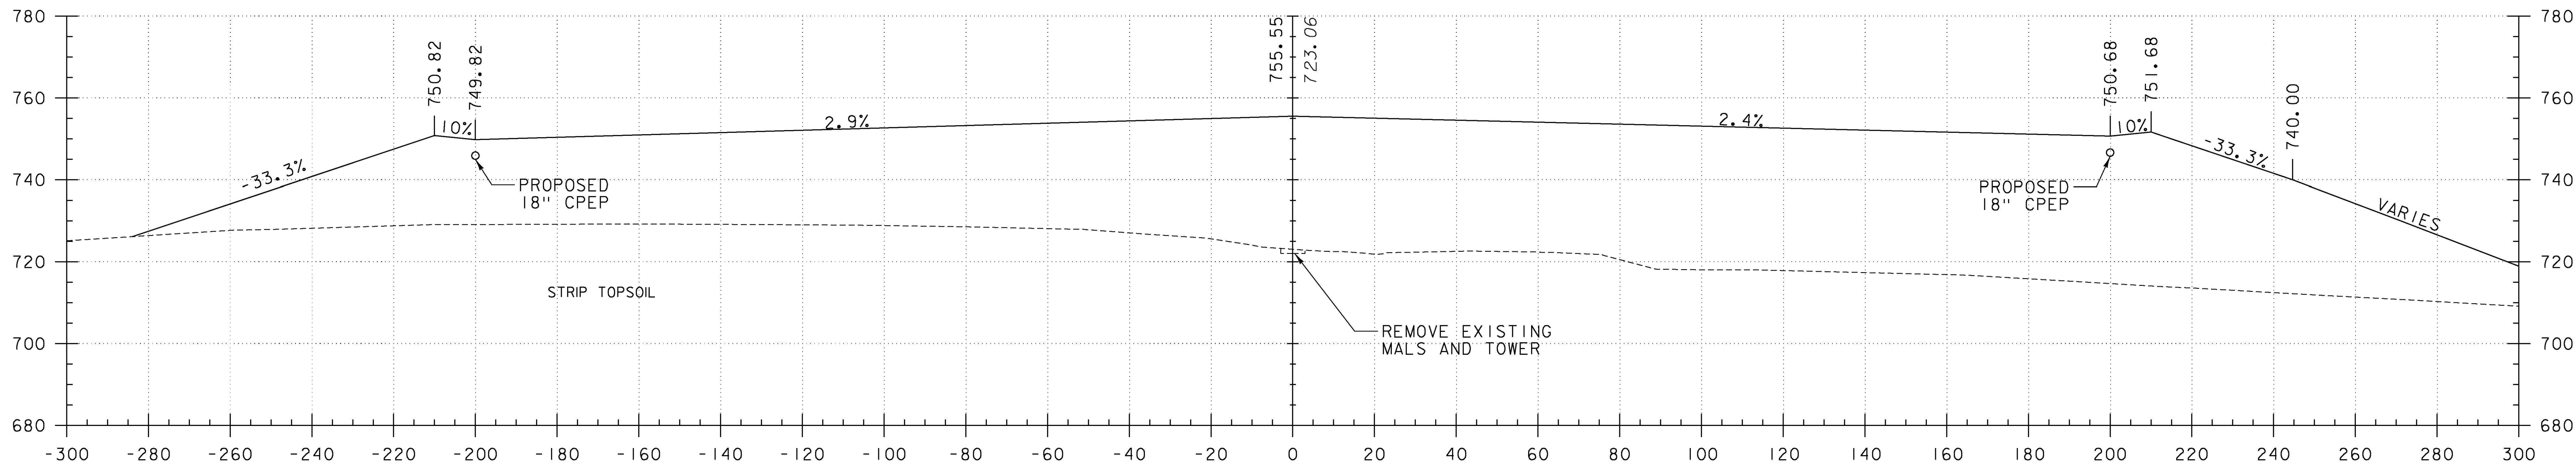

157+50



SCALE IN FEET

AIP 3-50-0015-34

VERMONT AGENCY OF TRANSPORTATION



**URS**  
 URS CORPORATION  
 3 CORPORATE DRIVE, SUITE 203  
 CLIFTON PARK, NY 12065  
 (518) 688-0015

PROJECT NAME: RUTLAND SOUTHERN VERMONT REGIONAL AIRPORT CLARENDON, VERMONT	PLOT DATE: 6/2/2013
PROJECT NUMBER: AV14-8018-300	DRAWN BY: M. KEMP
FILE NAME: z07h124xs_rsa5.dgn	CHECKED BY:
PROJECT LEADER: F. WALSH	SHEET 34 OF 36
DESIGNED BY: G. D'AMICO	
RSA CROSS SECTIONS	

PROJECT RECORD DRAWINGS

6/2/2013  
 P:\CADD\Consultants\z07h124xs\_rsa5.dgn