
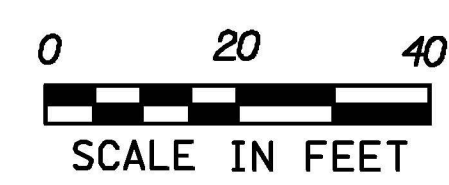
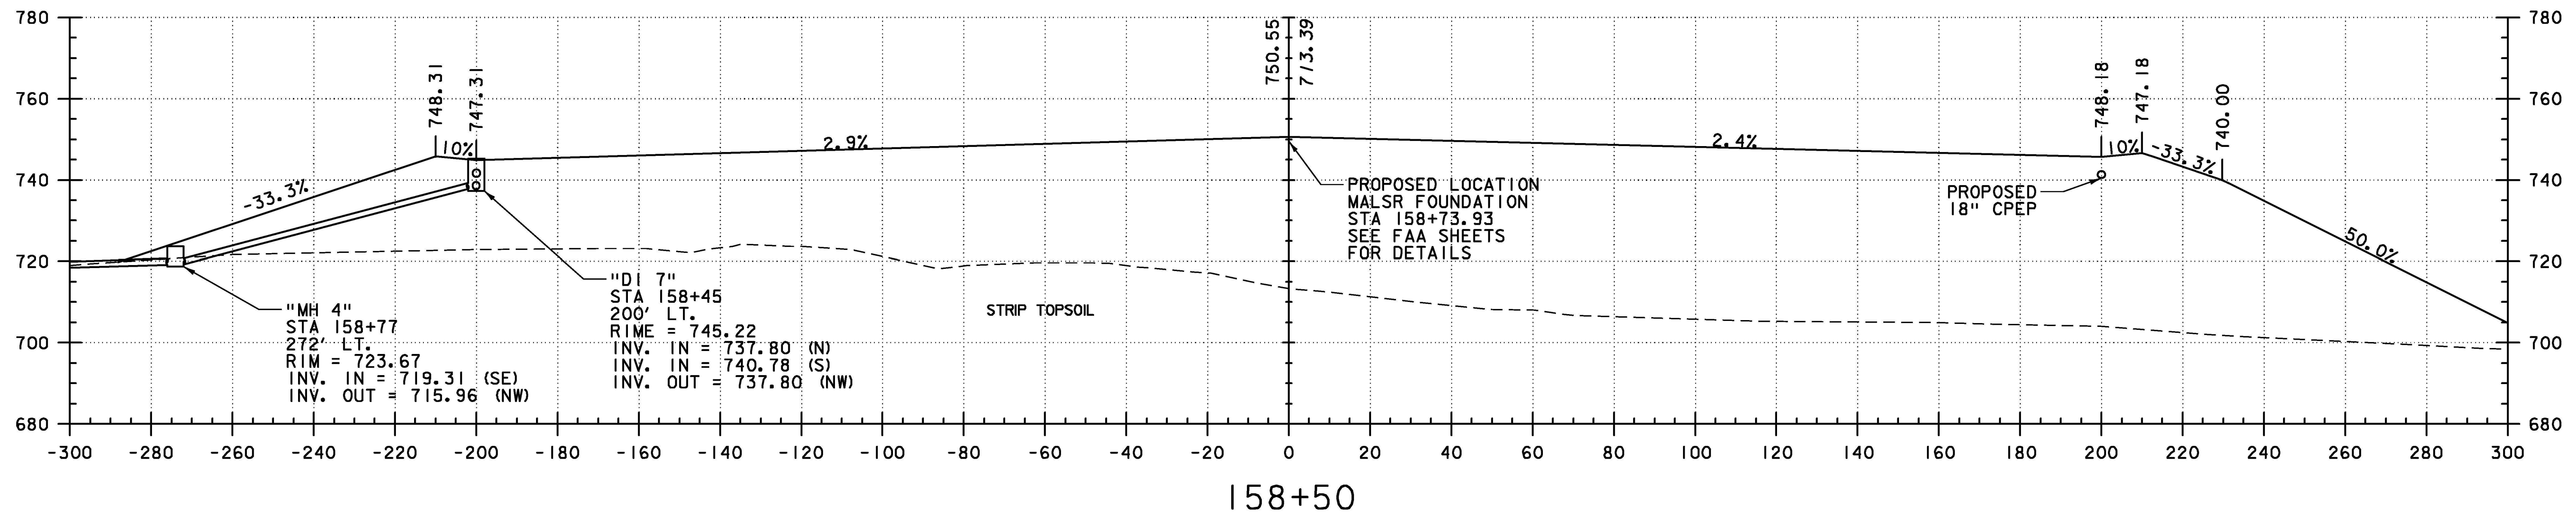


Record Drawing
 Finished grades are shown on
 Attachment A: Construction Survey
 Record Plan

See Drainage Plan
 for modifications to
 stormwater in this
 vicinity

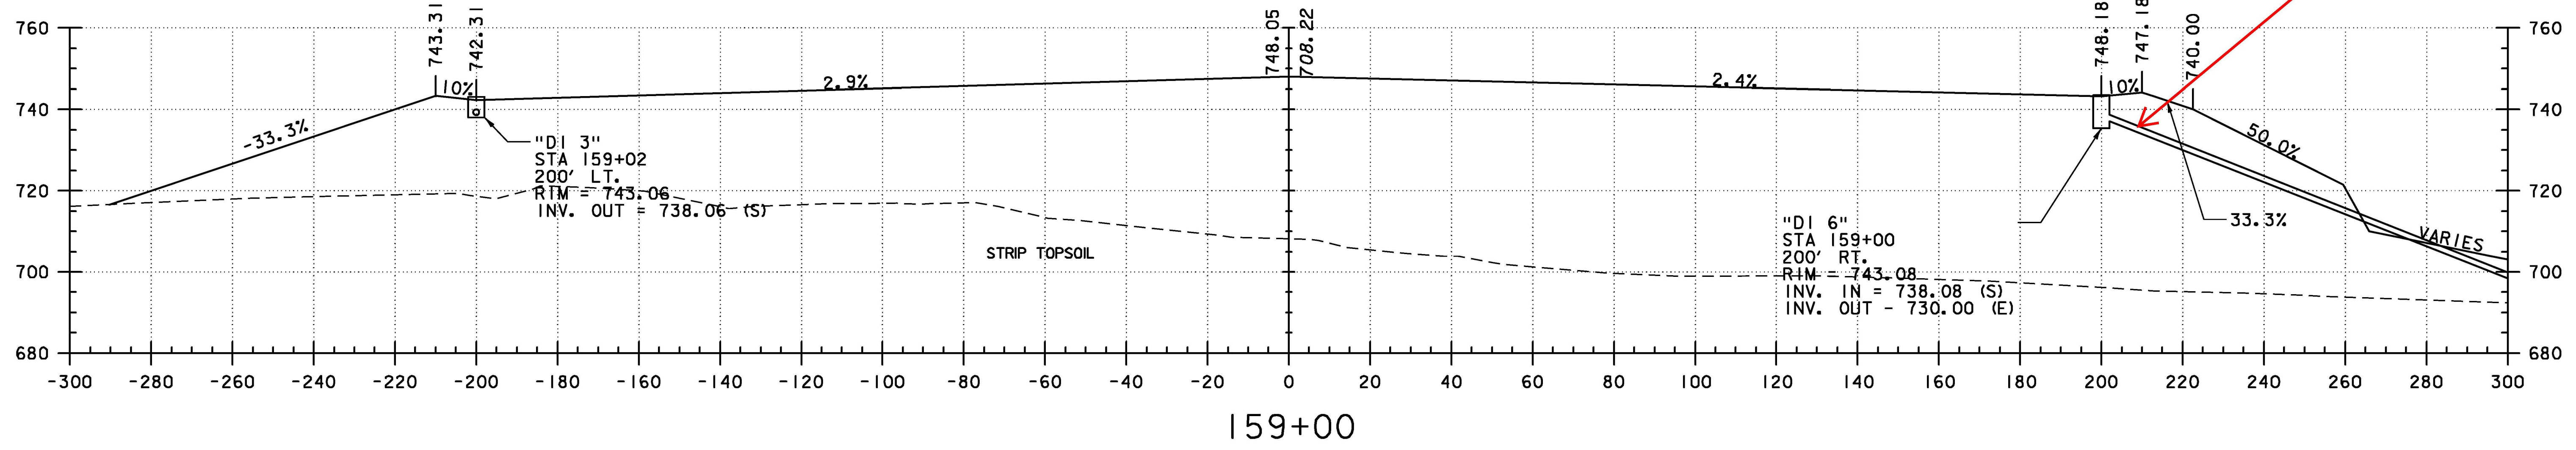

Addendum No. 2

AIP 3-50-0015-34

VERMONT AGENCY OF TRANSPORTATION



URS
 URS CORPORATION
 3 CORPORATE DRIVE, SUITE 203
 CLIFTON PARK, NY 12065
 (518) 688-0015

PROJECT NAME: RUTLAND SOUTHERN VERMONT REGIONAL AIRPORT
 CLARENDON, VERMONT
 PROJECT NUMBER: AV14-8018-300
 FILE NAME: z07h124xs_rsa6.dgn
 PROJECT LEADER: F. WALSH
 DESIGNED BY: G. D'AMICO
 RSA CROSS SECTIONS
 PLOT DATE: 6/13/2013
 DRAWN BY: M. KEMP
 CHECKED BY:
 SHEET 35 OF 36

PROJECT RECORD DRAWINGS

6/13/2013
 P:\CADD\Consultants\z07h124xs_rsa6.dgn