




Record Drawing
 Finished grades are shown on
 Attachment A: Construction Survey
 Record Plan

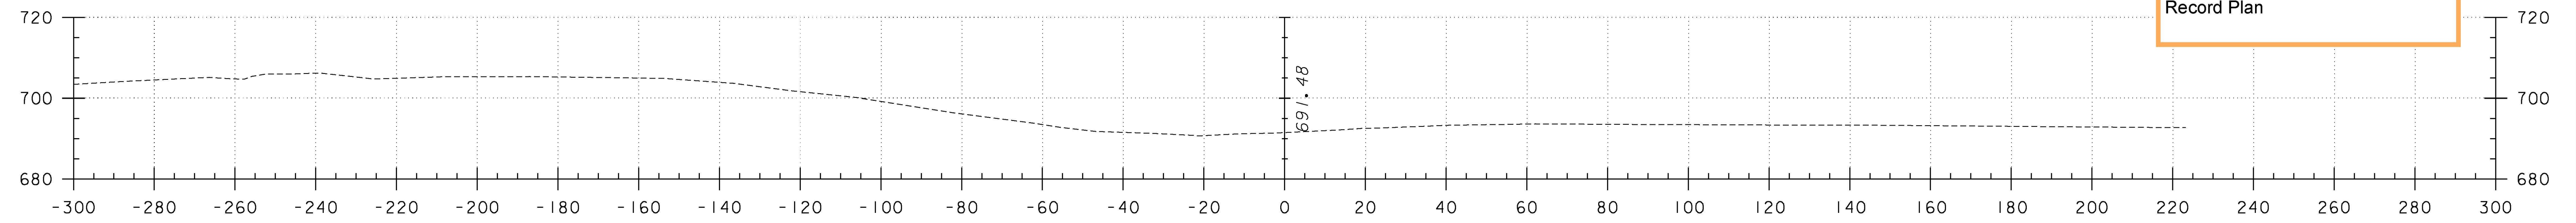


160+50
 END CONSTRUCTION 160+50 +/-

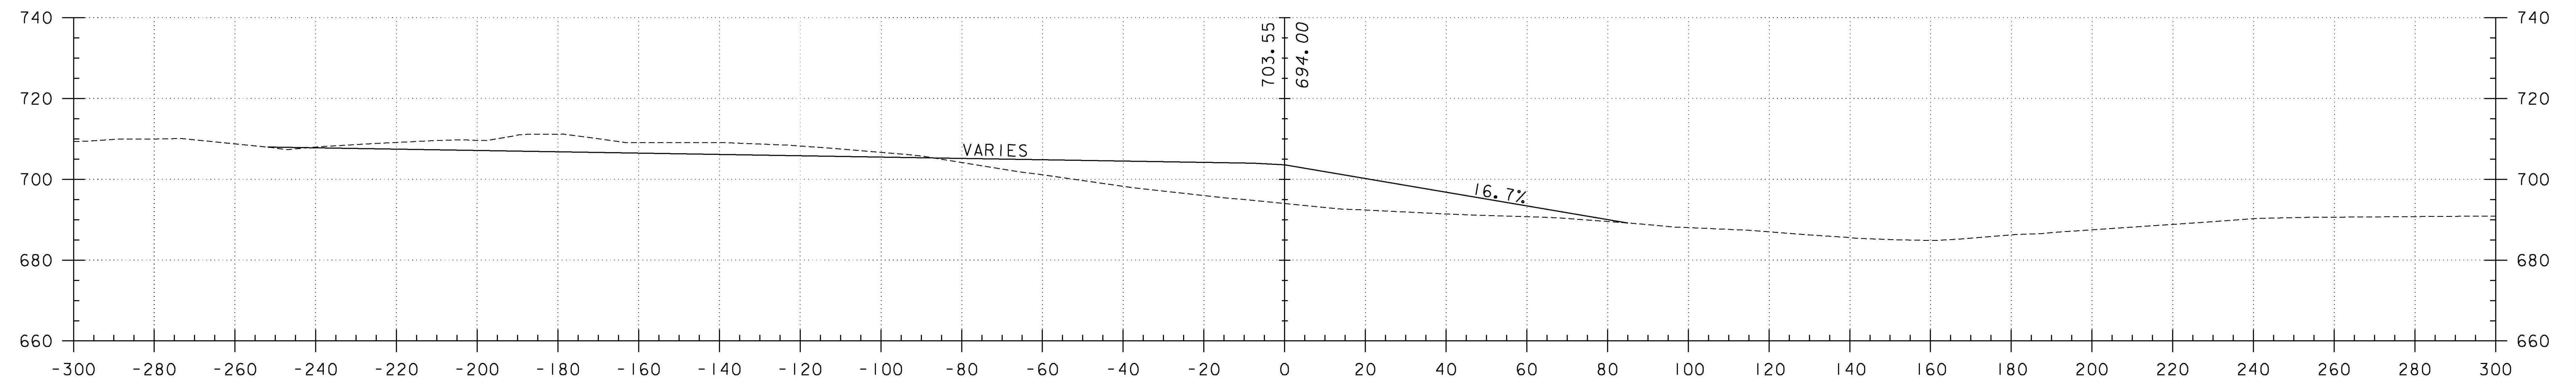

160+00

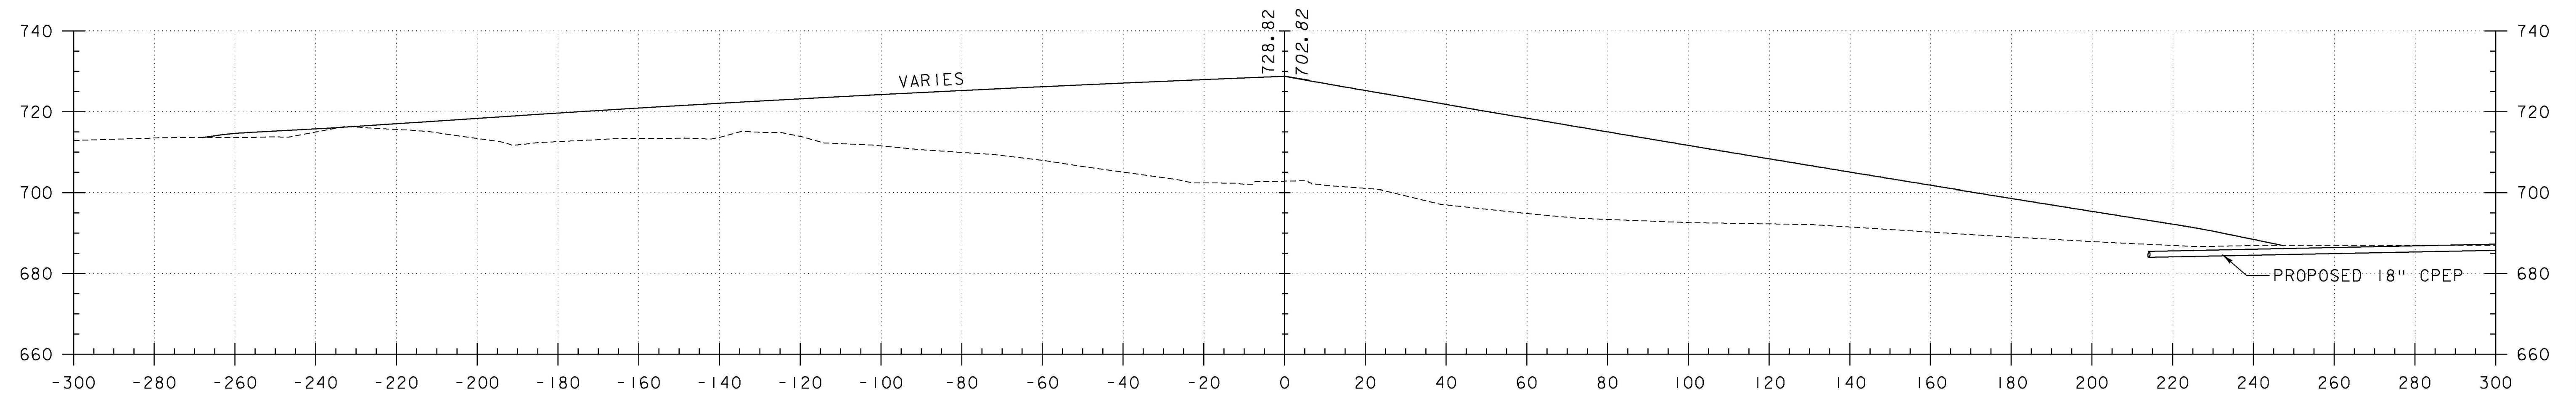

159+50

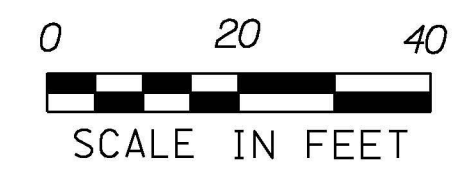

AIP 3-50-0015-34

VERMONT AGENCY OF TRANSPORTATION



URS
 URS CORPORATION
 3 CORPORATE DRIVE, SUITE 203
 CLIFTON PARK, NY 12065
 (518) 688-0015

PROJECT NAME: RUTLAND SOUTHERN VERMONT REGIONAL AIRPORT CLARENDON, VERMONT	PLOT DATE: 6/2/2013
PROJECT NUMBER: AV14-8018-300	DRAWN BY: M. KEMP
FILE NAME: z07h124xs_rsa7.dgn	CHECKED BY:
PROJECT LEADER: F. WALSH	SHEET 36 OF 36
DESIGNED BY: G. D'AMICO	
RSA CROSS SECTIONS	

PROJECT RECORD DRAWINGS

6/2/2013
 P:\CADD\Consultants\z07h124xs_rsa7.dgn