

VT STATE PLANE GRID

B.M. D Elev. 693.86
MAG NAIL 1/3 UP
IN POLE 7/197
Based On NAVD 88


B.M. A Elev. 773.31
MAG NAIL @ N WLY CORNER
RUNWAY 19
Based On NAVD 88

END OF RUNWAY
STA. 153+03.93
ELEV. 773.8

STA 161+04.5
N 379661.87
E 1521079.47

- LEGEND
- WETLAND LIMIT
 - - - EXISTING FENCE
 - STONE WALL
 - ◻ BUSH
 - R.O.W.
 - - - PROPERTY LINE
 - ... D.H. WIRES OVERHEAD WIRES
 - XX SURVEY POINT
 - 710 EXISTING CONTOUR W/ELEV.
 - - - EXISTING INT. CONTOUR

0 50 100
SCALE IN FEET

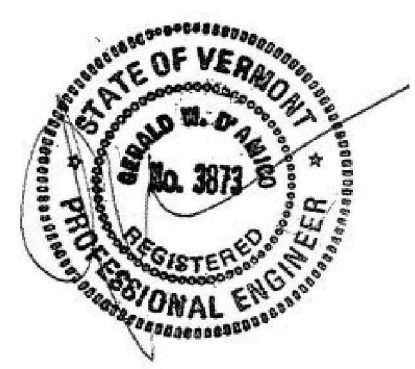

AIP 3-50-0015-34

VERMONT AGENCY OF TRANSPORTATION

URS
URS CORPORATION
3 CORPORATE DRIVE, SUITE 203
CLIFTON PARK, NY 12065
(518) 688-0015

PROJECT NAME: RUTLAND SOUTHERN VERMONT REGIONAL AIRPORT
CLARENDON, VERMONT
PROJECT NUMBER: AV14-8018-300
FILE NAME: z07h124ero_ecrsa.dgn
PLOT DATE: 6/2/2013
PROJECT LEADER: F. WALSH
DESIGNED BY: G. D'AMICO
EXISTING CONDITIONS PLAN-RSA
DRAWN BY: M. WASSON
CHECKED BY:
EC-1

6/2/2013
P:\CADD\Consultants\z07h124ero_ecrsa.dgn