





VT STATE PLANE GRID

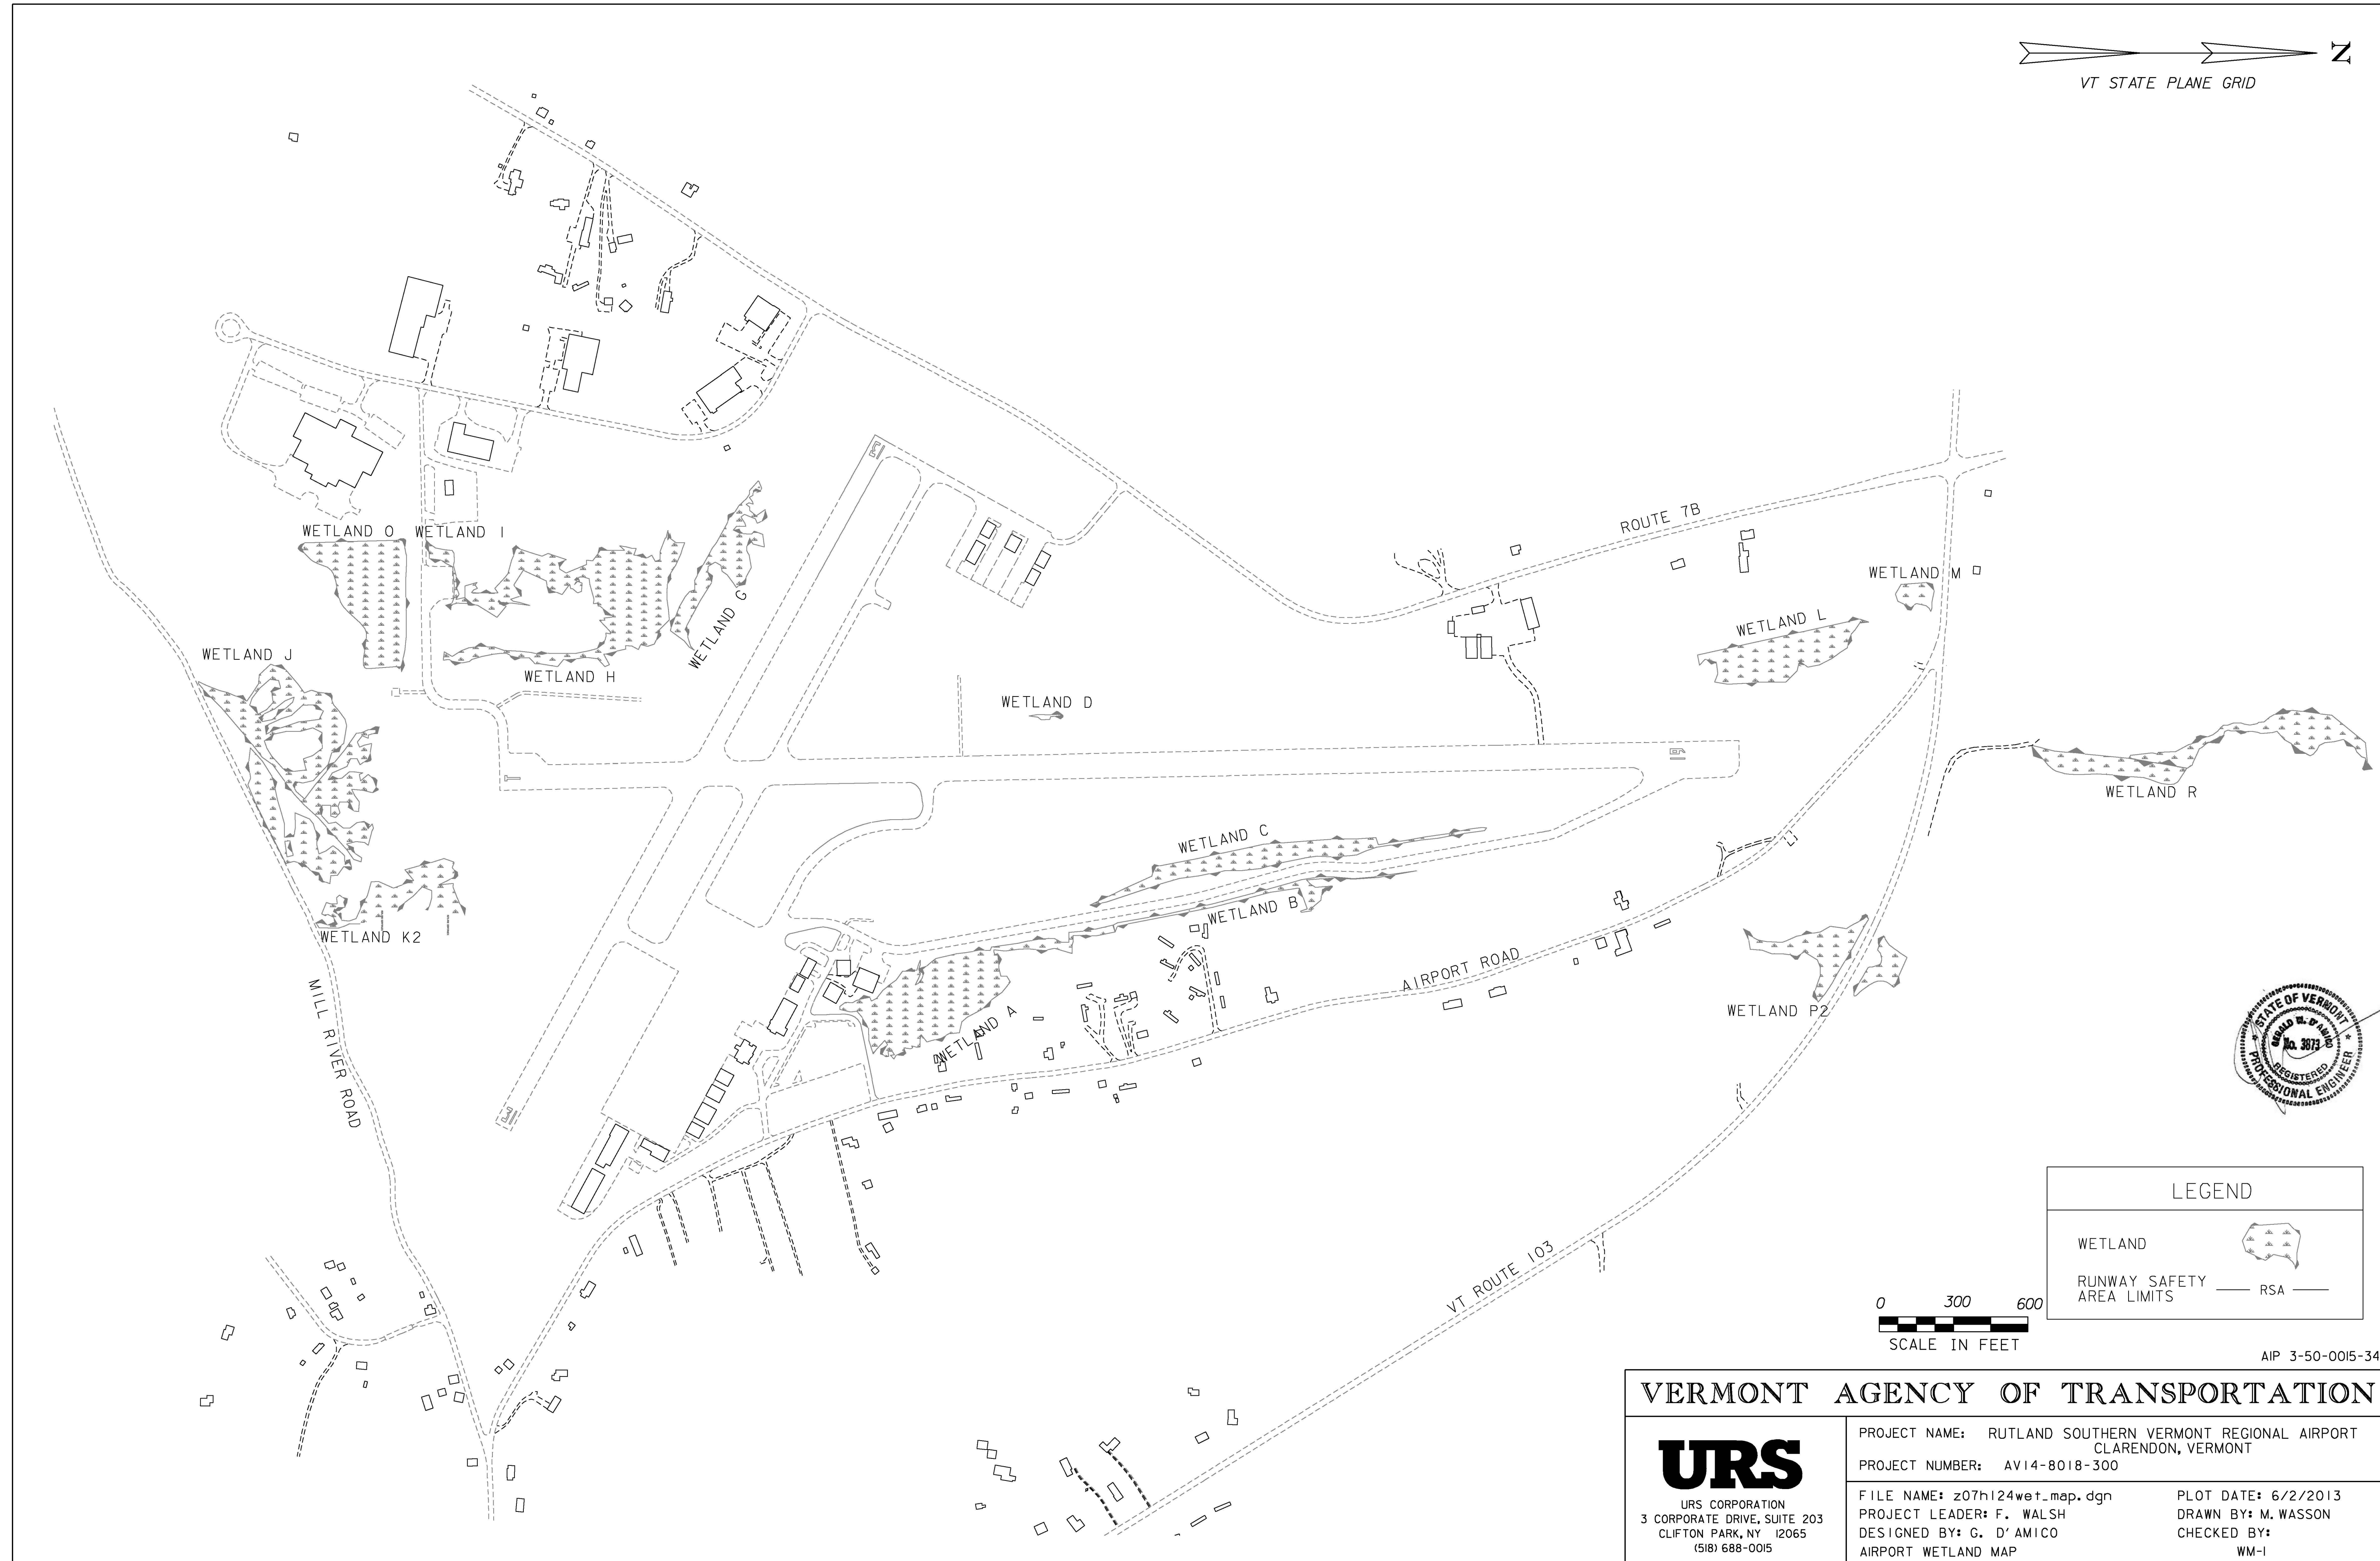

LEGEND	
WETLAND	
RUNWAY SAFETY AREA LIMITS	— RSA —

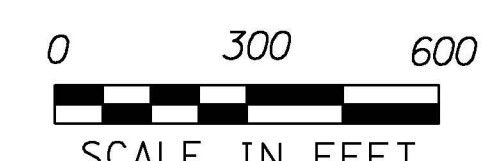

SCALE IN FEET

AIP 3-50-0015-34

VERMONT AGENCY OF TRANSPORTATION

URS
 URS CORPORATION
 3 CORPORATE DRIVE, SUITE 203
 CLIFTON PARK, NY 12065
 (518) 688-0015

PROJECT NAME: RUTLAND SOUTHERN VERMONT REGIONAL AIRPORT CLARENDON, VERMONT	PLOT DATE: 6/2/2013
PROJECT NUMBER: AV14-8018-300	DRAWN BY: M. WASSON
FILE NAME: z07h124wet_map.dgn	CHECKED BY:
DESIGNED BY: G. D'AMICO	WM-1
AIRPORT WETLAND MAP	

6/2/2013
P:\CADD\Consultants\z07h124wet_map.dgn

PROJECT RECORD DRAWINGS