


LEGEND	
	WETLAND LIMITS
	WETLAND BUFFER AREA LIMITS
	TEMPORARY WETLAND IMPACT
	PERMANENT WETLAND IMPACT
	WETLAND BUFFER AREA IMPACT

NOTES:
 1. WETLANDS DELINEATED JUNE 22, 2012
 BY THE SMART ASSOCIATES, INC.

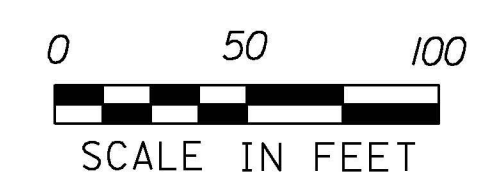

AIP 3-50-0015-34

VERMONT AGENCY OF TRANSPORTATION

URS
 URS CORPORATION
 3 CORPORATE DRIVE, SUITE 203
 CLIFTON PARK, NY 12065
 (518) 688-0015

PROJECT NAME: RUTLAND SOUTHERN VERMONT REGIONAL AIRPORT
 CLARENDON, VERMONT
 PROJECT NUMBER: AV14-8018-300
 FILE NAME: z07h124wet_imp.dgn
 PROJECT LEADER: F. WALSH
 DESIGNED BY: G. D'AMICO
 PROJECT WETLAND IMPACTS
 PLOT DATE: 6/2/2013
 DRAWN BY: M. WASSON
 CHECKED BY:
 WM-2

PROJECT RECORD DRAWINGS

6/2/2013 P:\CADD\Consultants\z07h124wet_imp.dgn