
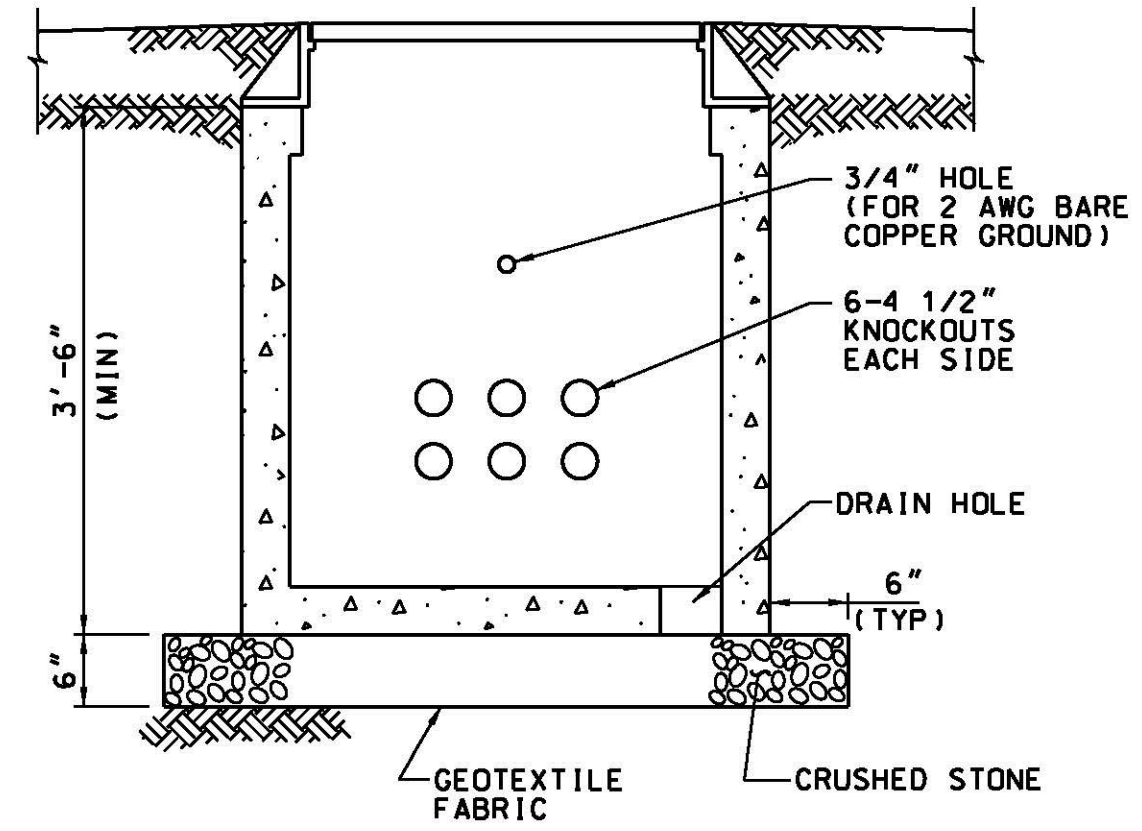


Record Drawings  
Work completed in general conformance with contract plans.

**HANDHOLE NOTES:**


1. CONCRETE COMPRESSIVE STRENGTH - 5,000 PSI MINIMUM.
2. STEEL REINFORCEMENT - ASTM A615, GRADE 60, 1" MINIMUM COVER.
3. MINIMUM DESIGN LOAD - 70,000 LBS DUAL WHEEL LOADING OR AASHTO HS20-44 AT A MINIMUM.
4. CAST GRAY IRON HANDHOLE FRAME AND COVER SHALL BE NEENAH AIRPORT CASTING R-3492 SERIES OR APPROVED EQUAL.
5. CAST IRON FRAME SHALL BE MECHANICALLY FASTENED TO THE HANDHOLE.
6. A PULLEYE SHALL BE PROVIDED ON EACH WALL.
7. INSTALL A CRUSHED STONE SUMP UNDER ALL HANDHOLES. TOP, SIDES AND BOTTOM OF SUMP SHALL BE LINED WITH A WATER PERMEABLE GEOTEXTILE FABRIC.
8. AFTER INSTALLATION OF CONDUITS THROUGH KNOCKOUTS. GROUT AROUND CONDUIT.
9. CABLE SLACK LOOPS SHALL BE LABELED AND RACKED IN ALL HANDHOLES.
10. INSTALL ONE 3/4", 10 FOOT LONG GROUND ROD AT EACH HANDHOLE OR SET OF ADJACENT HANDHOLES. BOND THIS GROUND ROD TO EITHER THE GRSC OR THE 1/0 AWG BARE COPPER GUARD WIRE OVER ANY PVC CONDUIT.
11. HANDHOLE MAY BE LOCATED INSIDE OF THE RUNWAY SAFETY AREA (RSA).

AIRCRAFT RATED FRAME AND COVER  
LABEL ACCORDINGLY 'FAA POWER'

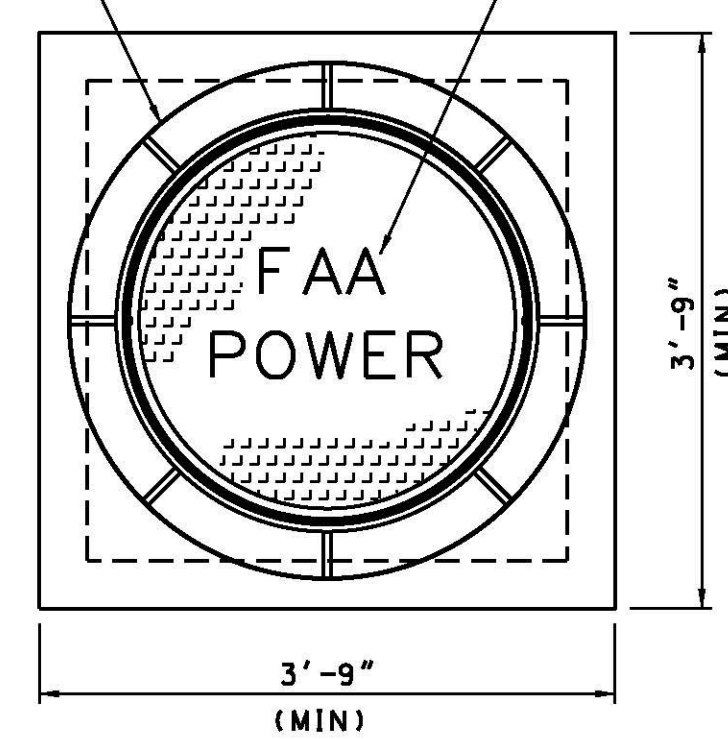


1 TYPICAL HANDHOLE DETAIL  
C001 NOT TO SCALE


LOAM AND RESEED ALL DISTURBED AREAS IN EXISTING GRASS AREAS

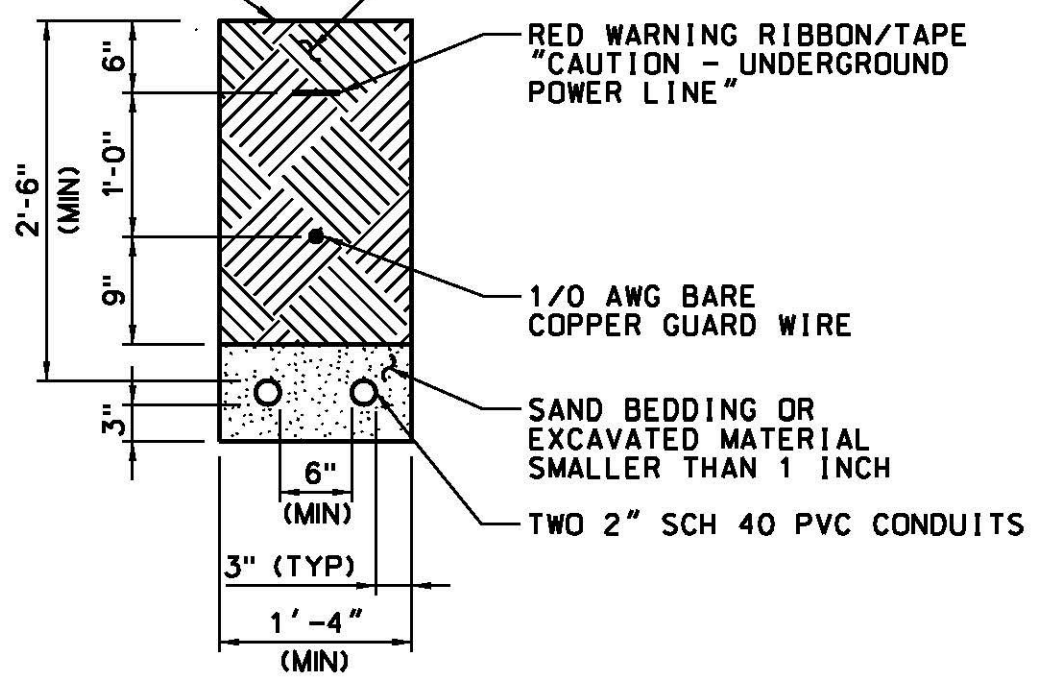

A TRENCH DETAIL  
C001 SCALE: 3/4" = 1'-0"

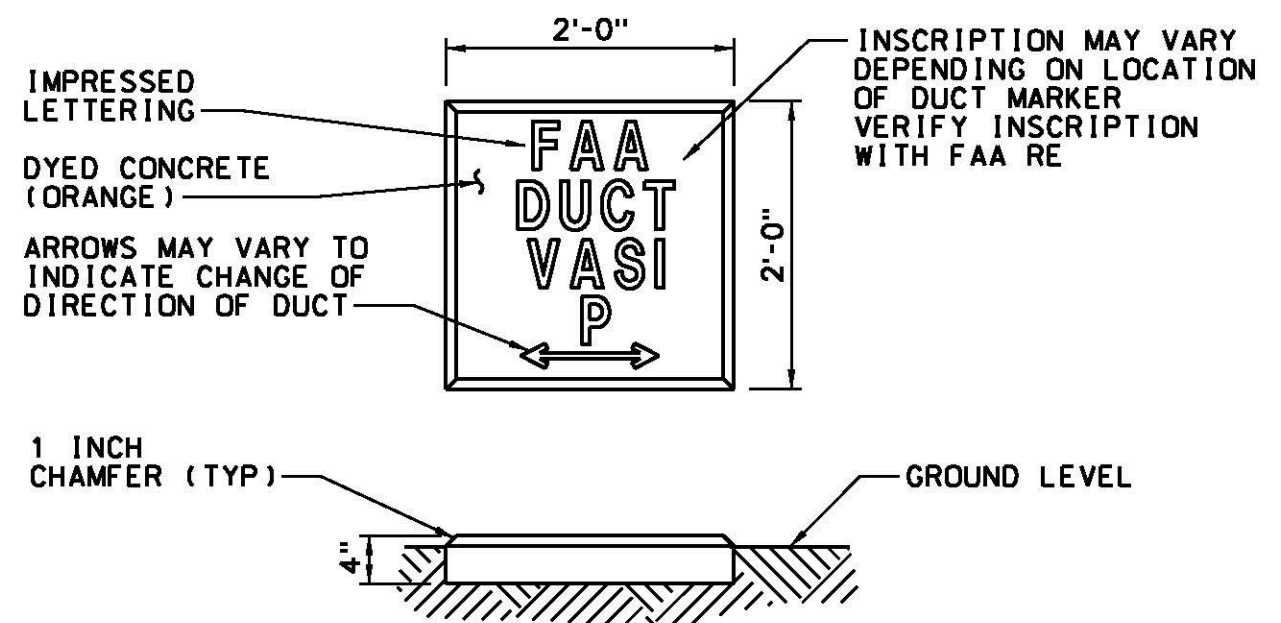

2 CONCRETE DUCT MARKER  
C002 SCALE: 3/4" = 1'-0"

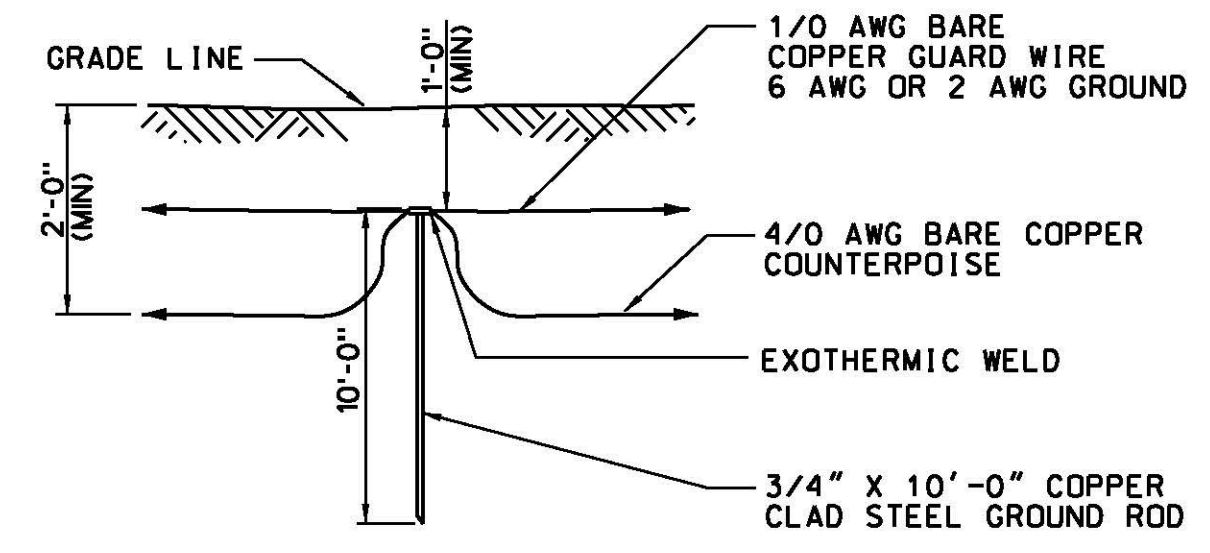

3 TYPICAL GROUND ROD INSTALLATION  
C002 NOT TO SCALE (SEE NOTE 2)

**NOTES:**


1. PROVIDE SIX INCH (MINIMUM) CLEAR DISTANCE BETWEEN POWER AND CONTROL OR SIGNAL CONDUITS. PROVIDE SIX INCH (MINIMUM) CLEAR DISTANCE BETWEEN POWER AND HIGH VOLTAGE CONDUITS. PROVIDE SIX INCH (MINIMUM) CLEAR DISTANCE BETWEEN HIGH VOLTAGE AND CONTROL OR SIGNAL CONDUITS.
2. FOR INSTALLATION OF GUARD WIRE AND GROUND ROD SPACING, SEE DRAWING RUT-NEZ120015-G003, NOTE 10 UNDER ELECTRICAL GROUNDING.

REV	APPROVED DATE	DESCRIPTION	JCN	REDLINE DATE	APV
	05/20/2013	CONSTRUCTION, WR *12738 (RUT)	992395	01/31/2013	

DEPARTMENT OF TRANSPORTATION  
FEDERAL AVIATION ADMINISTRATION  
ATO - TECHNICAL OPERATIONS EASTERN SERVICE AREA

VASI  
RUNWAY 19  
MISCELLANEOUS DETAILS  
SHEET 1 OF 2

RUTLAND	RUTLAND - SOUTHERN VERMONT REGIONAL AIRPORT	VT
REVIEWED BY	SUBMITTED BY	APPROVED BY
	D.L. WEBER	P. KIRBY
PROJECT ENGINEER	MGR: ENGINEERING - CENTER C	
DESIGNED	ISSUED BY	DATE
DLW	RUT	05/20/2013
DRAWN	ENGINEERING SERVICES	JCN
RUT	NAVAIDS	992395
CHECKED	DLW	DRAWING NO
		RUT-NEZ120016-C002

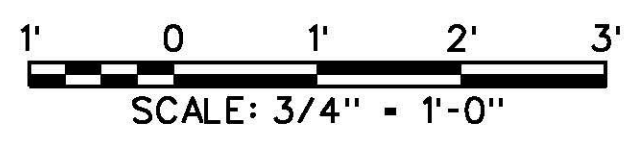

10/14/2013 3:03:12 PM Plotted by Scott CTR Pelteng

ISSUED FOR CONSTRUCTION  
EDM: rut-nez120016-c002.dgn