
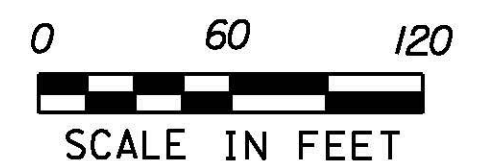
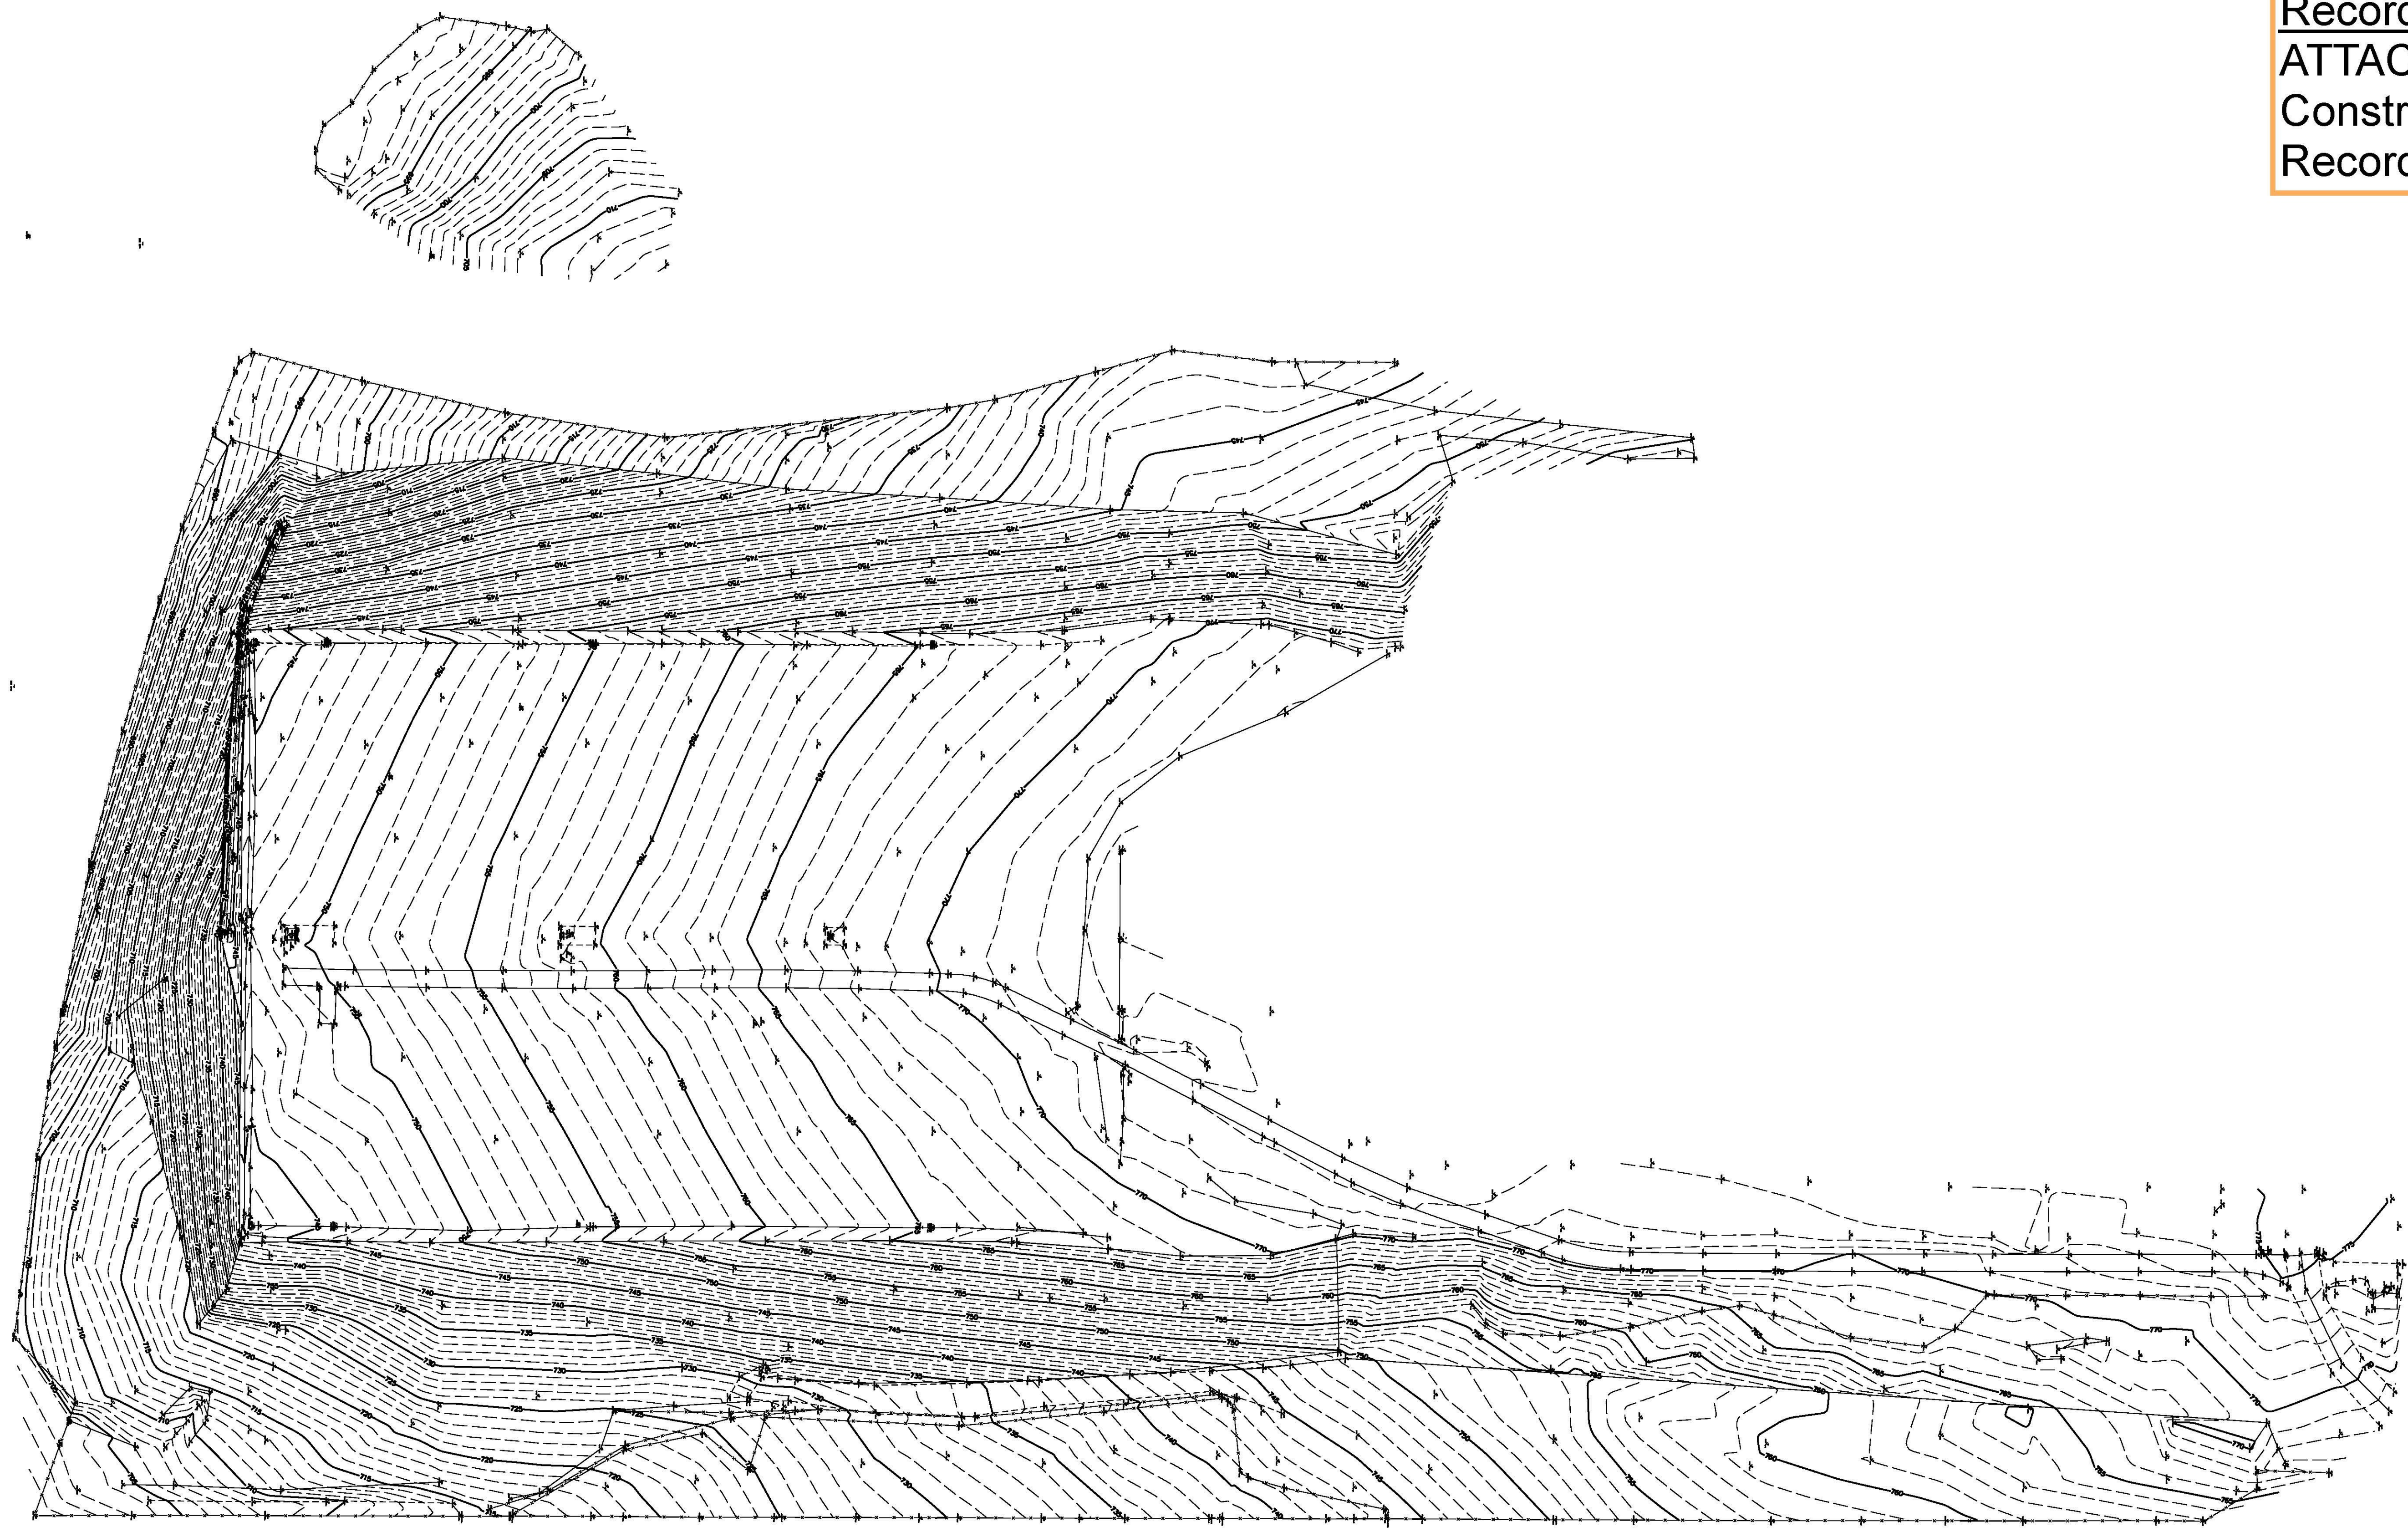


Record Drawings
ATTACHMENT A:
Construction Survey
Record Plan

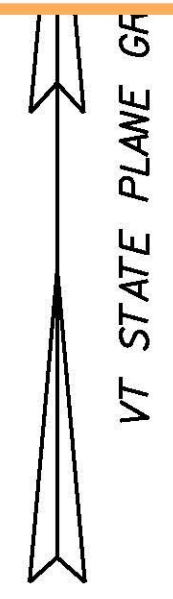

RUTLAND SOUTHERN VERMONT REGIONAL AIRPORT
RUNWAY 19 SAFETY AREA IMPROVEMENTS , PHASE II

PROJECT NUMBER: AV14-8018-300	PLOT DATE: 6/12/2015
FILE NAME: 322161-2014-12-24.DGN	DRAWN BY: R. OTIS
PROJECT LEADER: DAVE CONGER	CHECKED BY: G. STOCKMAN
	SHEET 1 OF 1