

STATE OF VERMONT
AGENCY OF TRANSPORTATION



PROPOSED IMPROVEMENT
AIRPORT PROJECT

ON-SITE WASTEWATER
DISPOSAL SYSTEM

SCHEDULE B - SITE 2 ONLY

SITE 1 NOT CONSTRUCTED IN
THIS CONTRACT


NEWPORT STATE AIRPORT

TOWN OF COVENTRY

COUNTY OF ORLEANS

| SHEET LIST | | |
|------------|-----------------------------------|----------|
| SHEET | TITLE | |
| G-00 | KEY PLAN | 1 OF 36 |
| G-01 | OVERALL PLAN | 2 OF 36 |
| G-02 | WASTEWATER SUBDIVISION PLAN | 3 OF 36 |
| TP1-01 | SITE 1 - TEST PIT LOCATION PLAN 1 | 4 OF 36 |
| P1-01 | SITE 1 - PIPING LAYOUT PLAN 1 | 5 OF 36 |
| P1-02 | SITE 1 - PIPING LAYOUT PLAN 2 | 6 OF 36 |
| P1-03 | SITE 1 - PIPING LAYOUT PLAN 3 | 7 OF 36 |
| P1-04 | SITE 1 - PIPING LAYOUT PLAN 4 | 8 OF 36 |
| P1-05 | SITE 1 - STRUCTURE DATA | 9 OF 36 |
| PR1-01 | SITE 1 - SANITARY PROFILE 1 | 10 OF 36 |
| PR1-02 | SITE 1 - SANITARY PROFILE 2 | 11 OF 36 |
| PR1-03 | SITE 1 - SANITARY PROFILE 3 | 12 OF 36 |
| PR1-04 | SITE 1 - SANITARY PROFILE 4 | 13 OF 36 |
| PR1-05 | SITE 1 - SANITARY PROFILE 5 | 14 OF 36 |
| MD1-01 | SITE 1 - MOUND A DETAIL | 15 OF 36 |
| MD1-02 | SITE 1 - MOUND B DETAIL | 16 OF 36 |
| TP2-01 | SITE 2 - TEST PIT LOCATION PLAN 1 | 17 OF 36 |
| TP2-02 | SITE 2 - TEST PIT LOCATION PLAN 2 | 18 OF 36 |
| TP2-03 | SITE 2 - TEST PIT LOCATION PLAN 3 | 19 OF 36 |
| P2-01 | SITE 2 - PIPING LAYOUT PLAN 1 | 20 OF 36 |
| P2-02 | SITE 2 - PIPING LAYOUT PLAN 2 | 21 OF 36 |
| P2-03 | SITE 2 - PIPING LAYOUT PLAN 3 | 22 OF 36 |
| P2-04 | SITE 2 - PIPING LAYOUT PLAN 4 | 23 OF 36 |
| P2-05 | SITE 2 - PIPING LAYOUT PLAN 5 | 24 OF 36 |
| PR2-01 | SITE 2 - SANITARY PROFILE 1 | 25 OF 36 |
| PR2-02 | SITE 2 - SANITARY PROFILE 2 | 26 OF 36 |
| PR2-03 | SITE 2 - SANITARY PROFILE 3 | 27 OF 36 |
| MD2-01 | SITE 2 - MOUNDS C & D DETAILS | 28 OF 36 |
| MD2-02 | SITE 2 - MOUND E DETAIL | 29 OF 36 |
| MD2-03 | SITE 2 - MOUND F DETAIL | 30 OF 36 |
| SD-01 | SANITARY SEWER DETAILS | 31 OF 36 |
| SD-02 | SANITARY SEWER DETAILS | 32 OF 36 |
| SD-03 | SANITARY SEWER DETAILS | 33 OF 36 |
| SD-04 | SANITARY SEWER DETAILS | 34 OF 36 |
| SD-05 | SANITARY SEWER DETAILS | 35 OF 36 |
| E-01 | ELECTRICAL - 1 | 36 OF 36 |

SITE 1 SYSTEM
INCLUDED FOR
REFERENCE ONLY.
NOT PART OF
SCHEDULE B FOR
THIS CONTRACT.

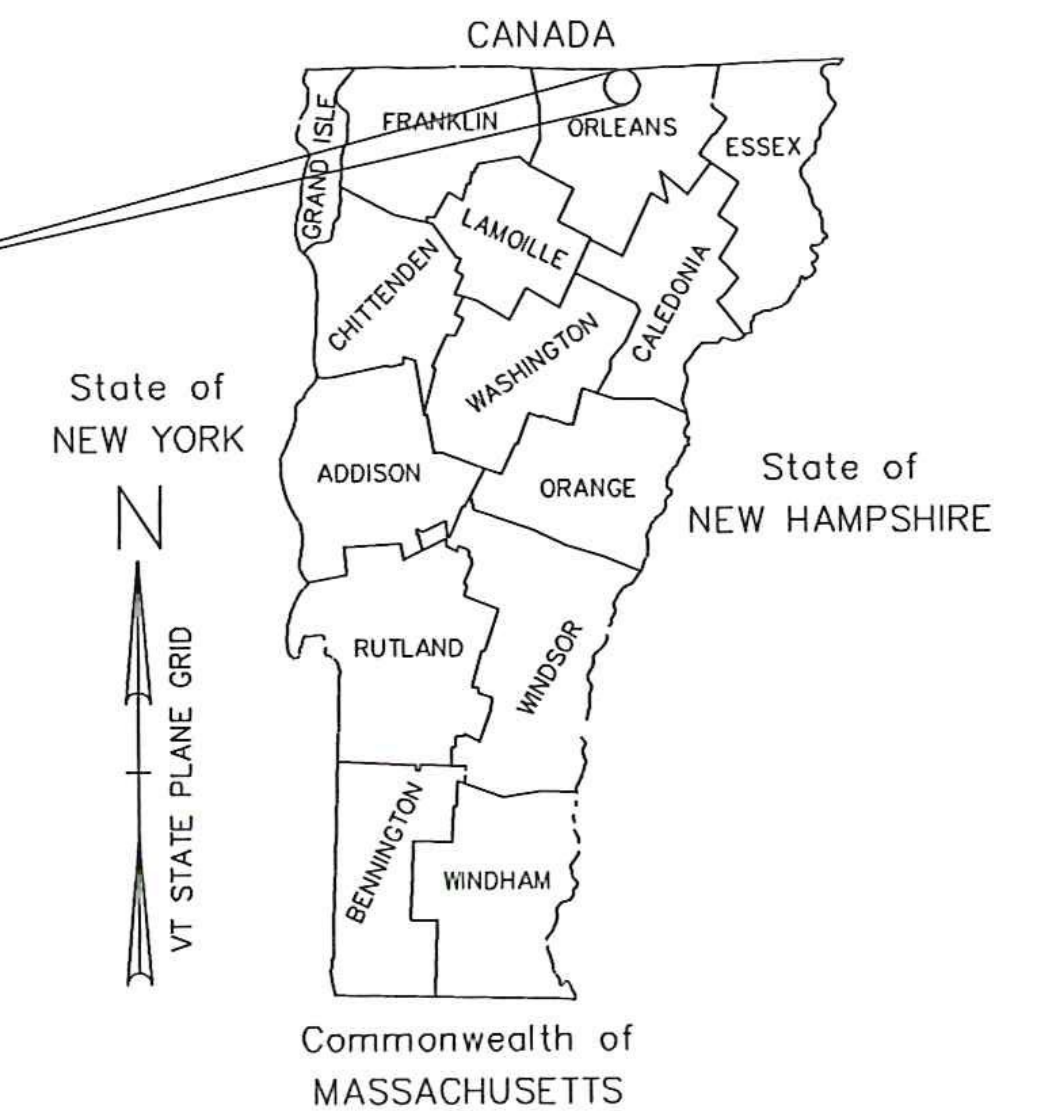

PROJECT LOCATION

REDLING ASBUILTS BY
CASSELLA CONSTRUCTION, INC.
3/12/18 (DWG FILE ALSO COMPLETED
WITH SURVEYED ASBUILT LOC. OF PIPES)

PREPARED BY:



McFarland Johnson

53 REGIONAL DRIVE
CONCORD, NEW HAMPSHIRE 03301
PHONE: 603-225-2978
FAX: 603-225-0095

SCHEDULE B - WASTEWATER SYSTEM - BID SET

VTRANS PROJECT #AVI157046-301

JUNE 2016

BY: JTC