

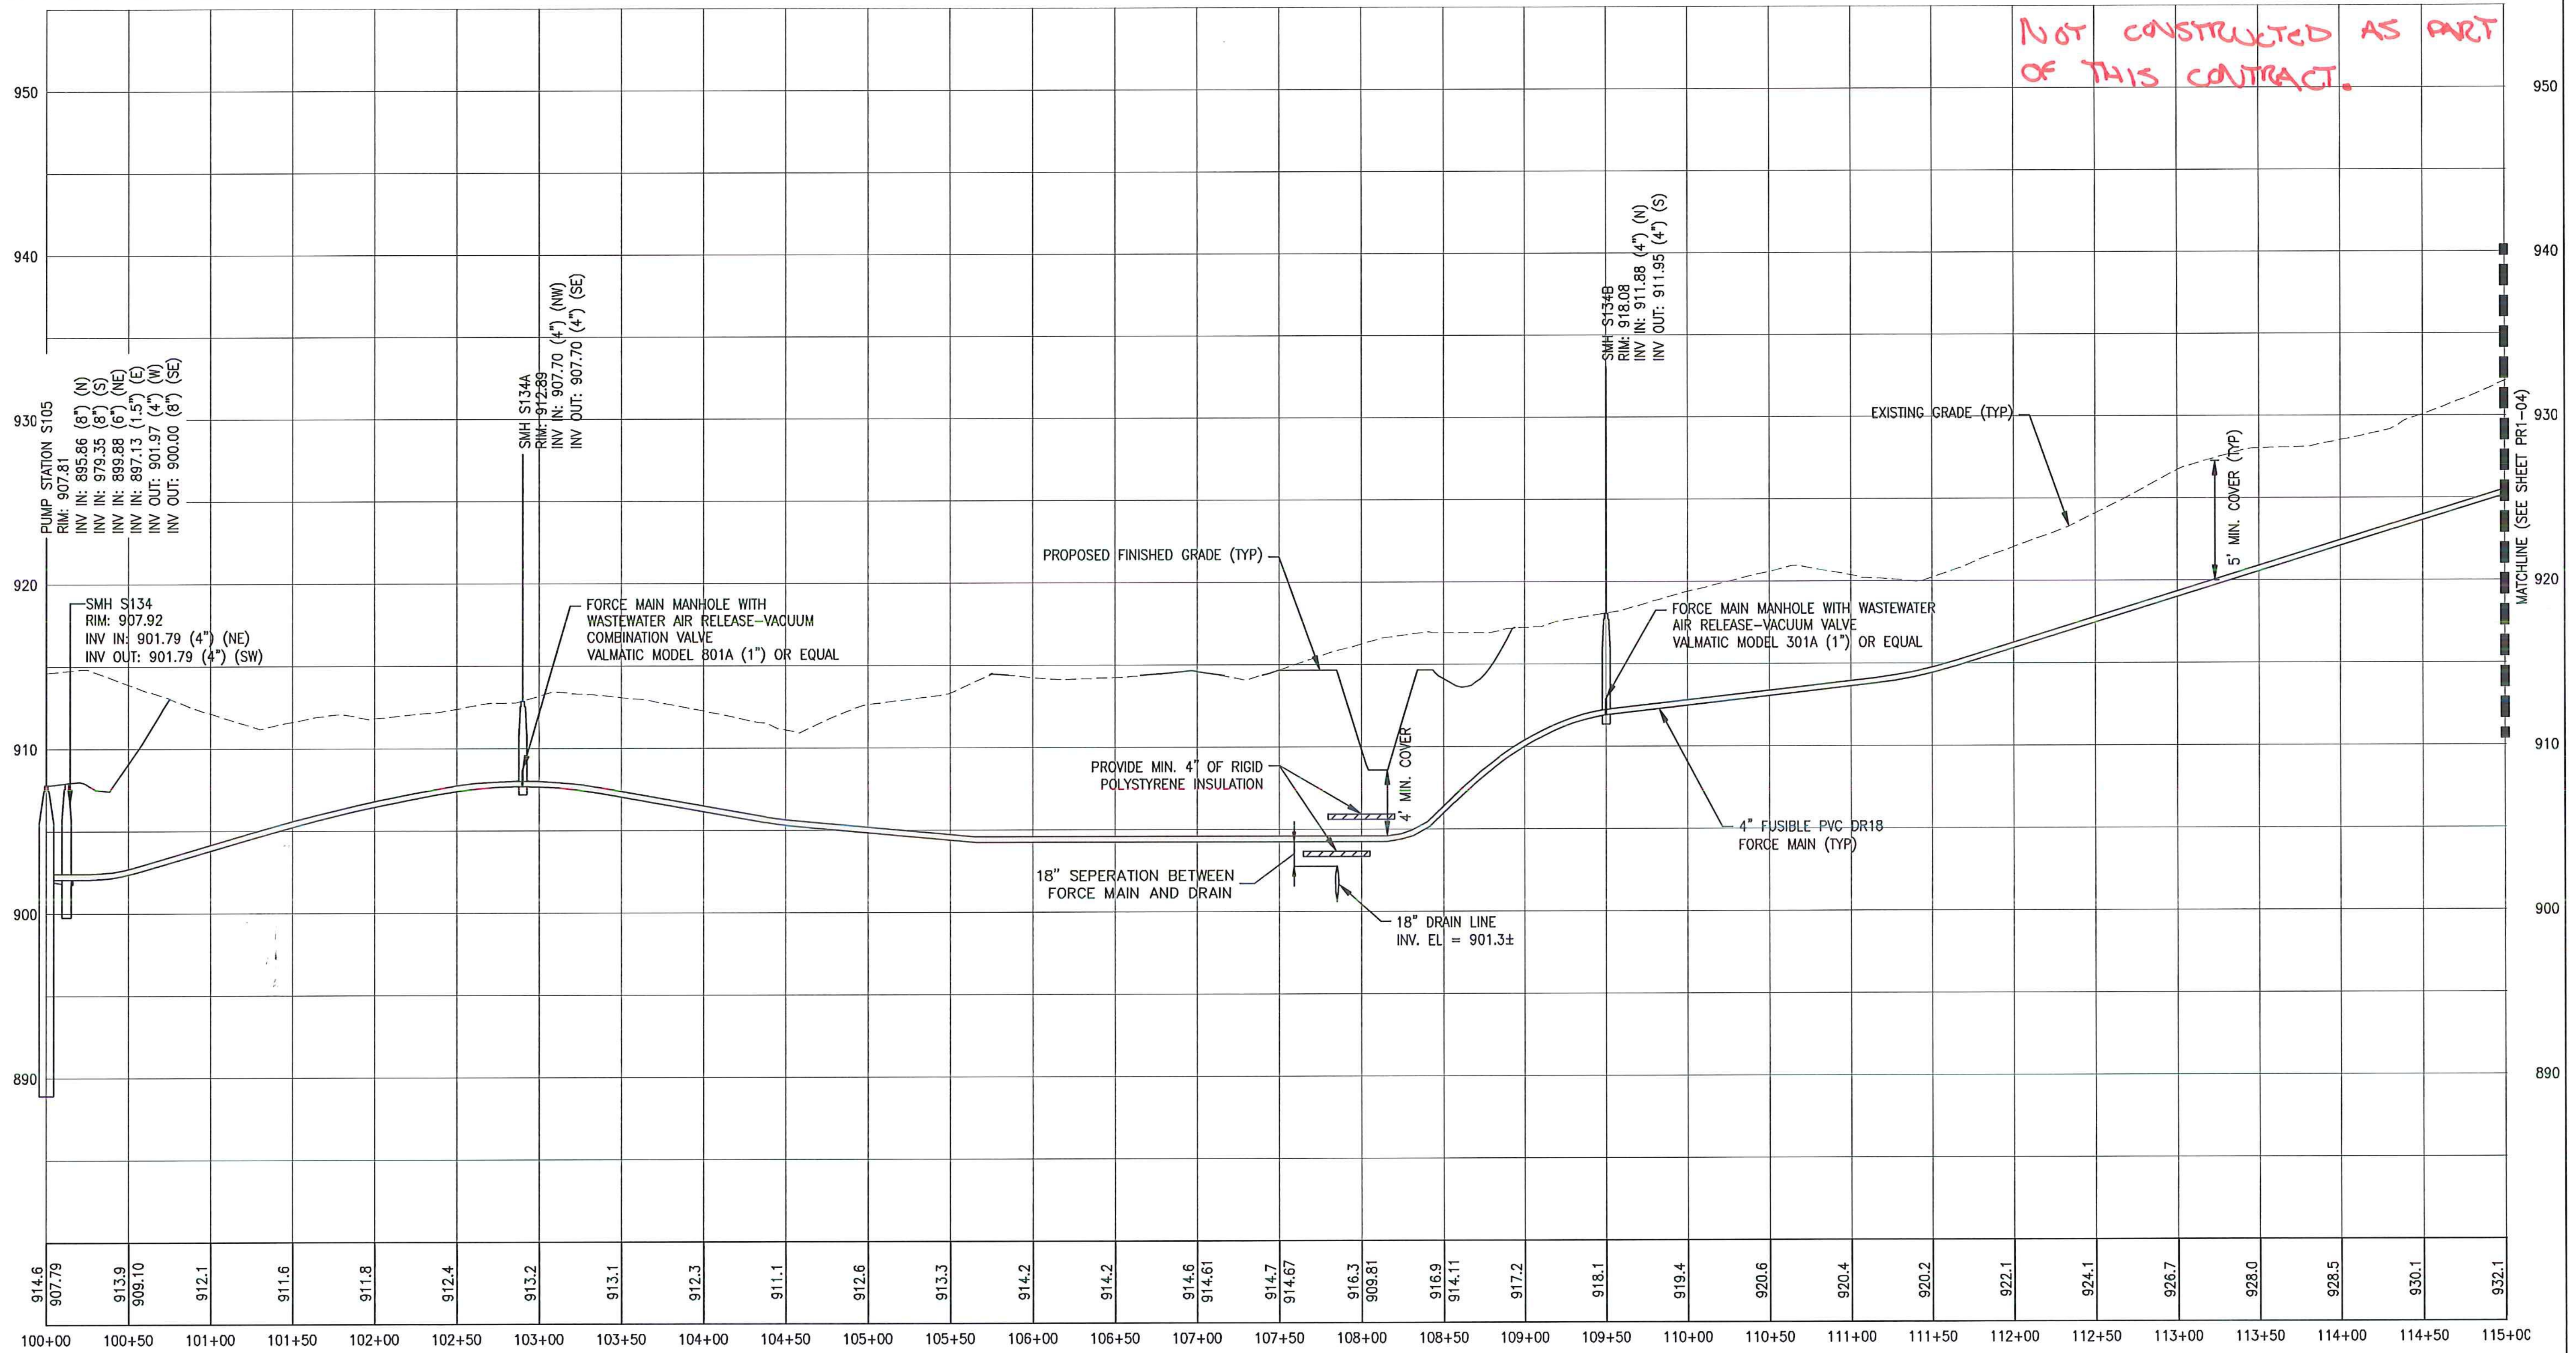


NOT CONSTRUCTED AS PART OF THIS CONTRACT.

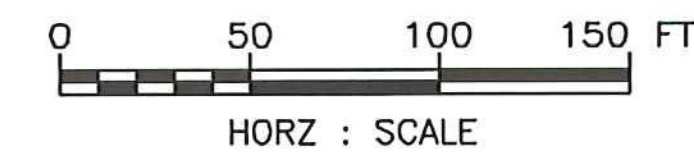

914.6  
907.79  
913.9  
909.10  
912.1  
911.6  
911.8  
912.4  
913.2  
913.1  
912.3  
911.1  
912.6  
913.3  
914.2  
914.2  
914.6  
914.61  
914.7  
914.67  
916.3  
909.81  
916.9  
914.11  
917.2  
918.1  
919.4  
920.6  
920.4  
920.2  
922.1  
924.1  
926.7  
928.0  
928.5  
930.1  
932.1

100+00 100+50 101+00 101+50 102+00 102+50 103+00 103+50 104+00 104+50 105+00 105+50 106+00 106+50 107+00 107+50 108+00 108+50 109+00 109+50 110+00 110+50 111+00 111+50 112+00 112+50 113+00 113+50 114+00 114+50 115+00

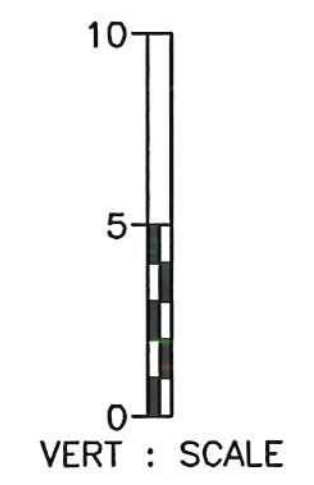

PERMIT PLANS

|     |         |                            |     |
|-----|---------|----------------------------|-----|
| 5   | 5/3/15  | COLD WEATHER MODIFICATIONS | BMB |
| 4   | 4/29/15 | PERMITTING MODIFICATIONS   | SKI |
| 3   | 1/30/15 | WW SYSTEM MODIFICATIONS    | BMB |
| 2   | 8/5/14  | ANR COMMENTS               | TCB |
| 1   | 4/18/14 | ADD 400-SERIES TEST PITS   | CH  |
| REV | DATE    | DESCRIPTION                | BY  |

IT IS A VIOLATION OF LAW FOR ANY PERSON, UNLESS THEY ARE ACTING UNDER THE DIRECT DIRECTION OF A LICENSED PROFESSIONAL ENGINEER, ARCHITECT, LANDSCAPE ARCHITECT, OR LAND SURVEYOR, TO ALTER AN ITEM IN ANY WAY. IF AN ITEM BEARING THE STAMP OF A LICENSED PROFESSIONAL IS ALTERED, THE ALTERING ENGINEER, ARCHITECT, LANDSCAPE ARCHITECT, OR LAND SURVEYOR SHALL STAMP THE DOCUMENT AND INCLUDE THE NOTATION "ALTERED BY" FOLLOWED BY THEIR SIGNATURE, THE DATE OF SUCH ALTERATION, AND A SPECIFIC DESCRIPTION OF THE ALTERATION.

NEWPORT STATE AIRPORT  
COVENTRY, VERMONT  
NEWPORT WASTEWATER

SITE 1 - SANITARY PROFILE 3



**McFarland Johnson**  
53 REGIONAL DRIVE  
CONCORD, NH 03301

|                      |                   |                    |
|----------------------|-------------------|--------------------|
| SCALE: H 1:50, V 1:5 | DESIGN: TCB       | PR1-03<br>12 OF 36 |
| DRAWN: MTF           | PROJECT: 17958.01 |                    |
| CHECKED: BLS         | DATE: JUNE, 2014  |                    |