


MATCHLINE - SEE DRAWING NO. P1

MATCHLINE - SEE DRAWING NO. P3

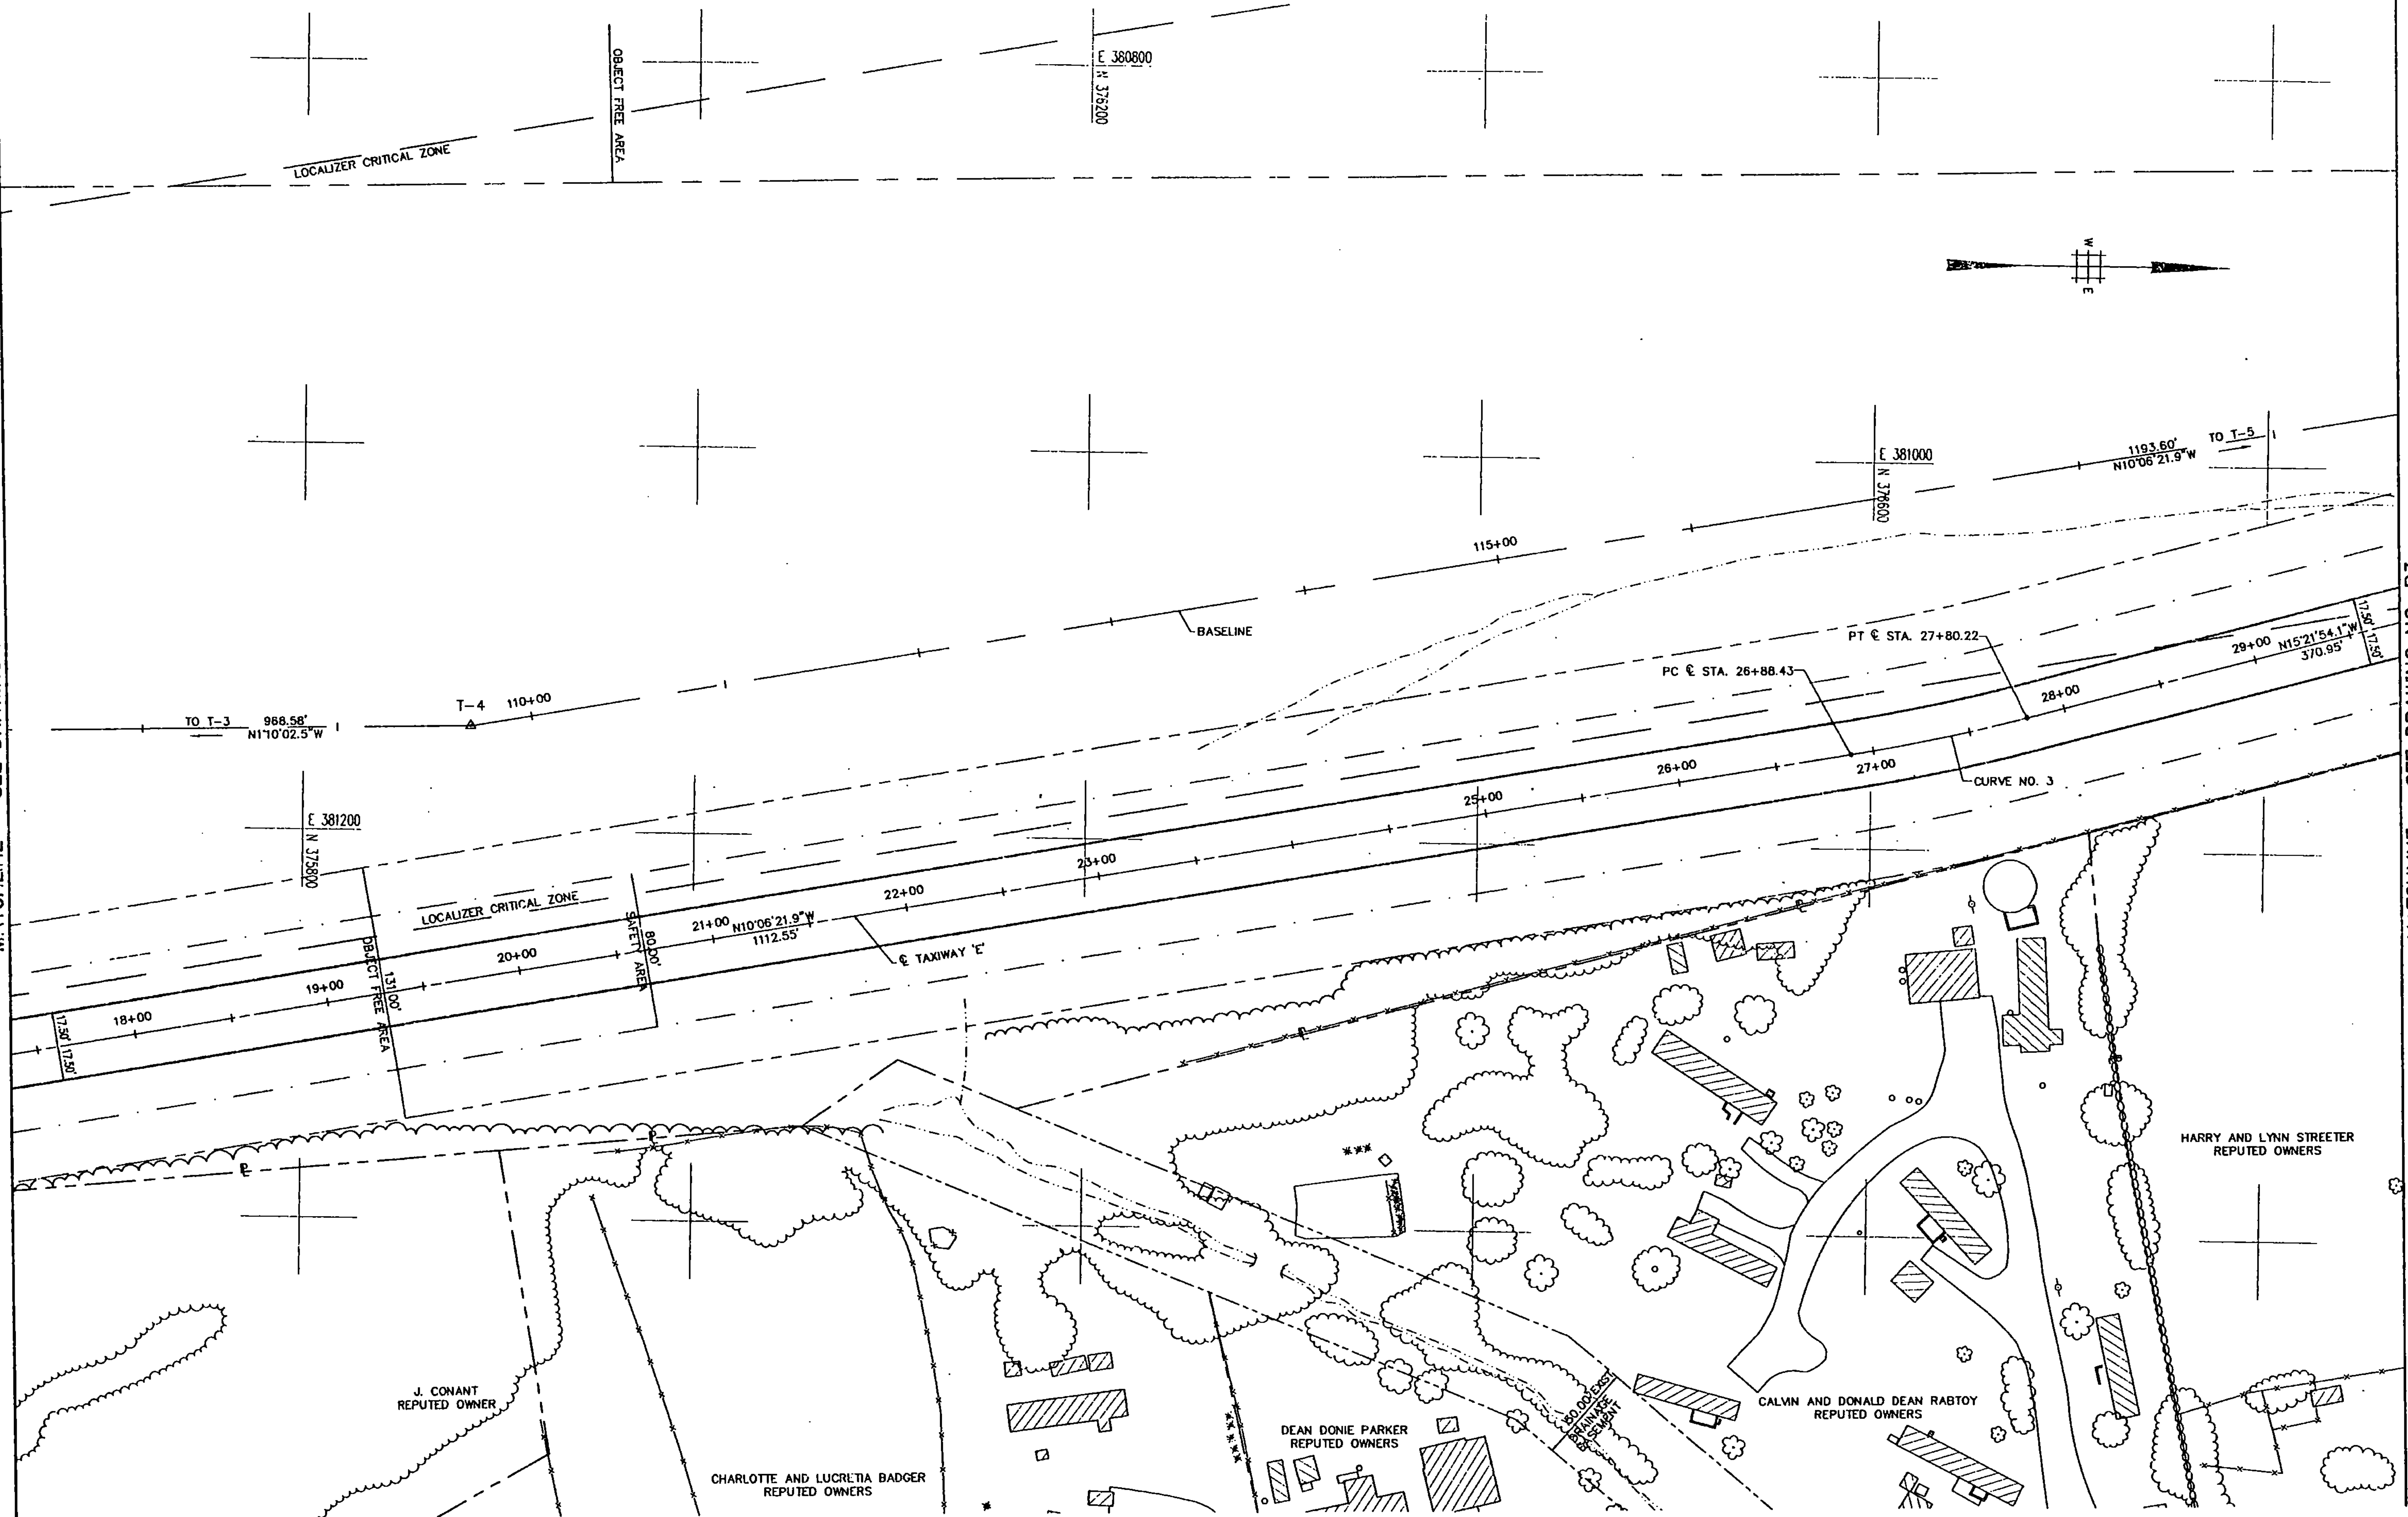

CENTERLINE CURVE DATA

CURVE	RADIUS	LENGTH	TANGENT	DELTA
3	1000.00'	91.79'	45.93'	05°15'32.2"

CENTERLINE COORDINATE TABLE

CURVE	Q. STATION	POINT	NORTH	EAST	Q. STATION	OFFSET
3	26+88.43	PC3	376589.635	381151.083	116+60.52	12E.75' RT.
	27+80.22	PT3	376679.131	381130.656	117+52.18	124.54' RT.



SEAL
[Signature]

PROJECT NO.	7804	DESIGNED BY:	D. W.	CHECKED BY:	L. G.
PROJECT DESCRIPTION	RUTLAND STATE AIRPORT CLARENDON, VERMONT TAXIWAY E SITE PLAN				
DATE	AUG. 23, 1993	SCALE	1" = 40'	DATE	AUG. 23, 1993
DESIGNED BY	F. S.	SCALE	1" = 40'	DATE	AUG. 23, 1993
DRAWN BY	D. W.	PROJECT NO.	7804	PROJECT DESCRIPTION	RUTLAND STATE AIRPORT CLARENDON, VERMONT TAXIWAY E SITE PLAN
DECODED BY		DRAWING NO.	P2	DATE	AUG. 23, 1993
DATE		SHEET	8 OF 77		

DRAWING NO. **P2**
SHEET 8 OF 77